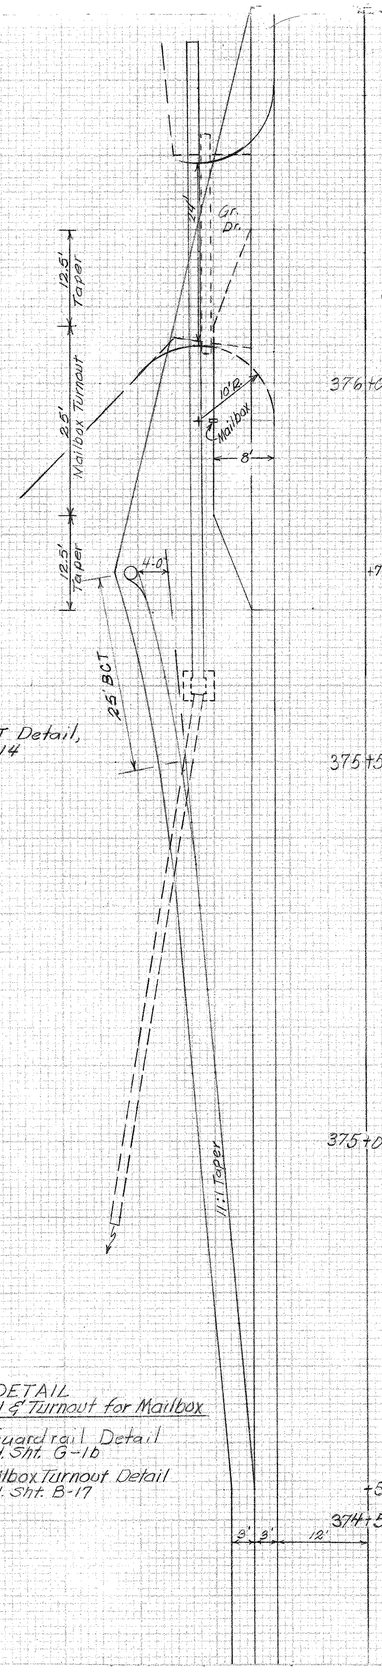

For Additional BCT Detail, See Stan. Sht. G-14

DETAIL
Guard Rail & Turnout for Mailbox

Additional Guardrail Detail
See Std. Sht. G-1b

Additional Mailbox Turnout Detail
See Std. Sht. B-17

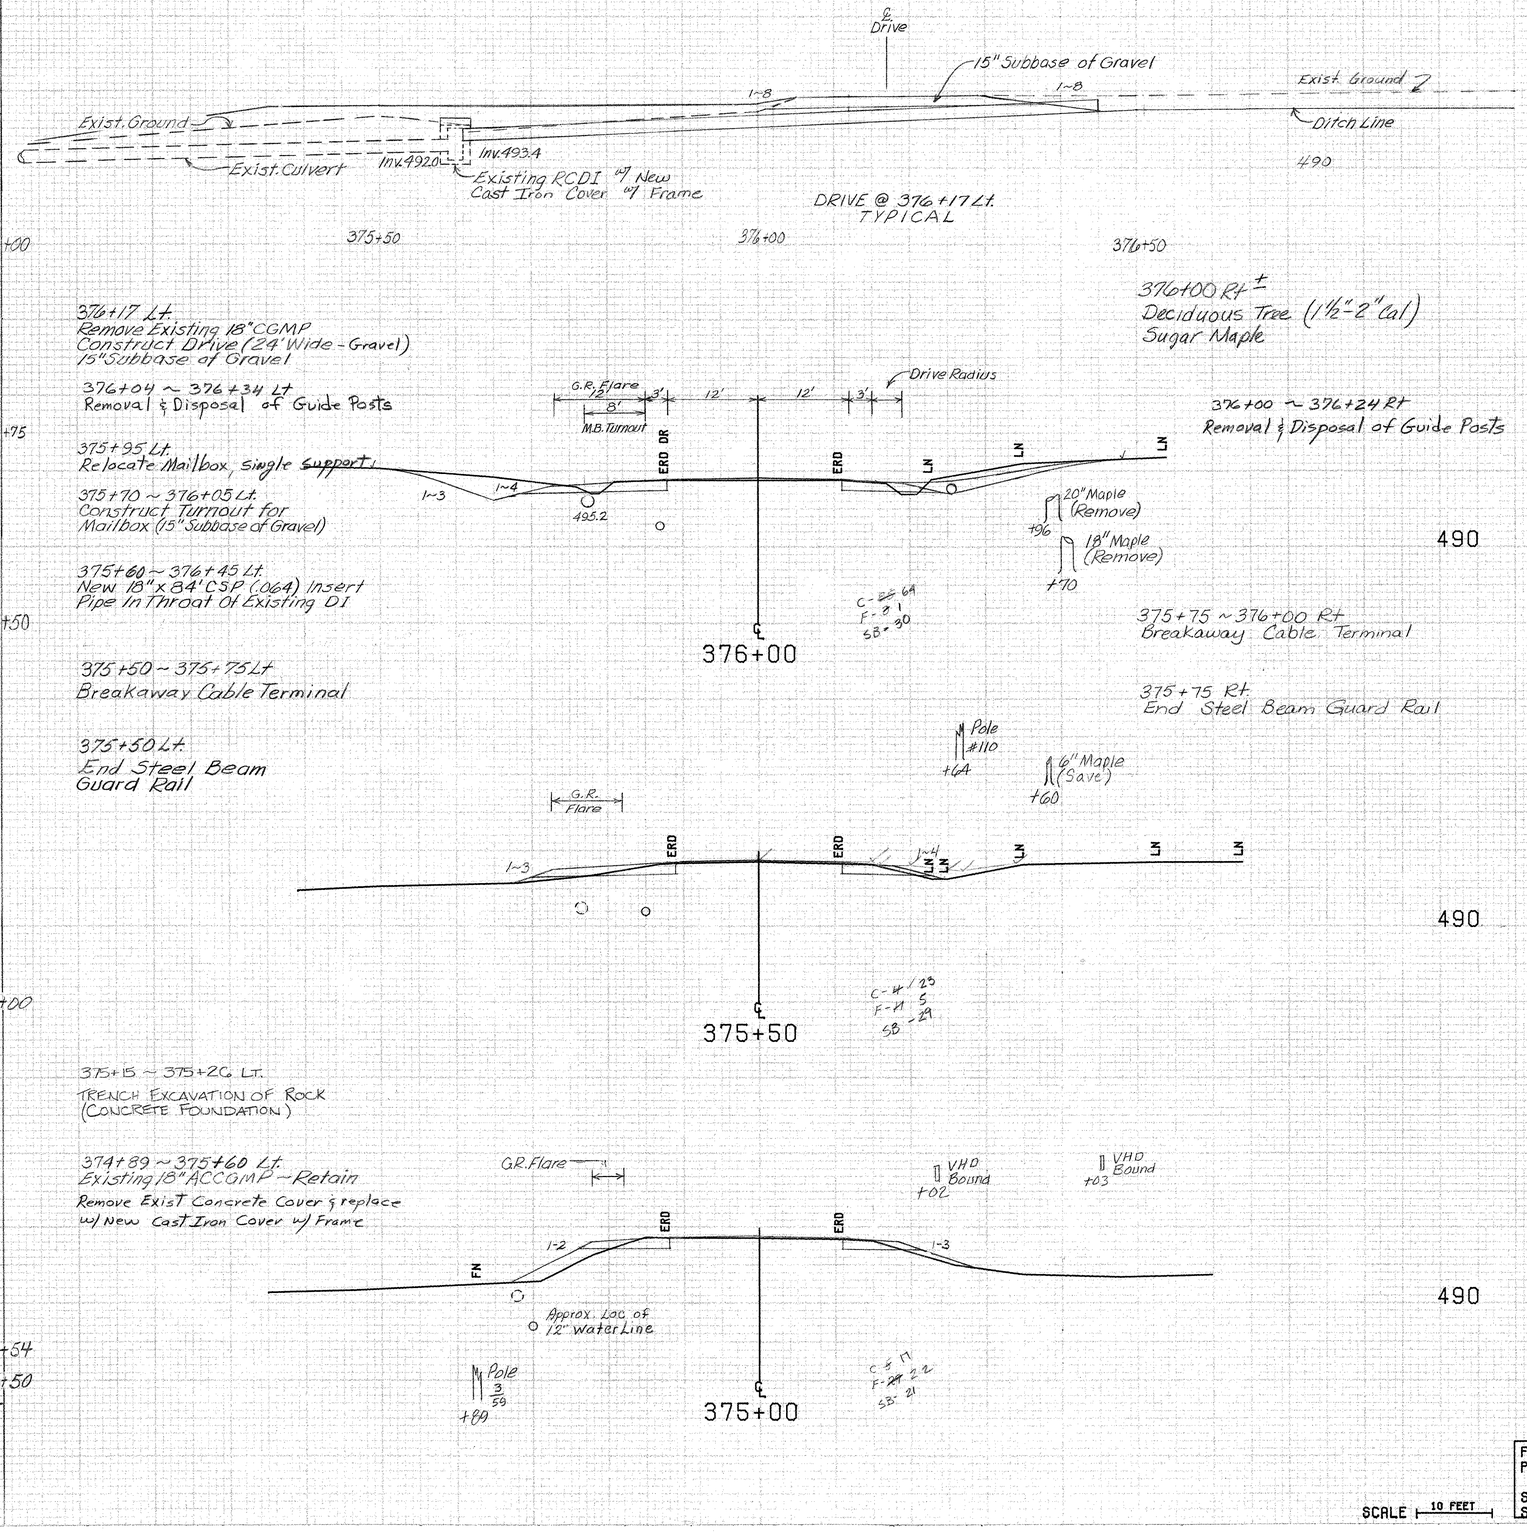

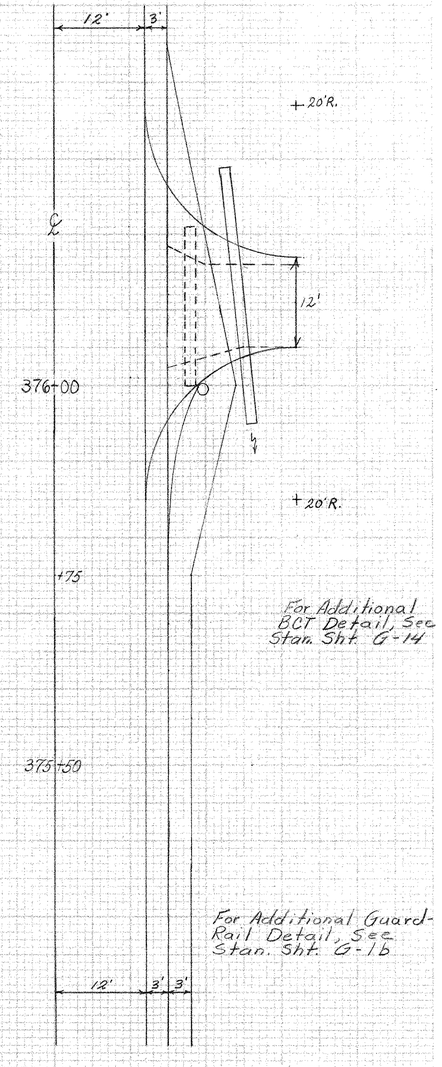

For Additional BCT Detail, See Stan. Sht. G-14

For Additional Guard-Rail Detail, See Stan. Sht. G-1b

Guardrail Detail

ADDISON MM 0.71 ~ MM 0.94

FROM STA. 375+00	TO STA. 376+00		
PROJECT NAME	SHOREHAM-BRIDPORT-ADDISON		
NO.	F017-1(2)	PLOTTED 03/13/84	
SURVEYED BY	FANTONI	FEB 84	
SHEET 378 OF 420 SHEETS		SHEET 378 OF 477	

SCALE 10 FEET