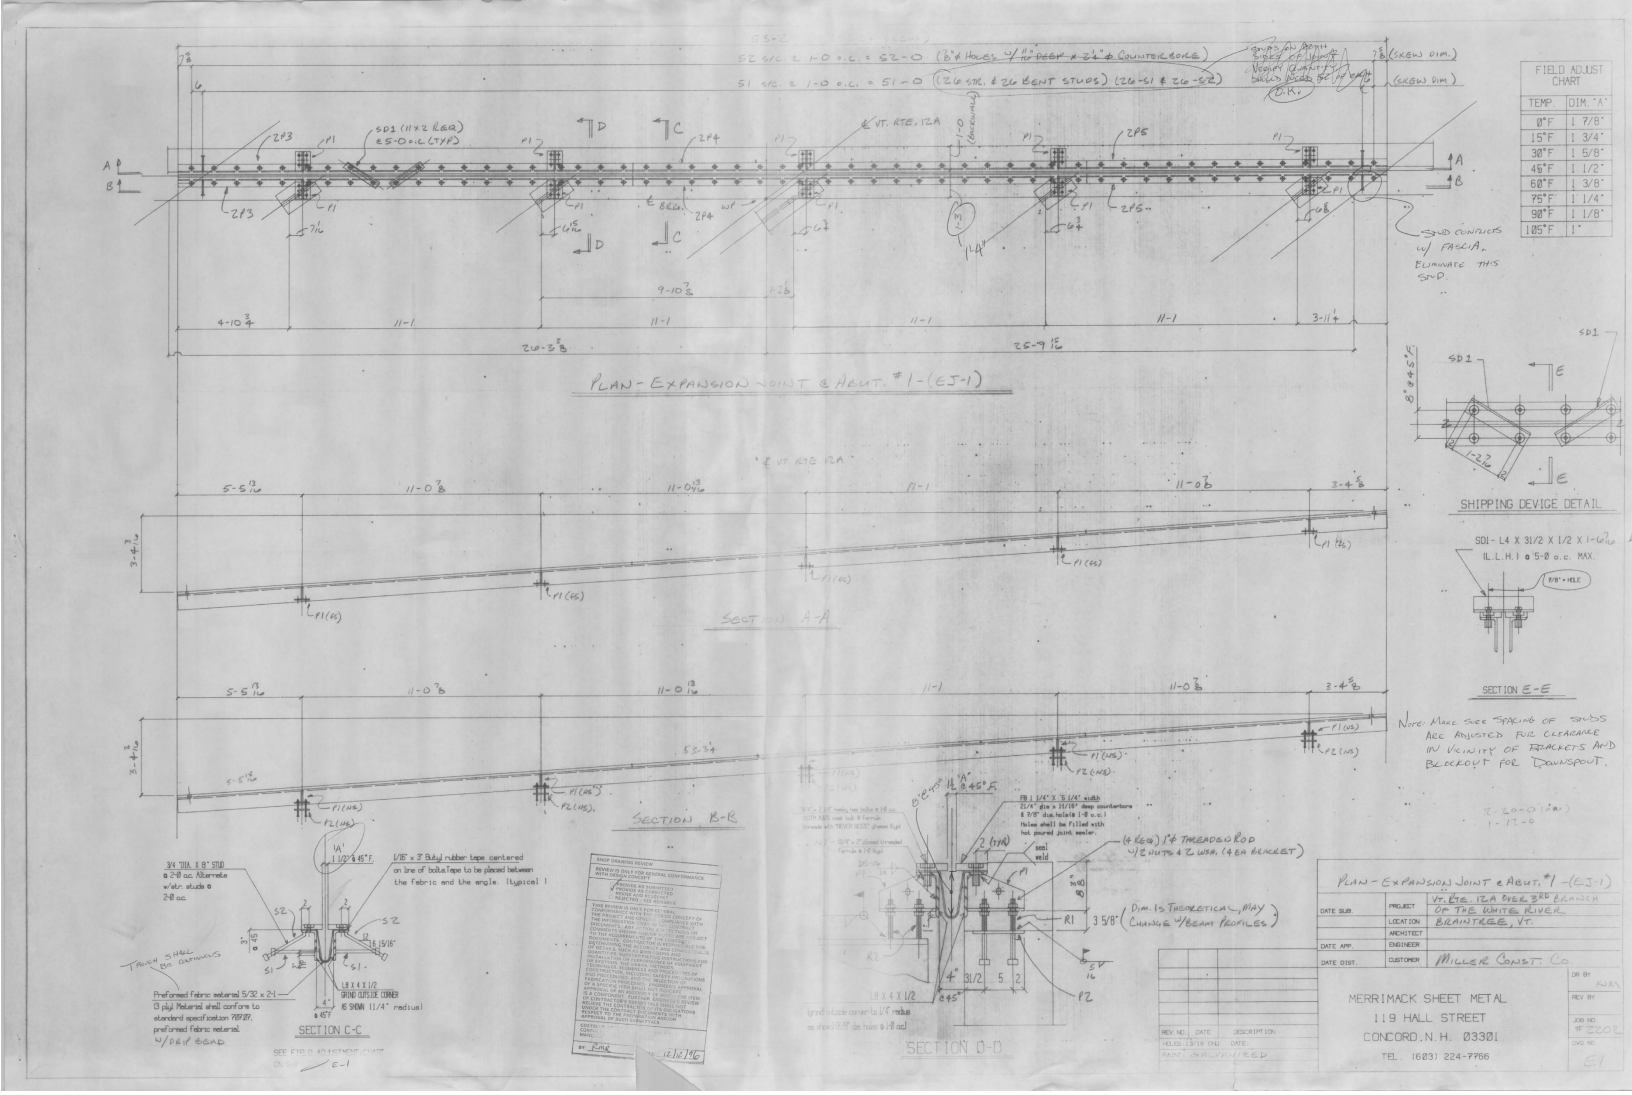
PLAN - EXPANSION JOINT @ ABUT. #1 - (EJ-1)
SECTION A-A
SECTION B-B
SECTION C-C
SECTION D-D
SECTION E-E
SHIPPING DEVICE DETAIL
FIELD ADJUST CHART
TEMP. | DIM. "A"
0°F | 1 7/8"
15°F | 1 3/4"
30°F | 1 5/8"
45°F | 1 1/2"
60°F | 1 3/8"
75°F | 1 1/4"
90°F | 1 1/8"
105°F | 1"
SD1 (11 x 2 REQ'D) E5-0 o.c. (TYP.)
SD1 - L4 X 3 1/2 X 1/2 X 1'-6 1/2 LL.H.) @ 5'-0 o.c. MAX.
7/8" ø HOLE
SHIP DRAWING REVIEW
MERRIMACK SHEET METAL
119 HALL STREET
CONCORD, N.H. 03301
TEL. (603) 224-7766
PROJECT: VT. RTE. 12A OVER 3RD BRANCH OF THE WHITE RIVER
LOCATION: BRAINTREE, VT.
CUSTOMER: MILLER CONST. CO.
DR. BY: NM
JOB NO. #2202
DWG NO. E1