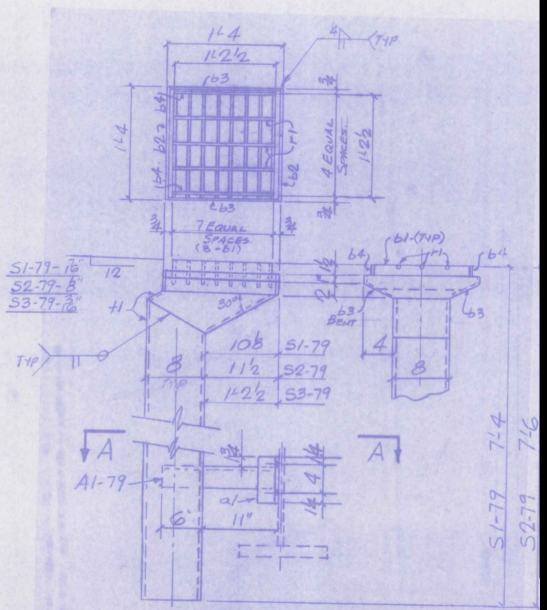

ONE - S1-79 (@ SECT. S1 - HIGH STE
ONE - S2-79 (@ SECT. S2 Do
ONE - S3-79 (@ SECT. S3 Do

WELDS - 6