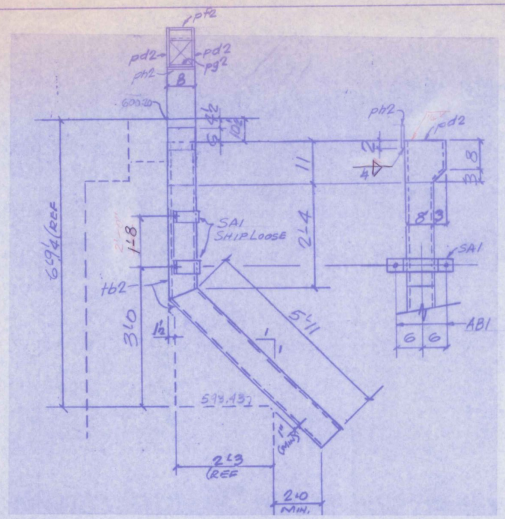

DS2-79-ONE REQ'D.
@ ABUT. 2

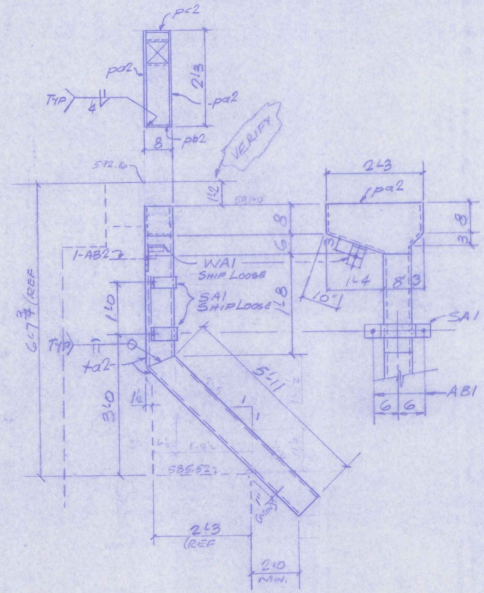

DS1-79-ONE REQ'D.
@ ABUT. 1

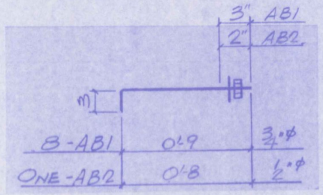

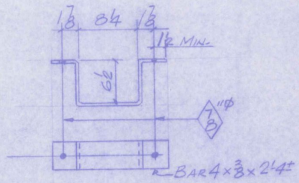

SA1-4 REQ'D

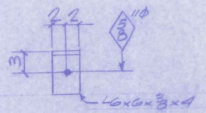

WA1-ONE REQ'D

ABM INFO	PAGE	LINE	NO.	DESC
			1	DOWN
	2	A	2	PL ¾ x
		B	1	PL ¾ x
		B	1	C
	2	D	1	PL ⅜ x
			1	DOWN
			2	PL ¾
	2	B	1	PL ¾
		B	1	
		C	1	PL ¾
	2	E	1	PL ⅜ x 3 x 4
	2	F	4	BAR 4 x ⅜ x 2'-4"
	2	G	1	L 6 x 6 x ⅜ x 4
	2	H	8	¾" ø
	2	I	1	½" ø

EQ'D

OUT FOR APPROVAL
OUT FOR APPROVAL
ISSUED TO SHOP
FIELD & OFFICE

REV. REMARKS
PROJECT NO. B
MATERIAL: A709
HOLES: A3, NOT
SURFACE PREP.
GALVANIZE
DESCRIPTION: D
JOB:
U.S. R
W
CUSTOMER: U.
BRIDG
5 INDUSTRY
PHONE (207)