
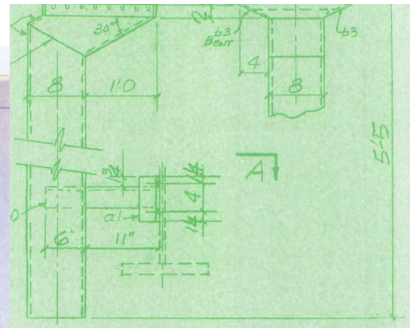


ONE-S1-80


WELDS-4" CONT. FILLET U.N.

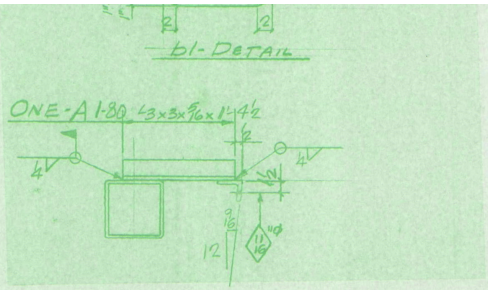

OUT FOR APPROVAL	9/96	
OUT FOR APPROVAL		
ISSUED TO SHOP		
FIELD & OFFICE		

REV.	REMARKS	DATE	DWN

PROJECT NO. B RS-0137
MATERIAL A709 GR36 ELECTRODE
HOLES AS NOTED SHOP BOLT
SURFACE PREP. & PAINT:
GALVANIZED AFTER ASM
DESCRIPTION: SCUPPE
JOB:
U.S. RT. 7 OVER
WALLINGF
CUSTOMER: J.A. MCD
BRIDGE & STE
5 INDUSTRY ROAD SOUT
PHONE (207) 874-2017

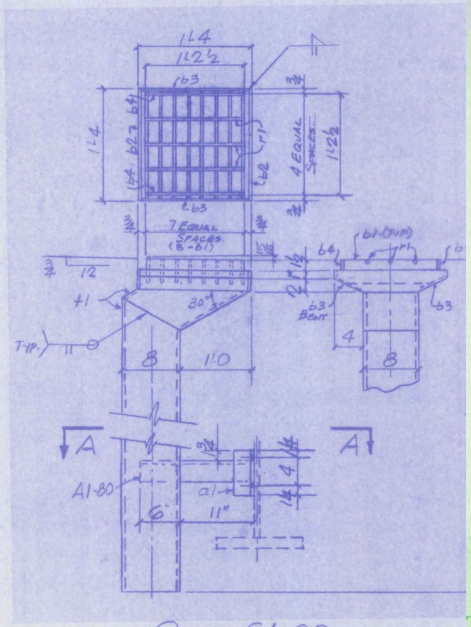



ONE-S1-80

WELDS-

ASM. INFO.			SHOP
PAGE	LINE	NO.	DESCRIPTION
			SCUPPER
1	A	8	BAR 5/16 x 3
1	B	2	BAR 3 x 4
1	C	2	BAR 5/16 x 4
1	D	2	BAR 12 x 4
1	E	3	6"Ø BAR
1	F	1	TS 8 x 8 x 4
1	H	1	L3x3x5/16
1	H	1	Do
1	I	12	3/4" H.S. BOLTS

PAY ITEM

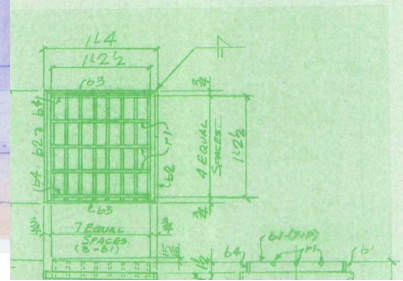

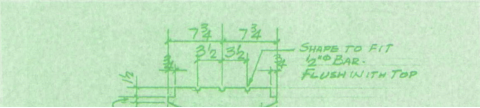

SHOP DRAW
REVIEW IS FOR GENER
CONTRACT DOCUMEN
IS ASSUMED FOR
DEPARTMENT
APPROV
APPROV
AMEND
REJECT
BARNES BR
80 Boyl
Boston, Mass
DATE 9/20/96