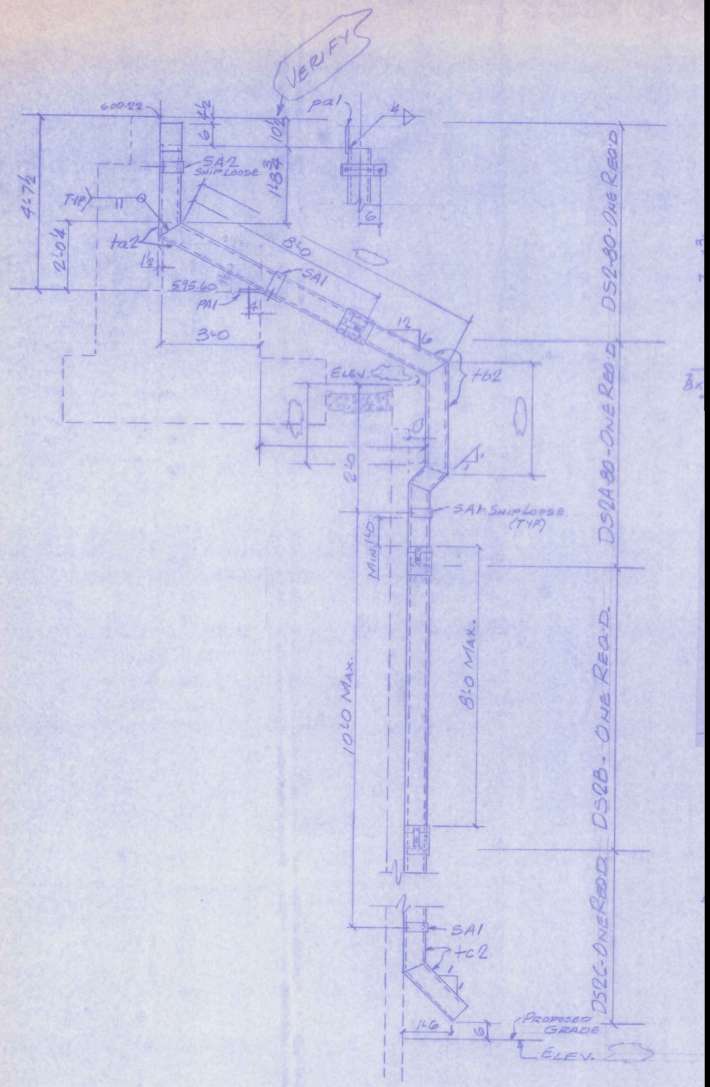

SHOP & FIELD ASSEMBLY DIAGR