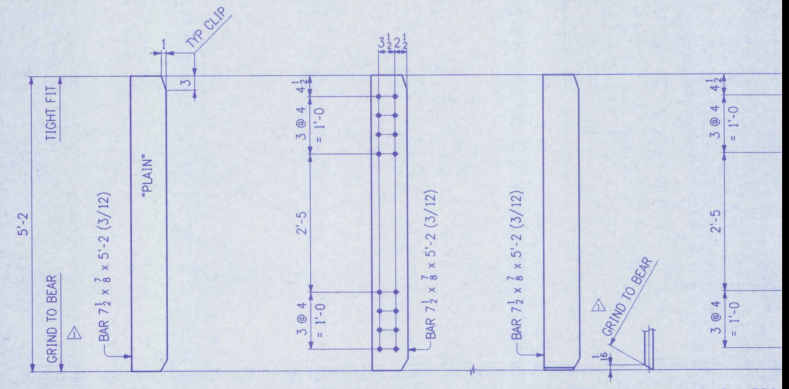

4 ~ BRG. STIFF. MK. x1a | 28 ~ BRG. STIFF. MK. x1b | 2 ~ BRG. STIFF. MK. x1c | 2 ~ BRG.

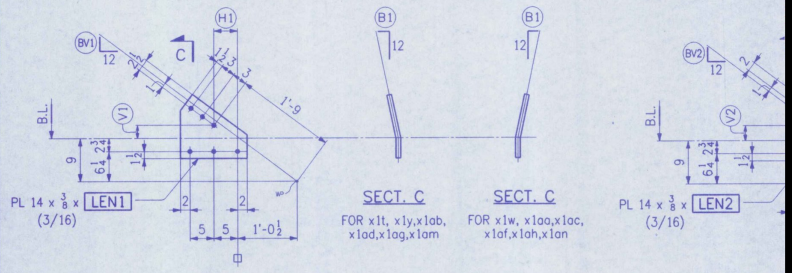

SECT. C
FOR x1t, x1y, x1ab, x1ad, x1ag, x1am

SECT. C
FOR x1w, x1ao, x1ac, x1af, x1ah, x1an

LATERAL GUSSET PLATES

MARK	No. REQ'D	BV1	H1	V1	LEN1	B1
x1p	2	8 1/4	5 3/8	2 1/16	1'-0 5/8	FLAT
x1s	4	8 15/16	4 15/16	2 3/4	1'-1 1/2	FLAT
x1t	4	8 15/16	4 15/16	2 3/4	1'-1 1/2	9/16
x1w	4					
x1y	4	8 15/16	4 15/16	2 3/4	1'-1 1/2	3/8
x1ao	4					
x1ab	4	8 15/16	4 15/16	2 3/4	1'-1 1/2	1/4
x1ac	4					
x1ad	6	8 15/16	4 15/16	2 3/4	1'-1 1/2	3/16
x1af	6					
x1ag	2	8 15/16	4 15/16	2 3/4	1'-1 1/2	5/16
x1ah	2					
x1ak	2	9 5/8	4 1/2	3 3/8	1'-2 1/4	FLAT
x1am	2	10 3/16	4 1/8	3 13/16	1'-2 13/16	1/8
x1an	2					

SHOP DRAWING REVIEW
REVIEW IS FOR GENERAL COMPLIANCE WITH CONTRACT DOCUMENTS. NO RESPONSIBILITY IS ASSUMED FOR CORRECTNESS OF DIMENSIONS OR DETAILS.
APPROVED
APPROVED AS NOTED
AMEND AND RESUBMIT
REJECTED - SEE REMARKS
DATE MAR 22 1995 BY