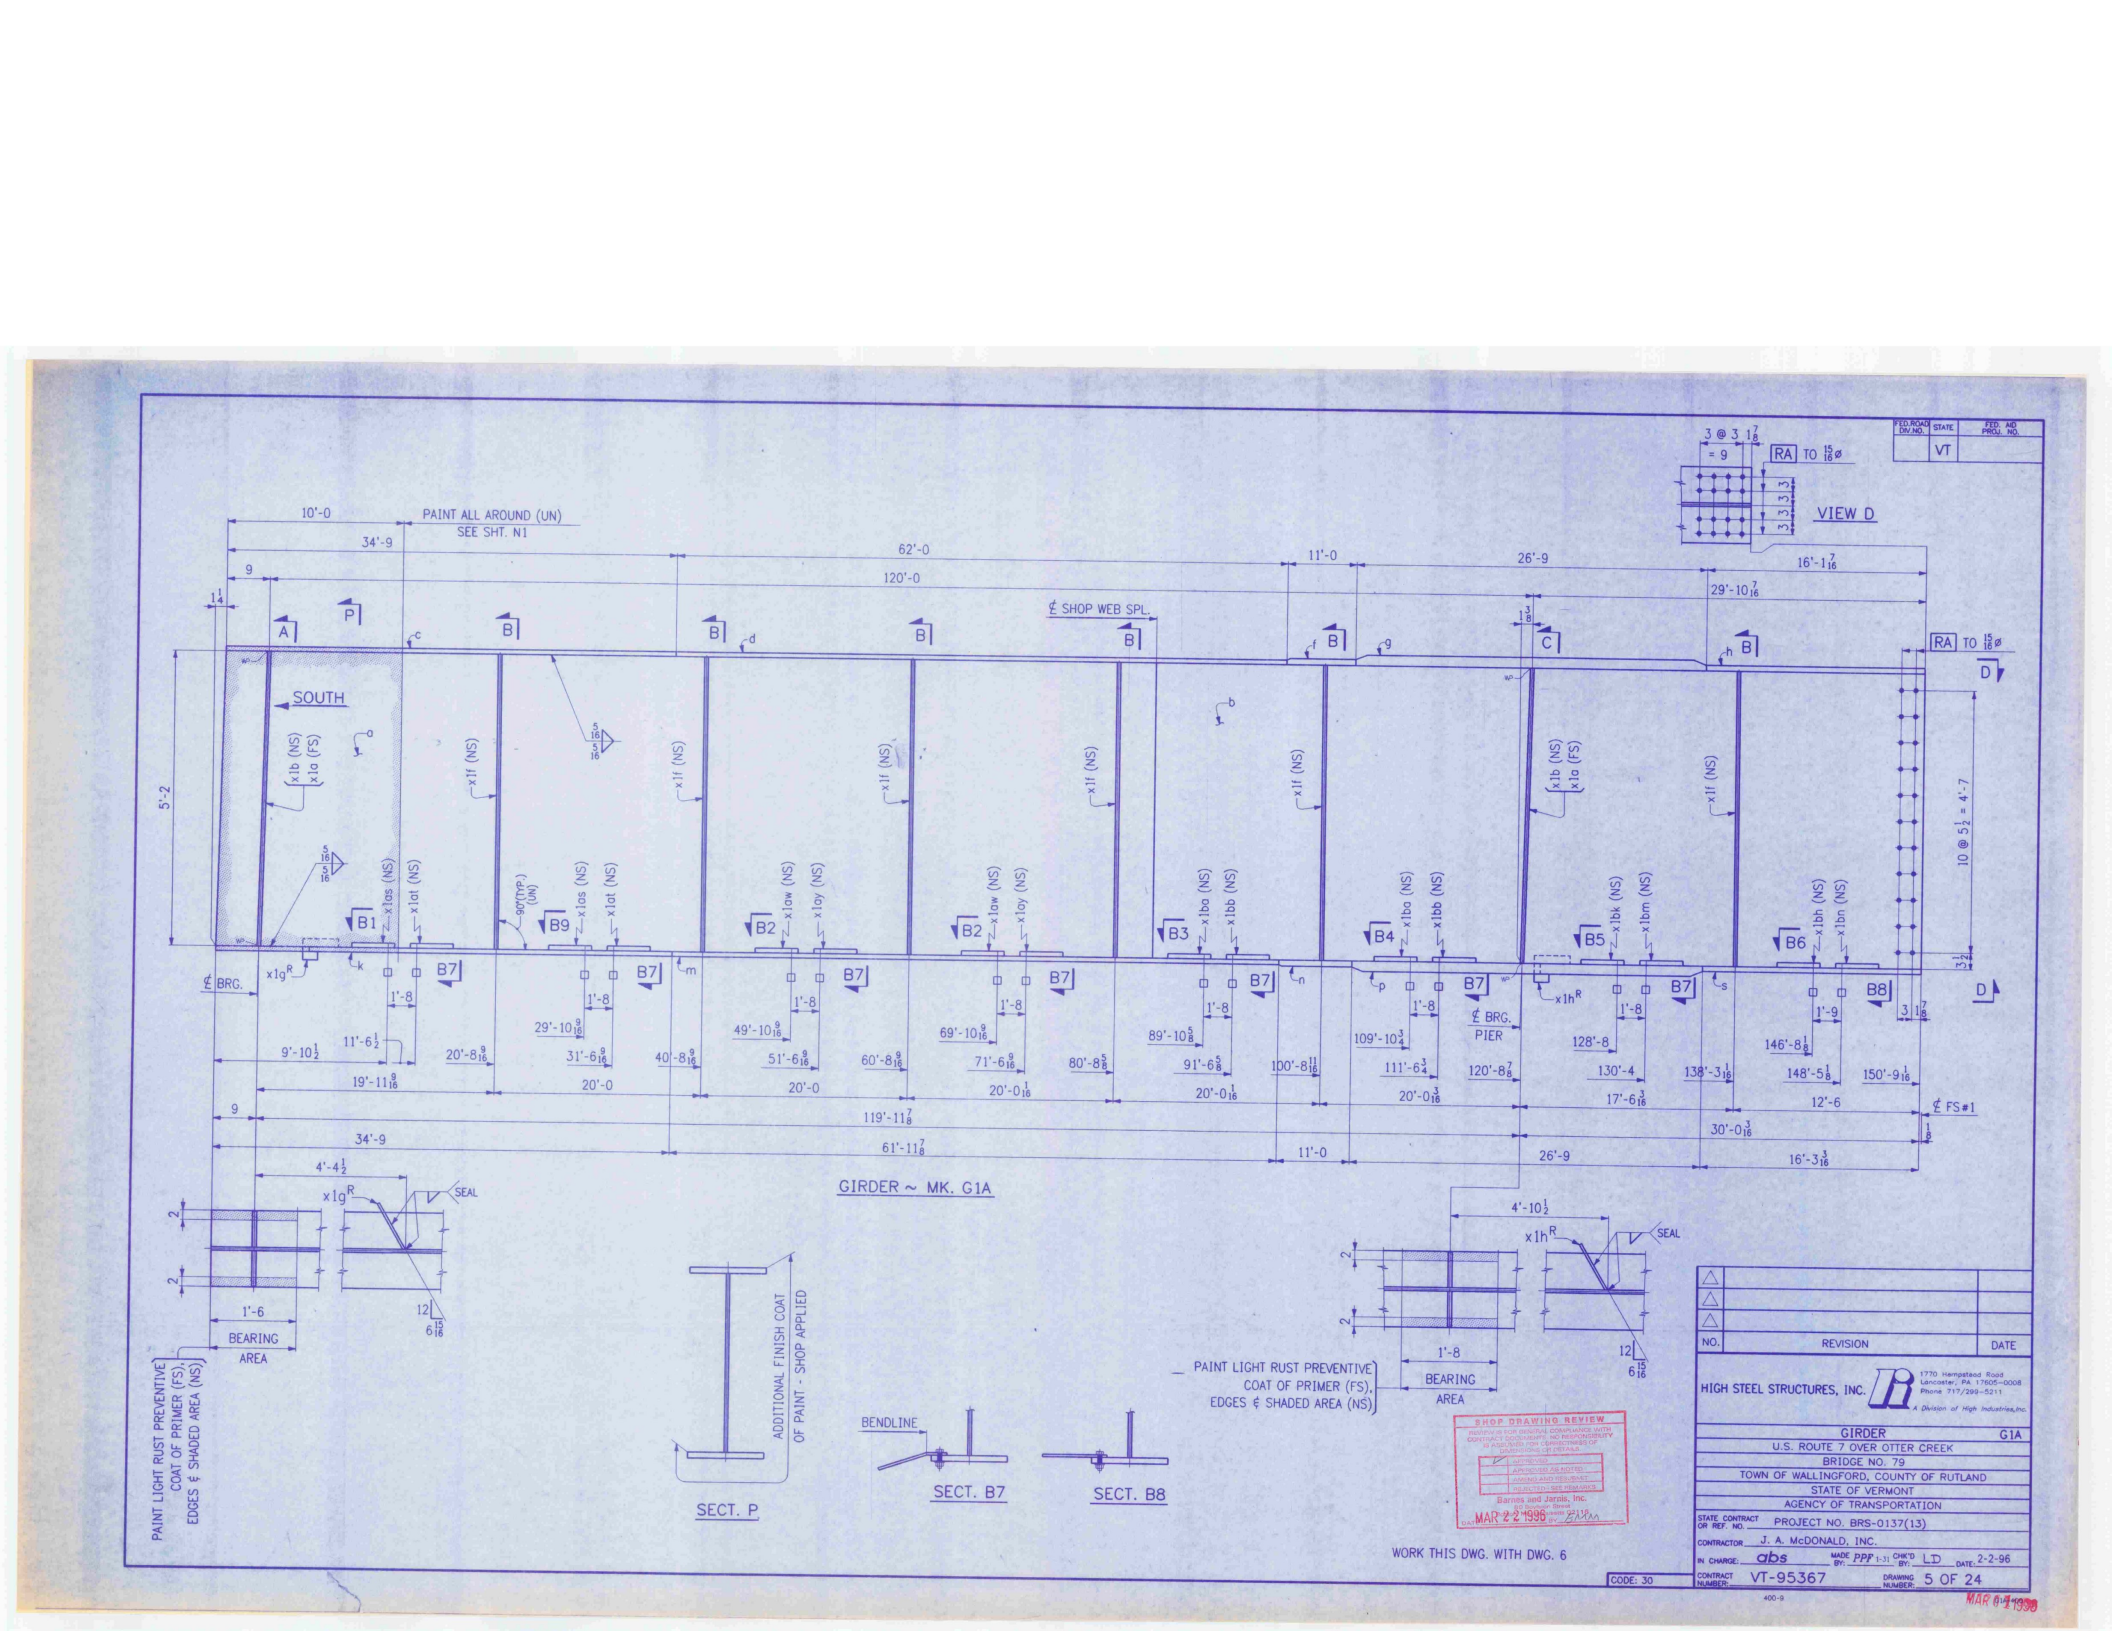
FED. ROAD DIV. NO.
STATE
VT
FED. AID PROJ. NO.
PAINT ALL AROUND (UN)
SEE SHT. N1
VIEW D
SOUTH
℄ SHOP WEB SPL.
℄ BRG.
℄ BRG. PIER
℄ FS#1
GIRDER ~ MK. G1A
SECT. P
SECT. B7
SECT. B8
BENDLINE
ADDITIONAL FINISH COAT OF PAINT - SHOP APPLIED
PAINT LIGHT RUST PREVENTIVE COAT OF PRIMER (FS), EDGES & SHADED AREA (NS)
BEARING AREA
SEAL
SHOP DRAWING REVIEW
Barnes and Jarais, Inc.
MAR 2 2 1996
WORK THIS DWG. WITH DWG. 6
CODE: 30
NO.
REVISION
DATE
HIGH STEEL STRUCTURES, INC.
1770 Hempstead Road
Lancaster, PA 17605-0008
Phone 717/299-5211
A Division of High Industries, Inc.
GIRDER G1A
U.S. ROUTE 7 OVER OTTER CREEK
BRIDGE NO. 79
TOWN OF WALLINGFORD, COUNTY OF RUTLAND
STATE OF VERMONT
AGENCY OF TRANSPORTATION
STATE CONTRACT OR REF. NO. PROJECT NO. BRS-0137(13)
CONTRACTOR J. A. McDONALD, INC.
IN CHARGE: abs
MADE BY: PPP 1-31
CHK'D BY: LD
DATE: 2-2-96
CONTRACT NUMBER: VT-95367
DRAWING NUMBER: 5 OF 24
400-9
MAR 04 1996