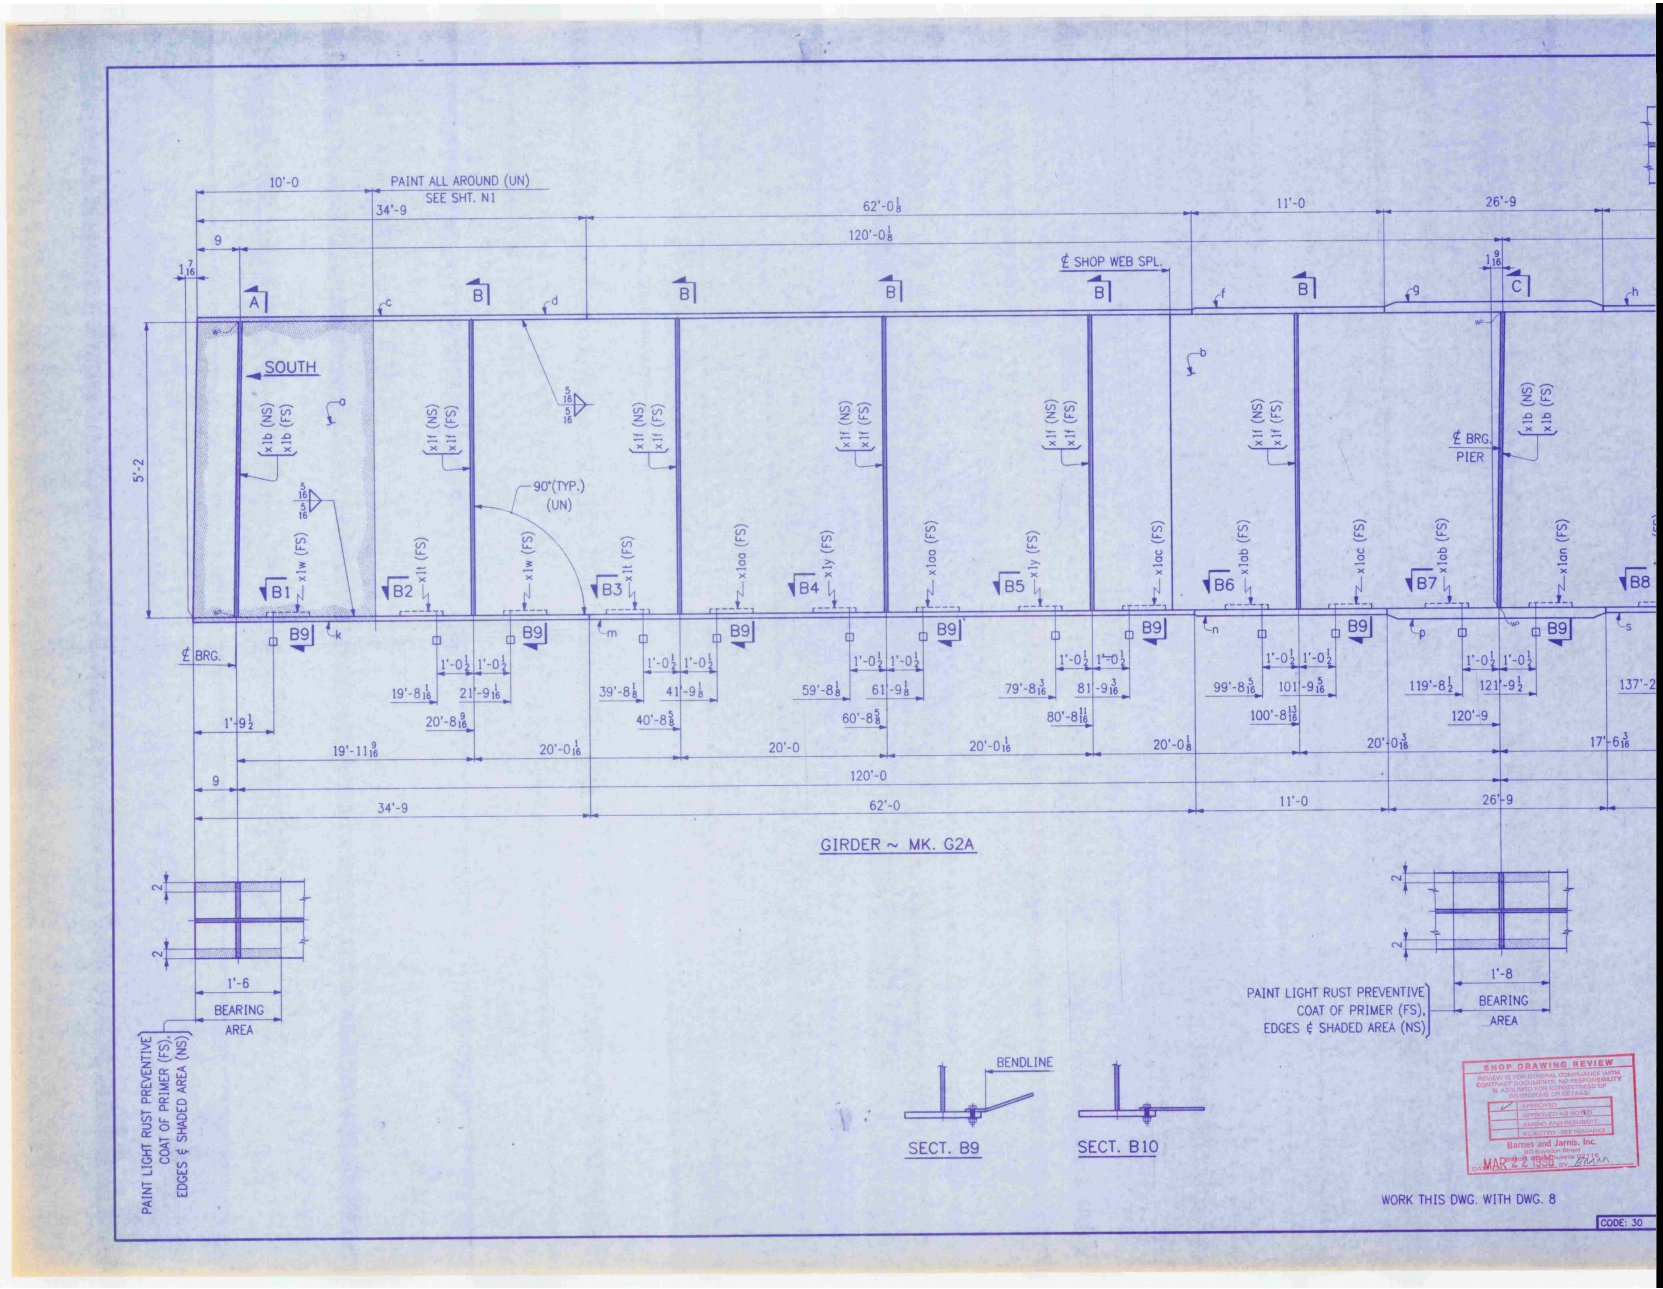
10'-0
PAINT ALL AROUND (UN)
SEE SHT. N1
34'-9
62'-0⅛
120'-0⅛
11'-0
26'-9
9
℄ SHOP WEB SPL.
SOUTH
5'-2
90°(TYP.)
(UN)
℄ BRG.
PIER
℄ BRG.
1'-9½
19'-11⅜
20'-0 1/16
20'-0
20'-0 1/16
20'-0⅛
20'-0 3/16
17'-6 3/16
120'-0
GIRDER ~ MK. G2A
1'-6
BEARING
AREA
PAINT LIGHT RUST PREVENTIVE
COAT OF PRIMER (FS),
EDGES & SHADED AREA (NS)
1'-8
BENDLINE
SECT. B9
SECT. B10
SHOP DRAWING REVIEW
Barnes and Jarvis, Inc.
WORK THIS DWG. WITH DWG. 8
CODE: 30