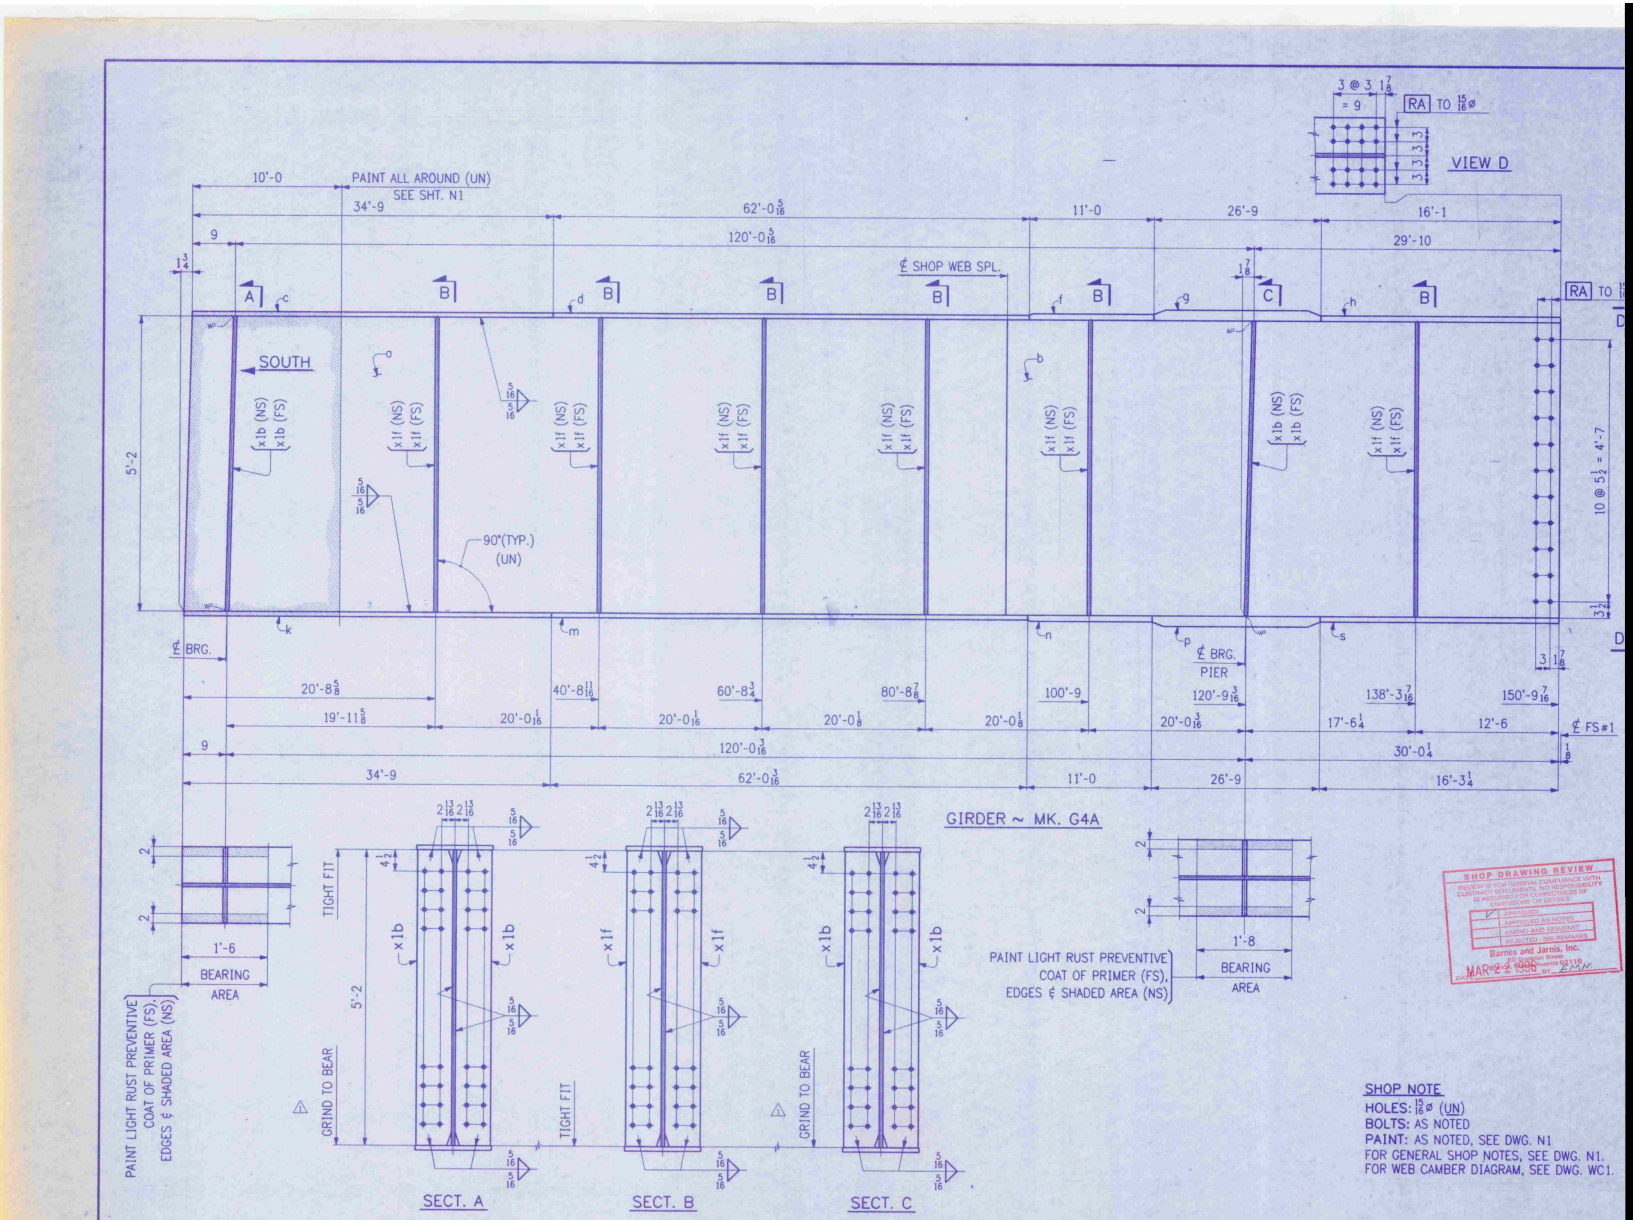
GIRDER ~ MK. G4A
VIEW D
SOUTH
PAINT ALL AROUND (UN)
SEE SHT. N1
℄ SHOP WEB SPL.
℄ BRG.
PIER
℄ FS#1
90°(TYP.)
(UN)
SECT. A
SECT. B
SECT. C
TIGHT FIT
GRIND TO BEAR
BEARING
AREA
PAINT LIGHT RUST PREVENTIVE
COAT OF PRIMER (FS),
EDGES & SHADED AREA (NS)
SHOP NOTE
HOLES: 15/16ø (UN)
BOLTS: AS NOTED
PAINT: AS NOTED, SEE DWG. N1
FOR GENERAL SHOP NOTES, SEE DWG. N1.
FOR WEB CAMBER DIAGRAM, SEE DWG. WC1.
SHOP DRAWING REVIEW
Barnes and Jarnis, Inc.
MAR 2-2 1995