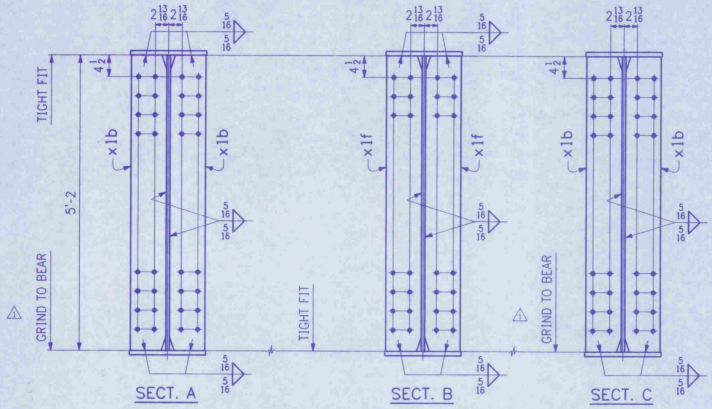

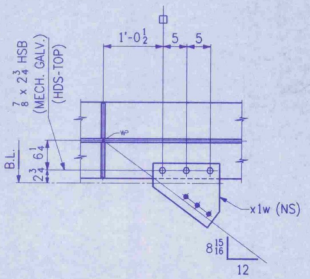

SECT. B1
(DEVELOPED)

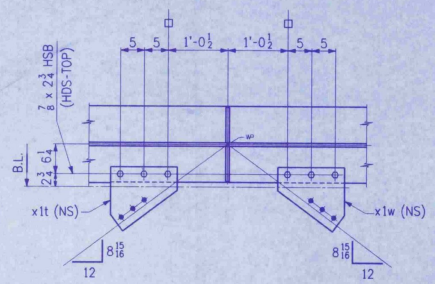

SECT. B2
(DEVELOPED)

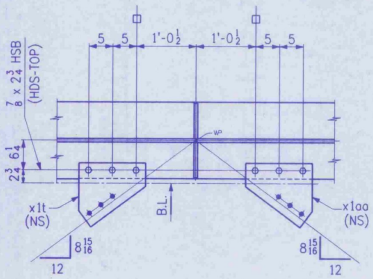

SECT. B3
(DEVELOPED)

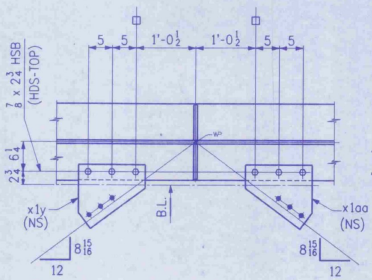

SECT. B4
(DEVELOPED)

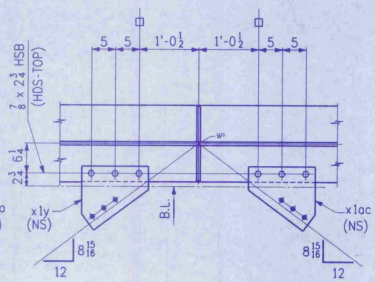

SECT. B5
(DEVELOPED)

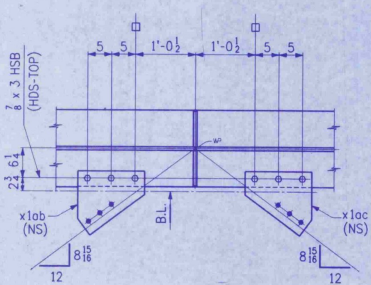

SECT. B6
(DEVELOPED)

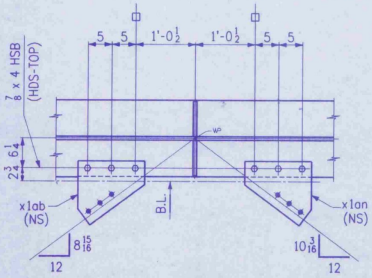

SECT. B7
(DEVELOPED)

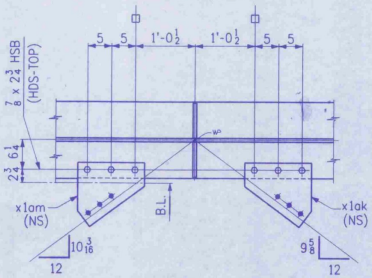

SECT. B8
(DEVELOPED)

SHOP DRAWING REVIEW
REVIEW IS FOR GENERAL COMPLIANCE WITH CONTRACT DOCUMENTS. NO RESPONSIBILITY IS ASSUMED FOR CORRECTNESS OF DIMENSIONS OR DETAILS.
APPROVED
APPROVED AS NOTED
AMEND AND RESUBMIT
REJECTED - SEE REMARKS
Barnes and Jarnis, Inc.
DATE MAR 2 2 1996 BY

SHOP NOTE

HOLES: $\frac{15}{16}$ø (UN)
BOLTS: AS NOTED
PAINT: AS NOTED, SEE DWG. N1
FOR GENERAL SHOP NOTES, SEE DWG. N1.
FOR WEB CAMBER DIAGRAM, SEE DWG. WC1.

WORK THIS DWG. WITH DWG. 11

CODE: 30