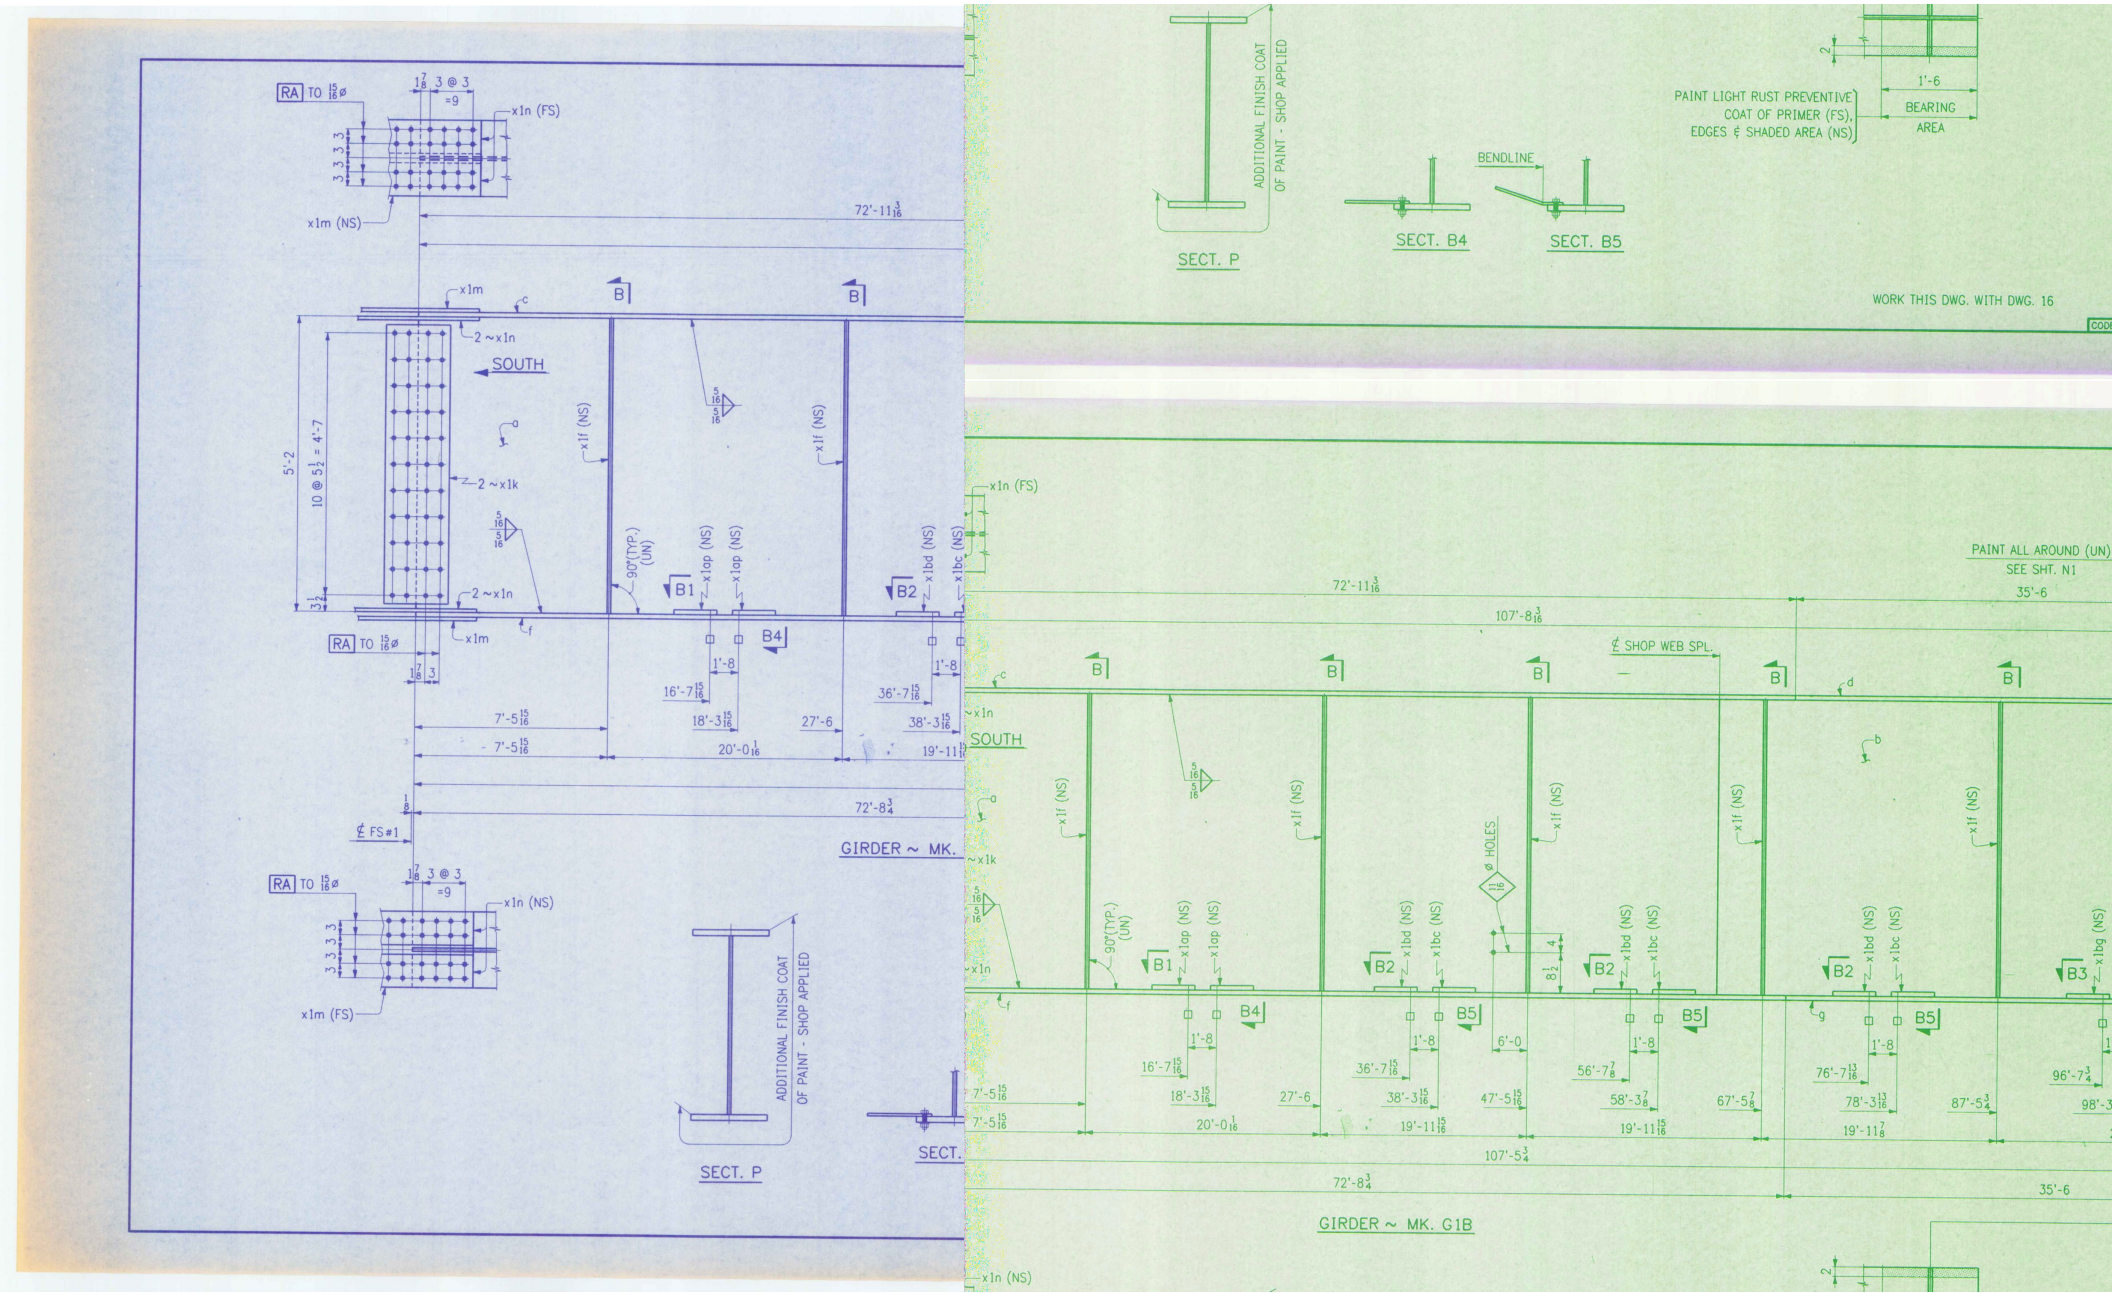

RA TO 15/16ø
1 7/8 3 @ 3 =9
x1n (FS)
3 3 3 3
x1m (NS)
72'-11 3/16
x1m
2 ~x1n
SOUTH
5'-2
10 @ 5 1/2 = 4'-7
3 1/2
2 ~x1k
x1f (NS)
5/16
5/16
90°(TYP.) (UN)
B1
x1ap (NS)
B2
x1bd (NS)
x1bc (NS)
B4
1'-8
16'-7 15/16
18'-3 15/16
20'-0 1/16
27'-6
36'-7 15/16
38'-3 15/16
19'-11 13/16
7'-5 15/16
72'-8 3/4
℄ FS#1
GIRDER ~ MK.
x1m (FS)
ADDITIONAL FINISH COAT OF PAINT - SHOP APPLIED
SECT. P
SECT. B4
BENDLINE
SECT. B5
PAINT LIGHT RUST PREVENTIVE COAT OF PRIMER (FS), EDGES & SHADED AREA (NS)
1'-6
BEARING AREA
WORK THIS DWG. WITH DWG. 16
PAINT ALL AROUND (UN) SEE SHT. N1
35'-6
107'-8 3/16
℄ SHOP WEB SPL.
ø HOLES
11/16
8 1/2
B3
x1bg (NS)
B5
6'-0
56'-7 7/8
58'-3 7/8
67'-5 7/8
76'-7 13/16
78'-3 13/16
87'-5 3/4
96'-7 3/4
19'-11 7/8
107'-5 3/4
GIRDER ~ MK. G1B