

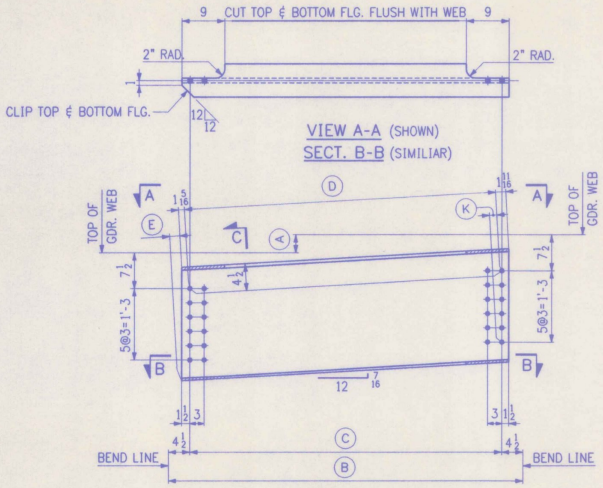


ABUTMENT DIAPHRAGMS

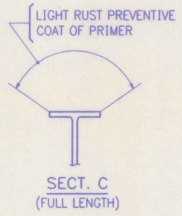

MARK	A	B	C	D	E	K
D26	$5\frac{3}{4}$	$14'\text{-}4\frac{13}{16}$	$13'\text{-}7\frac{13}{16}$	$13'\text{-}7\frac{15}{16}$	$\frac{13}{16}$	$\frac{1}{2}$
D27	$5\frac{3}{4}$	14'-5	13'-8	$13'\text{-}8\frac{1}{8}$	$\frac{13}{16}$	$\frac{1}{2}$
D28	$5\frac{3}{4}$	$14'\text{-}5\frac{3}{16}$	$13'\text{-}8\frac{3}{16}$	$13'\text{-}8\frac{5}{16}$	$\frac{13}{16}$	$\frac{1}{2}$
D29	$5\frac{3}{4}$	$14'\text{-}5\frac{3}{8}$	$13'\text{-}8\frac{3}{8}$	$13'\text{-}8\frac{1}{2}$	$\frac{13}{16}$	$\frac{1}{2}$
D30	$5\frac{7}{8}$	$14'\text{-}5\frac{1}{2}$	$13'\text{-}8\frac{1}{2}$	$13'\text{-}8\frac{5}{8}$	$\frac{7}{8}$	$\frac{9}{16}$

PAINT

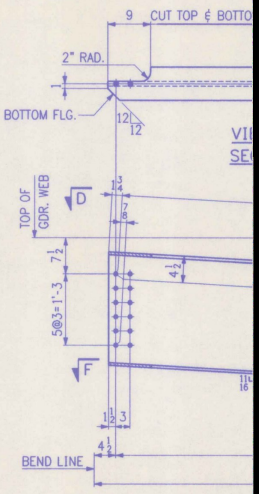

ABUTMENT

MARK	F
D31	9
D32	9
D33	9
D34	$9\frac{1}{8}$
D35	$9\frac{1}{8}$