



CALC. PLAN

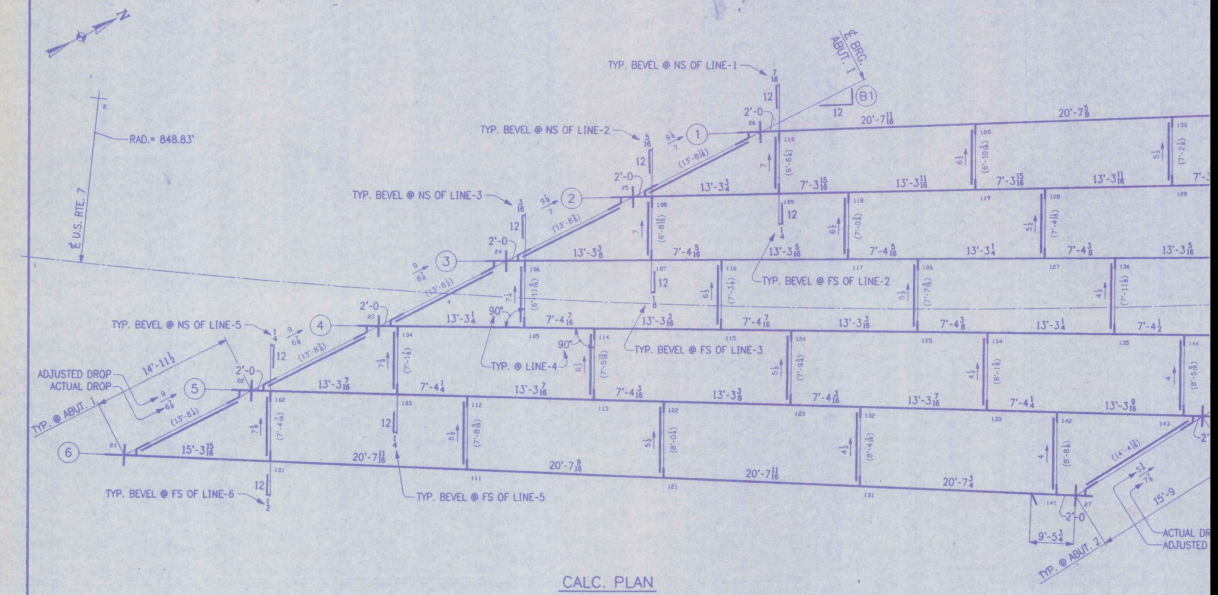

TYP. ELEVATION

LINE	BLA	B1	B2	C
1	99'-11 1/4	5 9/16	6 15/16	11 5/8
2	99'-10 7/16	5 3/4	7 3/16	1'-0
3	99'-10 1/16	6	7 7/16	1'-0 1/4
4	99'-9 15/16	6 1/4	7 11/16	1'-0 1/4
5	99'-10 1/8	6 1/2	7 15/16	1'-0 1/4
6	99'-10 5/8	6 3/4	8 1/4	1'-0

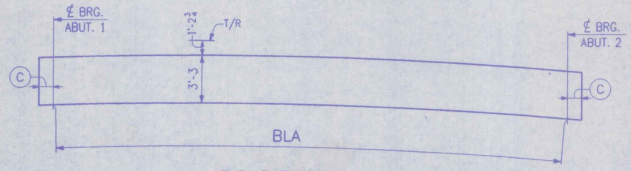