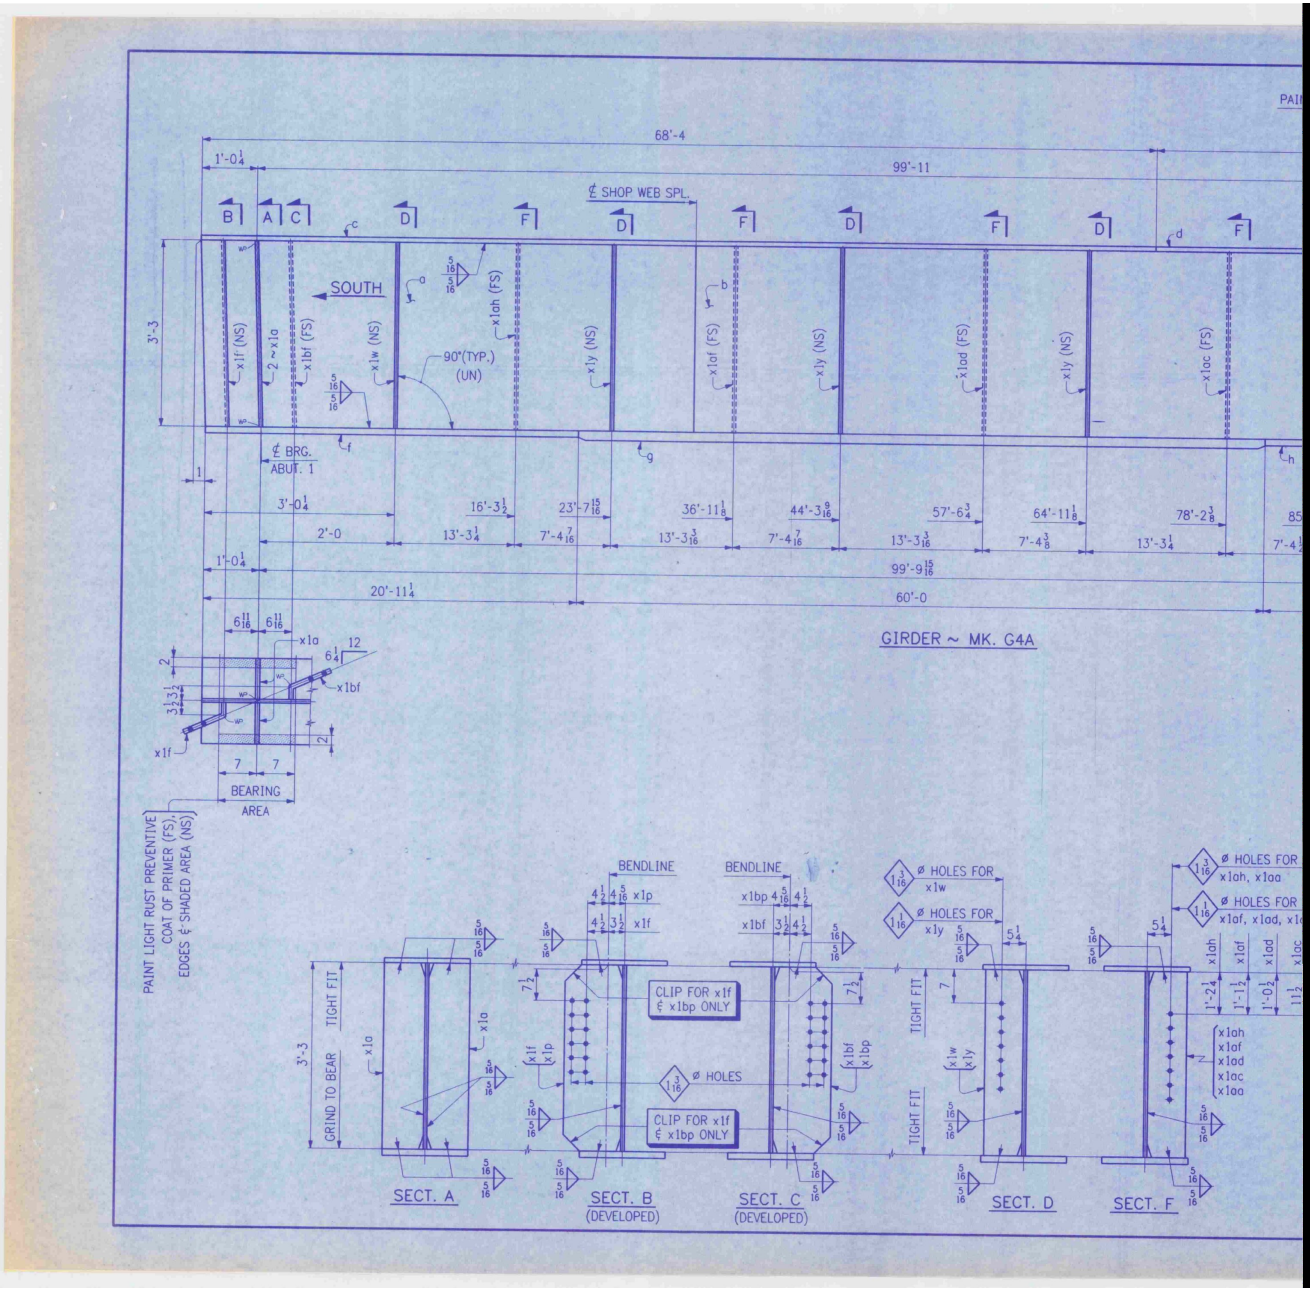
68'-4
99'-11
℄ SHOP WEB SPL.
SOUTH
90°(TYP.) (UN)
℄ BRG. ABUT. 1
GIRDER ~ MK. G4A
BEARING AREA
PAINT LIGHT RUST PREVENTIVE COAT OF PRIMER (FS). EDGES ℄ SHADED AREA (NS)
BENDLINE
CLIP FOR x1f ℄ x1bp ONLY
Ø HOLES
Ø HOLES FOR x1w
Ø HOLES FOR x1y
Ø HOLES FOR x1ah, x1aa
Ø HOLES FOR x1af, x1ad, x1
TIGHT FIT
GRIND TO BEAR
SECT. A
SECT. B (DEVELOPED)
SECT. C (DEVELOPED)
SECT. D
SECT. F