

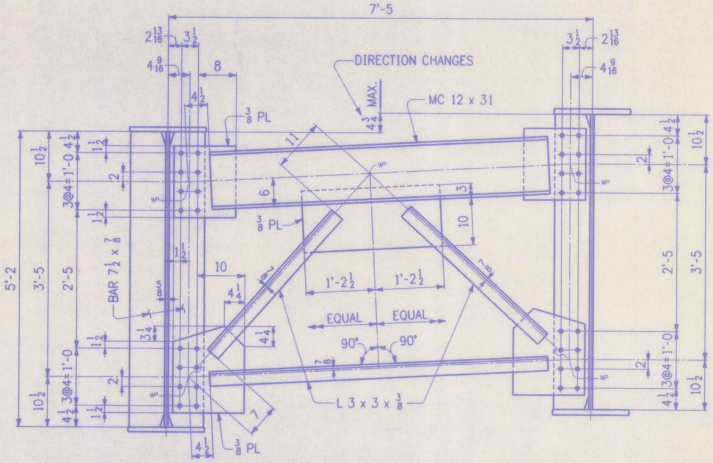


TYP. END AND PIER CROSSFRAME
(CFK14)

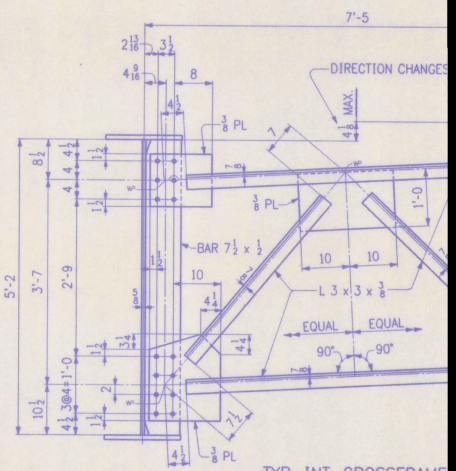

TYP. INT. CROSSFRAME
(CFK14)

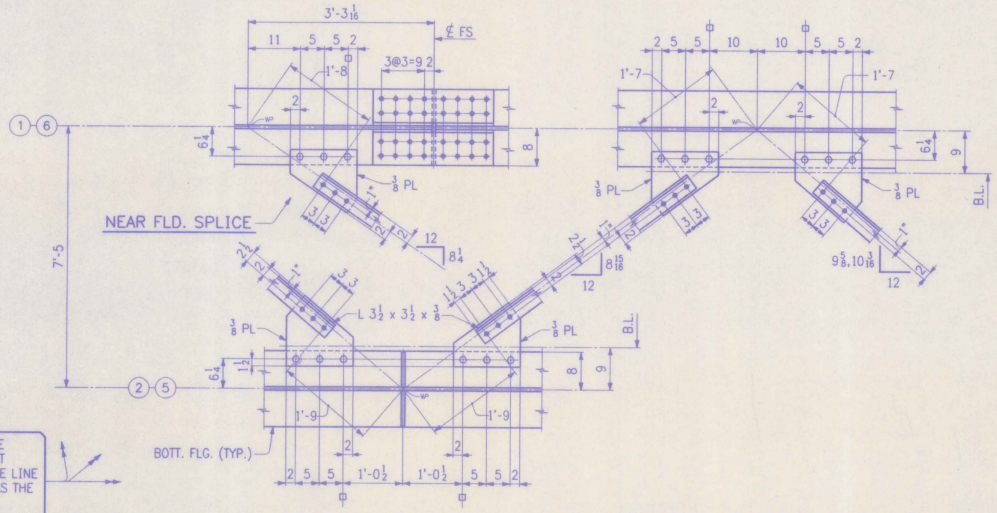

DETAILER NOTE: CARE MUST BE EXERCISED IN THE ASSIGNMENT OF GUSSET PLATE MARKS. GAGE LINE FOR HOLES IS NOT THE SAME AS THE "WL" AND PLATES CANNOT BE TURNED UPSIDE DOWN.

TYP. LATERAL BRACING

THIS IS A WO
PROVIDE BAS
USE IN THE
IT IS NOT IN
OR FABRICA