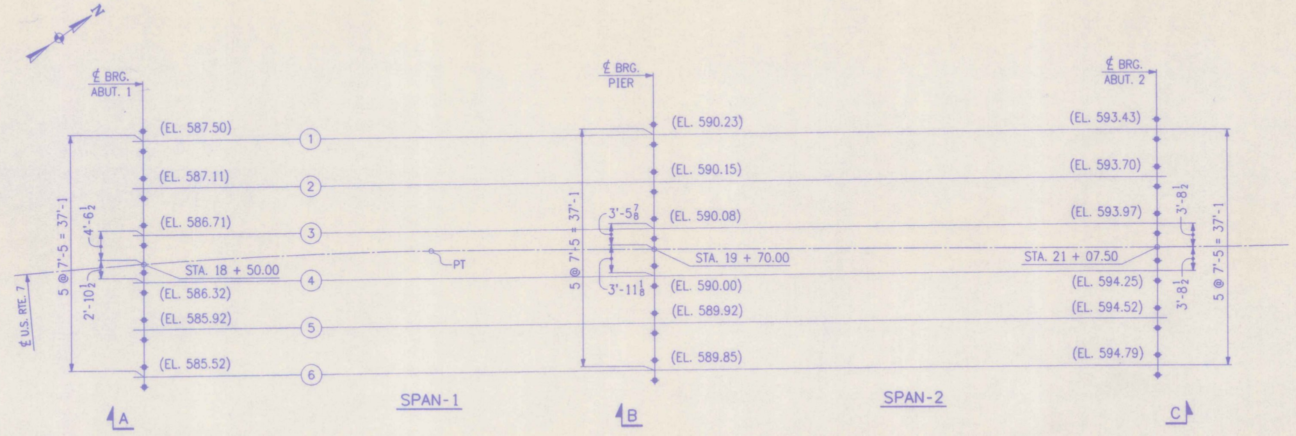

ANCHOR BOLT PLAN

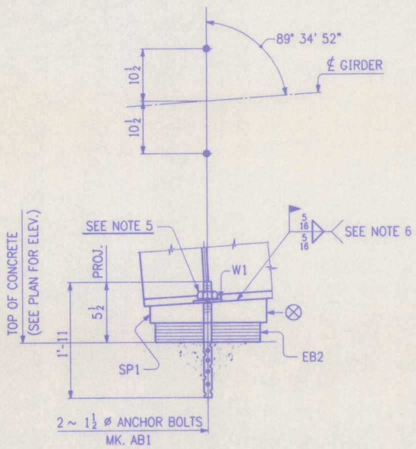

SECT. A
(TYP. @ ABUT. 1)

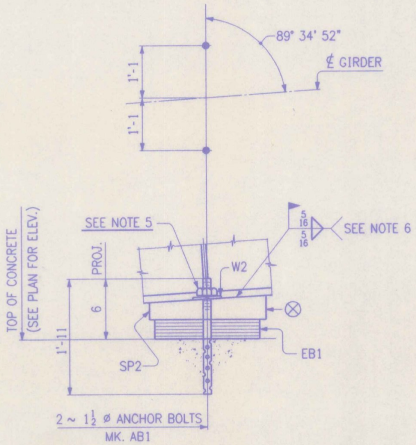

SECT. B
(TYP. @ PIER)

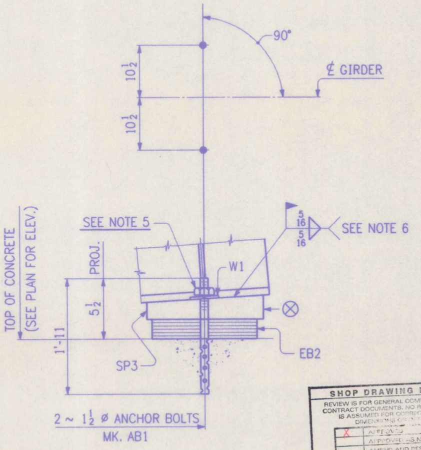

SECT. C
(TYP. @ ABUT. 2)

NOTES:

1. ALL DIME
2. ELEVATIO
3. ANCHOR
DETAIL IN
4. ANCHOR
STRUCTU
5. BACK NU
BURR TH
6. AREAS OF
SHALL BE
ACCORDA
7. ⊗ DENO

SHOP DRAWING REVIEW

REVIEW IS FOR GENERAL COMPLIANCE WITH CONTRACT DOCUMENTS. NO RESPONSIBILITY IS ASSUMED FOR CORRECTNESS OF DIMENSIONS OR DETAILS.

X	APPROVED
	APPROVED AS NOTED
	AMEND AND RESUBMIT
	REJECTED - SEE REMARKS

Barnes and Jarnis, Inc.
80 Boylston Street
Boston, Massachusetts 02116
DATE 2-23-96 BY JAB

NO.
HIGH
STATE O
OR REF
CONTRA
IN CHA
CONTRA
NUMBER

[redacted]