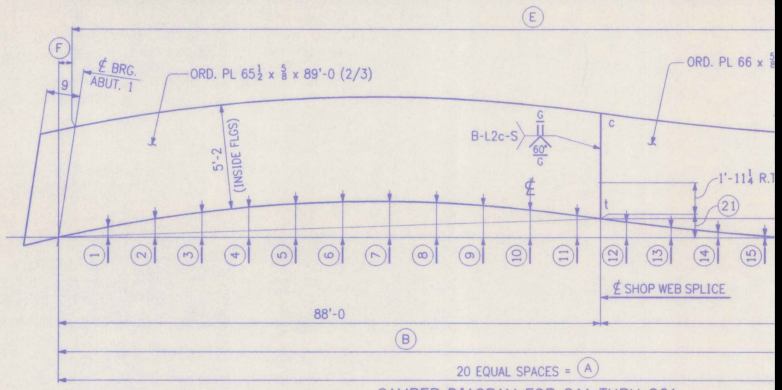

CAMBER DIAGRAM FOR G1A THRU G6A

MARK	A	B	C	D	E	F	G	1	2	3	4	5	6	7	8	9
G1A	150'-0 1/16	119'-11 7/8	30'-0 3/16	62'-0 1/16	149'-10 7/16	1 1/4	1 3/8	7/16	7/8	1 5/16	1 5/8	1 15/16	2 1/16	2 1/8	2	1
G2A	150'-0 3/16	120'-0	30'-0 3/16	62'-0 3/16	149'-10 3/8	1 7/16	1 9/16	7/16	7/8	1 5/16	1 11/16	1 15/16	2 1/8	2 1/8	2 1/16	1
G3A	150'-0 5/16	120'-0 1/16	30'-0 1/4	62'-0 5/16	149'-10 3/8	1 9/16	1 3/4	7/16	7/8	1 5/16	1 11/16	2	2 3/16	2 3/16	2 3/16	2
G4A	150'-0 7/16	120'-0 3/16	30'-0 1/4	62'-0 7/16	149'-10 5/16	1 3/4	1 7/8	7/16	7/8	1 3/8	1 3/4	2 1/16	2 1/4	2 5/16	2 1/4	2 1
G5A	150'-0 5/8	120'-0 5/16	30'-0 5/16	62'-0 5/8	149'-10 5/16	1 15/16	2 1/16	7/16	15/16	1 3/8	1 13/16	2 1/8	2 5/16	2 3/8	2 3/8	2 1
G6A	150'-0 13/16	120'-0 1/2	30'-0 5/16	62'-0 13/16	149'-10 3/8	2 1/16	2 1/4	7/16	15/16	1 7/16	1 7/8	2 3/16	2 7/16	2 1/2	2 1/2	2 1

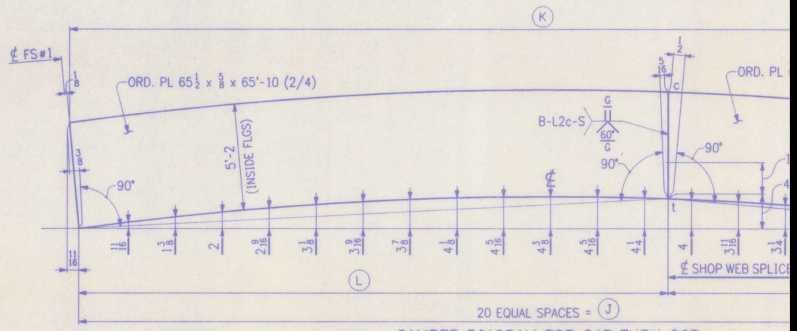

CAMBER DIAGRAM FOR G1B THRU G6B

MARK	J	K	L	M	N
G1B	107'-5 3/4	107'-8 3/16	65'-5 3/4	1 3/4	1 1/4
G2B	107'-5 13/16	107'-8 3/8	65'-5 13/16	1 7/8	1 3/8
G3B	107'-5 7/8	107'-8 5/8	65'-5 7/8	2 1/16	1 9/16
G4B	107'-6	107'-8 7/8	65'-6	2 3/16	1 11/16
G5B	107'-6 1/16	107'-9 1/8	65'-6 1/16	2 3/8	1 7/8
G6B	107'-6 3/16	107'-9 3/8	65'-6 3/16	2 1/2	2