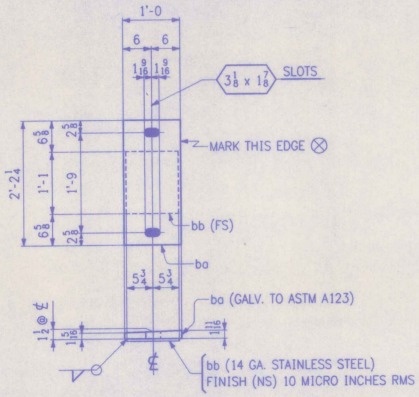

SOLE PLATES ~ MK. SP1

(ABUT. 1)

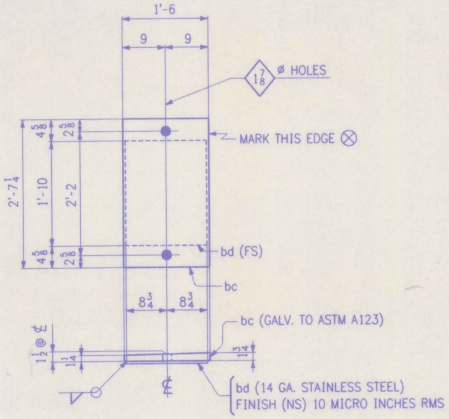

SOLE PLATES ~ MK. SP2

(PIER)

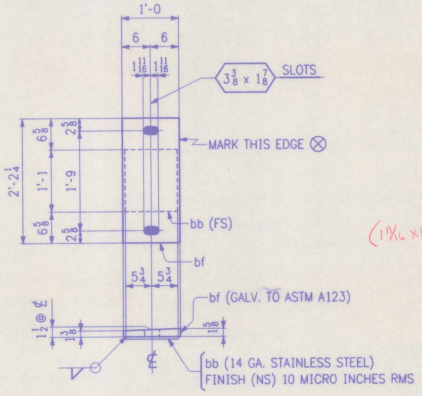

SOLE PLATES ~ MK. SP3

(ABUT. 2)

(1 9/16 x 1 5/16)

NO.	MARK
6	SP1
6	ba
6	bb
6	SP2
6	bc
6	bd
6	SP3
6	bf
6	bb
36	AB1
24	W1
12	W2
6	EB1
12	EB2

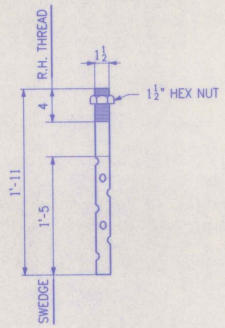

ANCHOR BOLTS ~ MK. AB1

(GALV. A153)

CODE: P

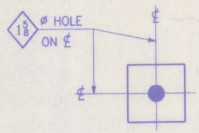

PLATE WASHERS ~ MK. W1

(ABUT.) (GALV. A153)

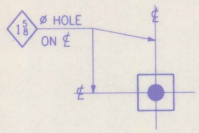

PLATE WASHERS ~ MK. W2

(PIER) (GALV. A153)

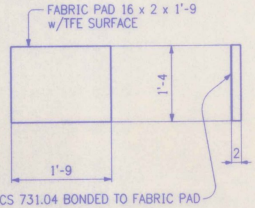

FABRIC PADS ~ EB1

(FIX) CODE: P

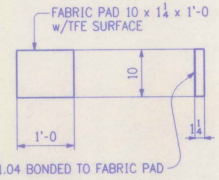

FABRIC PADS ~ EB2

(EXP.) CODE: P

SHOP DRAWING REVIEW

REVIEW IS FOR GENERAL CONFORMANCE WITH CONTRACT DOCUMENTS. NO RESPONSIBILITY IS ASSUMED FOR CONSTRUCTION DIMENSIONS OR QUANTITIES.

X APPROVED AS NOTED

APPROVED AS CORRECTED

RESUBMIT REVISED

REJECTED RESUBMIT

Barnes and Jarrett, Inc.

60 Boylston Street

Boston, Massachusetts 02116

DATE 1-30-14 BY JBC

SHOP NOTE

HOLES: AS NOTED

BOLTS: NONE

PAINT: NONE

FOR GENERAL SHOP NOTES, SEE DWG. N1.

CODE: 60 (UN)

NO.

HIGH STE

STATE CONTRA
OR REF. NO.

CONTRACTOR

IN CHARGE:

CONTRACT
NUMBER: