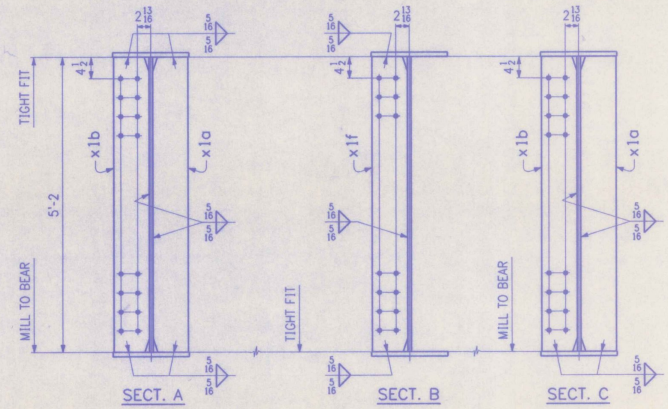

SECT. A SECT. B SECT. C

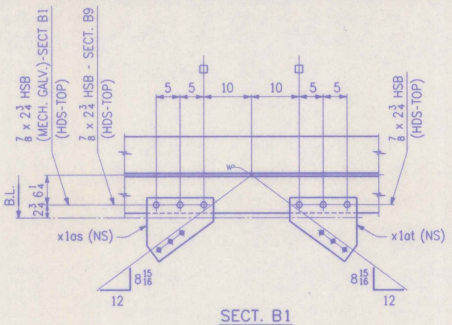

SECT. B1
(DEVELOPED)
SECT. B9
(DEVELOPED)

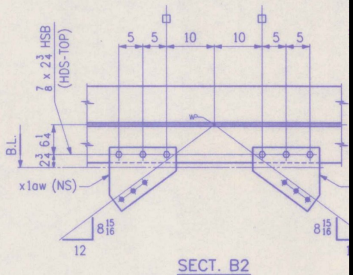

SECT. B2
(DEVELOPED)

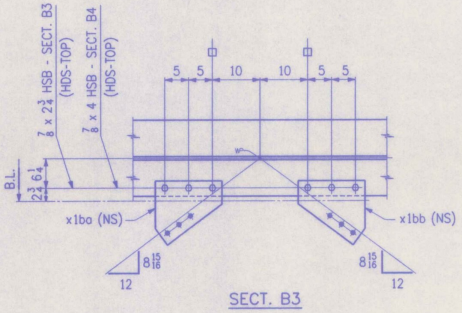

SECT. B3
SECT. B4
(DEVELOPED)

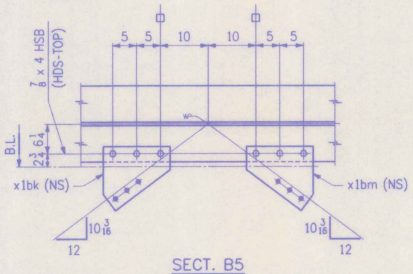

SECT. B5
(DEVELOPED)

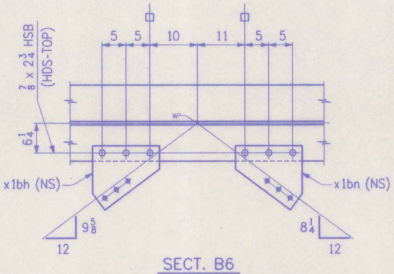

SECT. B6

SHOP DRAWING R
REVIEW IS FOR GENERAL COMPL
CONTRACT DOCUMENTS. NO RE
& ASSEMBLY
Barnes and Jarnis,
80 Boylston Street
Boston, Massachusetts 0
DATE 2-15-94 BY

SHOP NOTE
HOLES: 13/16ø (UN)
BOLTS: AS NOTED
PAINT: AS NOTED, SEE DWG. N1
FOR GENERAL SHOP NOTES, SEE DWG. N1
FOR WEB CAMBER DIAGRAM, SEE DWG. W

WORK THIS DWG. WITH DWG. 5