

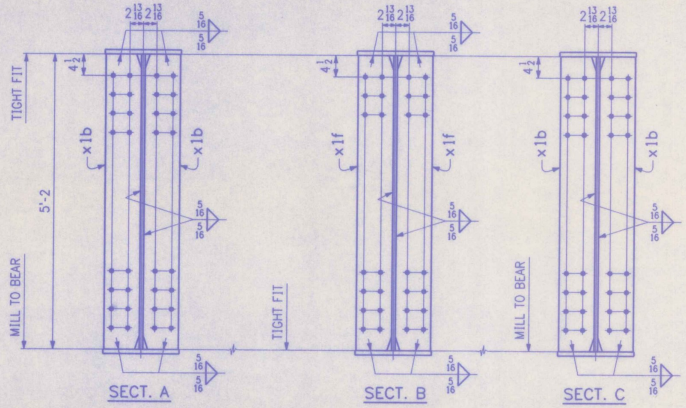



SECT. A SECT. B SECT. C

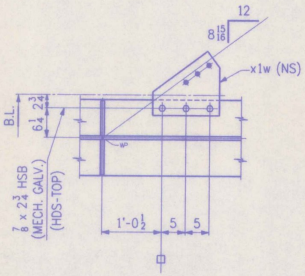


SECT. B1 (DEVELOPED)

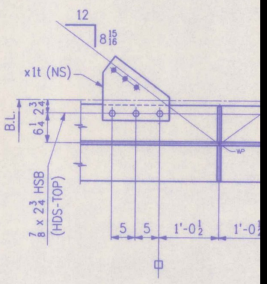


SECT. B2 (DEVELOPED)

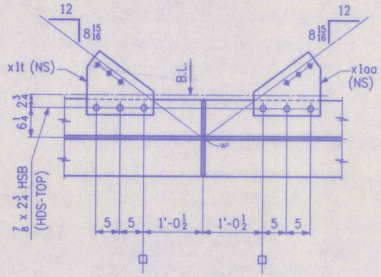


SECT. B3 (DEVELOPED)

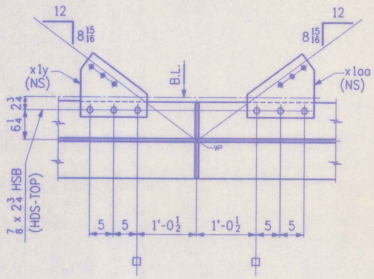


SECT. B4 (DEVELOPED)

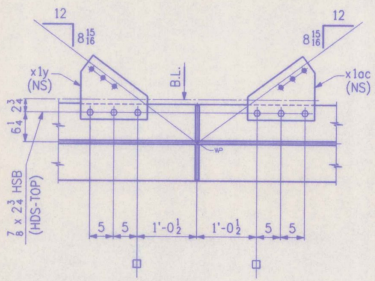


SECT. B5 (DEVELOPED)

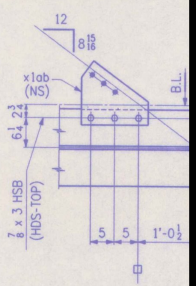

SEC (DEVE

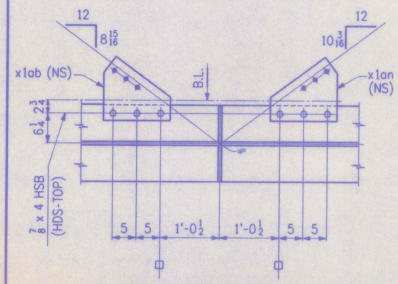

SECT. B7 (DEVELOPED)

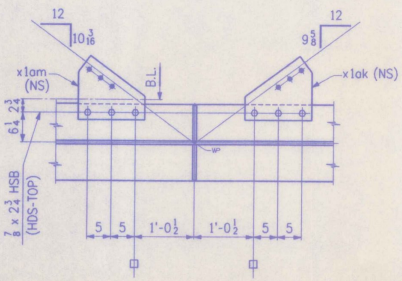

SECT. B8 (DEVELOPED)

SHOP NOTE
HOLES:
BOLTS: AS N
PAINT: AS N
FOR GENERAL
FOR WEB CAM

WORK THIS D