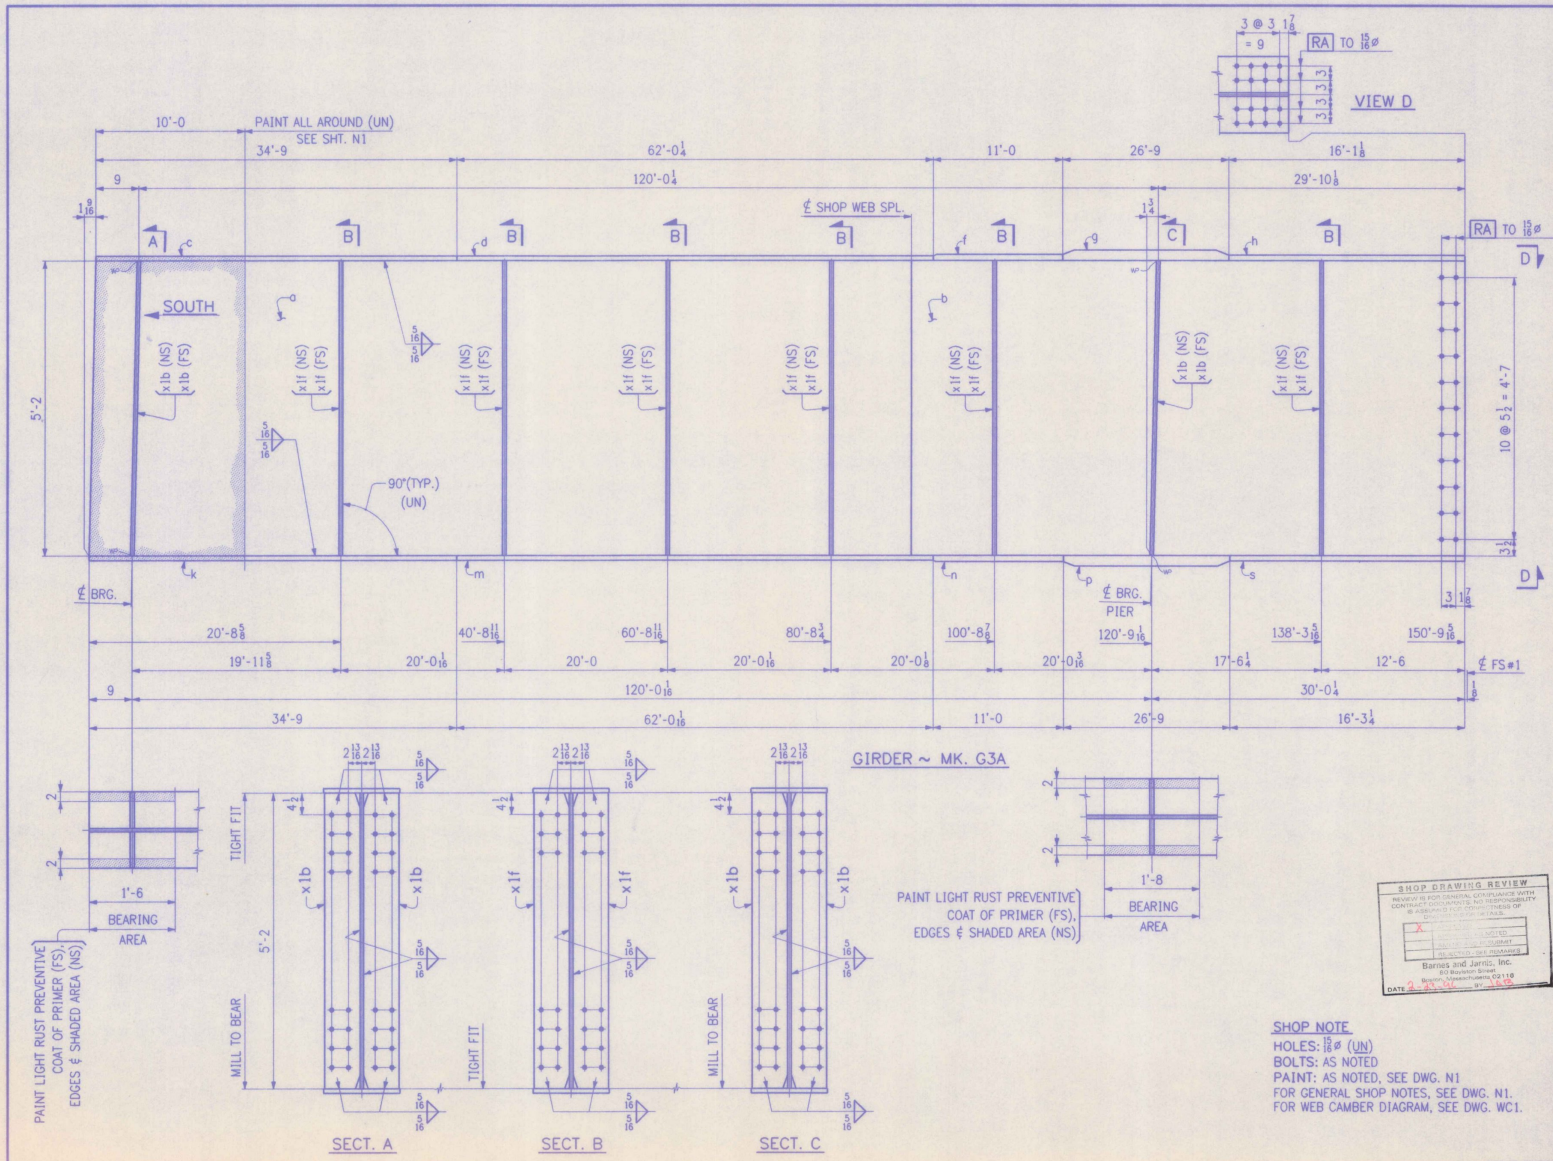

NO.	MARK	DESCRIPTION	LENGTH		
ONE	G3A	GIRDER			
1	a	PL 62 x $\frac{5}{8}$	88	9	(T)
1	b	PL 62 x $\frac{3}{8}$	62	$0\frac{5}{16}$	(T)
1	c	PL 16 x $\frac{15}{16}$	34	9	(T)
1	d	PL 16 x $\frac{15}{16}$	62	$0\frac{1}{4}$	(T)
1	f	PL 16 x $1\frac{1}{4}$	11	0	(T)
1	g	PL 16 x $2\frac{13}{16}$	26	9	(T)
1	h	PL 16 x $1\frac{1}{8}$	16	$1\frac{1}{8}$	(T)
1	k	PL 16 x $\frac{15}{16}$	34	9	(T)
1	m	PL 16 x $\frac{15}{16}$	62	$0\frac{1}{16}$	(T)
1	n	PL 16 x $1\frac{1}{4}$	11	0	(T)
1	p	PL 16 x $2\frac{13}{16}$	26	9	(T)
1	s	PL 16 x $1\frac{1}{8}$	16	$3\frac{1}{4}$	(T)
4	x1b	BAR $7\frac{1}{2}$ x $\frac{5}{8}$	5	2	
12	x1f	BAR $7\frac{1}{2}$ x $\frac{1}{2}$	5	2	

SHOP NOTE
HOLES: $\frac{15}{16}$ø (UN)
BOLTS: AS NOTED
PAINT: AS NOTED, SEE DWG. N1
FOR GENERAL SHOP NOTES, SEE DWG. N1.
FOR WEB CAMBER DIAGRAM, SEE DWG. WC1.

SHOP DRAWING REVIEW
REVIEW IS FOR GENERAL COMPLIANCE WITH CONTRACT DOCUMENTS. NO RESPONSIBILITY IS ASSUMED FOR CONSTRUCTION.
Barnes and Jarnis, Inc.
80 Boylston Street
Boston, Massachusetts 02116

NO. REVISION

HIGH STEEL STRUCTURES, INC.

GIRDER
U.S. ROUTE 7 OVER OTT
BRIDGE NO. 7
TOWN OF WALLINGFORD, COU
STATE OF VERMO
AGENCY OF TRANSPO

STATE CONTRACT OR REF. NO. PROJECT NO. BRS-013
CONTRACTOR J. A. McDONALD, INC.
IN CHARGE: abs MADE BY: PPP 2-1
CONTRACT NUMBER: VT-95367
CODE: 30
400-9