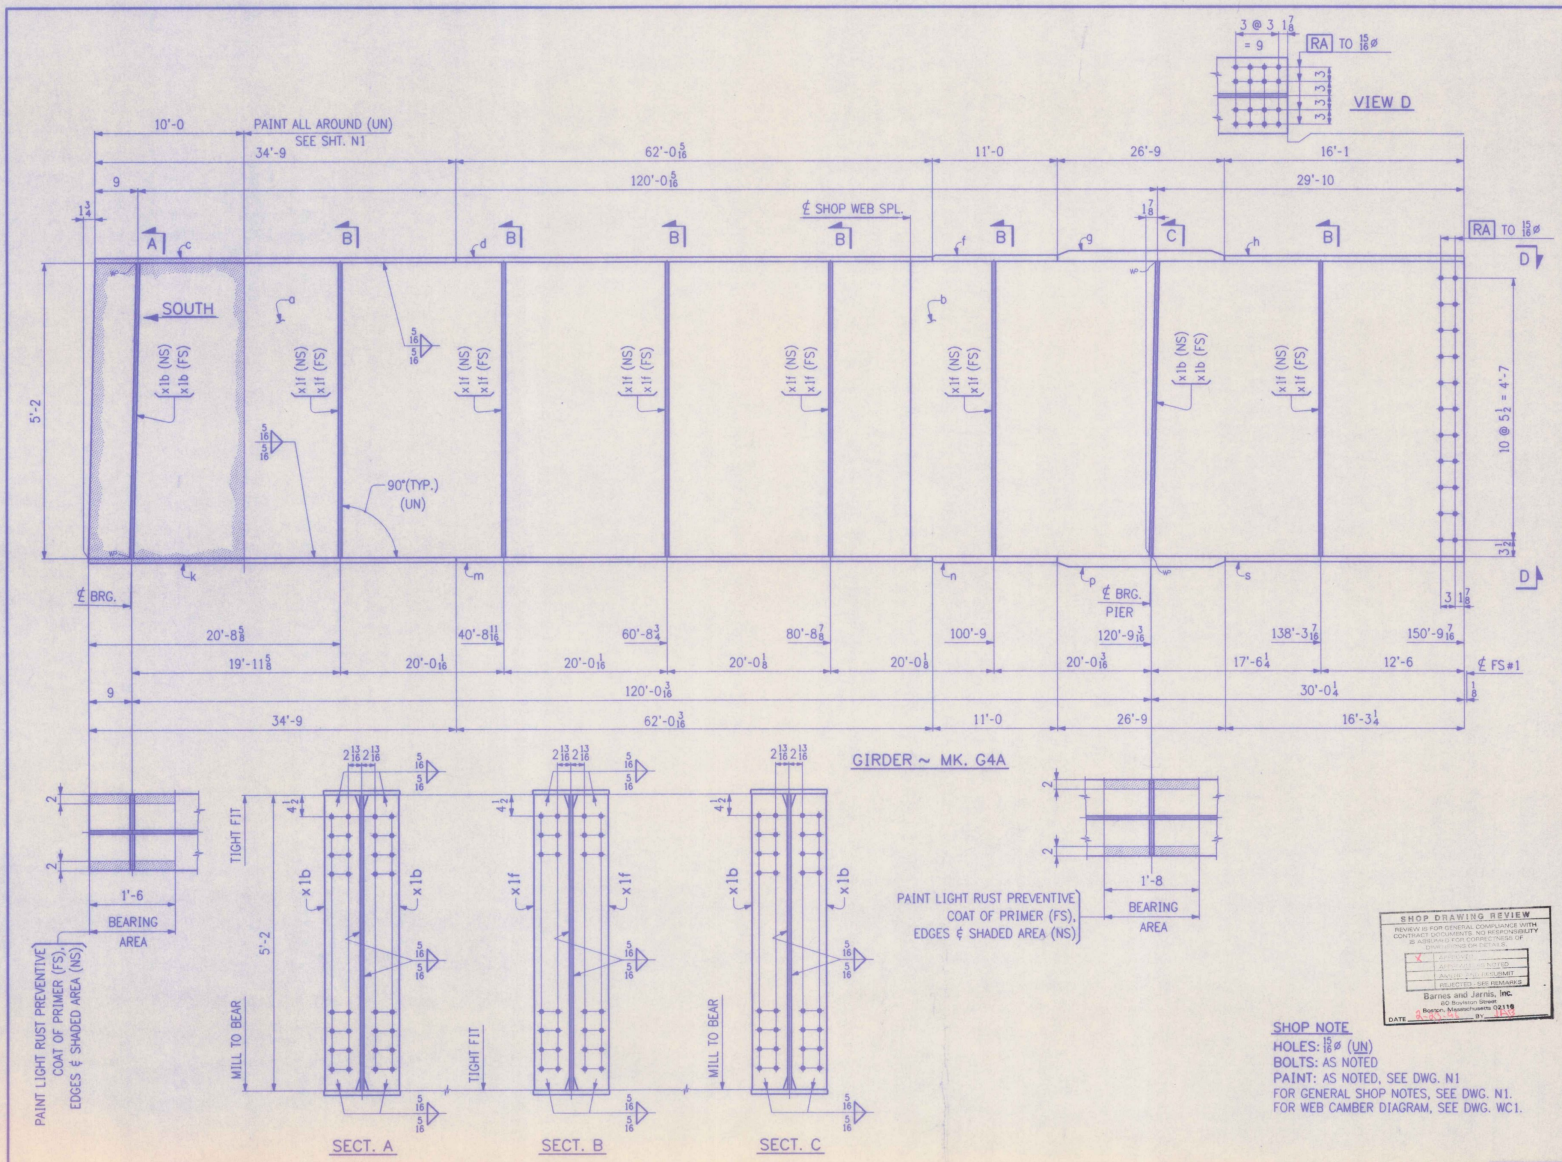

FED.ROAD DIV.NO.	STATE	FED. AID PROJ. NO.
	VT	

BILL OF MATERIAL

NO.	MARK	DESCRIPTION	LENGTH		REMARKS	ITEM	SHOP WEIGHT Lbs.
ONE	G4A	GIRDER					40865
1	a	PL 62 x 5/8	88	9	(T)	2/3	
1	b	PL 62 x 3/8	62	0 7/16	(T)	2/2	
1	c	PL 16 x 15/16	34	9	(T)	2/18	
1	d	PL 16 x 15/16	62	0 5/16	(T)	2/17	
1	f	PL 16 x 1 1/4	11	0	(T)	2/11	
1	g	PL 16 x 2 1/16	26	9	(T)	2/9	
1	h	PL 16 x 1 1/8	16	1	(T)	2/15	
1	k	PL 16 x 15/16	34	9	(T)	2/18	
1	m	PL 16 x 15/16	62	0 5/16	(T)	2/17	
1	n	PL 16 x 1 1/4	11	0	(T)	2/11	
1	p	PL 16 x 2 1/16	26	9	(T)	2/9	
1	s	PL 16 x 1 1/8	16	3 1/4	(T)	2/15	
4	x1b	BAR 7 1/2 x 7/8	5	2		3/12	
12	x1f	BAR 7 1/2 x 1/2	5	2		3/14	

SHOP DRAWING REVIEW
REVIEW IS FOR GENERAL COMPLIANCE WITH CONTRACT DOCUMENTS. NO RESPONSIBILITY IS ASSUMED FOR CORRECTNESS OF DIMENSIONS OR DETAILS.
APPROVED
APPROVED AS NOTED
RESUBMIT
REJECTED - SEE REMARKS
Barnes and Jarnis, Inc.
80 Boylston Street
Boston, Massachusetts 02116
DATE 4-25-96 BY

SHOP NOTE
HOLES: 15/16ø (UN)
BOLTS: AS NOTED
PAINT: AS NOTED, SEE DWG. N1
FOR GENERAL SHOP NOTES, SEE DWG. N1.
FOR WEB CAMBER DIAGRAM, SEE DWG. WC1.

CODE: 30

NO.	REVISION	DATE
△		
△		
△		

HIGH STEEL STRUCTURES, INC.
1770 Hempstead Road
Lancaster, PA 17605-0008
Phone 717/299-5211
A Division of High Industries, Inc.

GIRDER G4A
U.S. ROUTE 7 OVER OTTER CREEK
BRIDGE NO. 79
TOWN OF WALLINGFORD, COUNTY OF RUTLAND
STATE OF VERMONT
AGENCY OF TRANSPORTATION

STATE CONTRACT OR REF. NO. PROJECT NO. BRS-0137(13)
CONTRACTOR J. A. McDONALD, INC.
IN CHARGE: abs MADE BY: PPP 2-1 CHK'D BY: LD DATE: 2-2-96
CONTRACT NUMBER: VT-95367 DRAWING NUMBER: 10 OF 24

400-9 G4A-400