

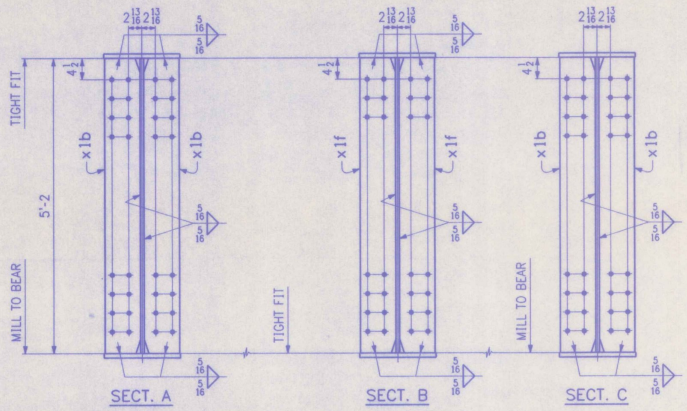



SECT. A SECT. B SECT. C

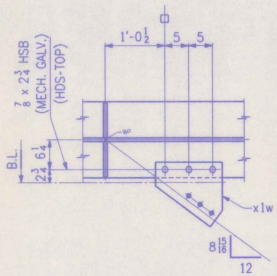


SECT. B1 (DEVELOPED)

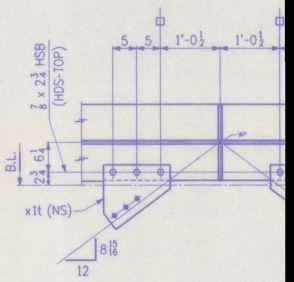


SECT. B2 (DEVELOPED)

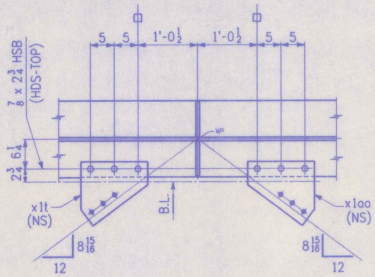


SECT. B3 (DEVELOPED)

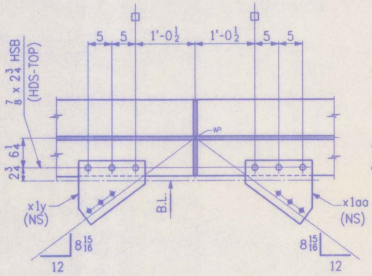


SECT. B4 (DEVELOPED)

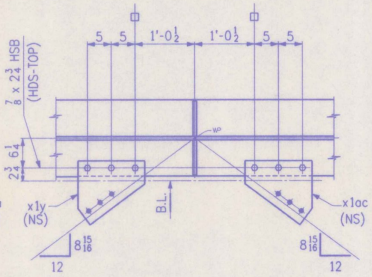


SECT. B5 (DEVELOPED)

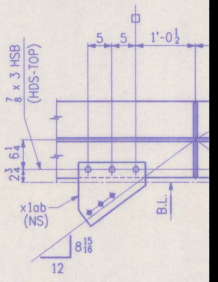

SECT. (DEVELO

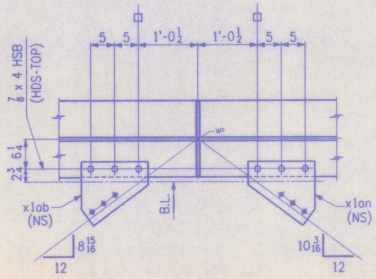

SECT. B7 (DEVELOPED)

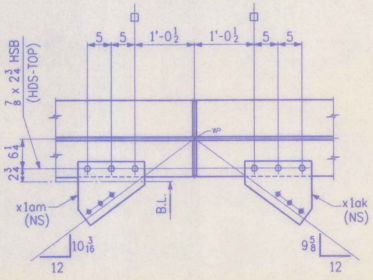

SECT. B8 (DEVELOPED)

SHOP NOTE
HOLES: 13/16ø (UN
BOLTS: AS NOTE
PAINT: AS NOTE
FOR GENERAL SH
FOR WEB CAMBE

WORK THIS DWG