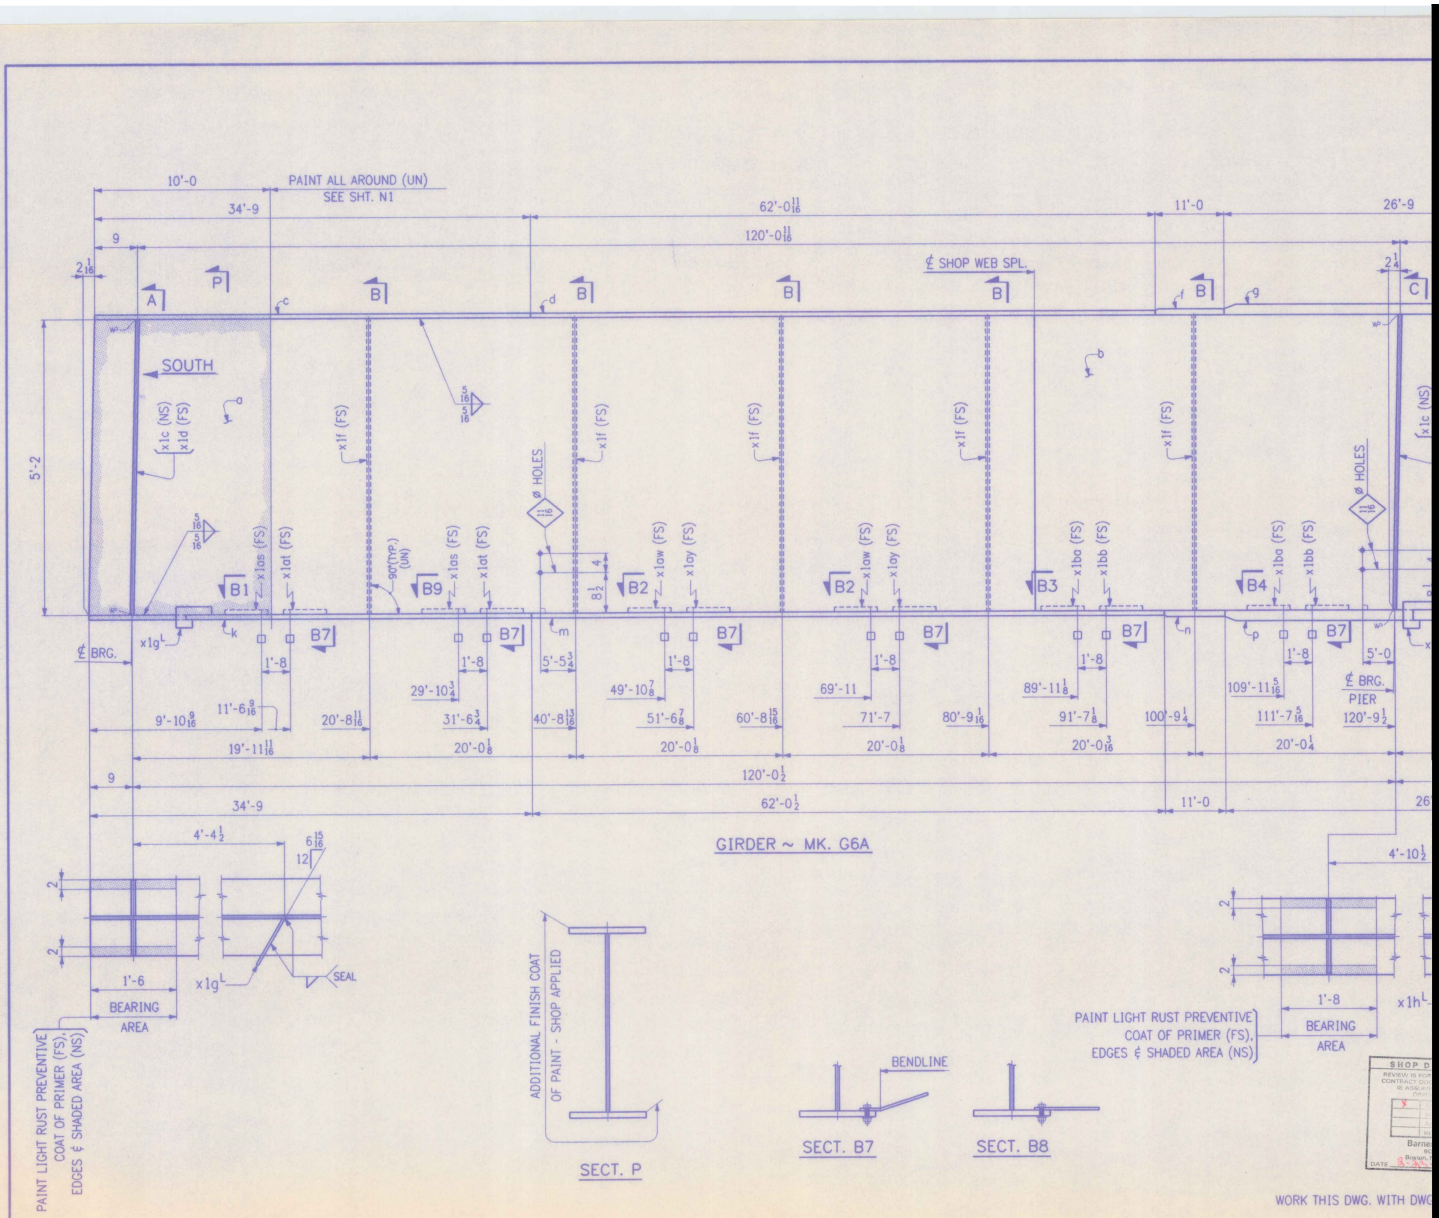

10'-0
PAINT ALL AROUND (UN)
SEE SHT. N1
34'-9
62'-0 11/16
120'-0 11/16
11'-0
26'-9
℄ SHOP WEB SPL.
SOUTH
5'-2
x1c (NS)
x1d (FS)
x1f (FS)
x1as (FS)
x1at (FS)
90°(TYP.) (UN)
x1aw (FS)
x1ay (FS)
x1ba (FS)
x1bb (FS)
Ø HOLES
B1
B9
B2
B3
B4
B7
℄ BRG.
x1g
x1h
1'-8
5'-0
℄ BRG. PIER
9'-10 9/16
11'-6 9/16
20'-8 1/16
29'-10 3/4
31'-6 3/4
40'-8 13/16
49'-10 7/8
51'-6 7/8
60'-8 15/16
69'-11
71'-7
80'-9 1/16
89'-11 1/8
91'-7 1/8
100'-9 1/4
109'-11 5/16
111'-7 5/16
120'-9 1/2
19'-11 11/16
20'-0 1/8
20'-0 3/8
20'-0 3/16
20'-0 1/4
120'-0 1/2
62'-0 1/2
GIRDER ~ MK. G6A
4'-4 1/2
4'-10 1/2
1'-6
BEARING AREA
SEAL
PAINT LIGHT RUST PREVENTIVE COAT OF PRIMER (FS), EDGES & SHADED AREA (NS)
ADDITIONAL FINISH COAT OF PAINT - SHOP APPLIED
SECT. P
BENDLINE
SECT. B7
SECT. B8
WORK THIS DWG. WITH DWG