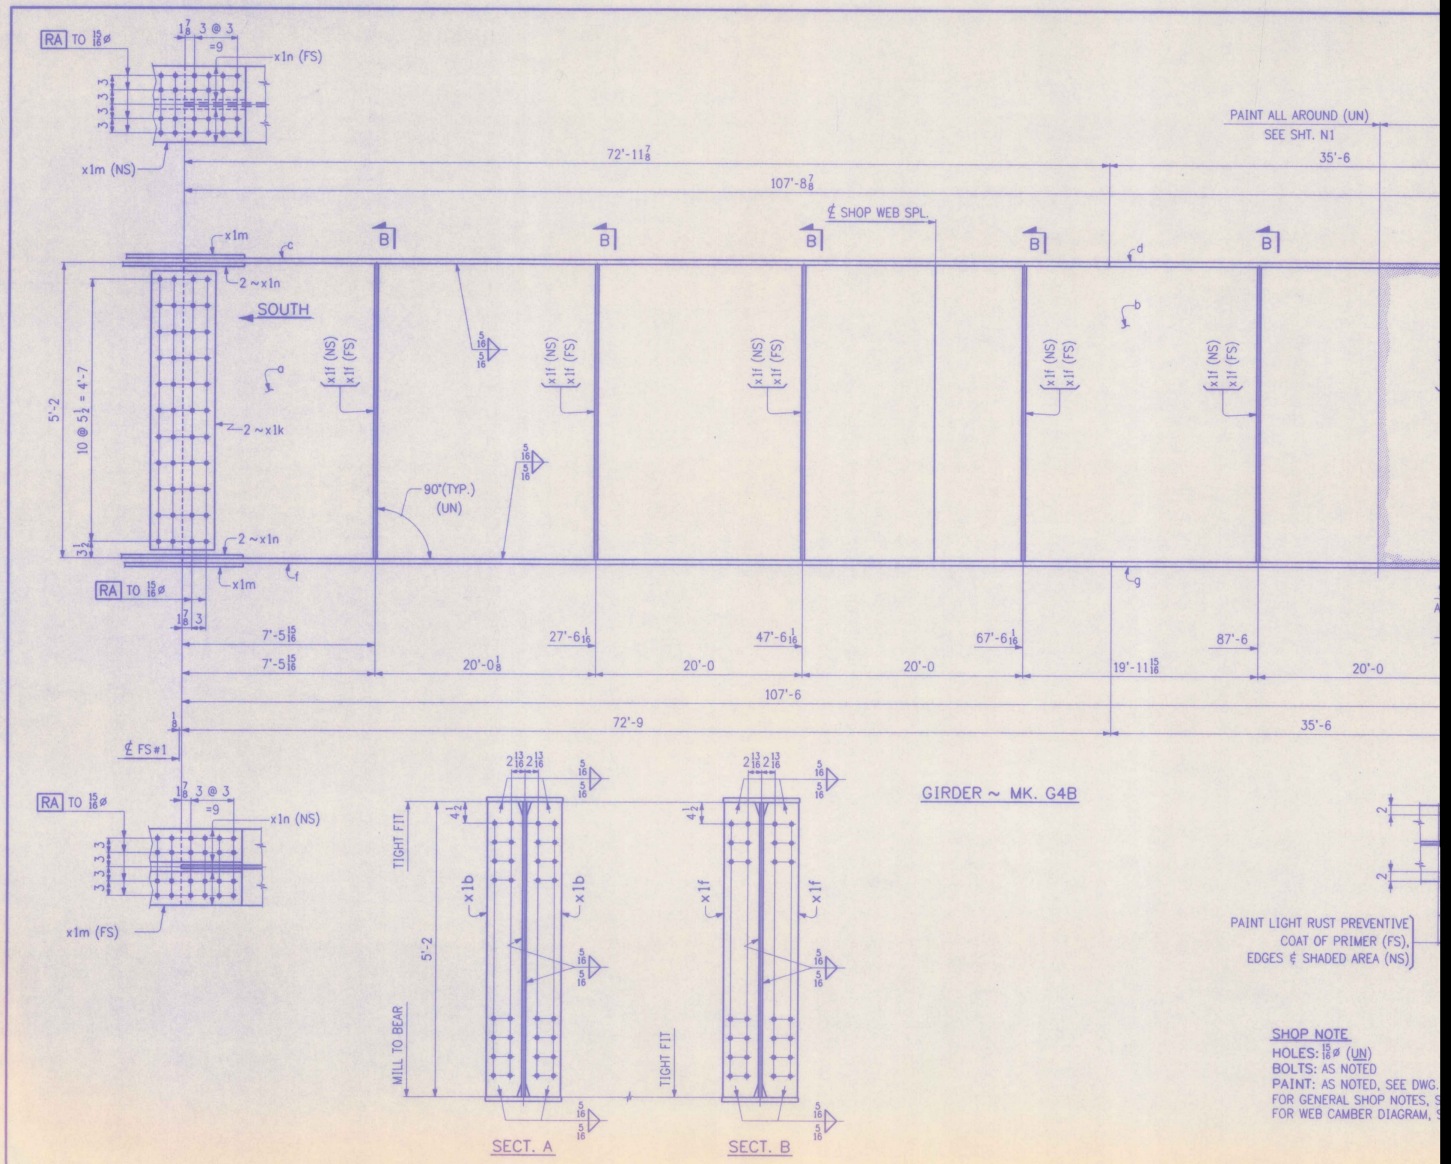

RA TO 15/16ø
1 7/8 3 @ 3 =9
x1n (FS)
3 3 3 3
x1m (NS)
PAINT ALL AROUND (UN)
SEE SHT. N1
35'-6
72'-11 7/8
107'-8 7/8
℄ SHOP WEB SPL.
x1m
2 ~x1n
SOUTH
x1f (NS)
x1f (FS)
5'-2
10 @ 5 1/2 = 4'-7
3 1/2
2 ~x1k
90°(TYP.)
(UN)
RA TO 15/16ø
x1m
1 7/8 3
7'-5 15/16
27'-6 1/16
47'-6 1/16
67'-6 1/16
87'-6
20'-0 1/8
20'-0
19'-11 15/16
107'-6
1/8
72'-9
℄ FS#1
RA TO 15/16ø
1 7/8 3 @ 3 =9
x1n (NS)
3 3 3 3
x1m (FS)
2 13/16 2 13/16
5/16
4 1/2
TIGHT FIT
x1b
5'-2
MILL TO BEAR
SECT. A
x1f
SECT. B
GIRDER ~ MK. G4B
PAINT LIGHT RUST PREVENTIVE
COAT OF PRIMER (FS),
EDGES ℄ SHADED AREA (NS)
SHOP NOTE
HOLES: 15/16ø (UN)
BOLTS: AS NOTED
PAINT: AS NOTED, SEE DWG.
FOR GENERAL SHOP NOTES, S
FOR WEB CAMBER DIAGRAM, S