


FINAL SURVEY NOTEBOOK	SURVEYED PLOTTED DATE AREAS CHECKED	BY	DATE
NO			

ORIGINAL SURVEY NOTEBOOK	SURVEYED PLOTTED DATE AREAS CHECKED	BY	DATE
NO			

8+28.5-88.76 (L=10)

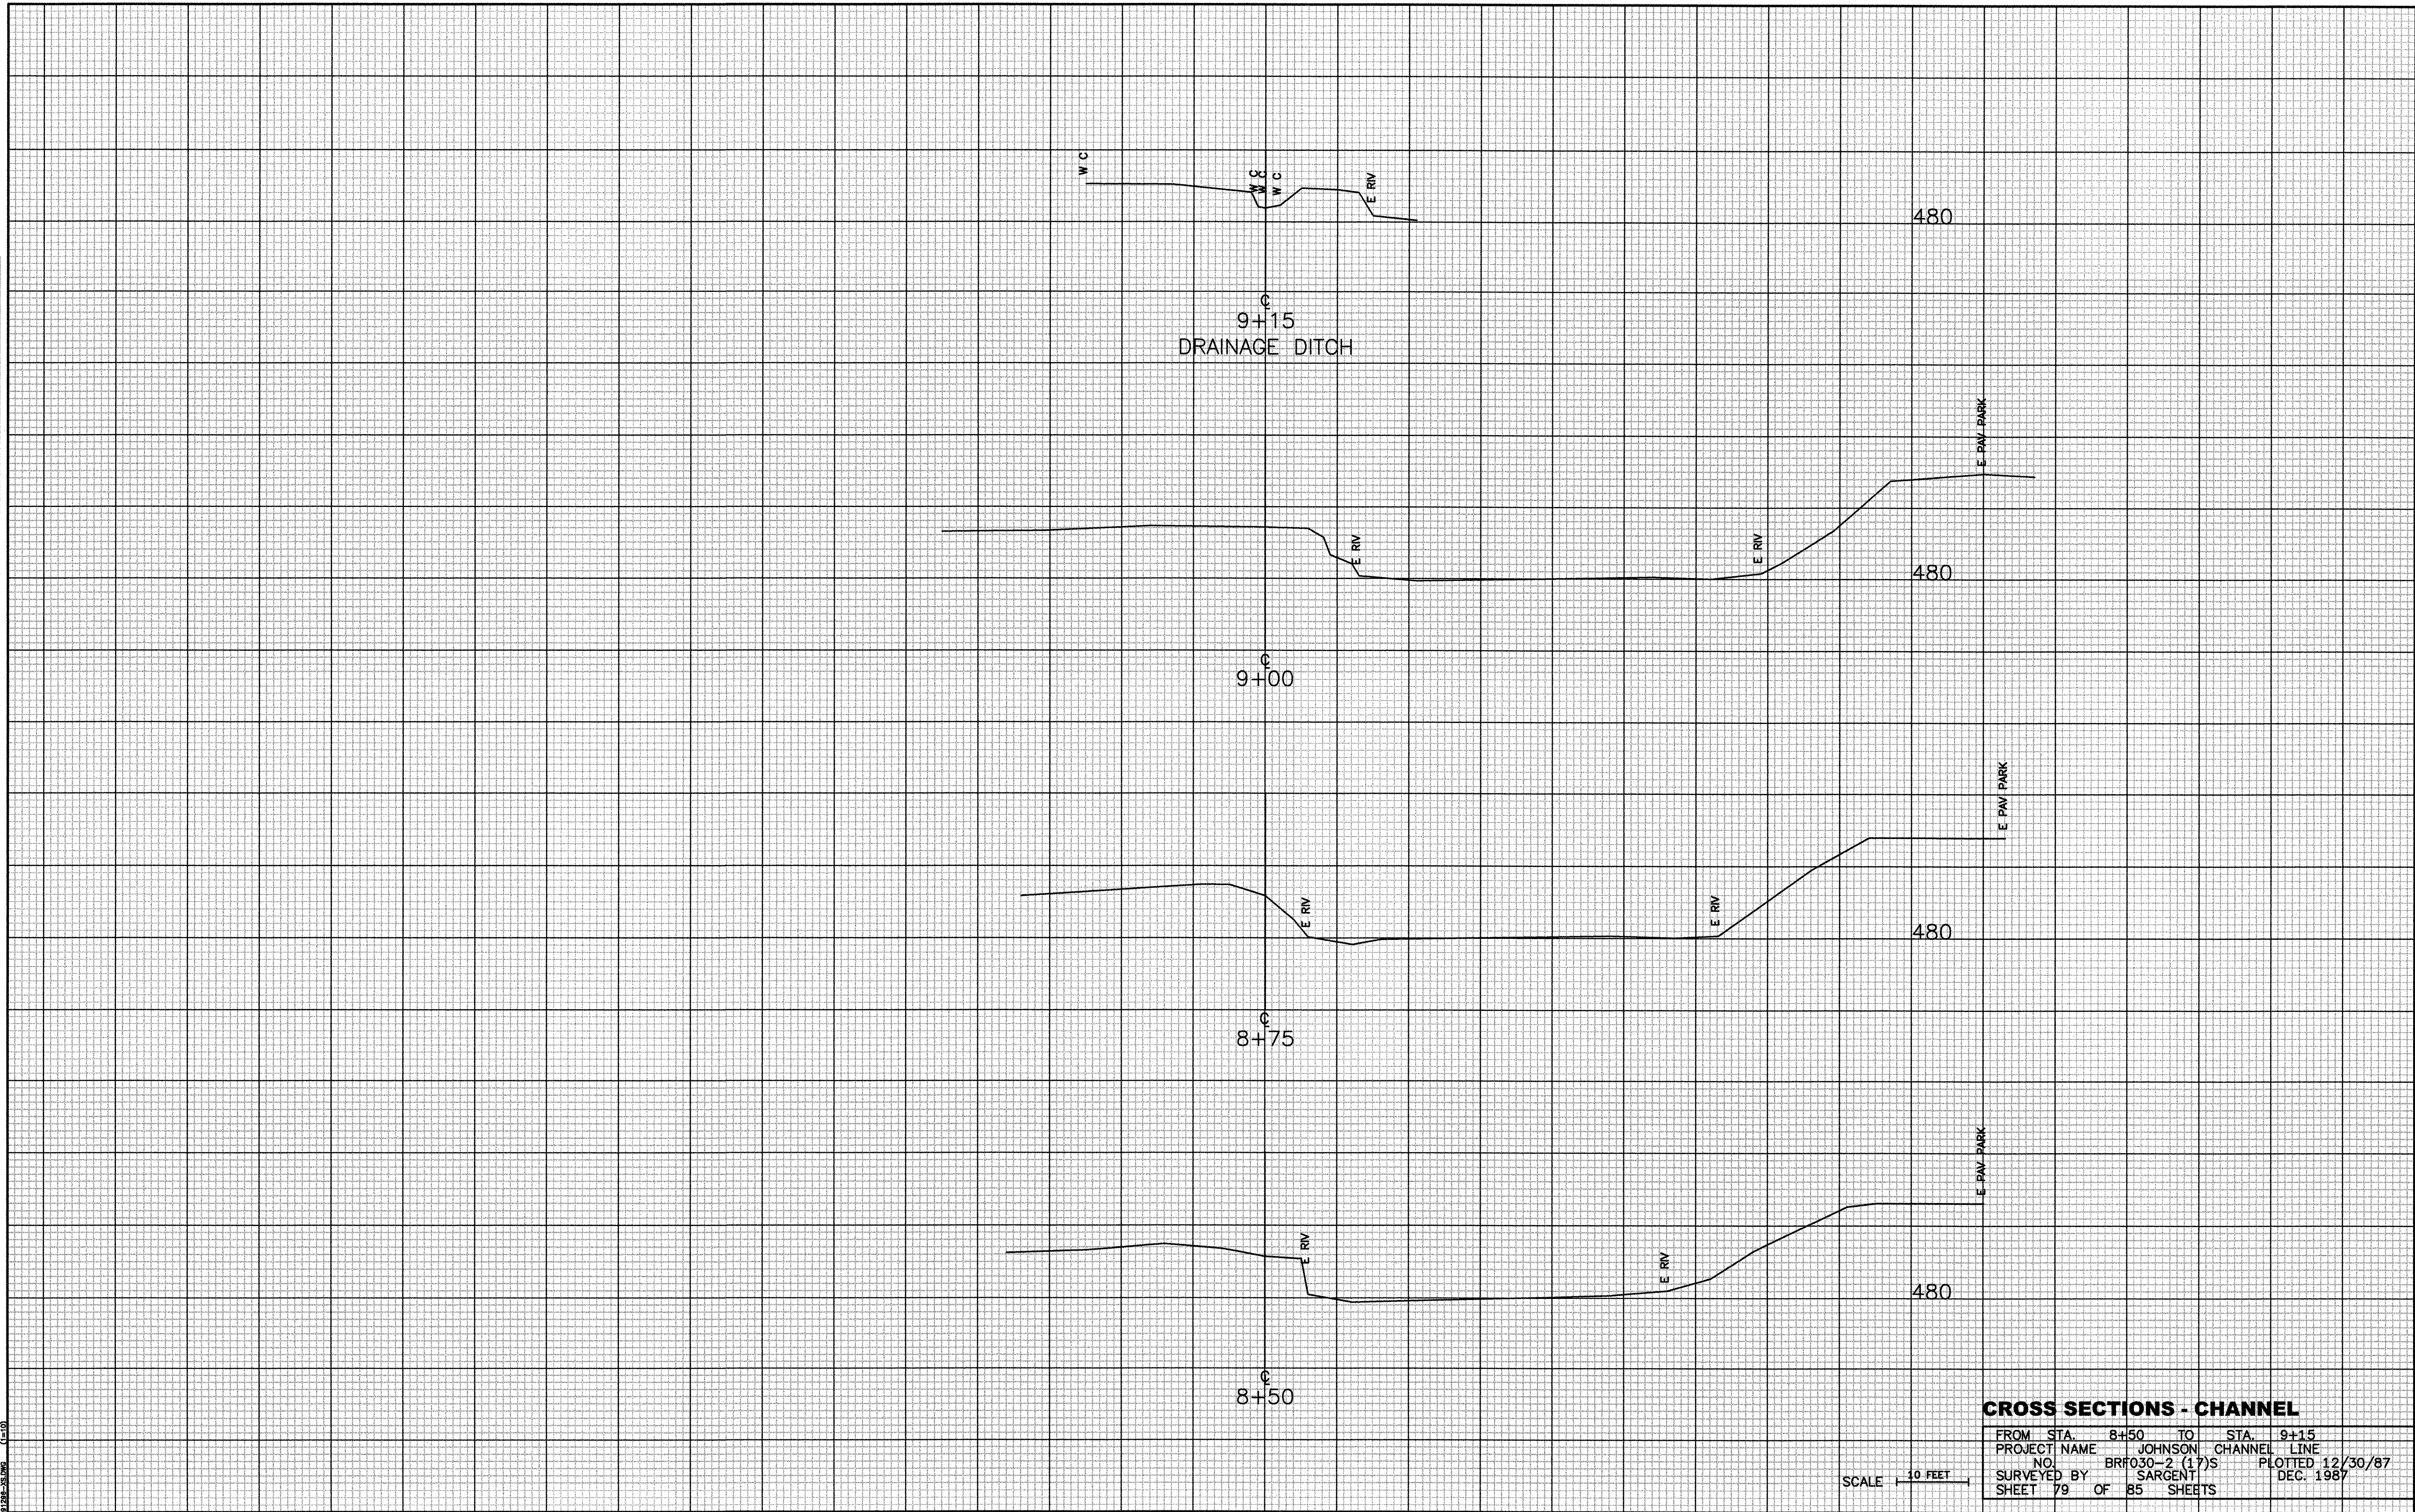

CROSS SECTIONS - CHANNEL

FROM STA.	8+50	TO STA.	9+15
PROJECT NAME	JOHNSON	CHANNEL LINE	
NO.	BRF030-2 (17)S	PLOTTED	12/30/87
SURVEYED BY	SARGENT	DEC.	1987
SHEET	79	OF	85 SHEETS