
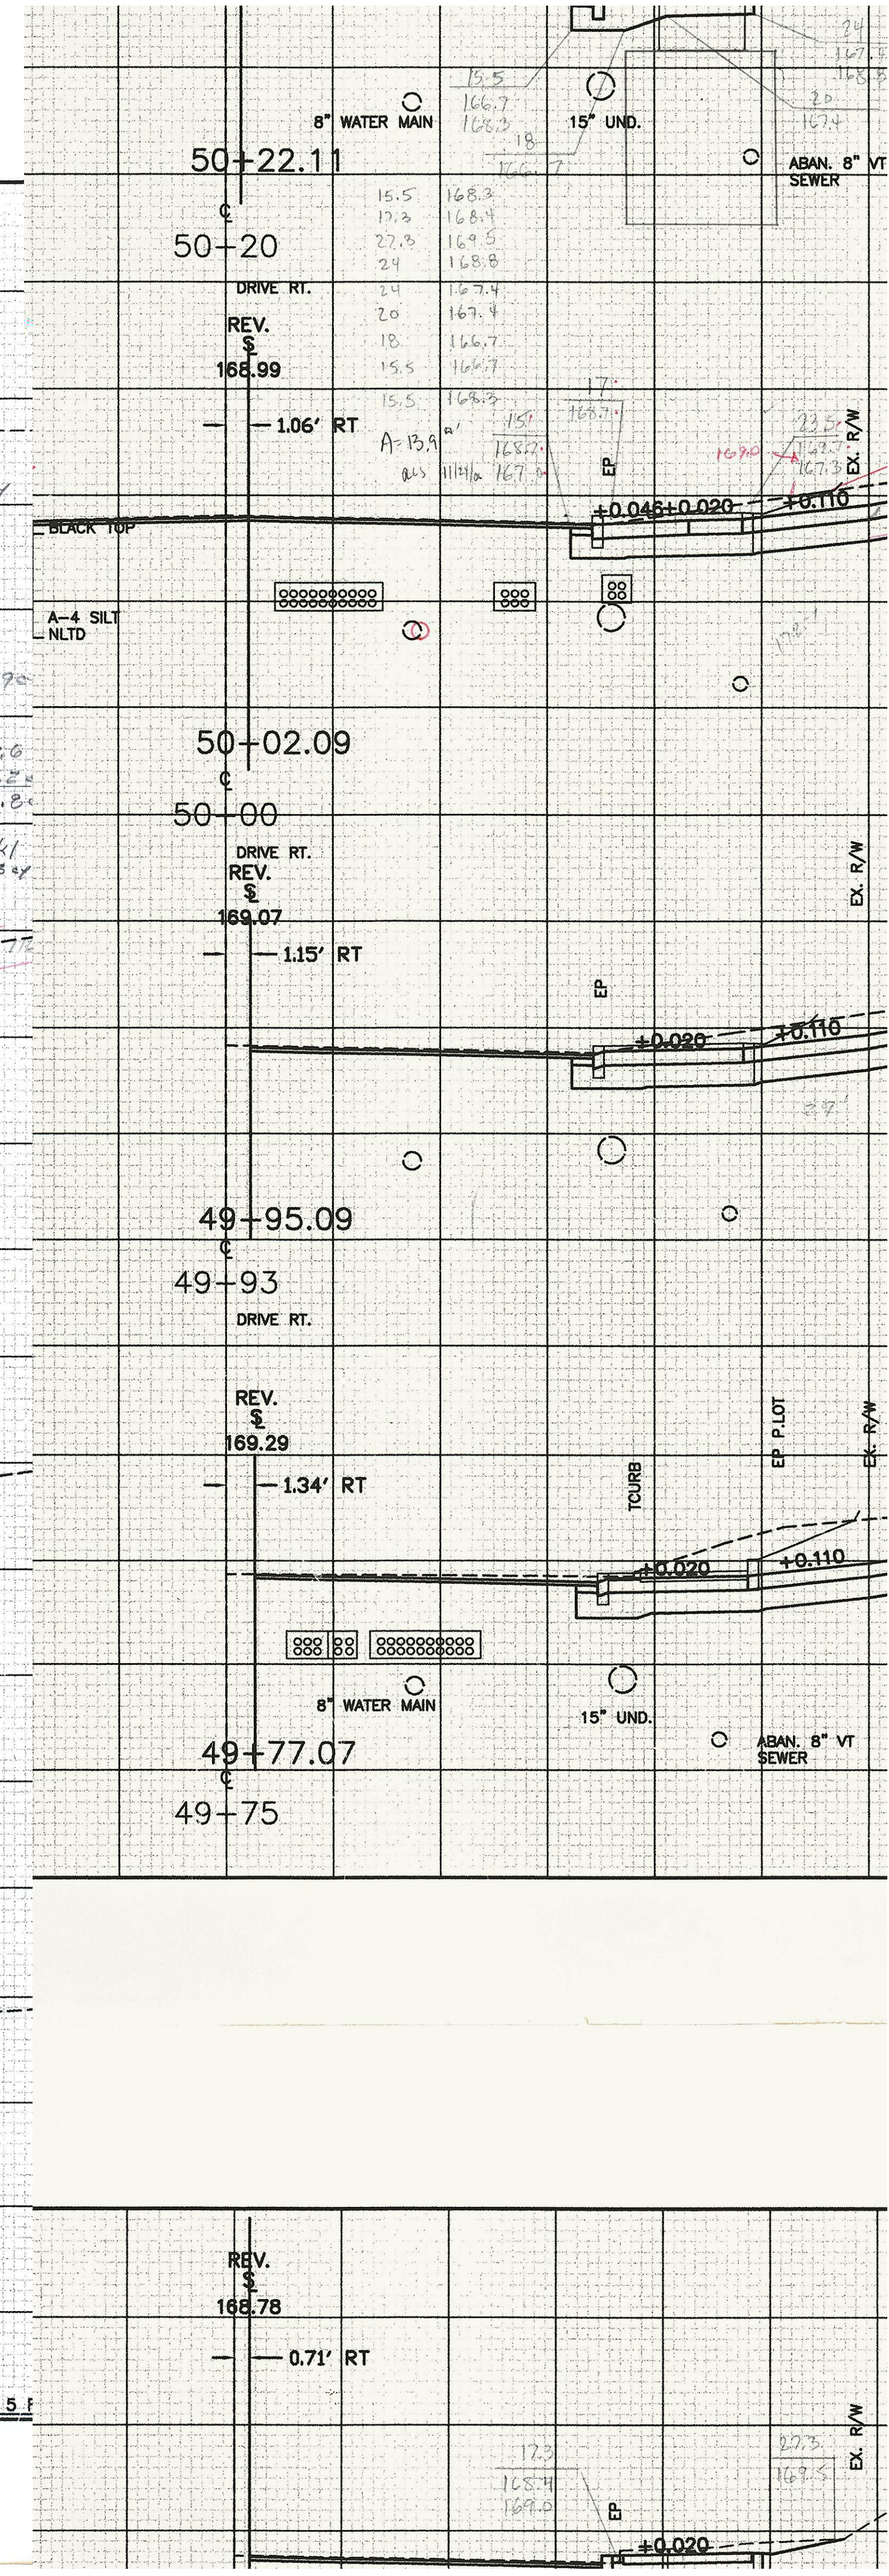


FINAL SURVEY	BY	DATE
SURVEYED		
PLOTTED		
TEMPLATE		
AREAS		
AREAS CHECKED		
NO		

ORIGINAL SURVEY	BY	DATE
SURVEYED		
PLOTTED		
TEMPLATE		
NOTEBOOK		
AREAS		
AREAS CHECKED		

39108XS4.DWG (1"=5')

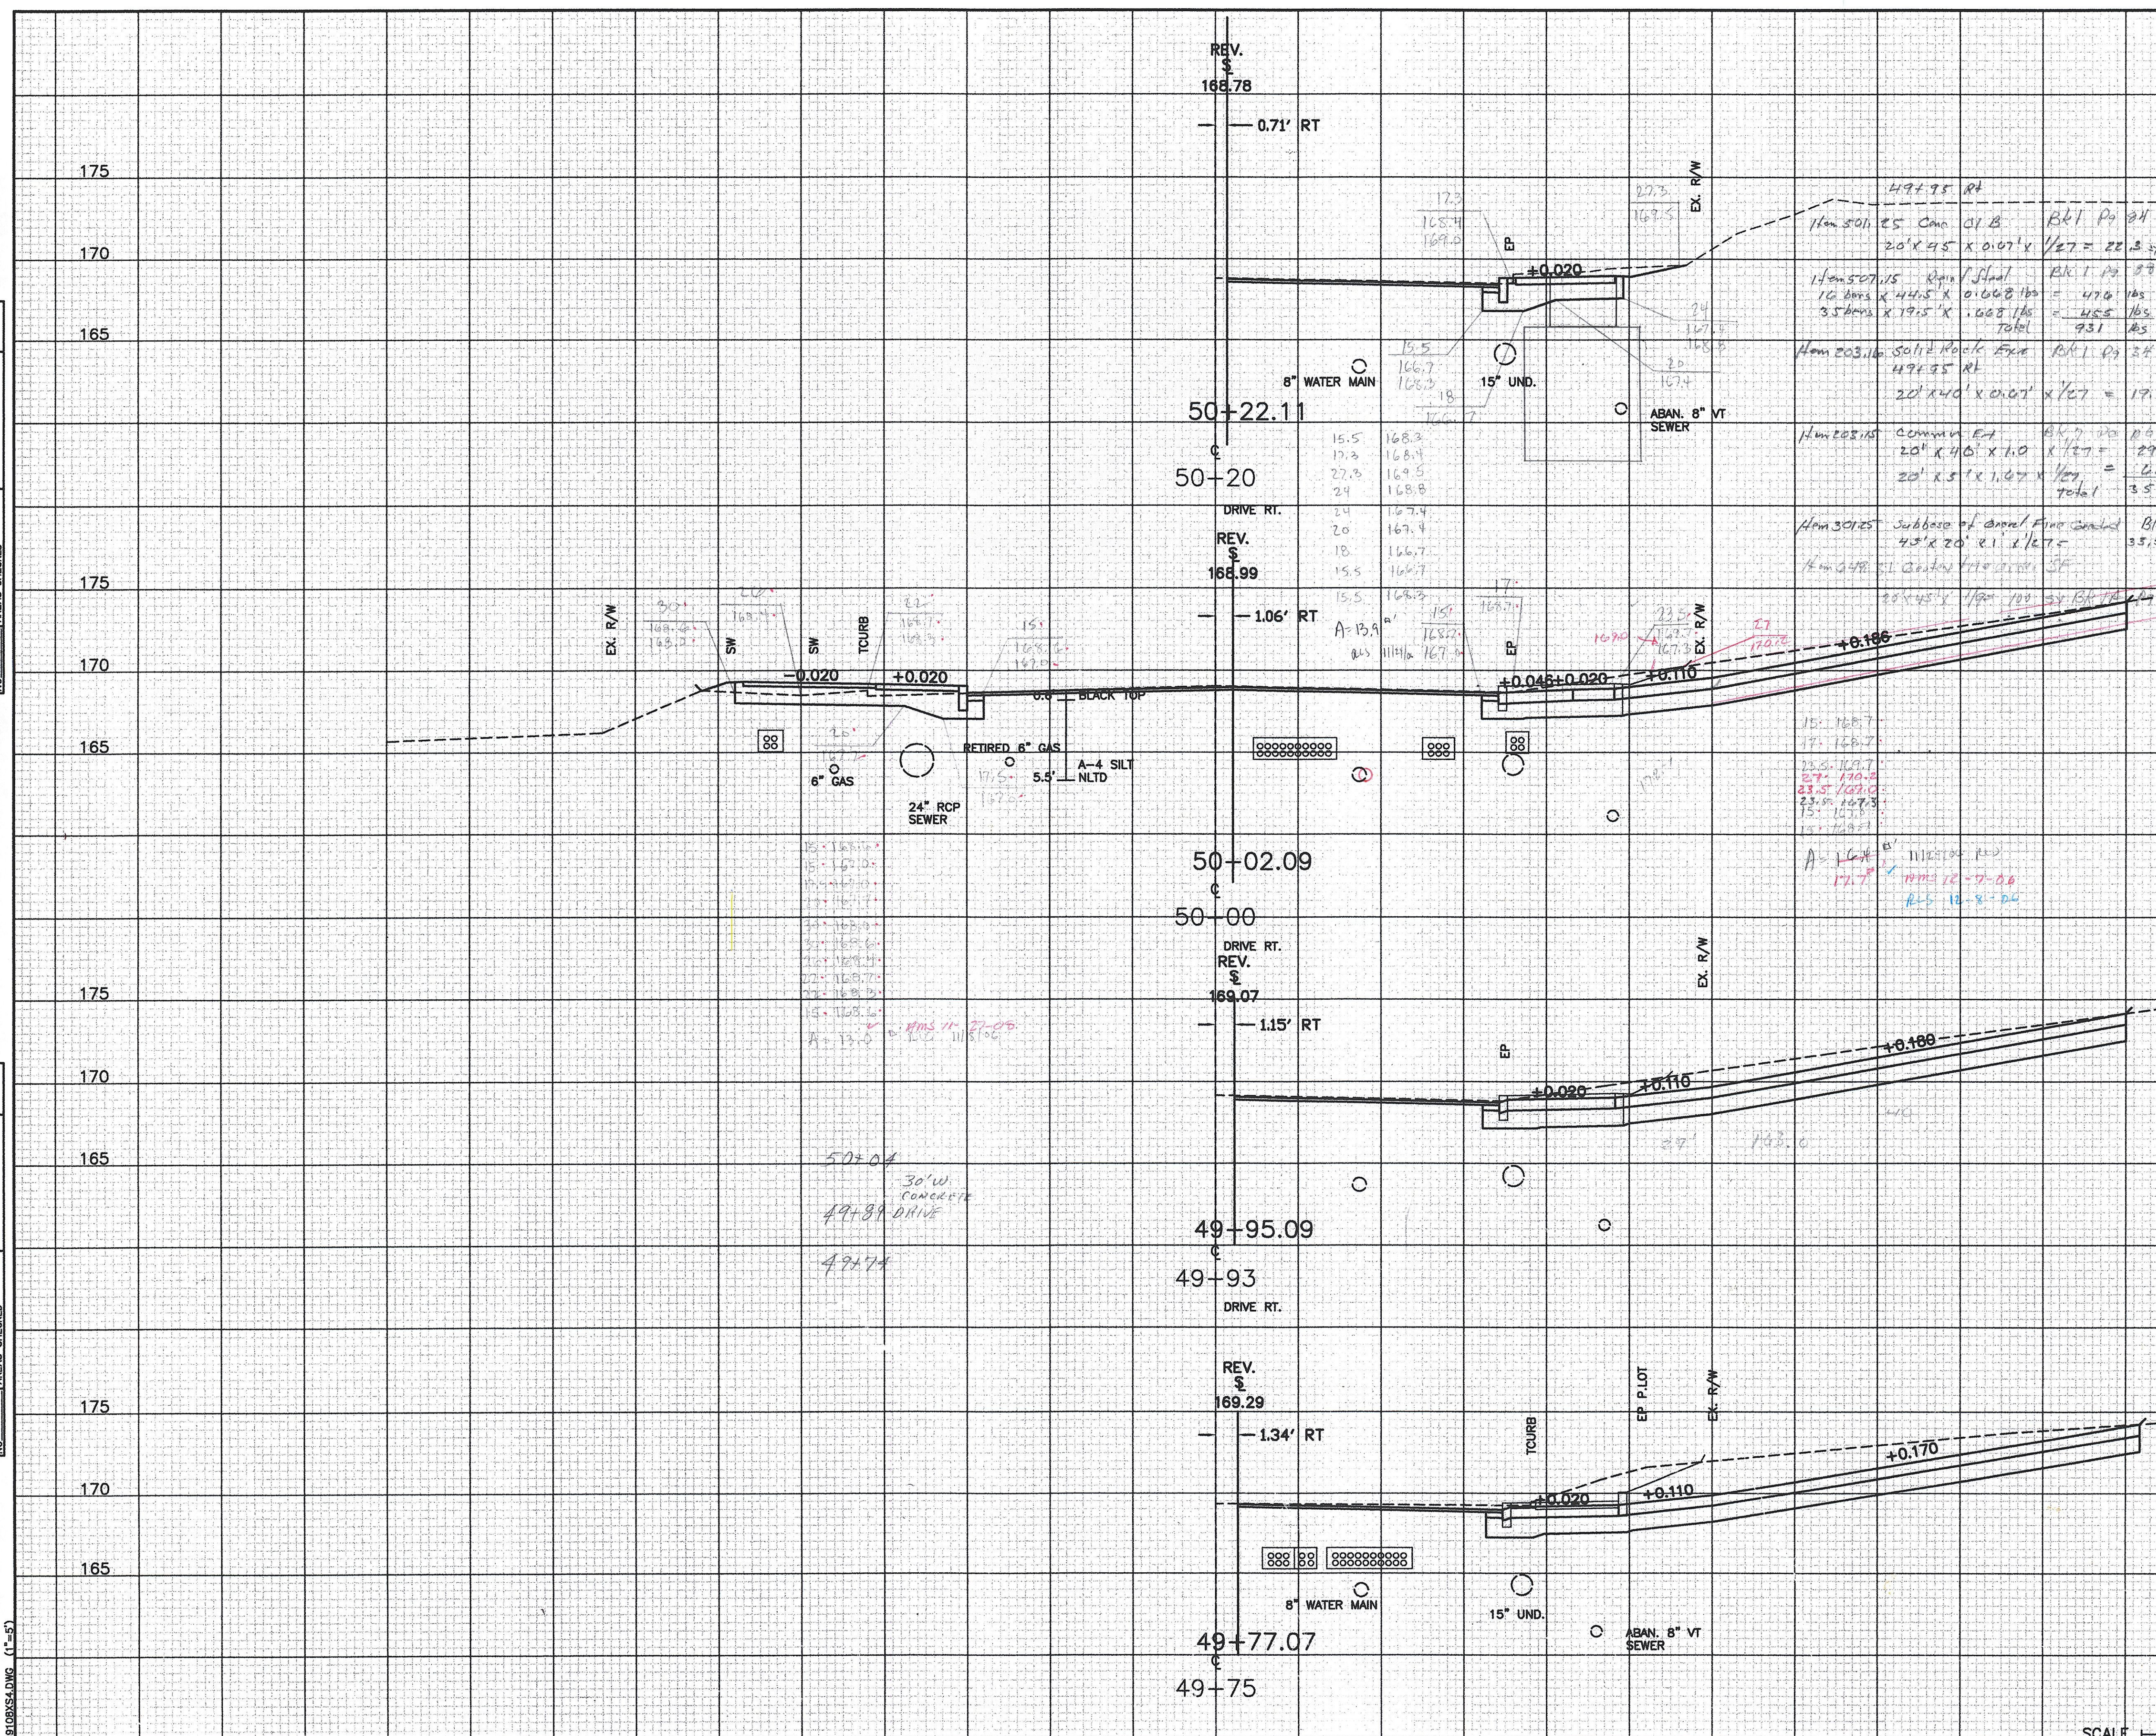

SCALE 5