


FINAL SURVEY	SURVED		BY		DATE
	PLOTTED				
NOTEBOOK	TEMPLATE				
	AREAS				
NO.	AREAS CHECKED				

ORIGINAL SURVEY		BY	DATE
	SURVEYED		
	PLOTTED		
	TEMPLATE		
	AREAS		
	AREAS CHECKED		
NO			

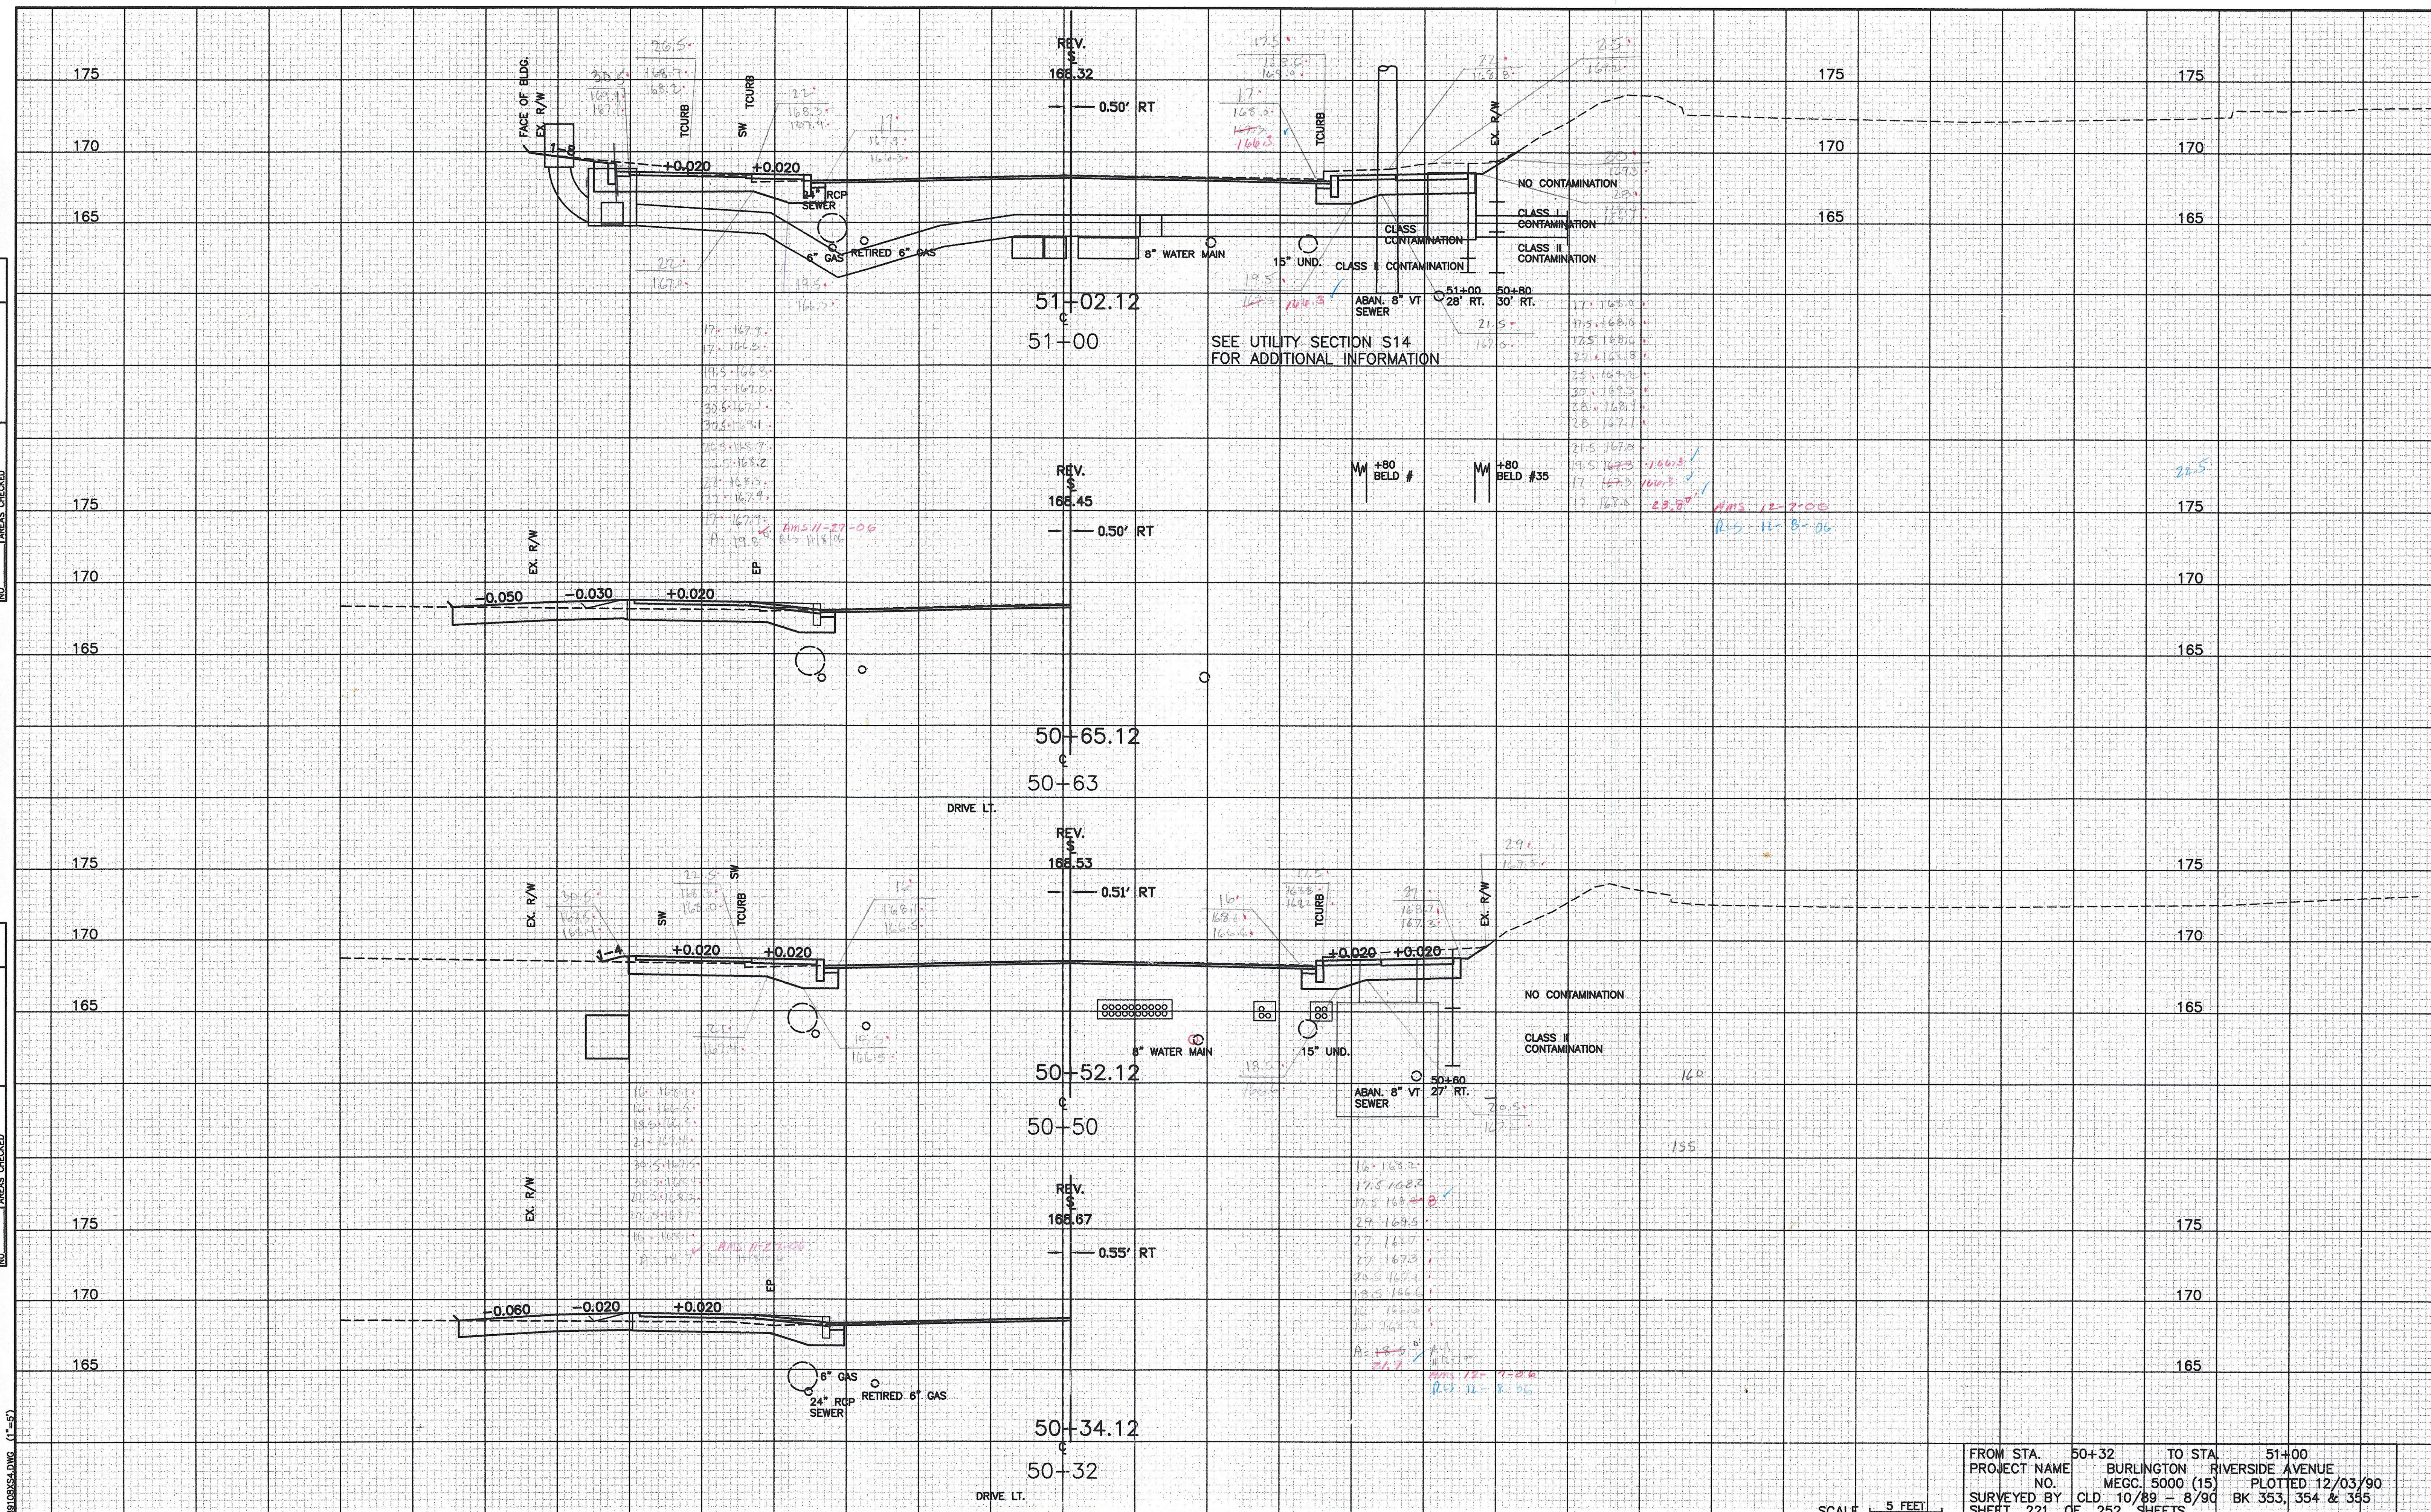

39108XS4.DWG (1"=5')

FROM STA.	50+32	TO STA.	51+00
PROJECT NAME	BURLINGTON RIVERSIDE AVENUE		
NO.	MEGC. 5000 (15)	PLOTTED 12/03/90	
SURVEYED BY	CLD 10/89 - 8/90	BK 353, 354 & 355	
SHEET 221	OF 252	SHEETS	

SCALE 5 FEET