


	BY	DATE
FINAL SURVEY		
PLOTTED		
TEMPLATE		
AREAS		
AREAS CHECKED		
NO.		

ORIGINAL SURVEY		BY	DATE
NOTED			
PLOTTED			
TEMPLATE			
AREAS			
AREAS CHECKED			
NO			

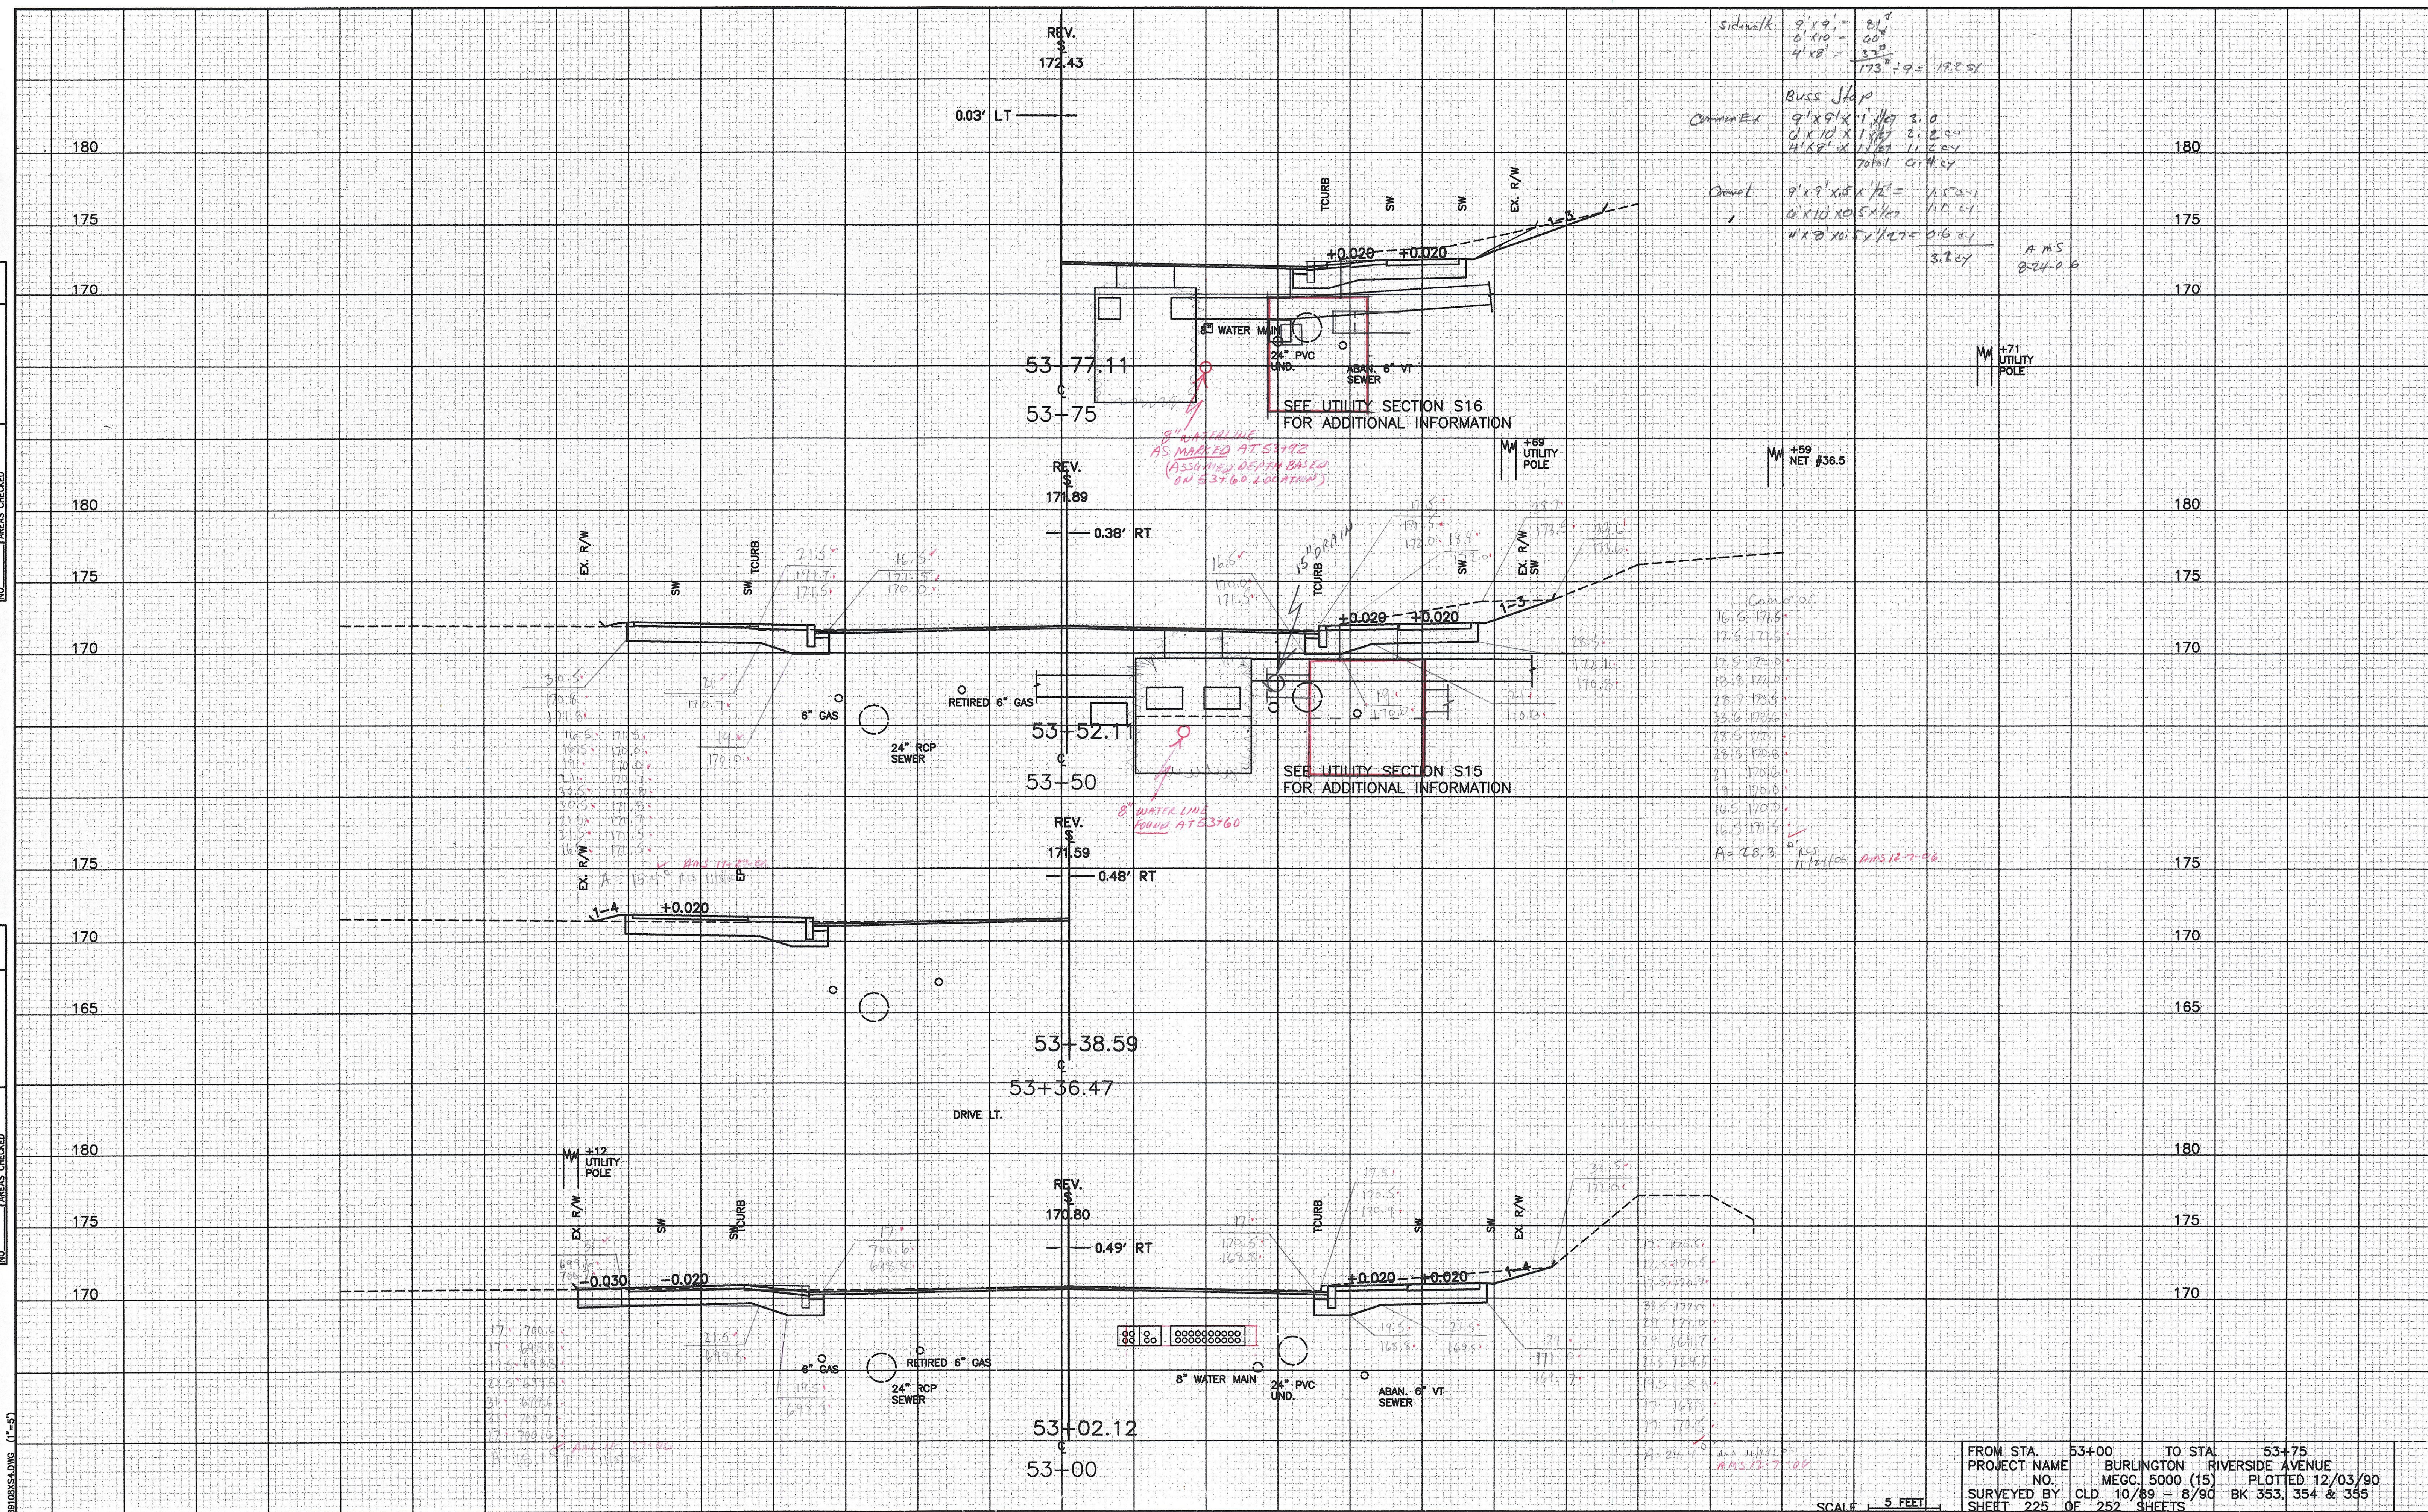

39108XS4.DWG (1"=5')

FROM STA.	53+00	TO STA.	53+75
PROJECT NAME	BURLINGTON RIVERSIDE AVENUE		
NO.	MECC. 5000 (15)	PLOTTED 12/03/90	
SURVEYED BY	CLD 10/89 - 8/90	BK 353, 354 & 355	
SHEET	225 OF 252 SHEETS		

SCALE 5 FEET