


FINAL	SURVEYED	DATE
SURVEY	PLOTTED	
NO.	DATE	
NO.	AREAS CHECKED	

ORIGINAL	SURVEYED	DATE
SURVEY	PLOTTED	
NO.	DATE	
NO.	AREAS CHECKED	

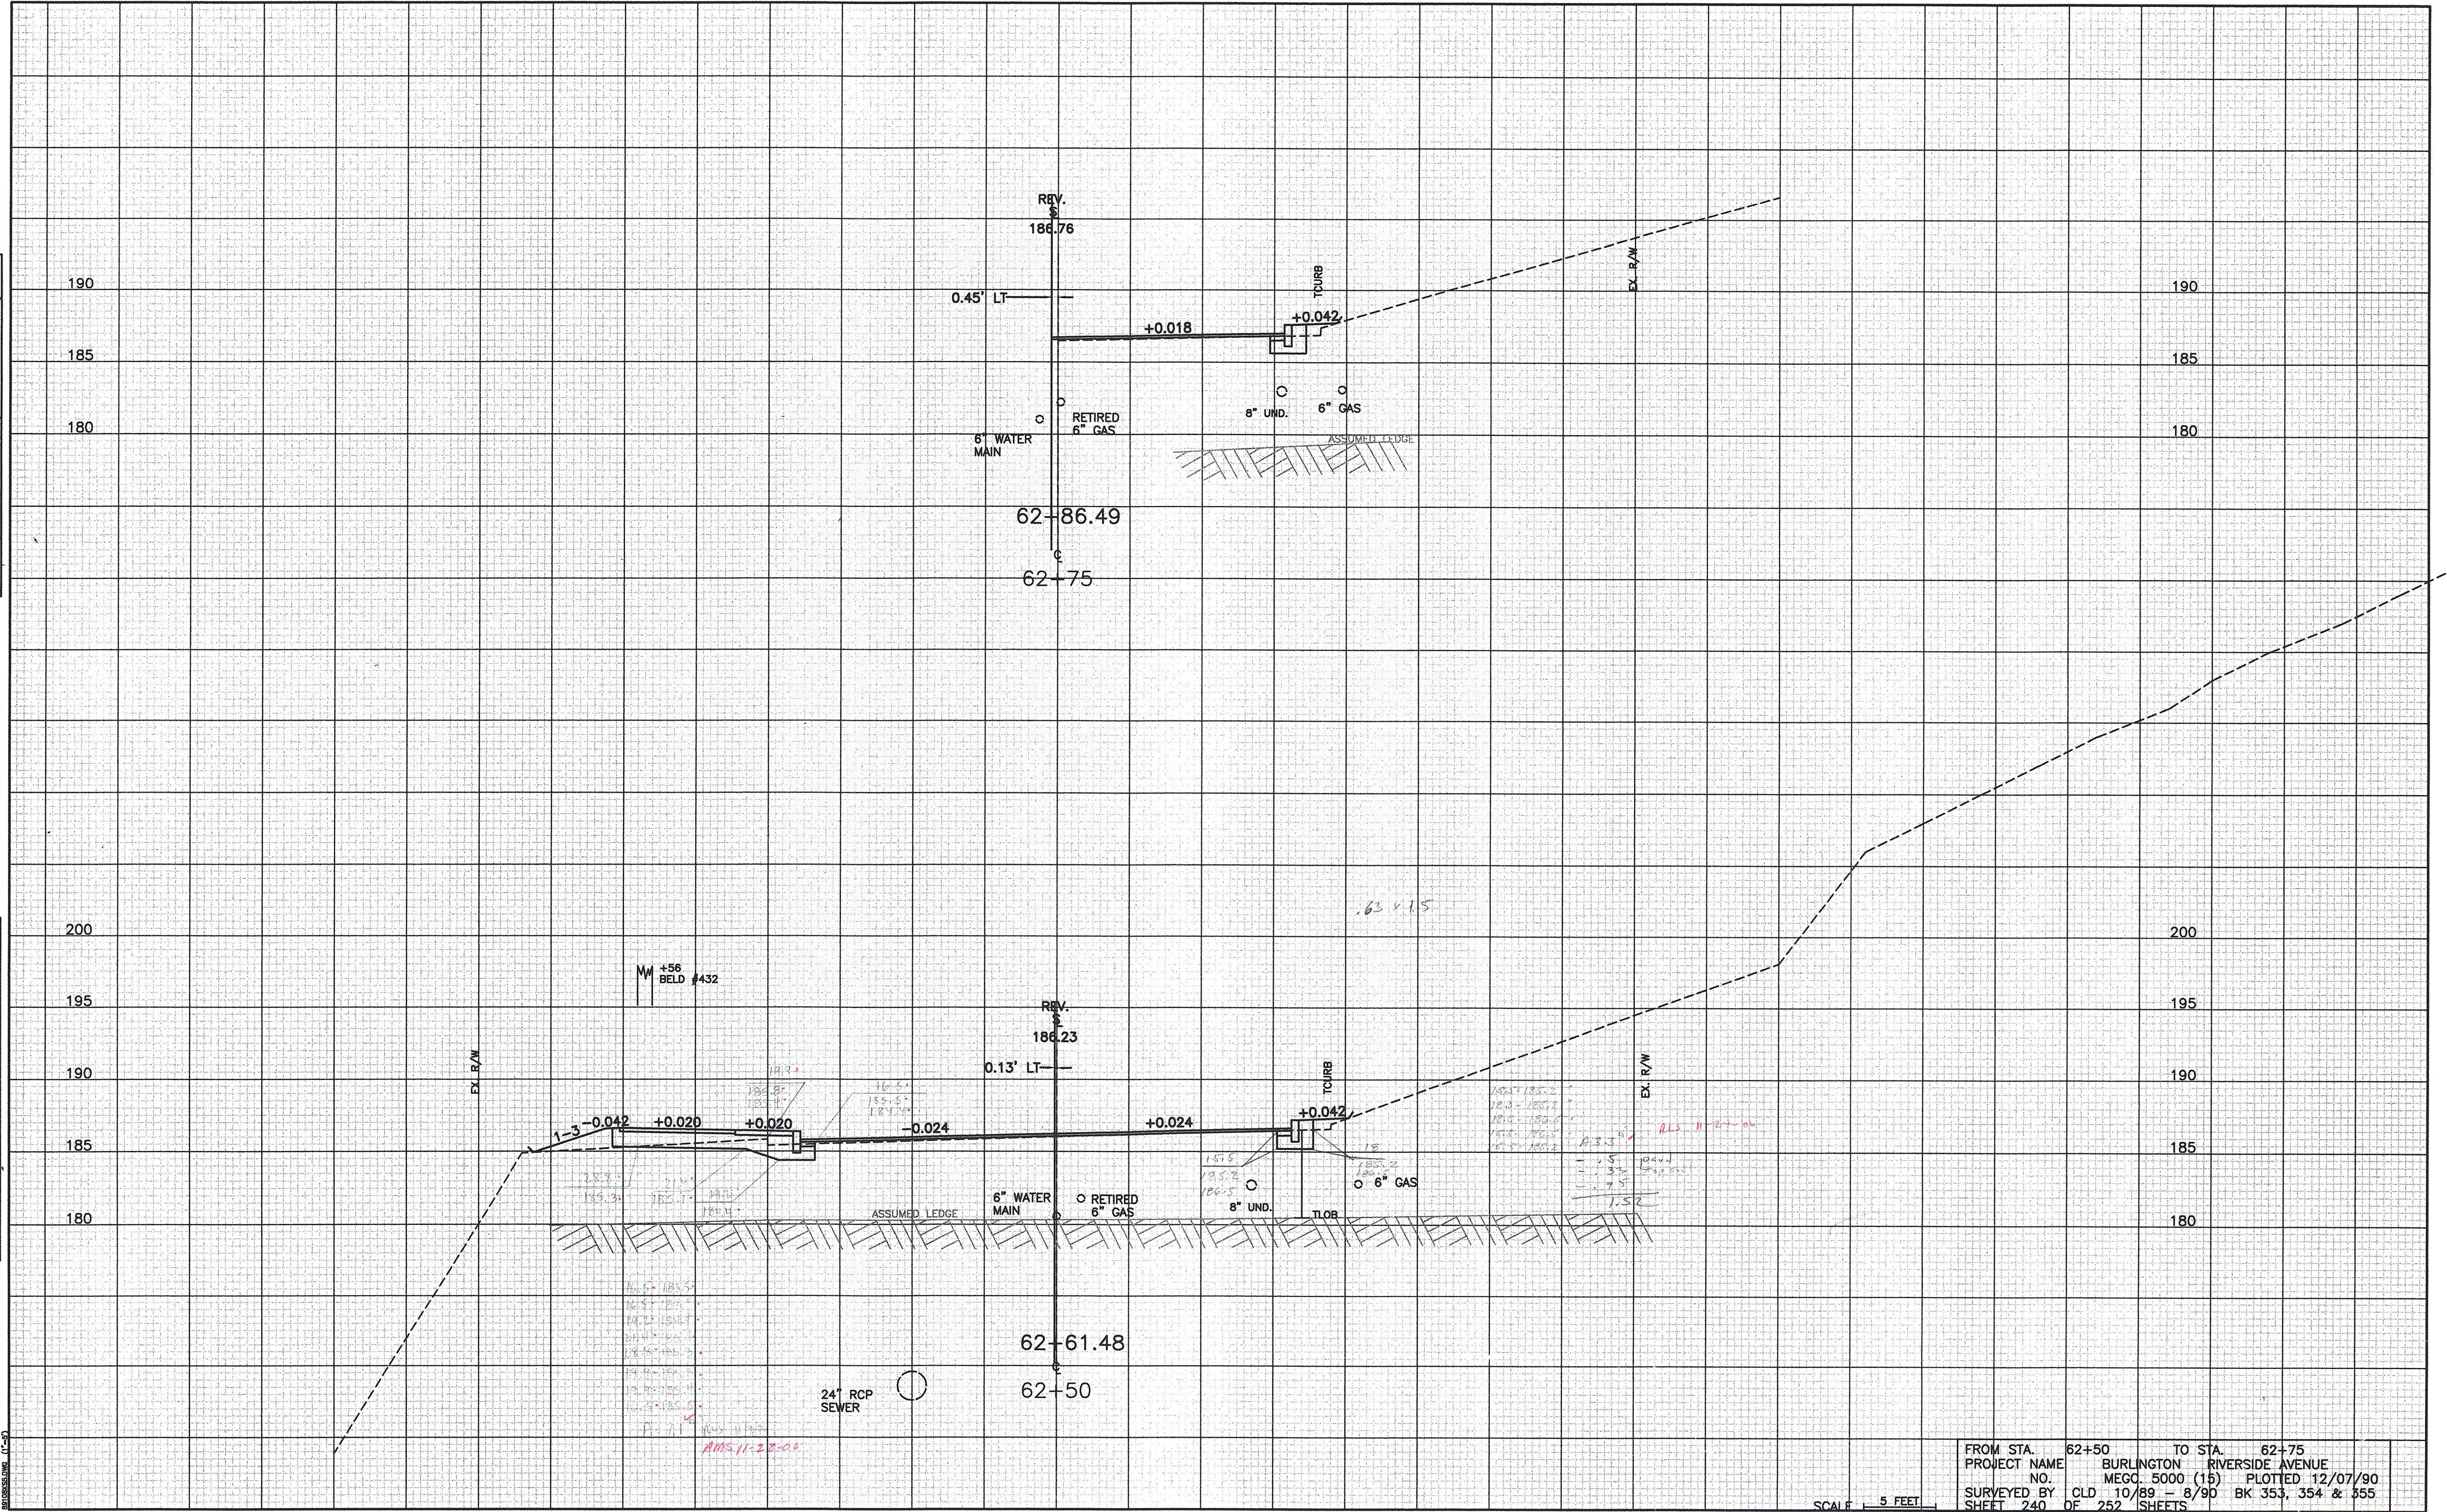

FROM STA.	62+50	TO STA.	62+75
PROJECT NAME	BURLINGTON RIVERSIDE AVENUE		
NO.	MECC. 5000 (15)	PLOTTED	12/07/90
SURVEYED BY	CLD 10/89	NO.	BK 353, 354 & 355
SHEET	240	OF	252 SHEETS

SCALE 5 FEET