FINAL SURVEY	SURVEYED	BY	DATE
	PLOTTED		
NOTEBOOK	TEMPLATE		
NO	AREAS		
	AREAS CHECKED		

ORIGINAL SURVEY	SURVEYED	BY	DATE
	PLOTTED		
NOTEBOOK	TEMPLATE		
NO	AREAS		
	AREAS CHECKED		

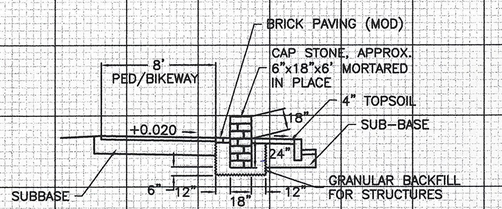

NOTES:
1. USE LARGE QUARRIED STONE MORTARED IN PLACE.
2. STONE AND MORTAR TO MATCH STONE COLOR OF EXISTING STONE WALLS.

MORTAR RUBBLE MASONRY STONE WALL

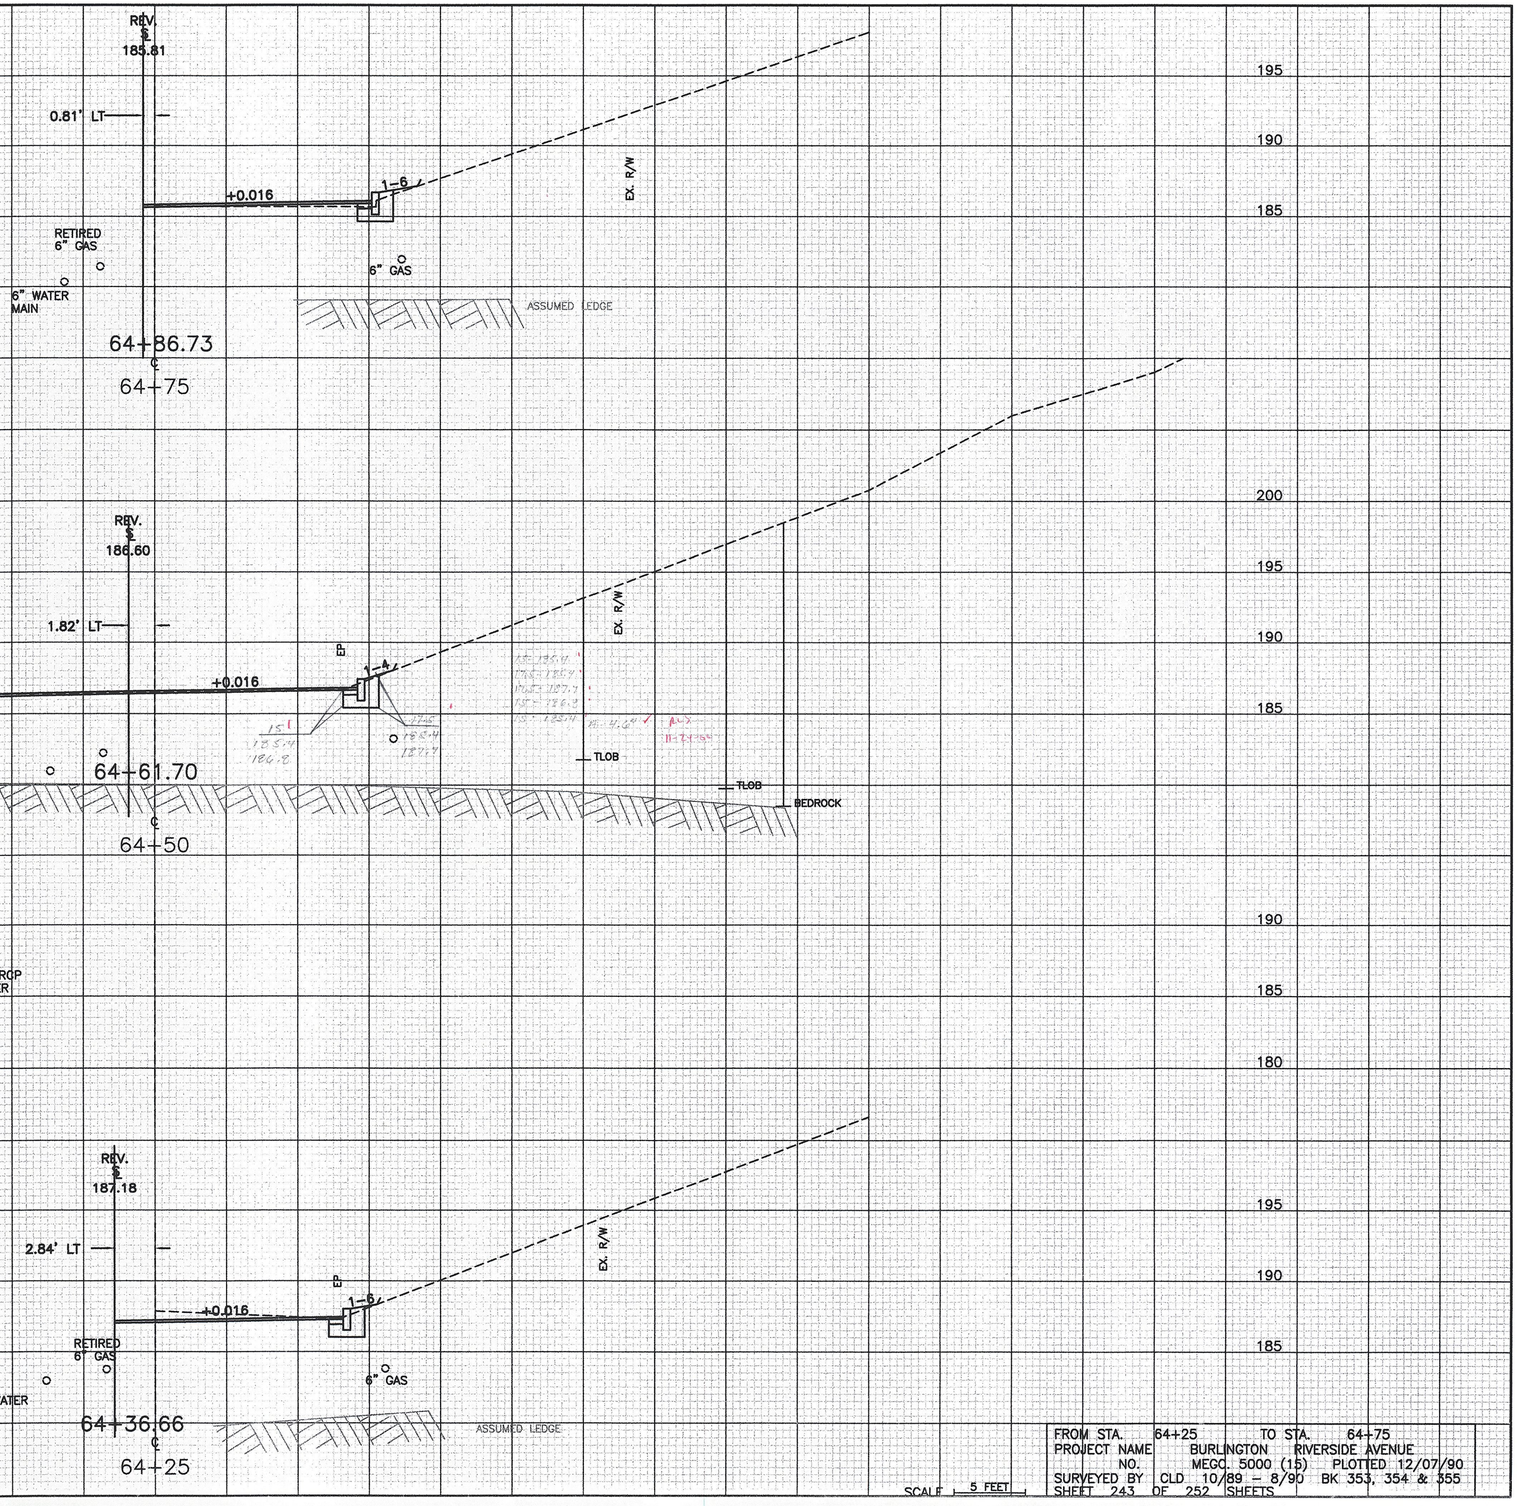

SCALE 5 FEET

FROM STA. 64+25 TO STA. 64+75
PROJECT NAME BURLINGTON RIVERSIDE AVENUE
NO. MEGC. 5000 (15) PLOTTED 12/07/90
SURVEYED BY CLD 10/89 - 8/90 BK 353, 354 & 355
SHEET 243 OF 252 SHEETS

891DRXSS.dwg (1"=5')