


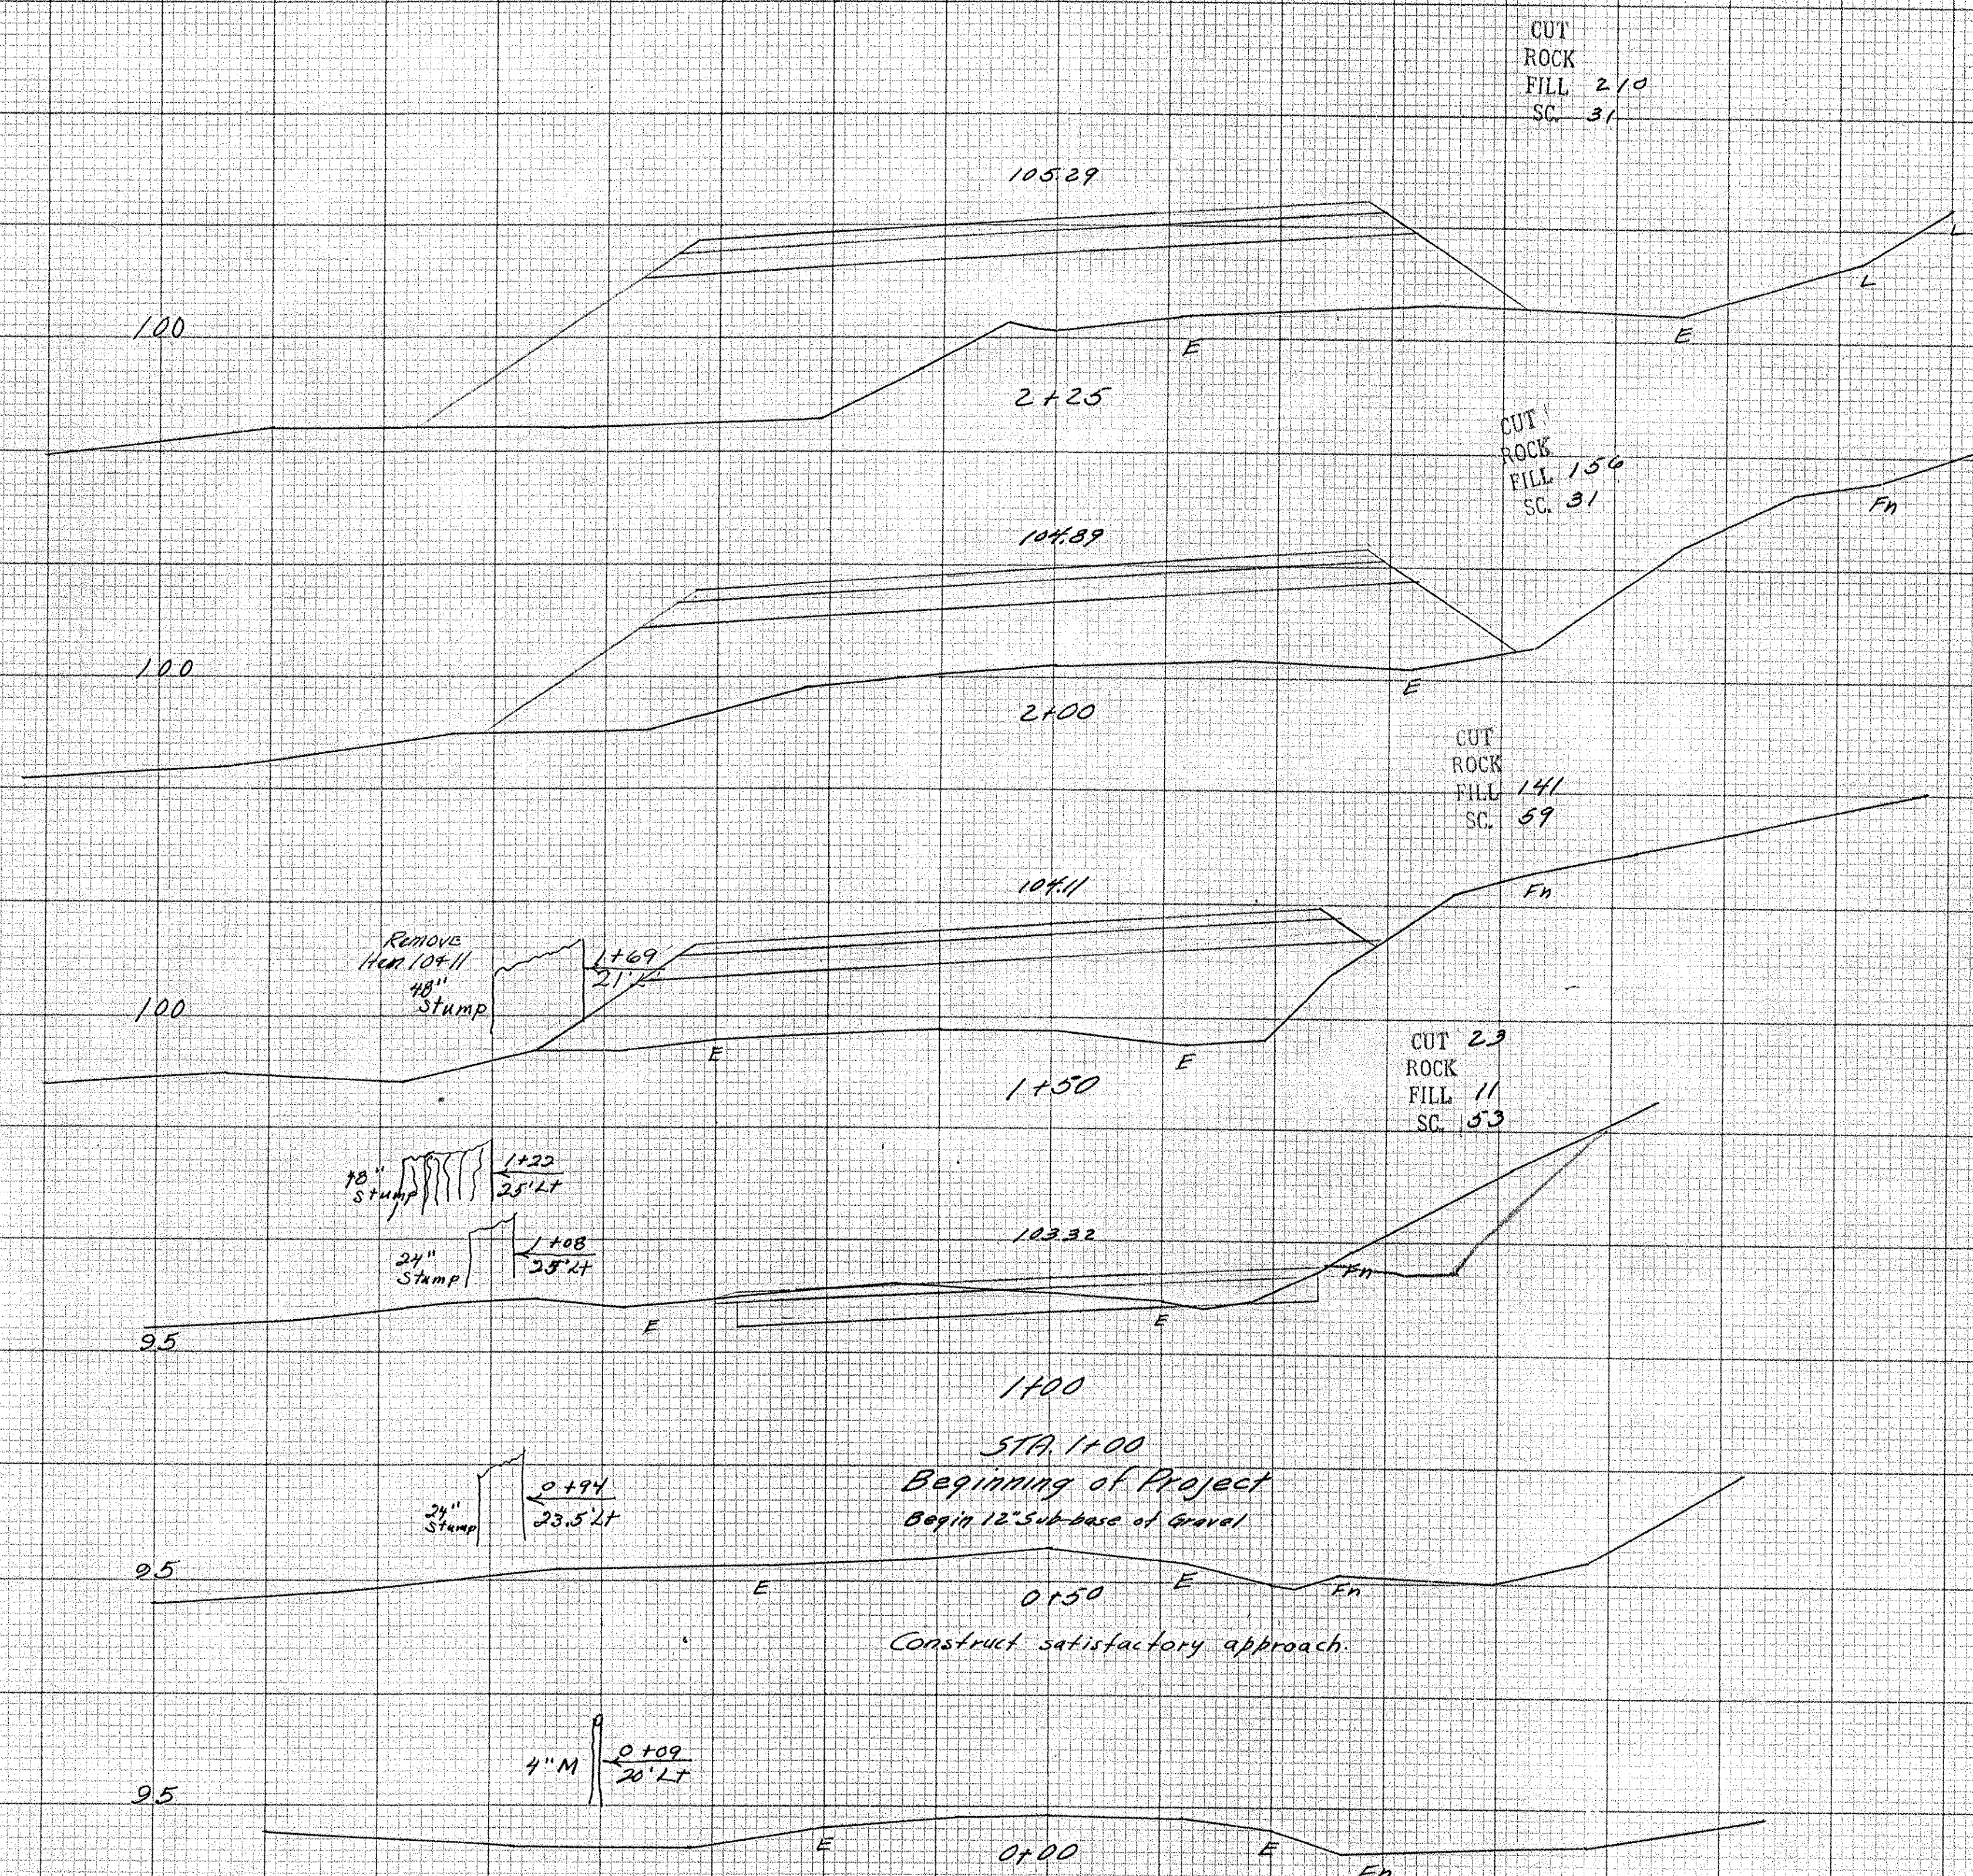

Fayston PWA Docket No. VI. 1092-F-89

LEVELS BY	Colby	CHKD. BY	M/LP
STATIONS PLOTTED BY	McAvey	CHKD. BY	
PLANNED BY		CHKD. BY	
EXAMINED BY		CHKD. BY	
SERIES F		NO.	FILED
SHEET 11		OF 17	