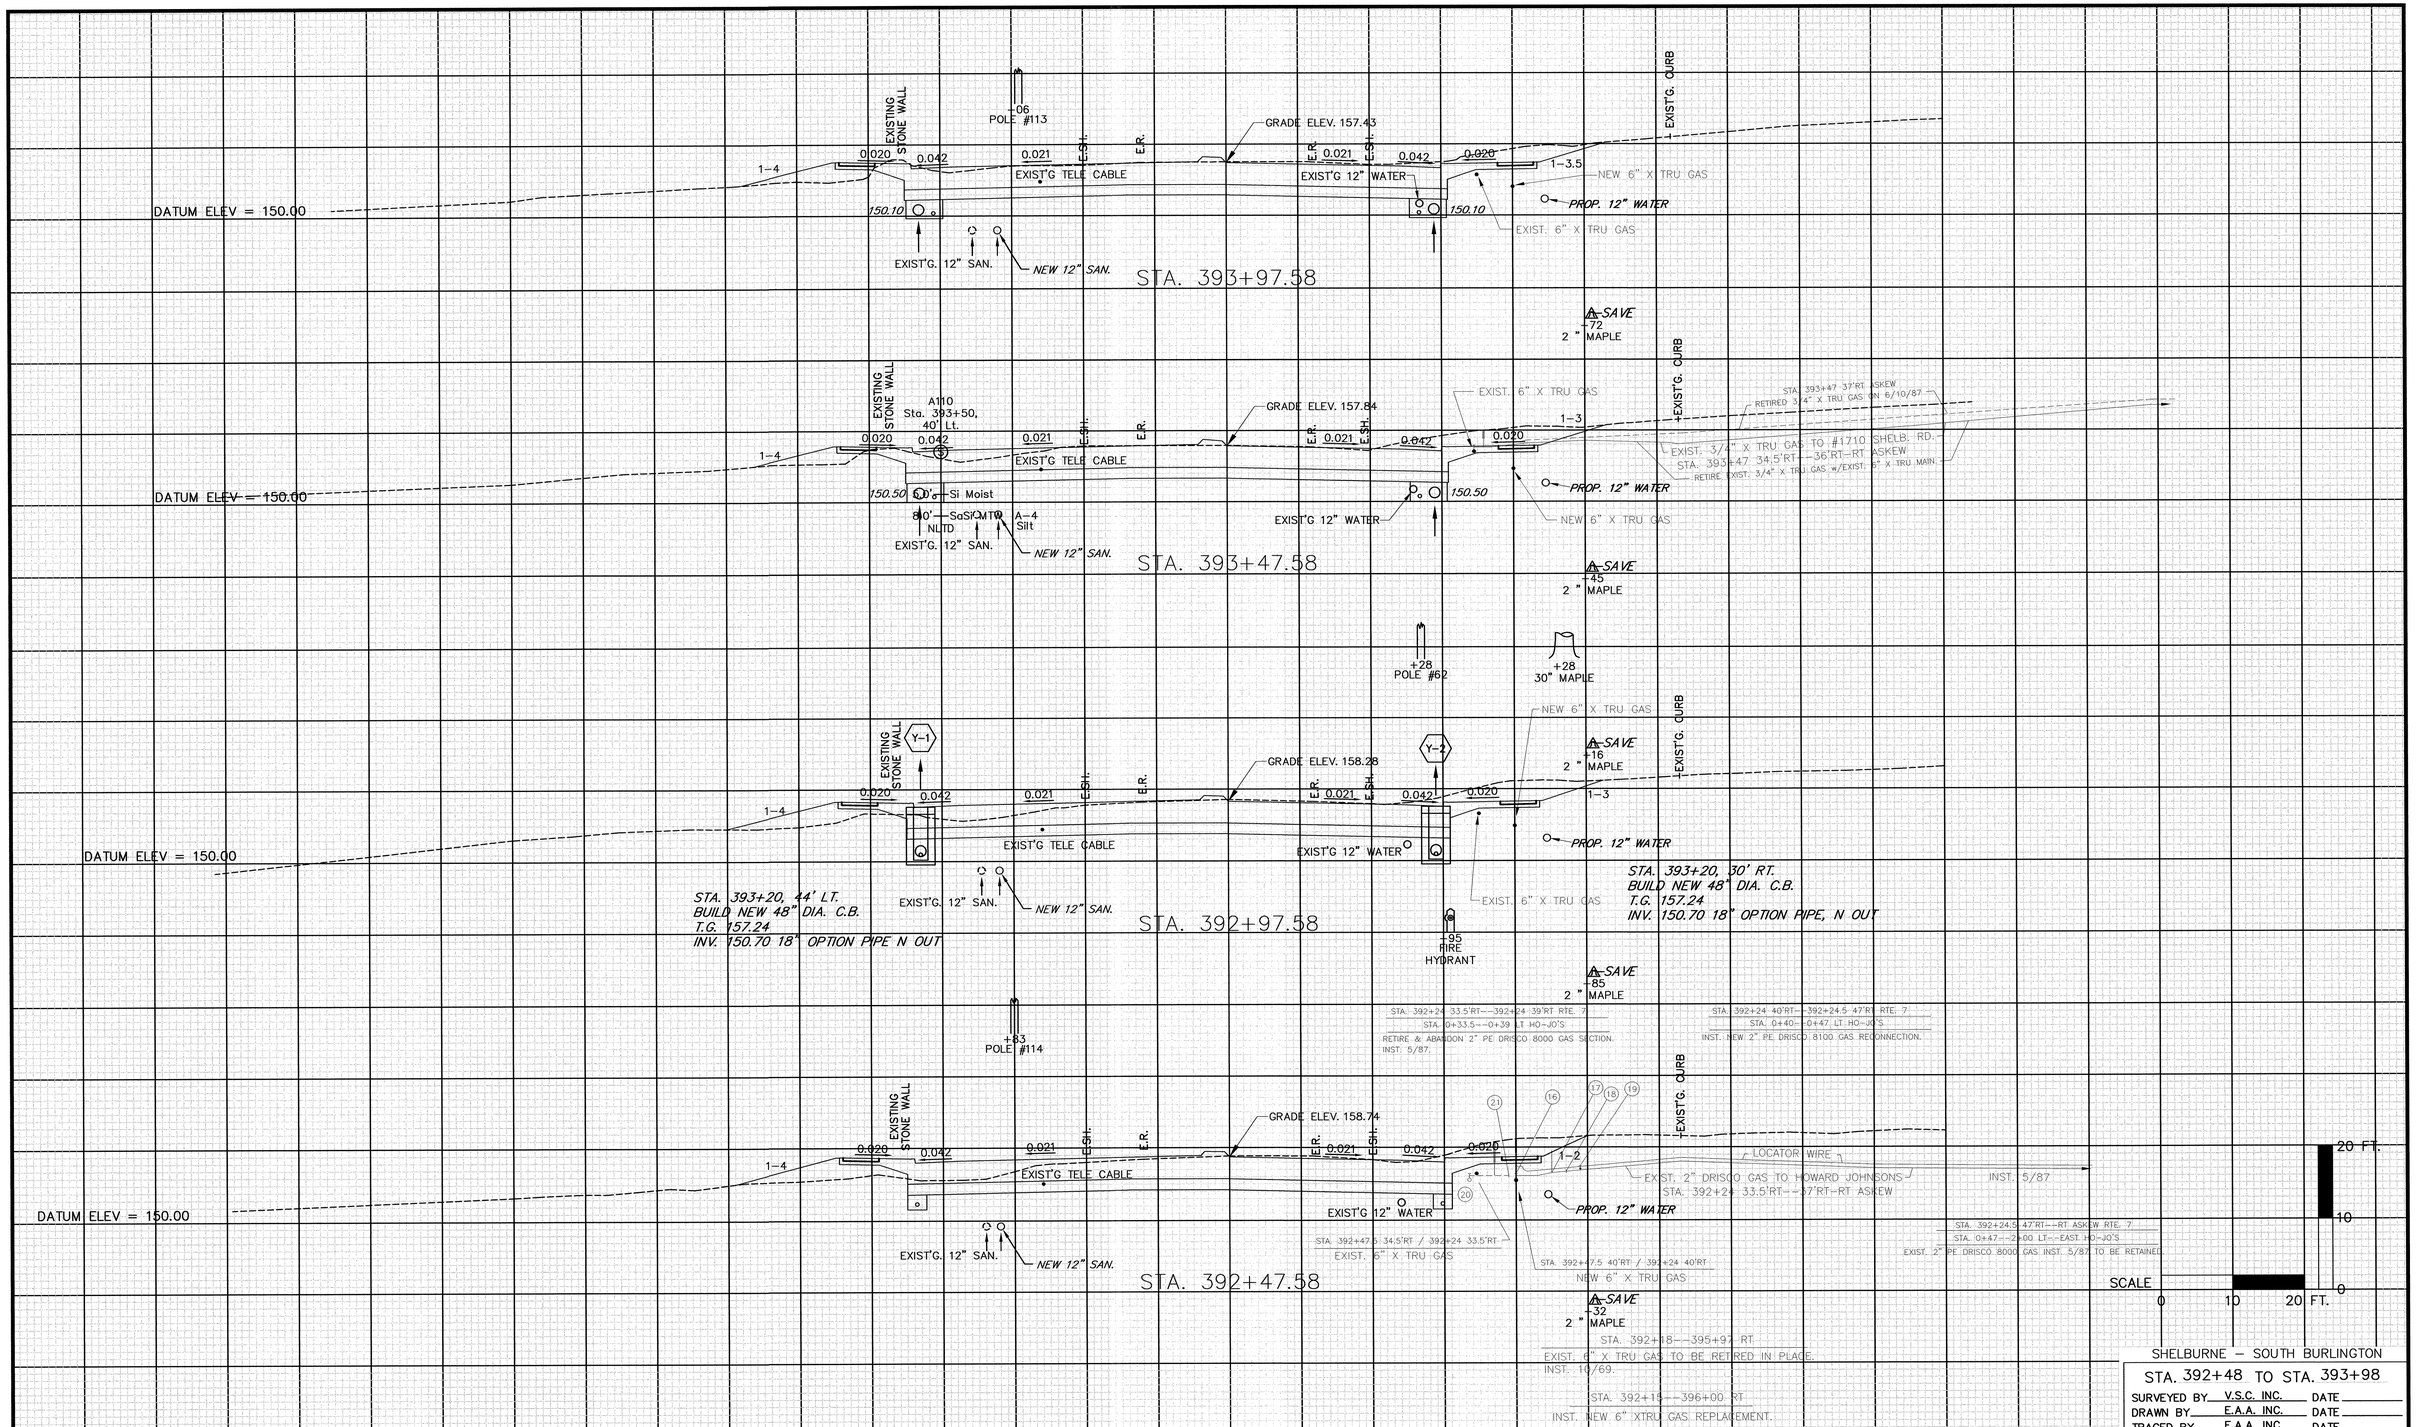

ERDMAN ANTHONY
CONSULTING ENGINEERS
Rochester, New York Camp Hill, Pennsylvania
Boston, Massachusetts

AS-BUILT REVISIONS REVISED SEWER DESIGN

NO.	DATE	DESCRIPTION	
1.	8/29/06	CHANGES MADE PER AS-BUILTS MARK UPS	4/4/03

SHELBURNE – SOUTH BURLINGTON

STA. 392+48 TO STA. 393+98

SURVEYED BY V.S.C. INC. DATE
DRAWN BY E.A.A. INC. DATE
TRACED BY E.A.A. INC. DATE

PROJECT NH-EGC-019-4(28)

CROSS-SECTION DWG. NO. 98

SHEET 190R OF 283

C:\6330008 (US Rte 7 Shelburne Rd)\AS-BUILTS\X-SECTIONS\ASBUILT X-098.dwg, 8/30/2006 3:28:59 PM