




K:\6330006 (US Rte 7 Shelburne Rd)\AS-BUILT\WATER-SEWER\2000_C63-pl(25).dwg, Layout1, 9/12/2008 2:57:07 PM, jarmata, lv-arj461\VT-BRL-HP1055cm East

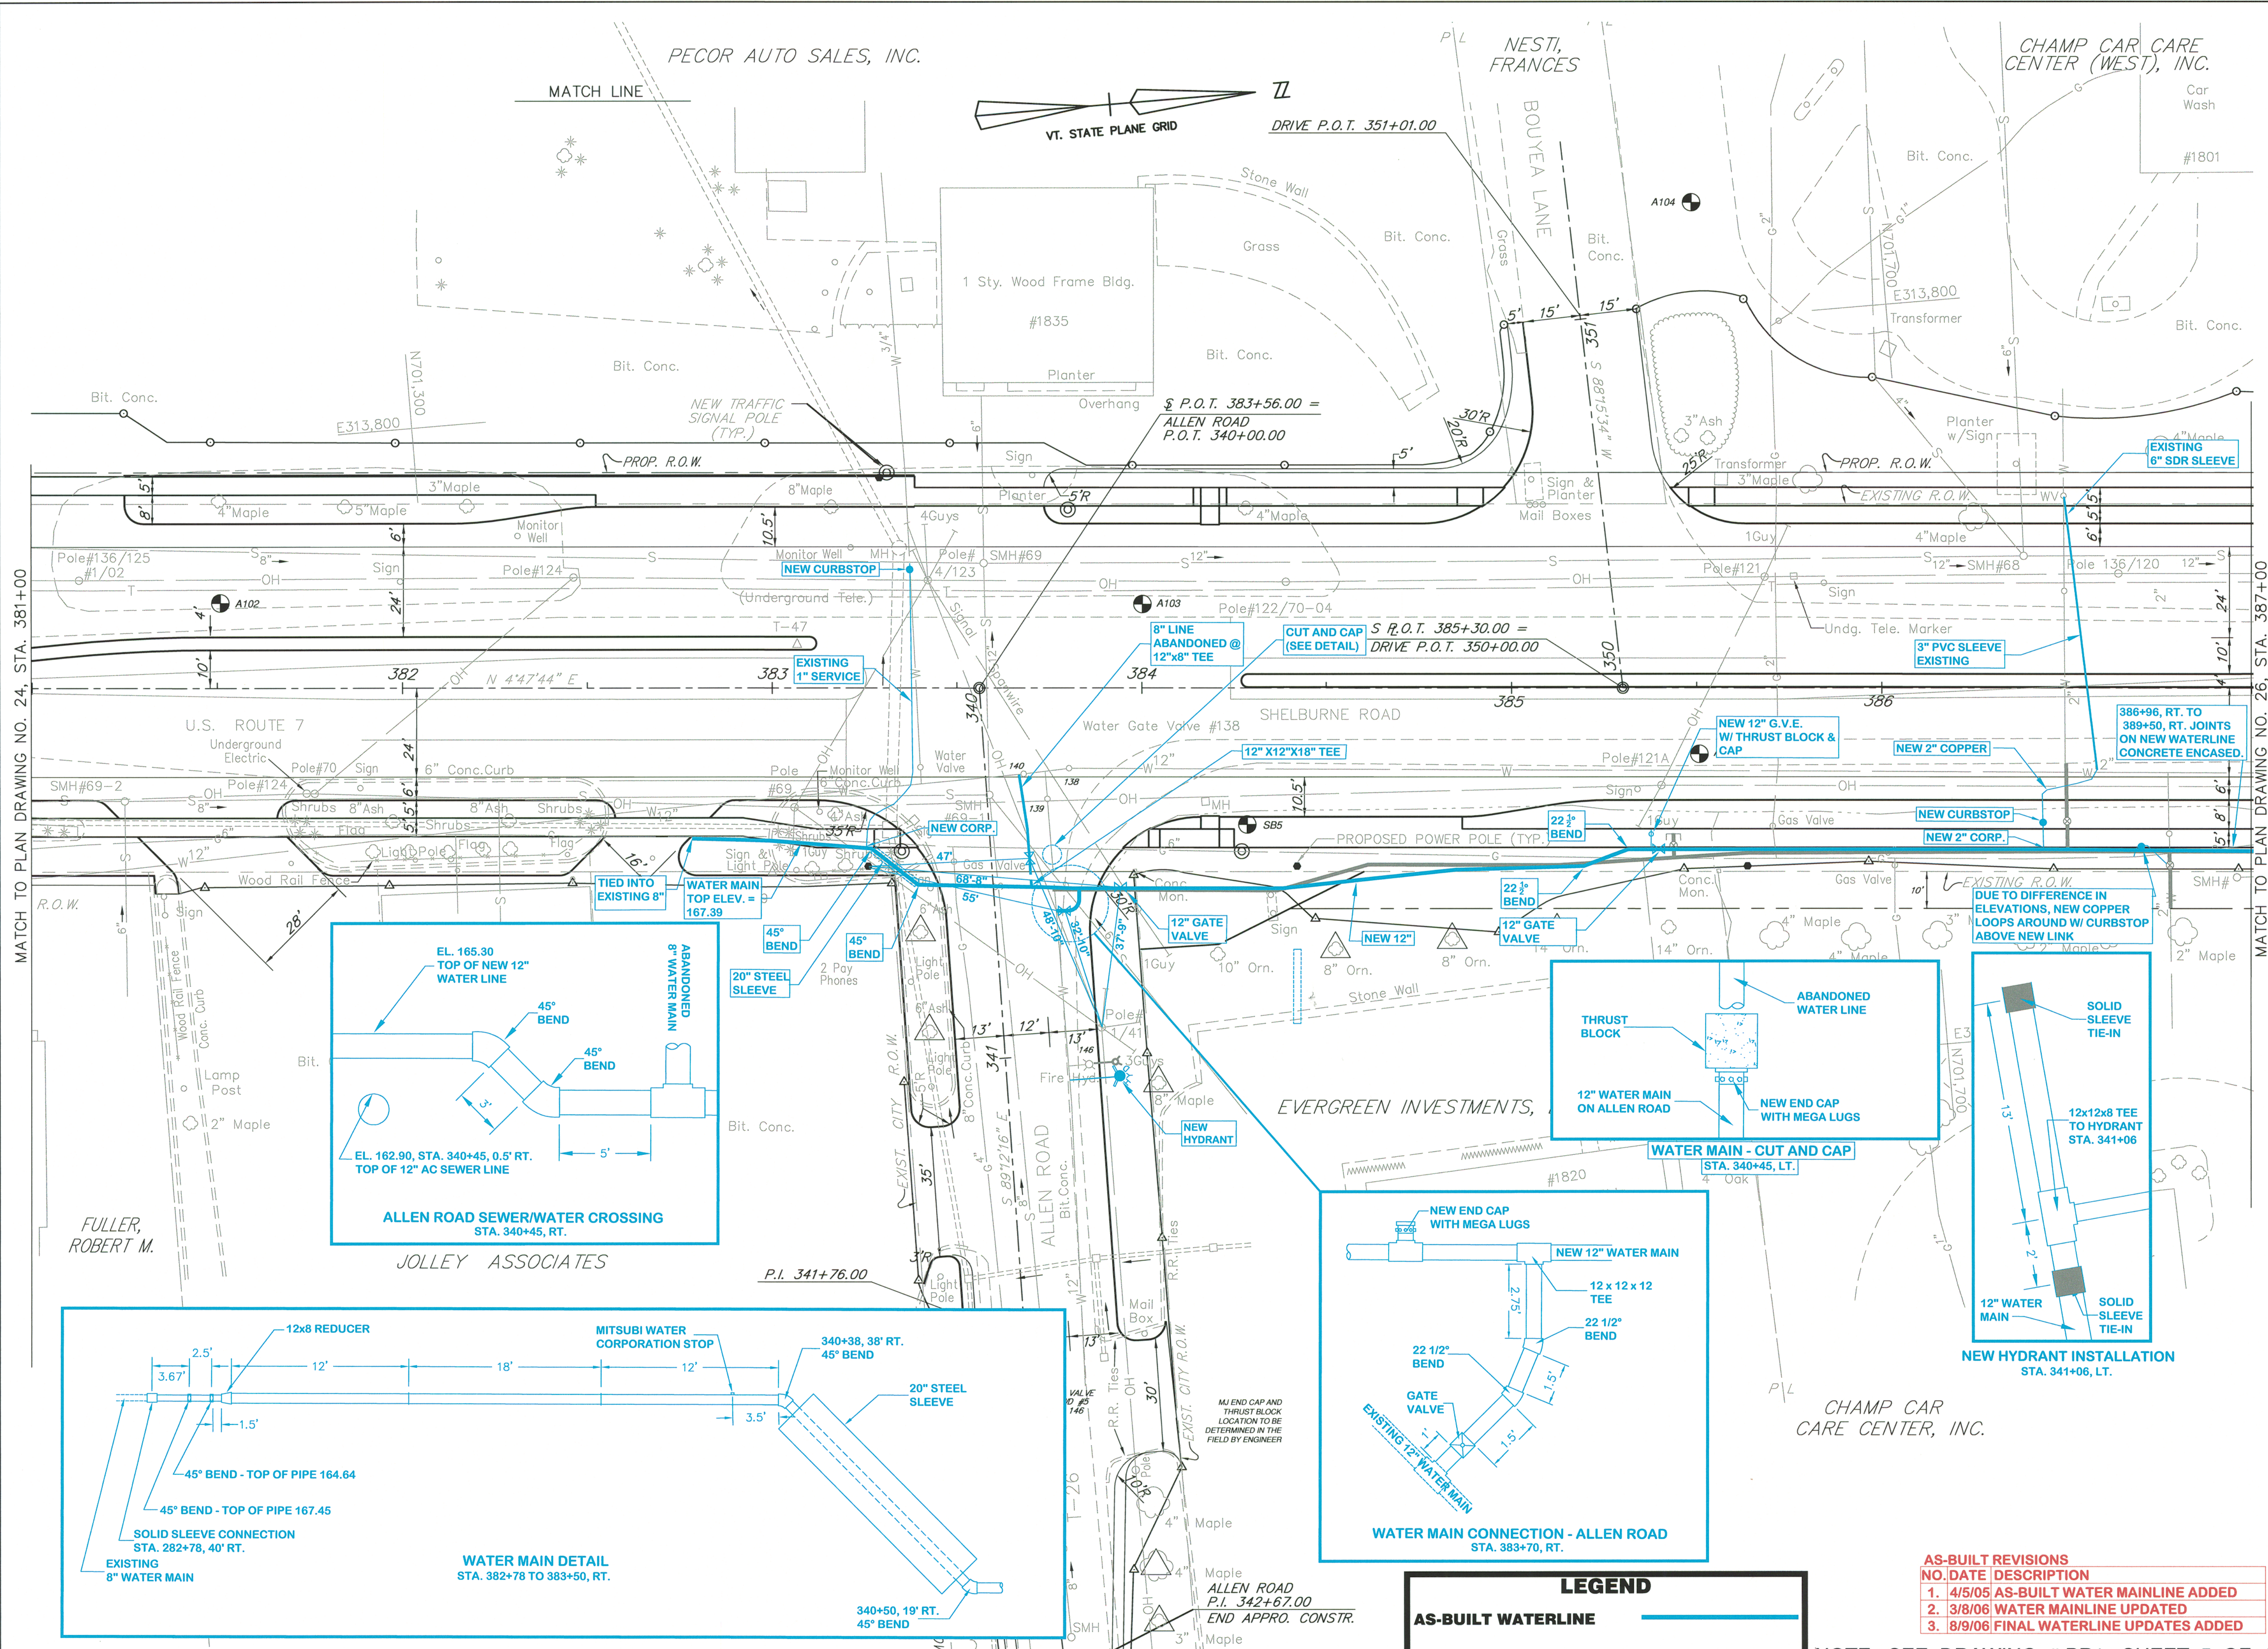

CHAMPLAIN WATER DISTRICT
403 Queen City Park Road
South Burlington, VT 05403
Phone: (802) 864-7454
Fax: (802) 864-0435

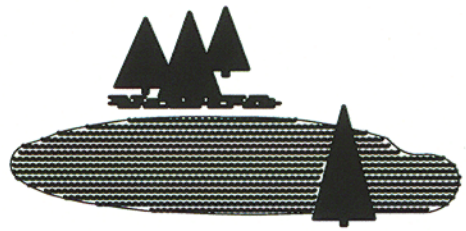

Dedicated to Quality
Water and Service

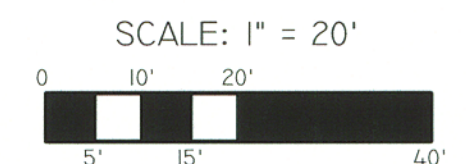

REVISIONS		
REV. #	DATE	BY

CONTRACT #63

WATER MAIN RELOCATION
U.S. ROUTE 7
"SHELburne ROAD"

SOUTH BURLINGTON,
VERMONT

PLAN VIEW
STA. 381+00 TO 387+00

244 of 283

DATE: APRIL, 2002
DESIGNED BY: RAP
DRAWN BY: EJP
CHECKED BY: RAP
APPROVED BY: RAP
FILE NAME: 2000_C63-pl(25)
SHEET 3 OF 18
DRAWING No.

PLI

AS-BUILT REVISIONS	
NO.	DATE DESCRIPTION
1.	4/5/05 AS-BUILT WATER MAINLINE ADDED
2.	3/8/06 WATER MAINLINE UPDATED
3.	8/9/06 FINAL WATERLINE UPDATES ADDED

NOTE: SEE DRAWING # PR1, SHEET 5 OF 18,
FOR PIPELINE PROFILE

LEGEND	
AS-BUILT WATERLINE	
AS-DESIGNED WATERLINE	