



SCALE: 1" = 20'


REVISIONS		
REV. #	DATE	BY

PLAN VIEW
STA. 399+00 TO 405+00

248 of 283

DATE: APRIL, 2002
DESIGNED BY: RAP
DRAWN BY: EJP
CHECKED BY: RAP
APPROVED BY: RAP
FILE NAME: 2000_C63-pl4(28)
SHEET 7 OF 18
DRAWING No.

PL4

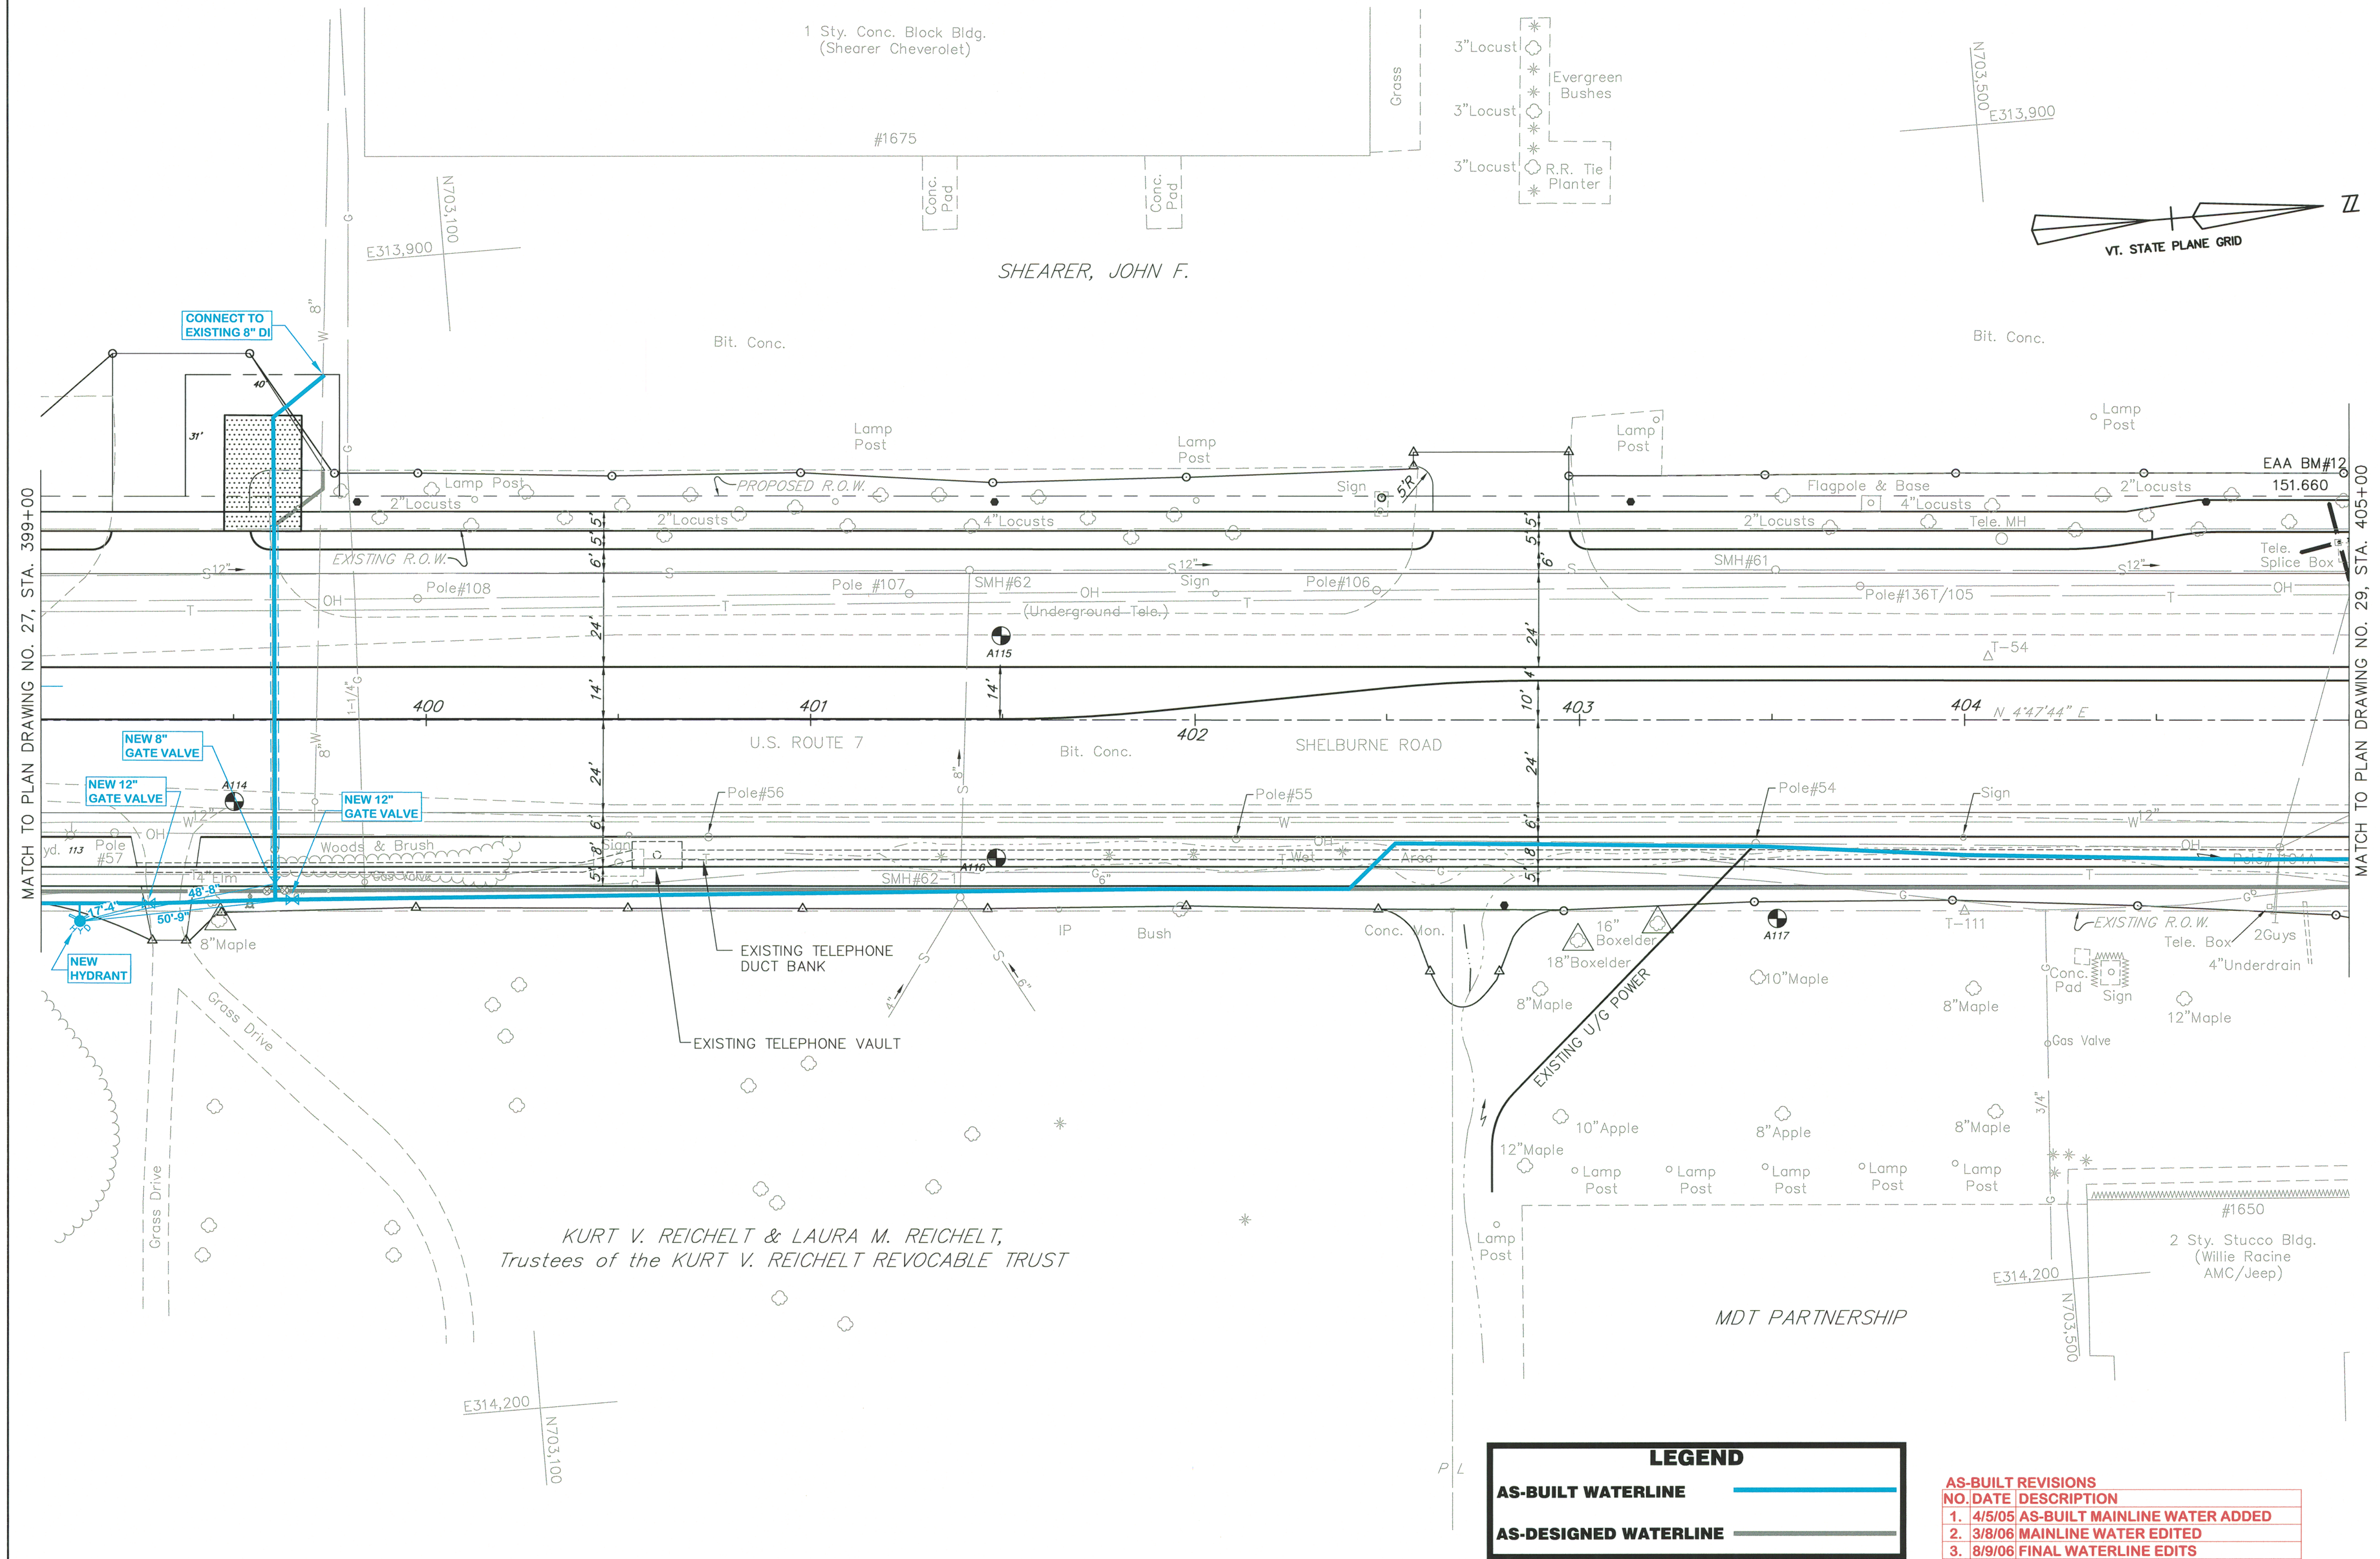

LEGEND	
AS-BUILT WATERLINE	
AS-DESIGNED WATERLINE	

AS-BUILT REVISIONS	
NO.	DATE DESCRIPTION
1.	4/5/05 AS-BUILT MAINLINE WATER ADDED
2.	3/8/06 MAINLINE WATER EDITED
3.	8/9/06 FINAL WATERLINE EDITS

NOTE: SEE DRAWING # PR2, SHEET 8 OF 18,
FOR PIPELINE PROFILE