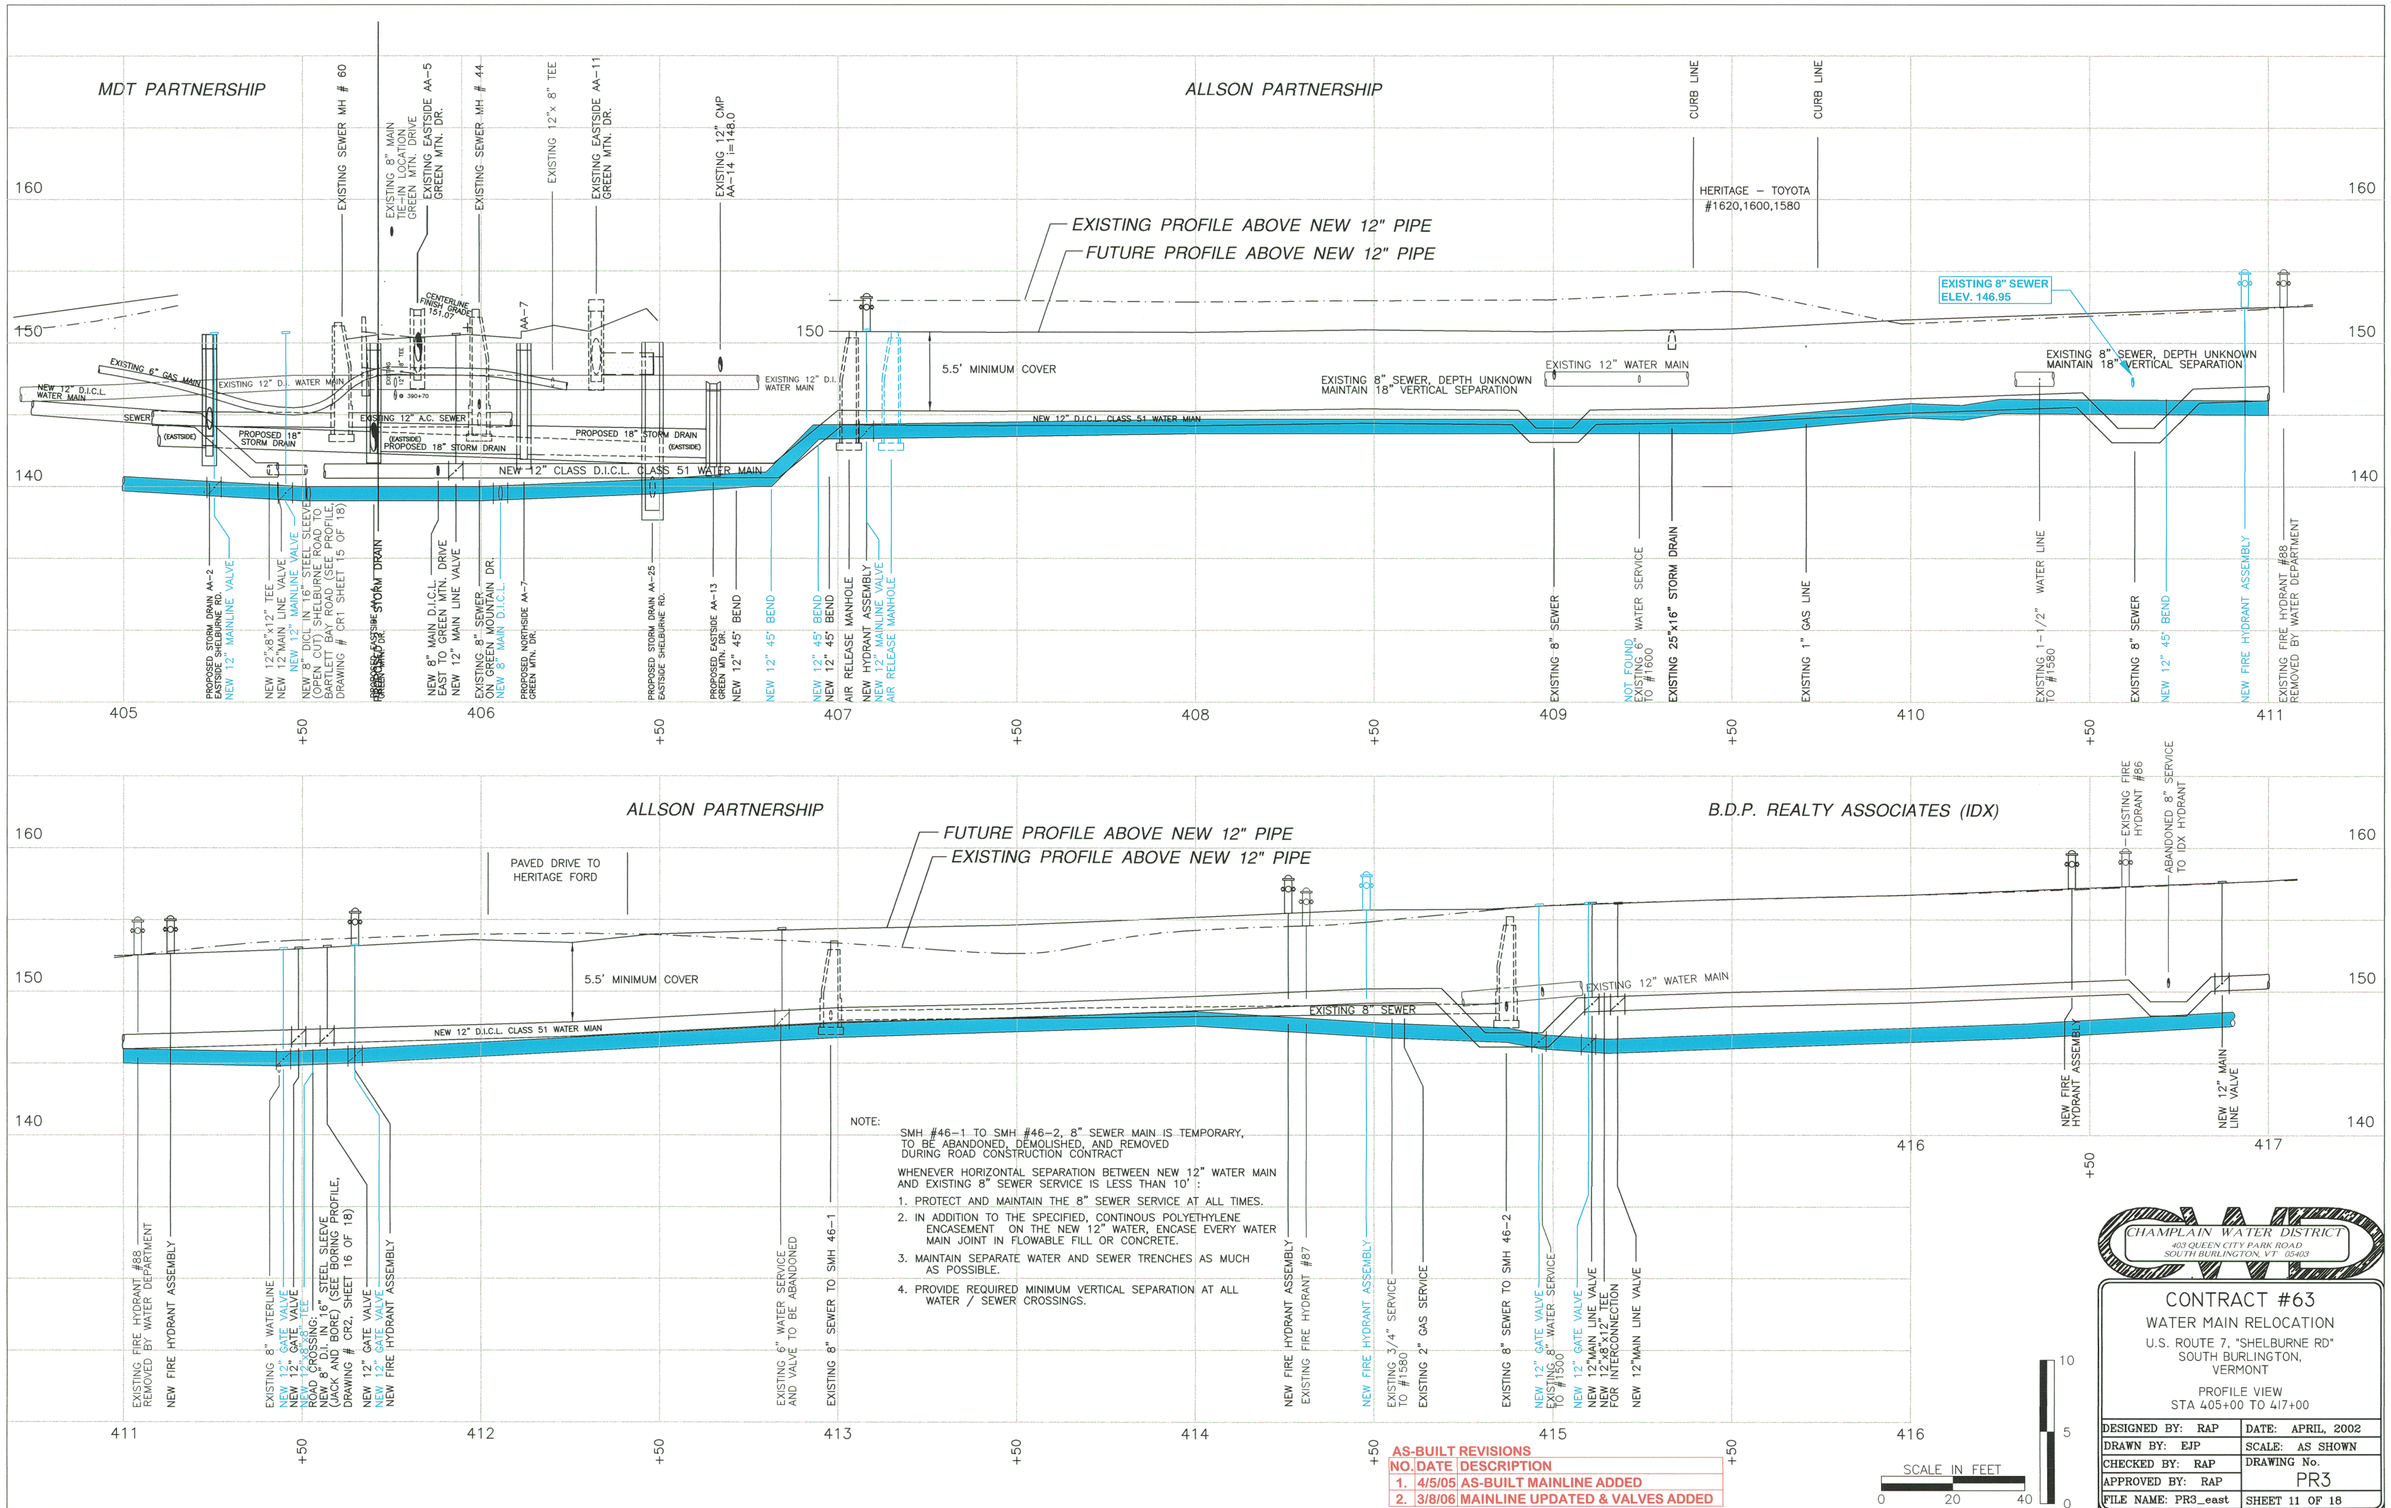

AS-BUILT REVISIONS		
NO.	DATE	DESCRIPTION
1.	4/5/05	AS-BUILT MAINLINE ADDED
2.	3/8/06	MAINLINE UPDATED & VALVES ADDED

CHAMPLAIN WATER DISTRICT
403 QUEEN CITY PARK ROAD
SOUTH BURLINGTON, VT 05403

CONTRACT #63
WATER MAIN RELOCATION
U.S. ROUTE 7, "SHELBURNE RD"
SOUTH BURLINGTON, VERMONT

PROFILE VIEW
STA 405+00 TO 417+00

DESIGNED BY: RAP	DATE: APRIL, 2002
DRAWN BY: EJP	SCALE: AS SHOWN
CHECKED BY: RAP	DRAWING No.
APPROVED BY: RAP	PR3
FILE NAME: PR3_east	SHEET 11 OF 18

K:\6330008 (US Rte 7 Shelburne Rd)\AS-BUILT\5WATER-SEWER\Pr3_east.dwg, Layout1, 8/5/2006 11:27:24 AM, pamatta, VT-BRL-HP1055cm Eastl(Paper-Draft).pc3