


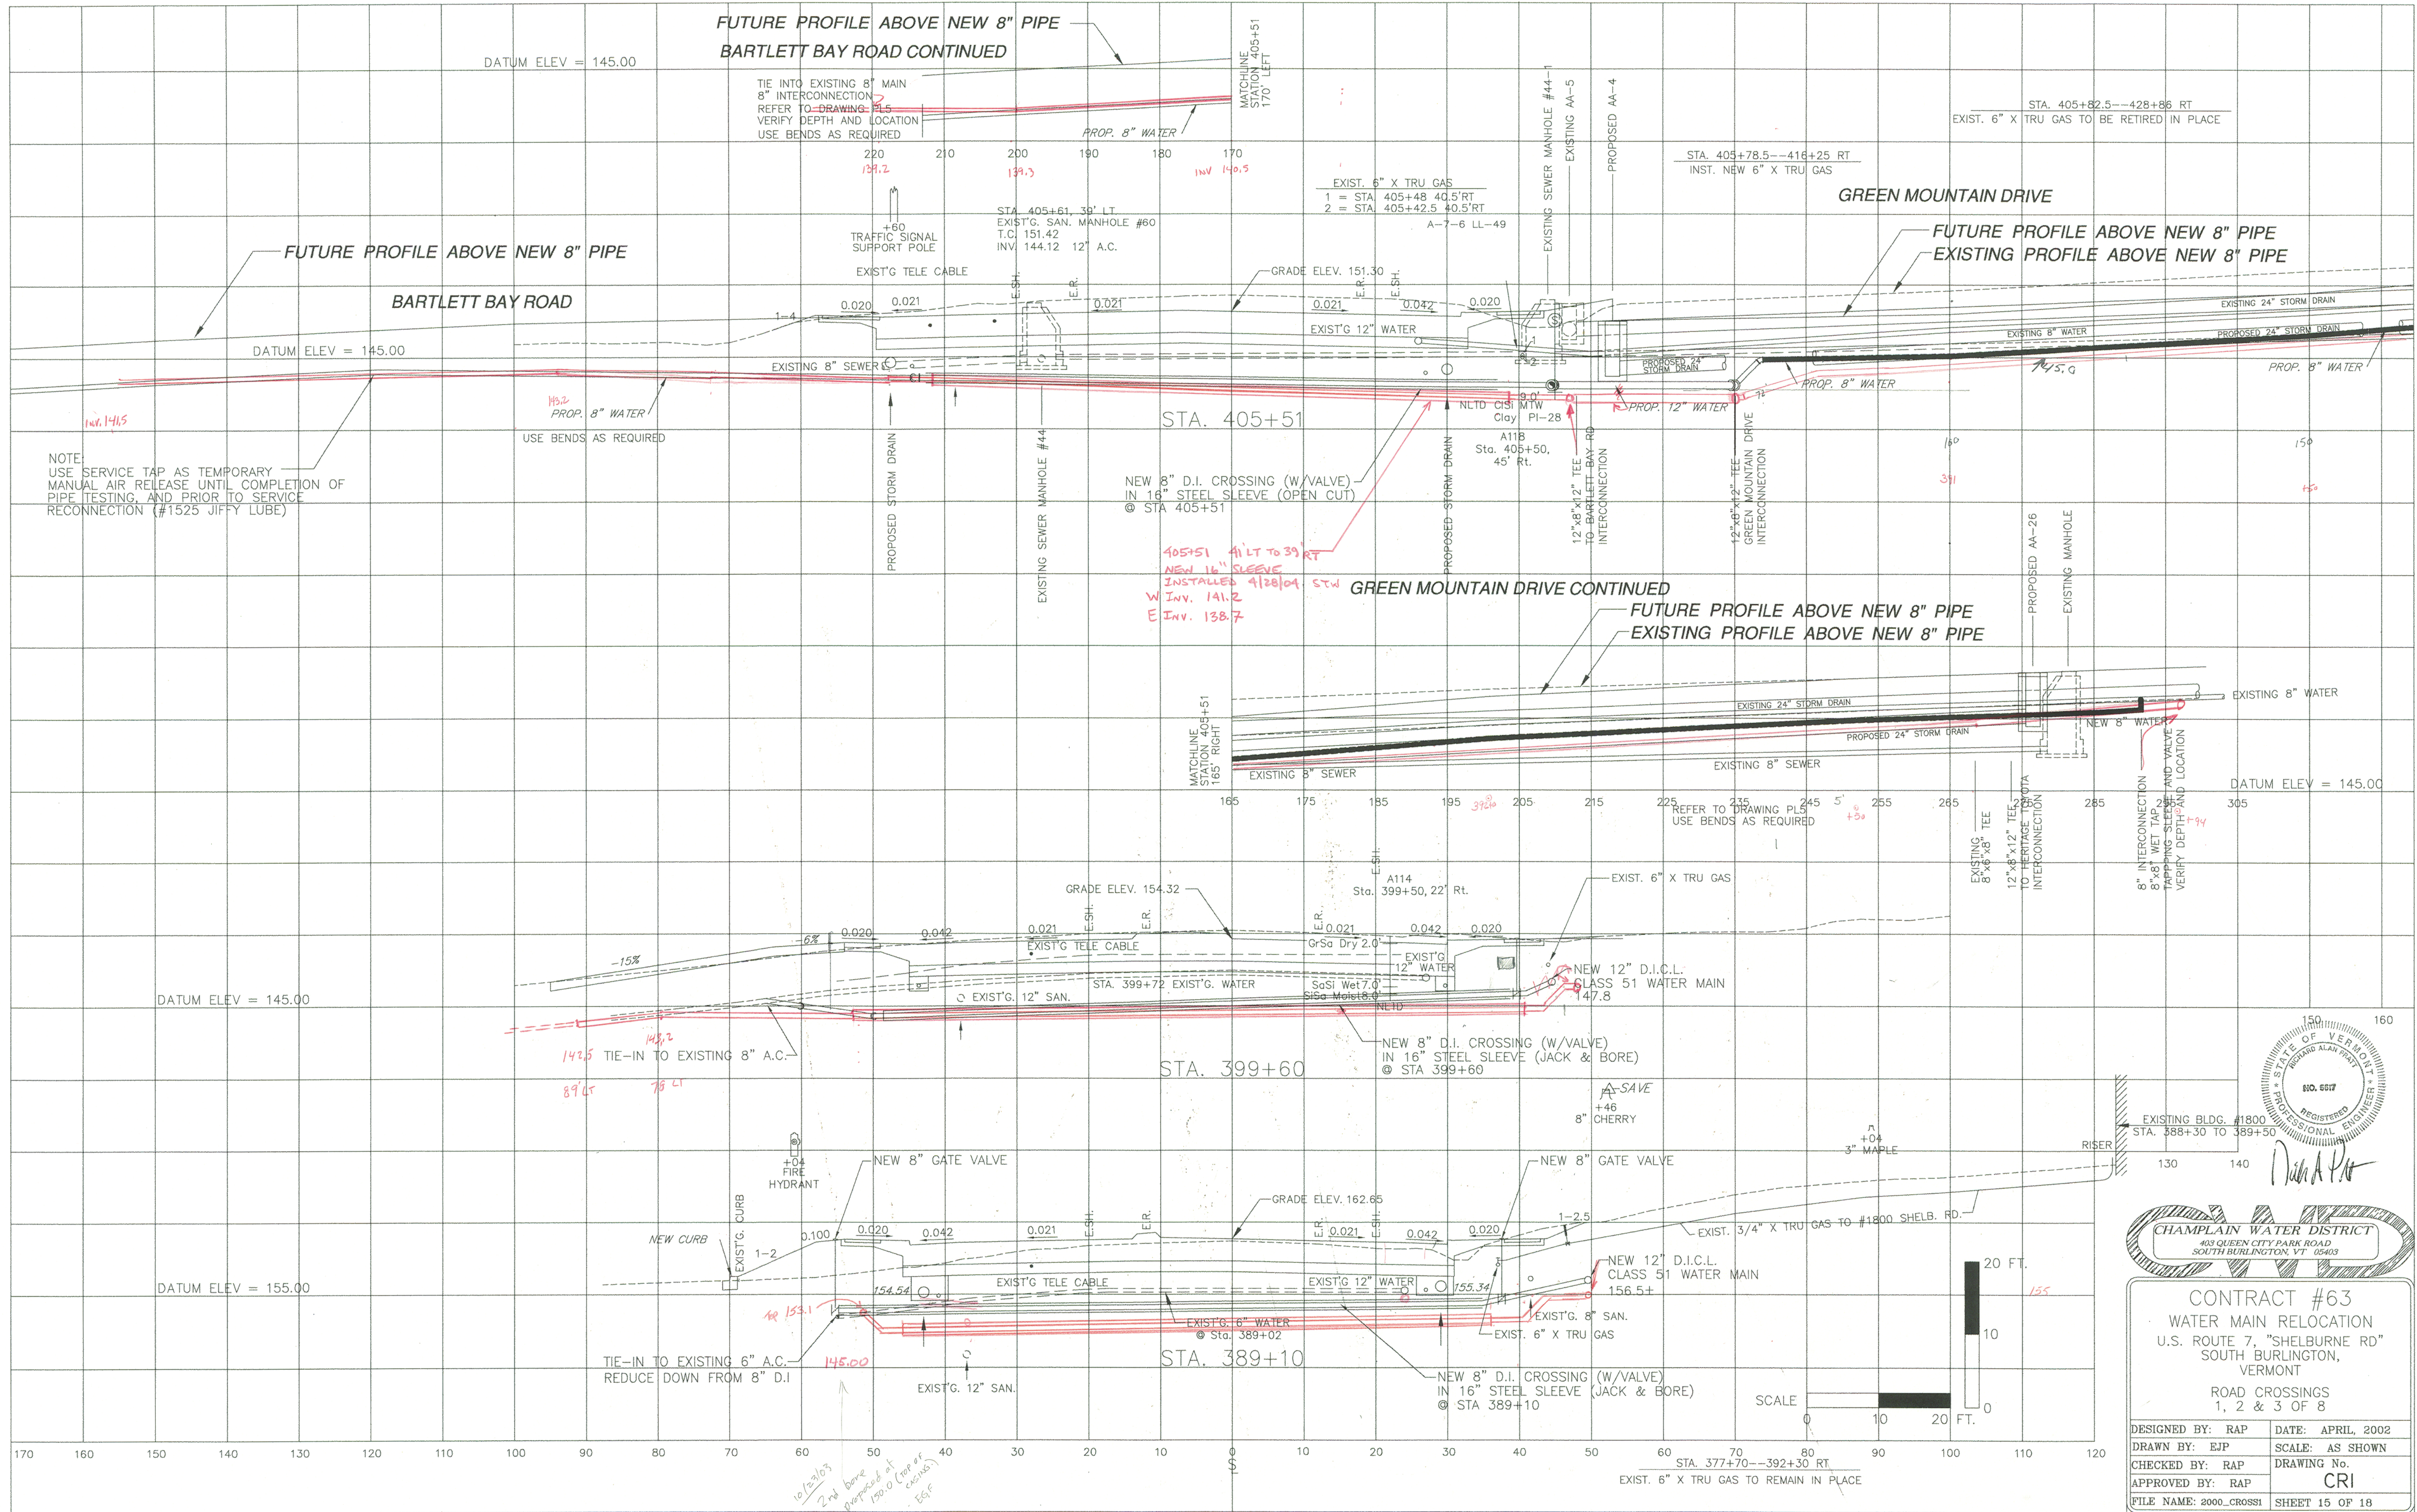

STATE OF VERMONT
REGISTERED PROFESSIONAL ENGINEER
NO. 6617
Dana A. Piro

CHAMPLAIN WATER DISTRICT
403 QUEEN CITY PARK ROAD
SOUTH BURLINGTON, VT 05403

CONTRACT #63
WATER MAIN RELOCATION
SOUTH BURLINGTON,
VERMONT

ROAD CROSSINGS
1, 2 & 3 OF 8

DESIGNED BY: RAP	DATE: APRIL, 2002
DRAWN BY: EJP	SCALE: AS SHOWN
CHECKED BY: RAP	DRAWING No.
APPROVED BY: RAP	CRI
FILE NAME: 2000_CROSS1	SHEET 15 OF 18

256 OF 283