


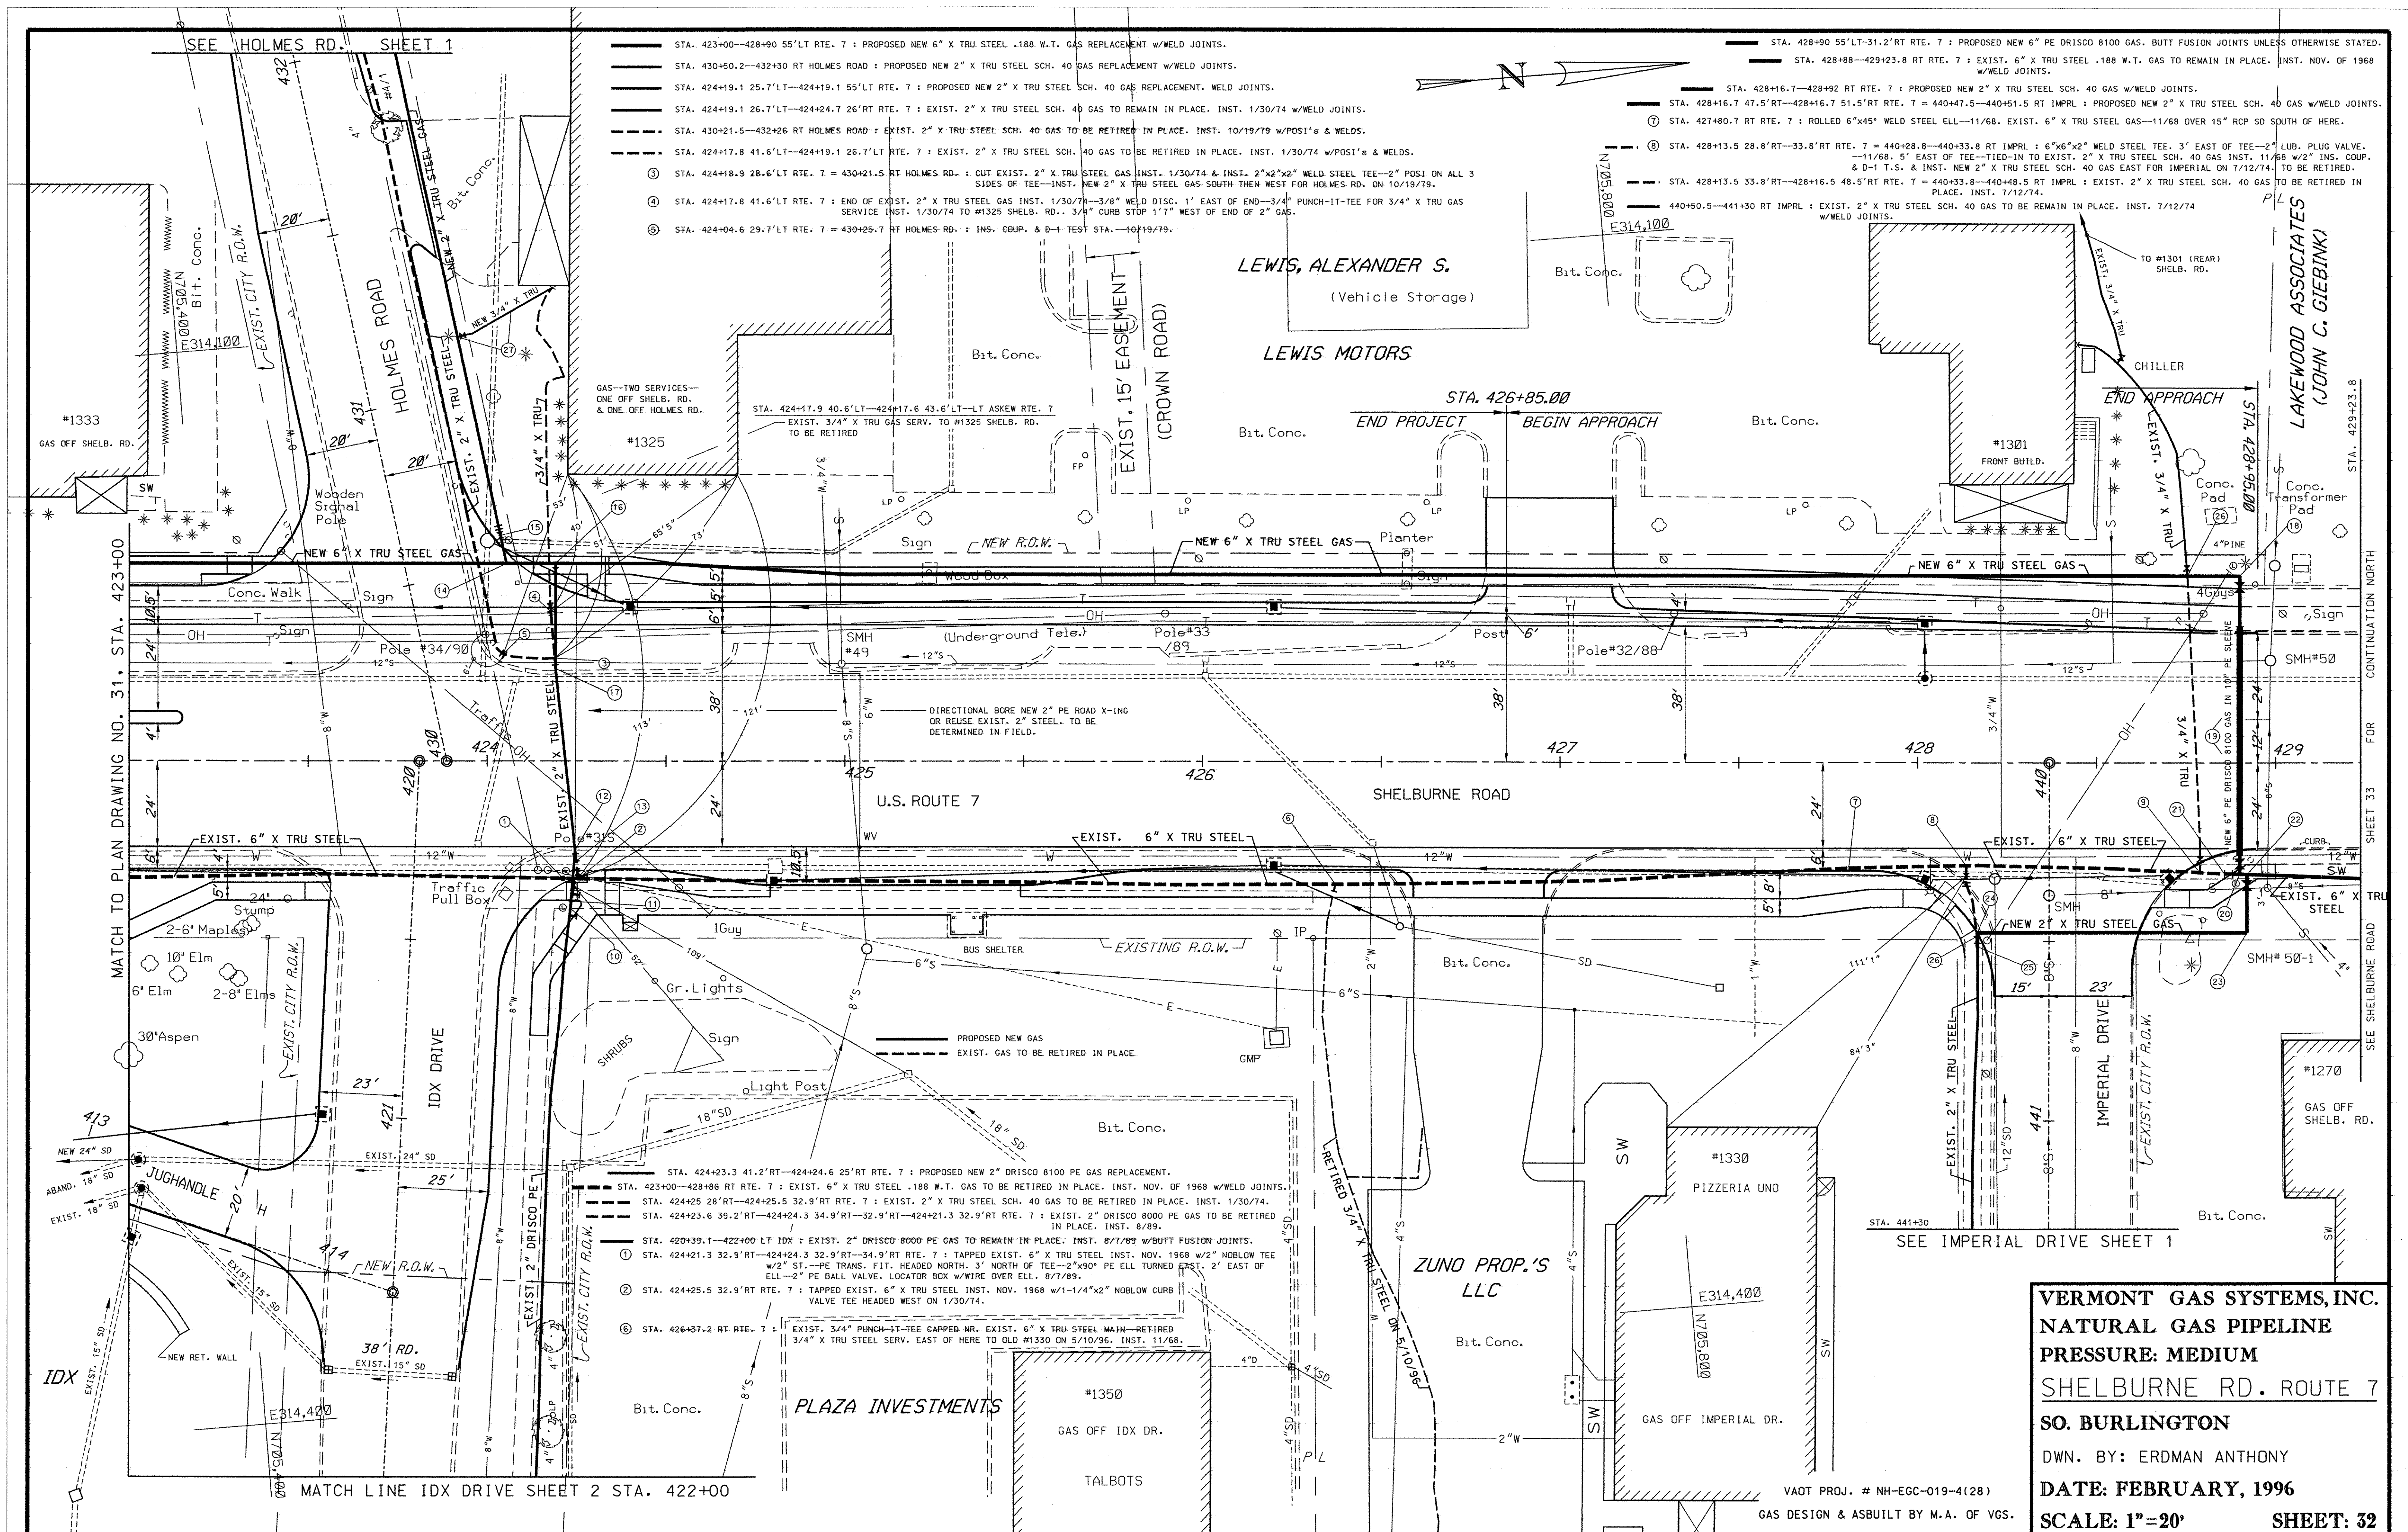

VERMONT GAS SYSTEMS, INC.
NATURAL GAS PIPELINE
PRESSURE: MEDIUM
SHELBURNE RD. ROUTE 7
SO. BURLINGTON
DWN. BY: ERDMAN ANTHONY
DATE: FEBRUARY, 1996
SCALE: 1"=20' **SHEET: 32**