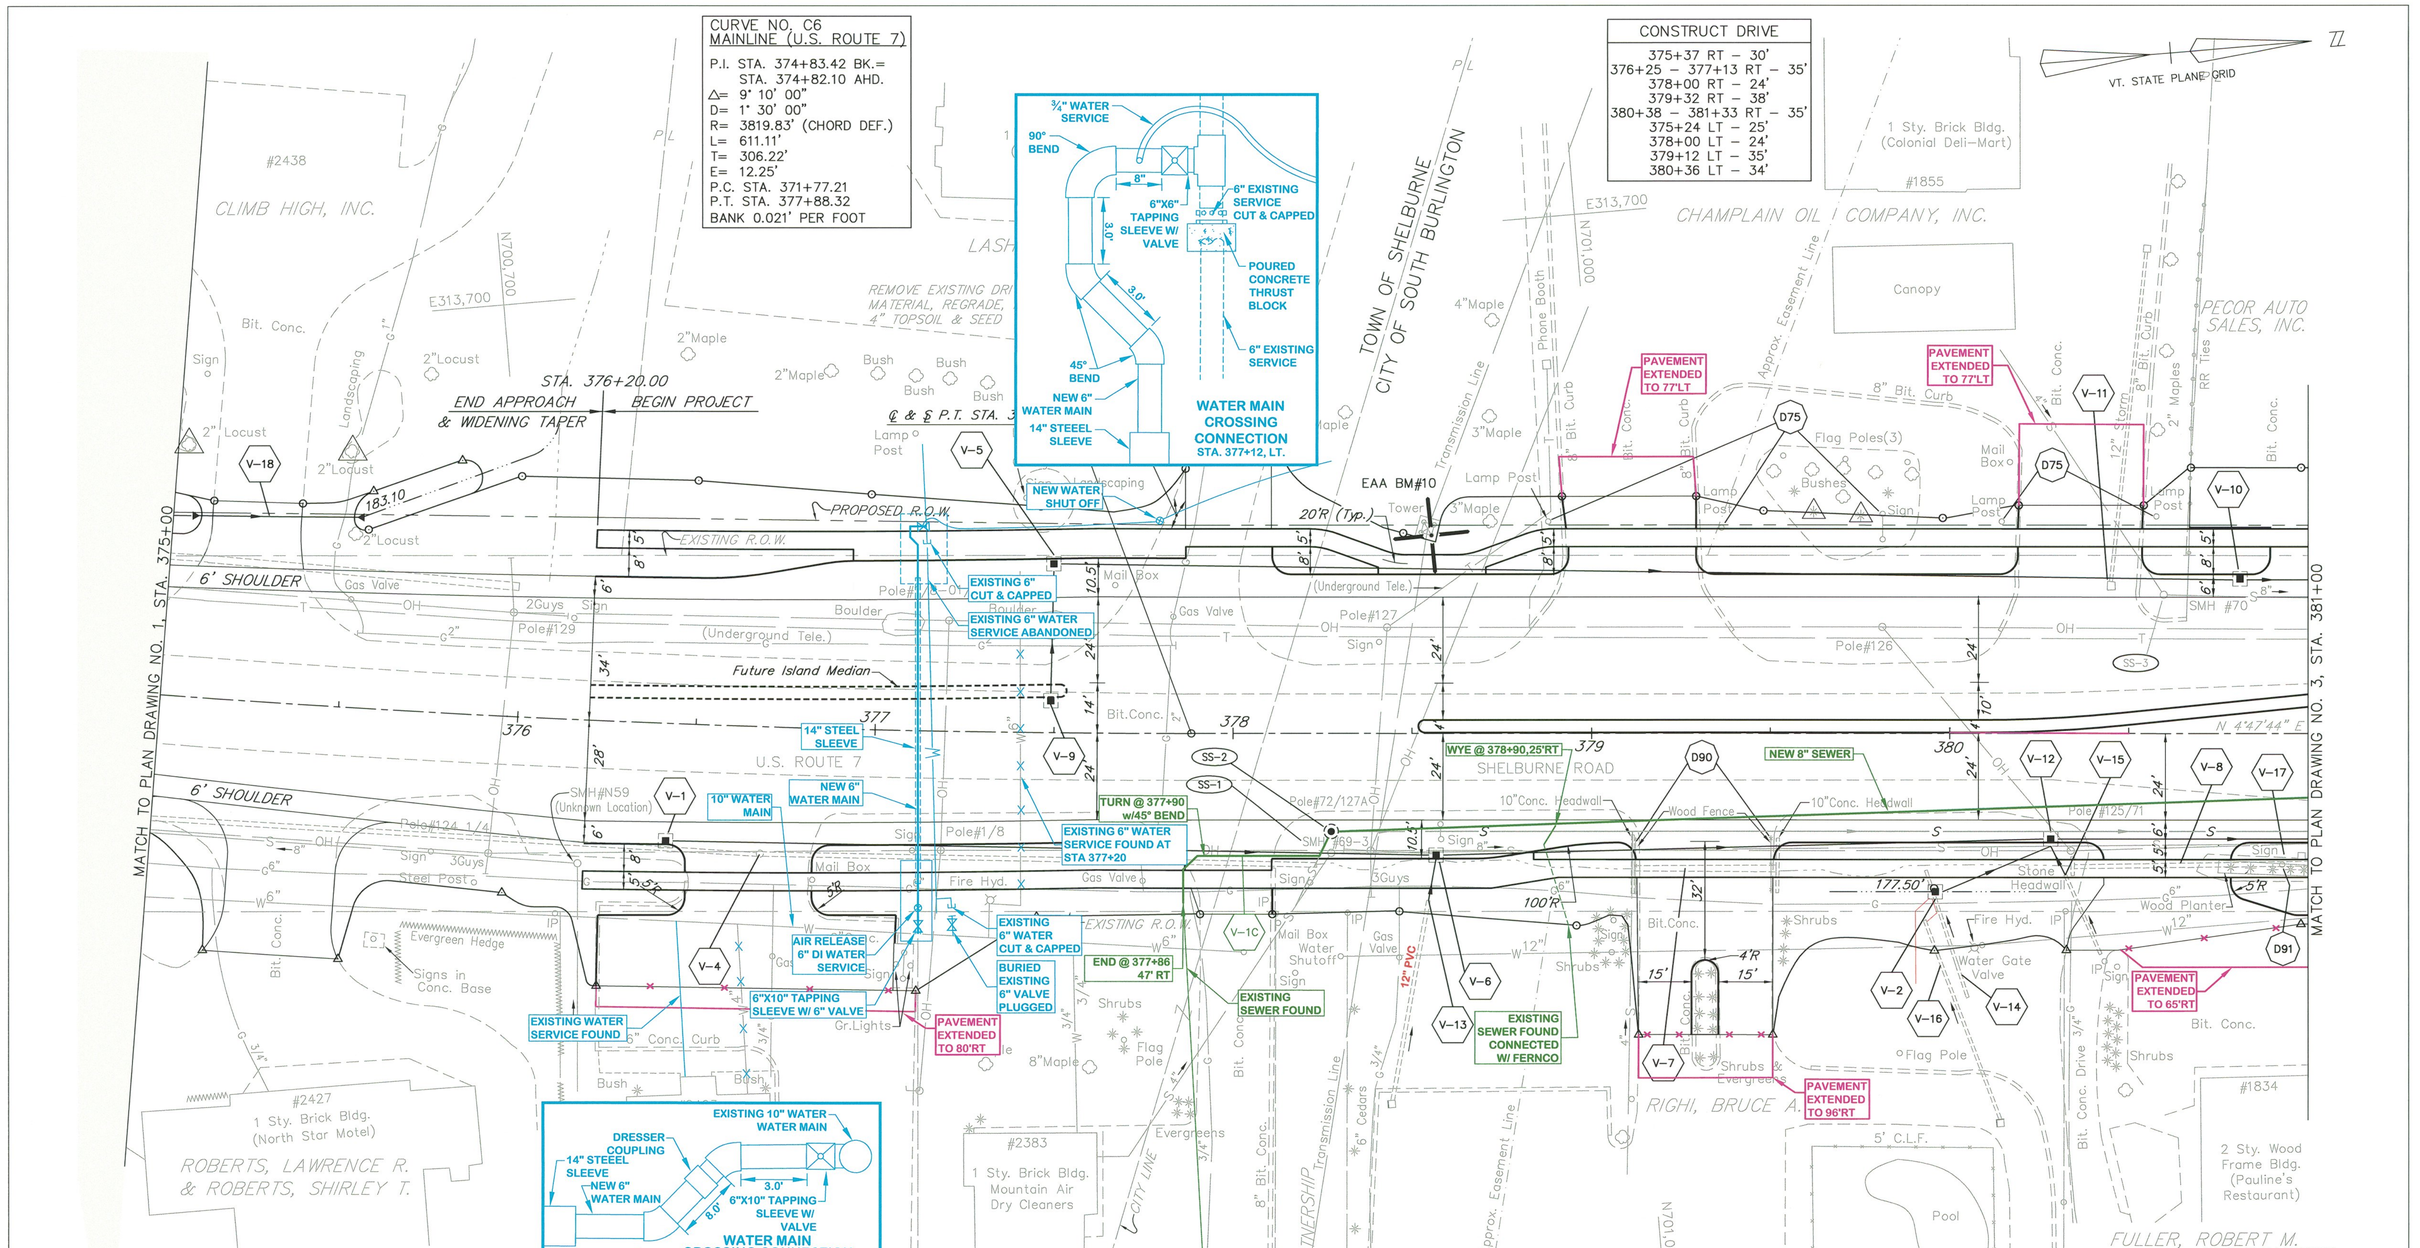

PORTLAND CEMENT CONCRETE SIDEWALK – 5"
376+20 – 376+43 RT
376+92 – 377+81 RT
378+19 – 379+06 RT
379+58 – 380+36 RT
380+85 – 381+00 RT
376+20 – 377+81 LT
378+19 – 378+88 LT
379+37 – 380+12 LT
380+60 – 380+82 LT

PORTLAND CEMENT CONCRETE SIDEWALK – 5" (MEDIAN WIDTH 4–6 FT.)
378+52 TO 381+00

DEMOLITION & DISPOSAL OF:
D75 @ 378+90, LT TO 380+15, LT (4 LPs & SIGN*)
D90 @ 379+10, RT (FENCE) @ 379+50, RT (FENCE)
D91 @ 380+90, RT (SIGN & PLANTER)
* – REMOVED BY OTHERS AS OF JAN. 2003

DATUM
VERTICAL NGVD 1929
HORIZONTAL NAD 1927

NOTES:

1. UNDERGROUND UTILITY LOCATIONS ARE PLOTTED BASED ON THE BEST AVAILABLE INFORMATION. LOCATIONS SHOULD BE VERIFIED BY THE CONTRACTOR BEFORE WORK.
2. SEE PLAN NOTES DRAWING NO. 1 FOR PLAN NOTES AND GENERAL NOTES.
3. THE WATERLINE AT STA. 377+40 MAY BE IMPACTED DURING CONSTRUCTION. SEE NOTE 18 ON PLAN NOTES DRAWING NO. 1 FOR DETAILS.

AS-BUILT REVISIONS

NO.	DATE	DESCRIPTION
1.	3/1/06	ADDED WATER, SEWER & PAVEMENT
2.	8/9/06	FINAL WATERLINE EDITS

FOR PROFILE SEE PROFILE DRAWING NO. 2

PORTLAND CEMENT CONCRETE SIDEWALK – 8"
376+43 – 376+92 RT
377+81 – 378+19 RT
379+06 – 379+58 RT
380+36 – 380+85 RT
377+81 – 378+19 LT
378+88 – 379+37 LT
380+12 – 380+60 LT
380+82 – 381+00 LT

SCALE IN FEET
0 20 40

AS-BUILT LEGEND
WATER AS-BUILTS
SEWER AS-BUILTS
DRAINAGE AS-BUILTS
ELECTRICAL AS-BUILTS
PAVEMENT /OTHER AS-BUILTS

SHELBURNE – SOUTH BURLINGTON

SURVEYED BY V.S.C. INC. DATE
DRAWN BY E.A.A. INC. DATE
TRACED BY E.A.A. INC. DATE

PROJECT NH-EGC-019-4(28)
PLAN DRAWING NO. 2
SHEET NO. 70 OF 283

K:\83S008 (US Rte 7 Shelburne Rd)\AS-BUILTS\WATER-SEWER\AS BUILT Pk_24_4_02.DWG, Layout1, 9/12/2006 9:42:18 AM, parmatis, \\vhf-bh1\0\TFBRL_HP1055cm East