

1. UNDERGROUND UTILITY LOCATIONS ARE PLOTTED BASED ON THE BEST AVAILABLE INFORMATION. LOCATIONS SHOULD BE VERIFIED BY THE CONTRACTOR BEFORE WORK.


2. SEE PLAN NOTES DRAWING NO. 1 FOR PLAN NOTES AND GENERAL NOTES.

3. VERSION UNDERGROUND TELEPHONE (STA. 396+50 - STA. 405+50 RT) 1.364M (W) 1.364M (W)

PORTLAND CEMENT	393+00 -	394+05 RT
CONCRETE SIDEWALK - 5"	394+54 RT	396+83 RT
	397+09 -	399+00 RT
	393+00 -	394+05 LT
	394+54 -	395+19 LT
	396+41 -	399+00 LT

CONSTRUCT DRIVE	394+29 RT - 35' 394+29 LT - 35' 396+16 LT - 36' 396+96 RT - 12'
-----------------	--

DEMOLITION & DISPOSAL OF:
74 @ 398+95, LT (LAMP POST*)
97 @ 394+05, RT (SIGN* & PLANTER)
REMOVED BY OTHERS AS OF JAN. 2003

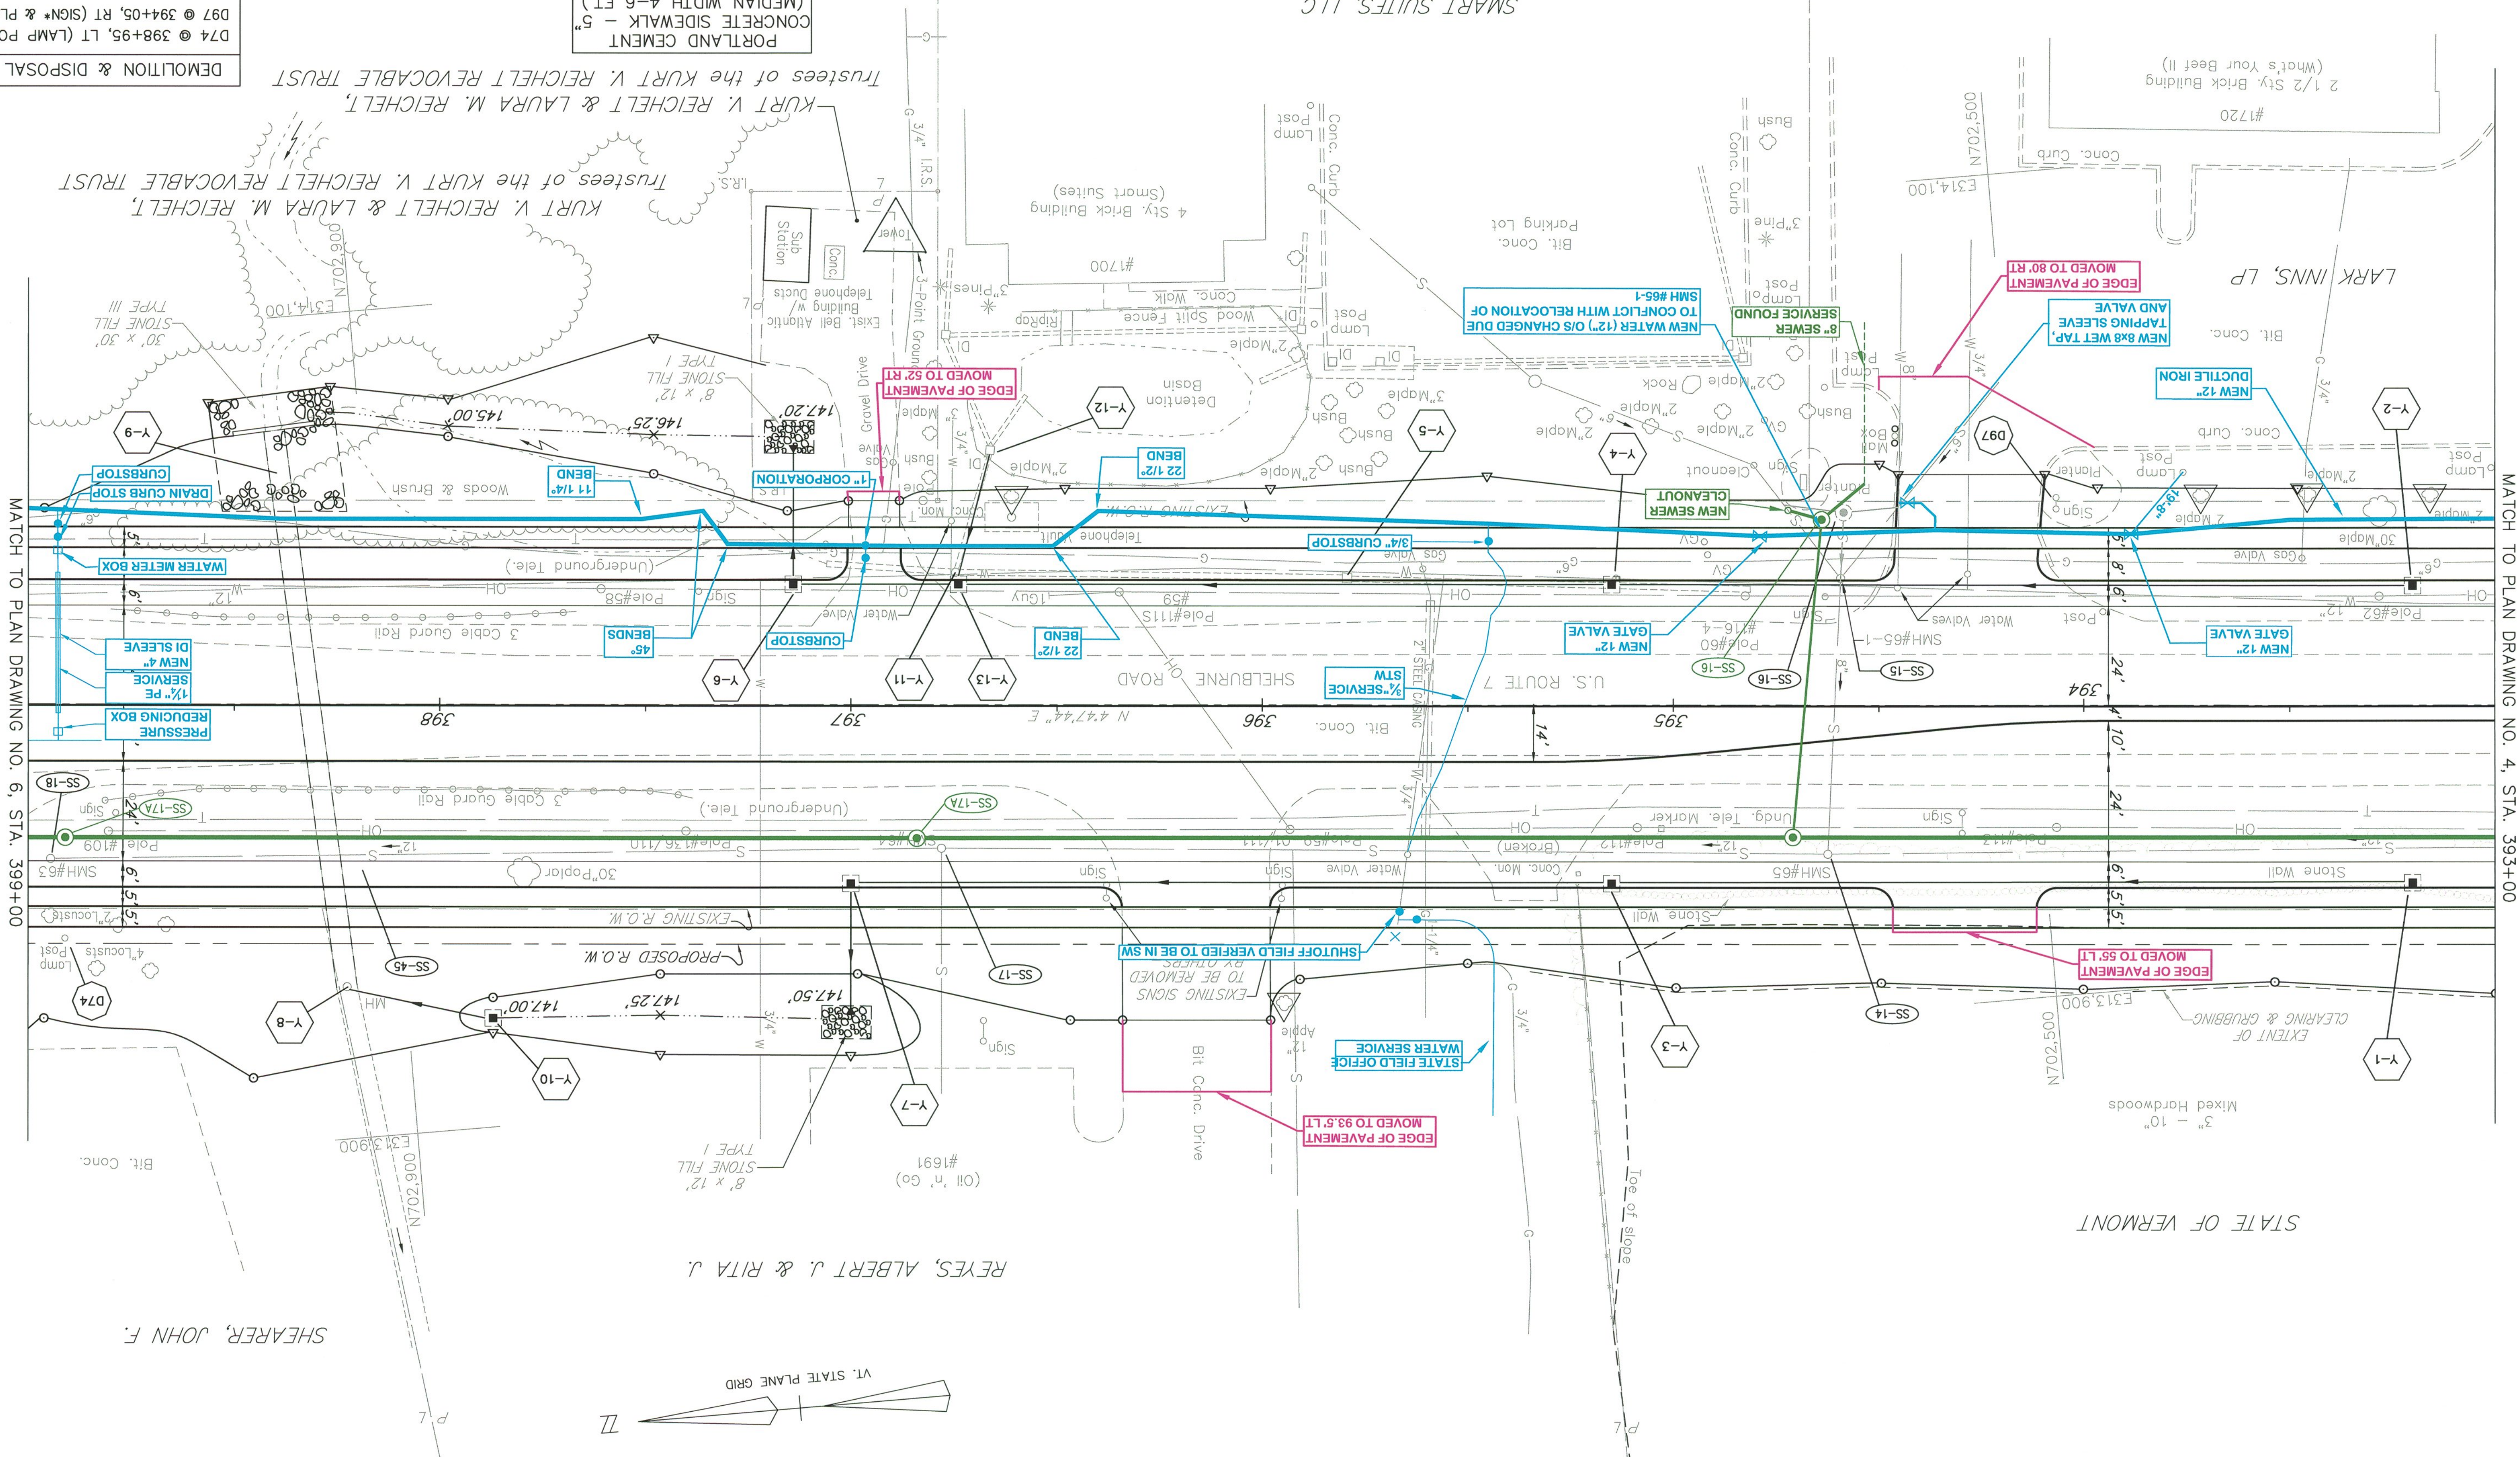

MATCH TO PLAN DRAWING NO. 4, STA. 393+00