


K:\6330008 [US Rte 7 Shelburne Rd]AS-BUILT WATER-SEWER\Pr2_2000.dwg, Layout1, 9/5/2006 11:26:15 AM, jammata, VT-BRL-HP (1055cm Email)Page-Draft1.jcd

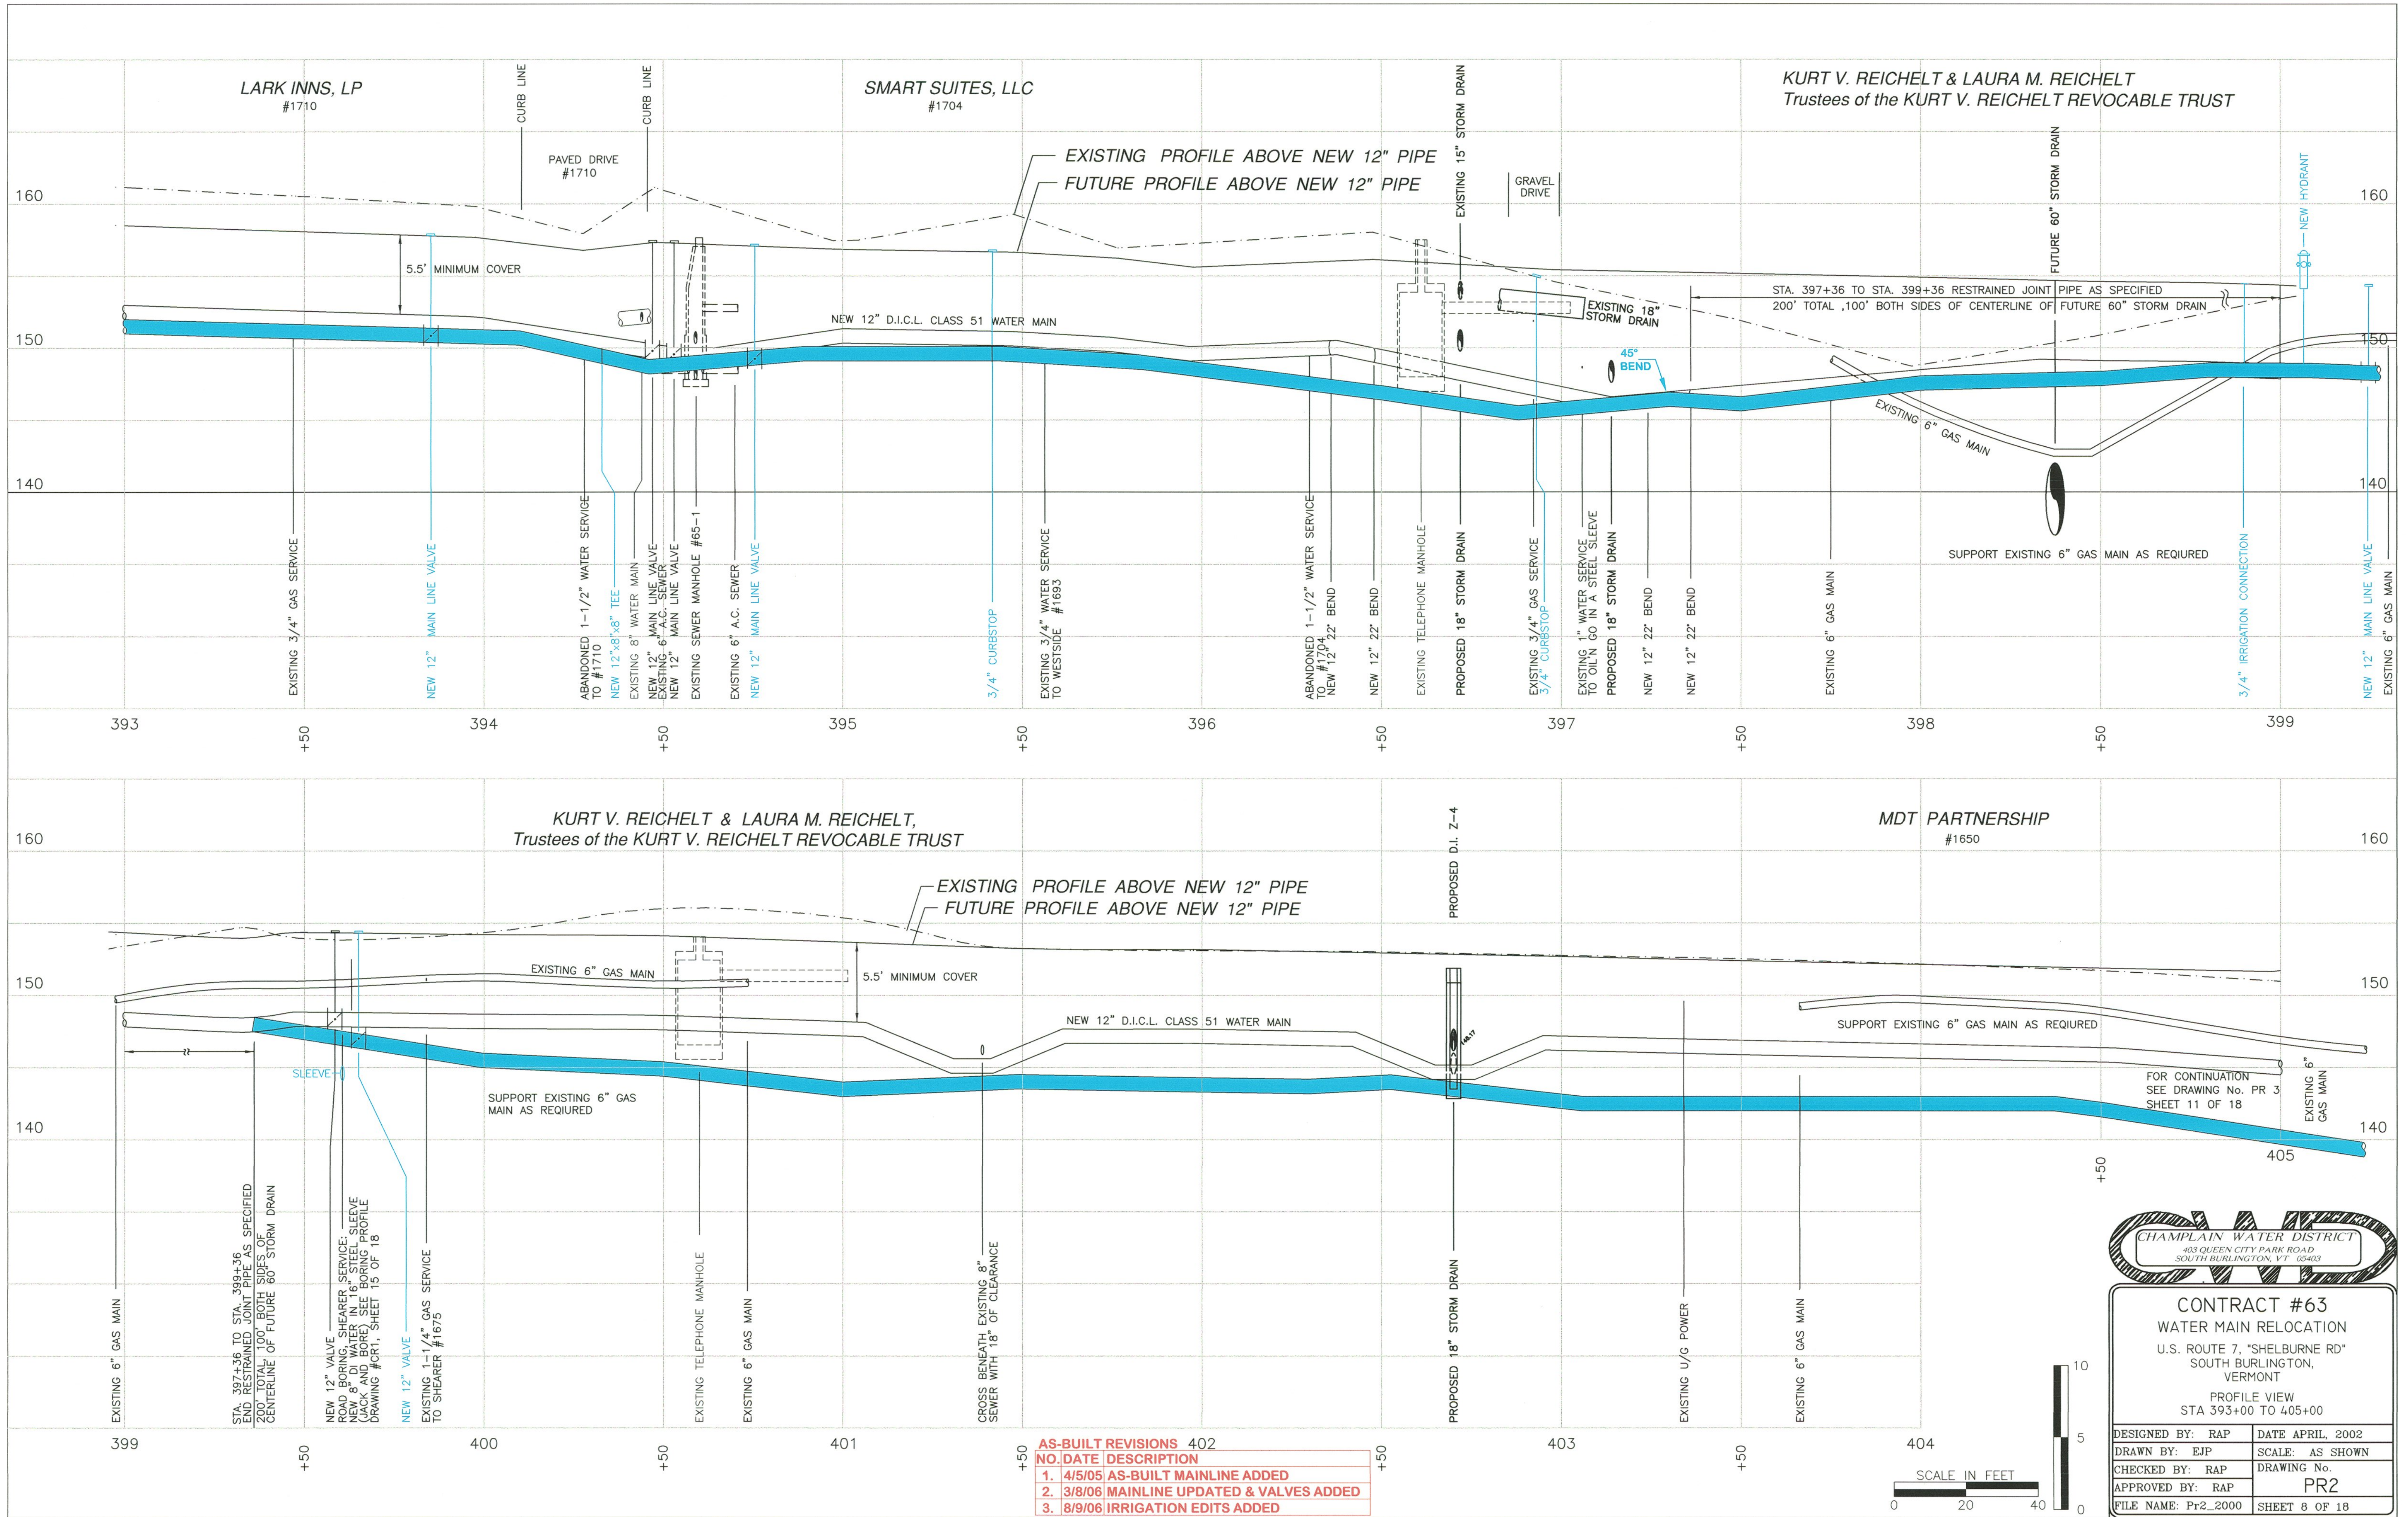

CHAMPLAIN WATER DISTRICT
403 QUEEN CITY PARK ROAD
SOUTH BURLINGTON, VT 05403

CONTRACT #63
WATER MAIN RELOCATION
U.S. ROUTE 7, "SHELBURNE RD"
SOUTH BURLINGTON, VERMONT

PROFILE VIEW
STA 393+00 TO 405+00

DESIGNED BY: RAP	DATE: APRIL, 2002
DRAWN BY: EJP	SCALE: AS SHOWN
CHECKED BY: RAP	DRAWING No. PR2
APPROVED BY: RAP	SHEET 8 OF 18
FILE NAME: Pr2_2000	

249 OF 283