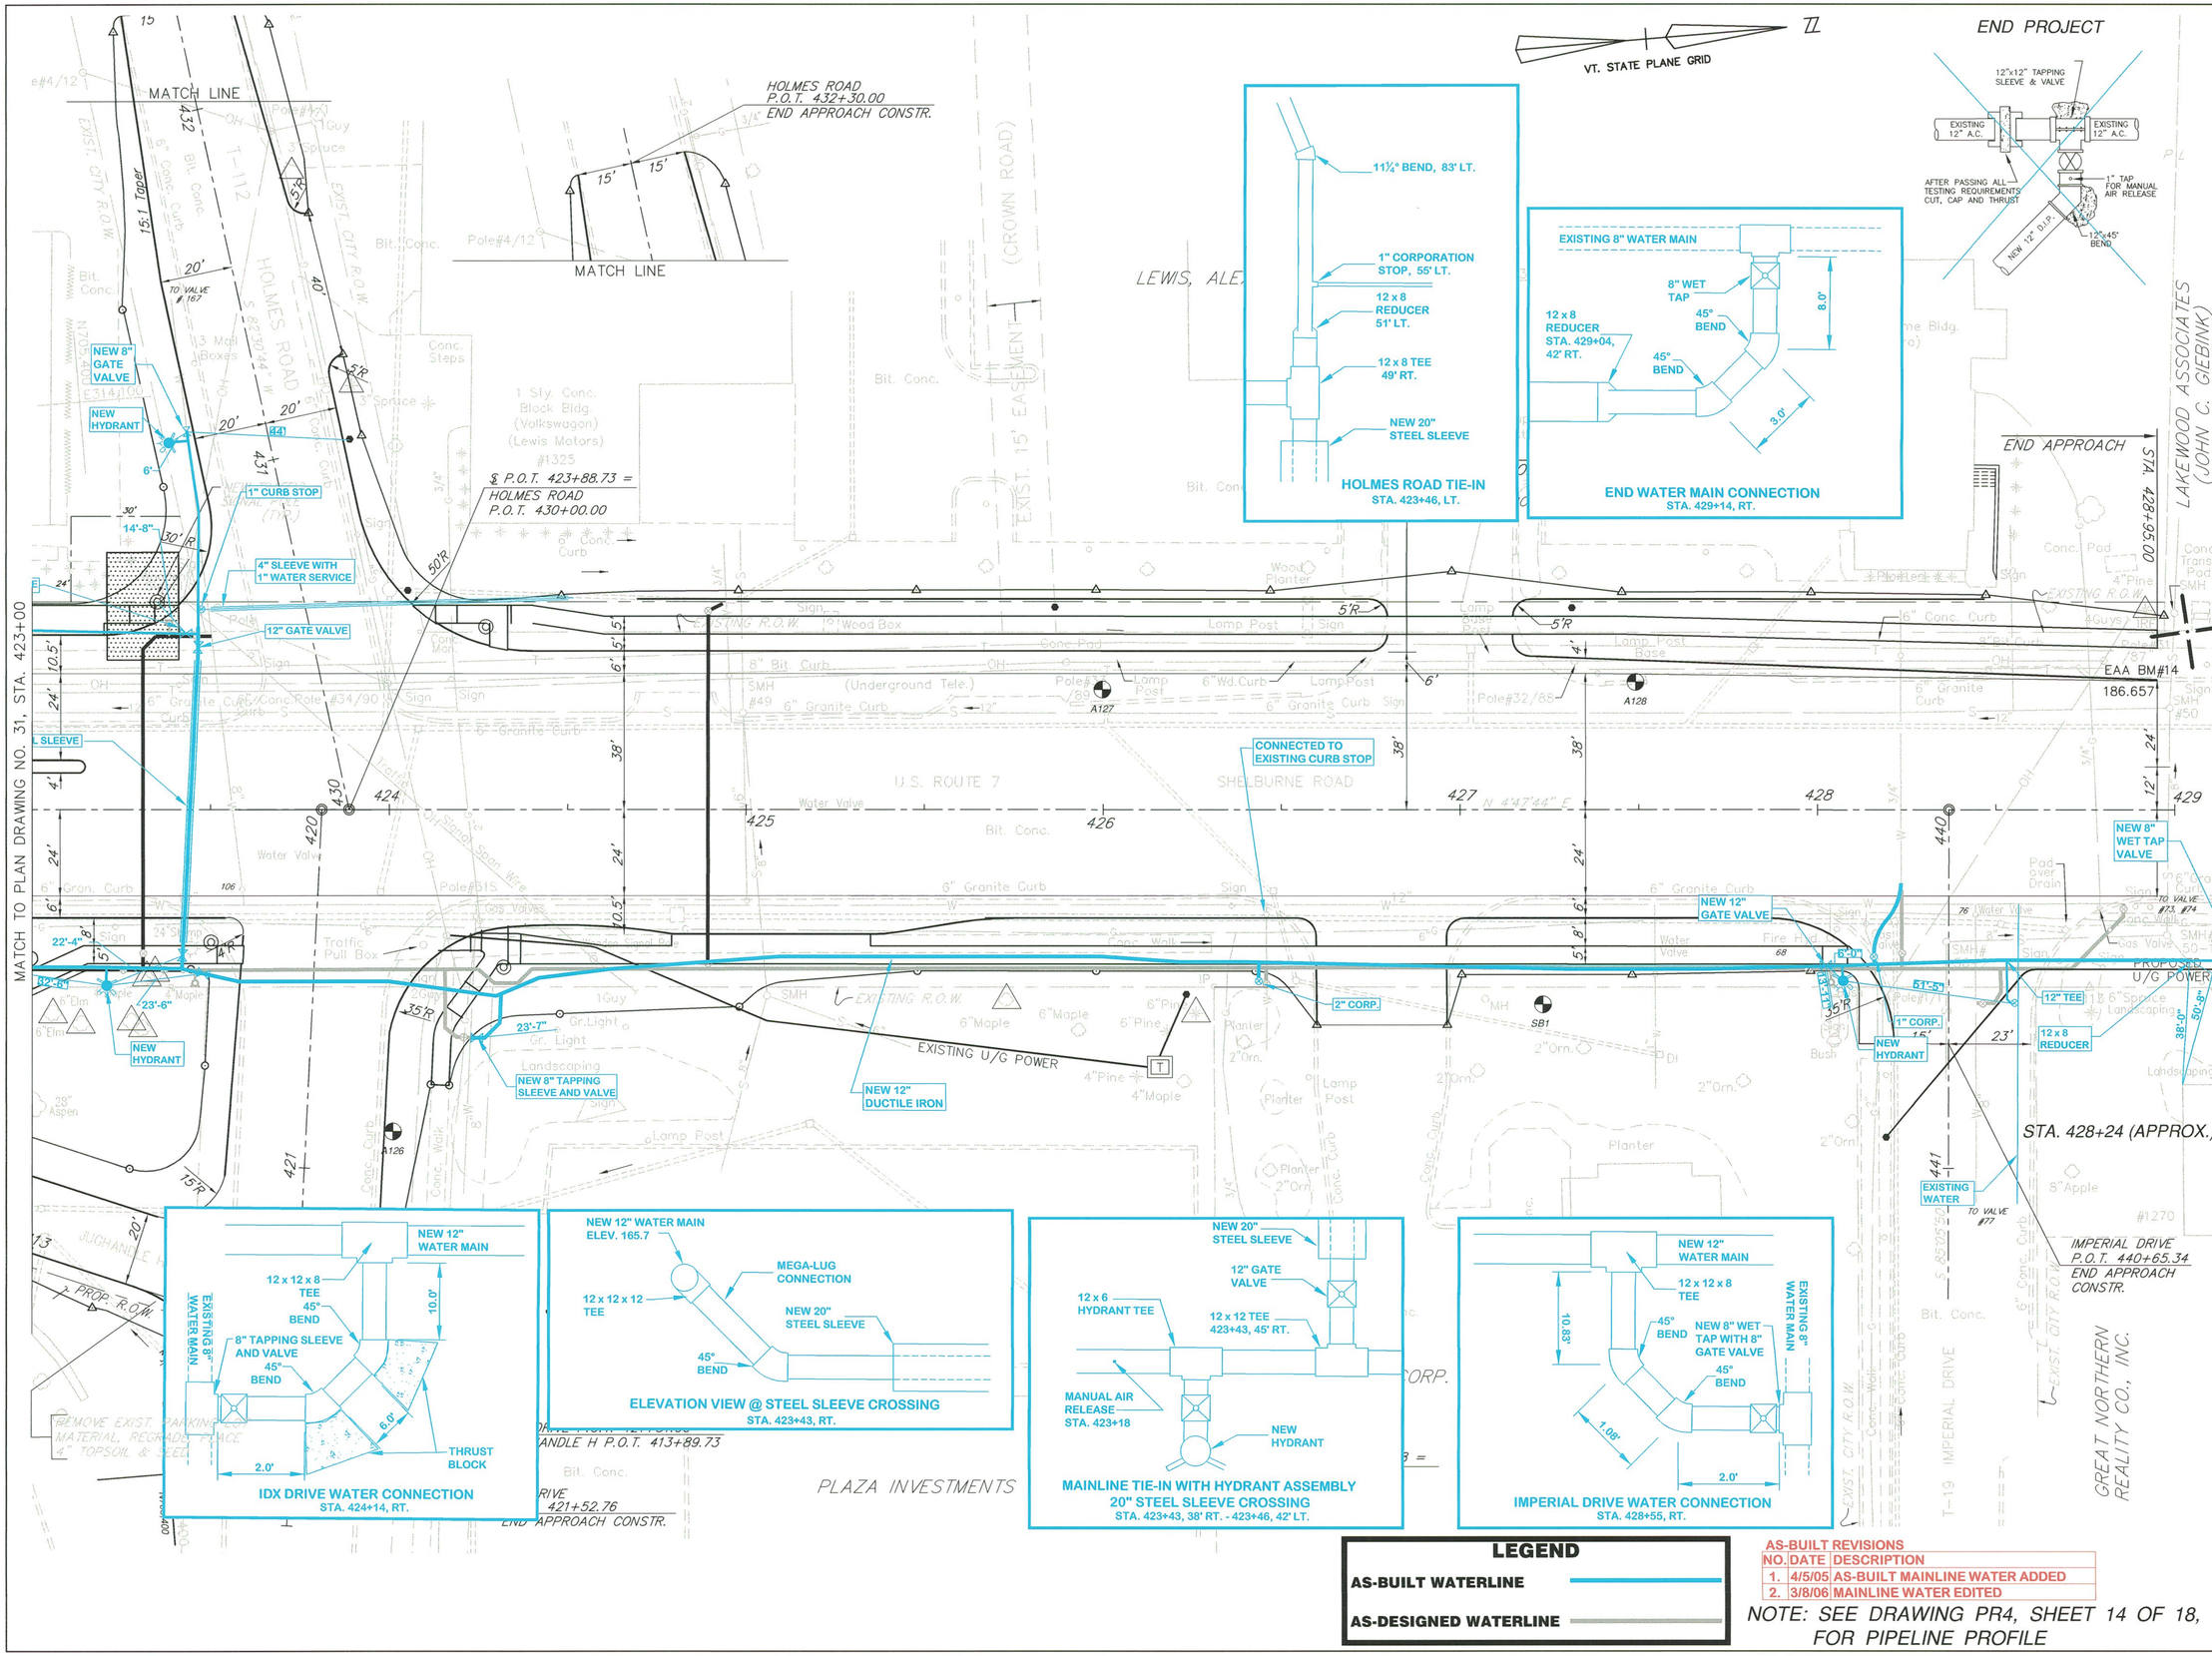

LEGEND

- AS-BUILT WATERLINE
- AS-DESIGNED WATERLINE

AS-BUILT REVISIONS

NO.	DATE	DESCRIPTION
1.	4/5/05	AS-BUILT MAINLINE WATER ADDED
2.	3/8/06	MAINLINE WATER EDITED

NOTE: SEE DRAWING PR4, SHEET 14 OF 18, FOR PIPELINE PROFILE

CHAMPLAIN WATER DISTRICT
403 Queen City Park Road
South Burlington, VT 05403
Phone: (802) 864-7454
Fax: (802) 864-0435

Dedicated to Quality Water and Service

SCALE: 1" = 20'

REVISIONS

REV. #	DATE	BY

CONTRACT #63

WATER MAIN RELOCATION
U.S. ROUTE 7
"SHELBURNE ROAD"

SOUTH BURLINGTON, VERMONT

PLAN VIEW
STA. 423+00 TO 429+00

254 of 283

DATE:	APRIL, 2002
DESIGNED BY:	SGW
DRAWN BY:	EJP
CHECKED BY:	RAP
APPROVED BY:	RAP
FILE NAME:	2000C63-pl8(32)
SHEET	13 OF 18
DRAWING No.	PL8

K:\6330008 (US Rte 7 Shelburne Rd)\AS-BUILTS\WATER-SEWER\2000C63-pl8(32).dwg, Layout1, 8/5/2006 11:16:42 AM, parmata, VT-BRL-HP1055cm East(Paper-Draft).pc3