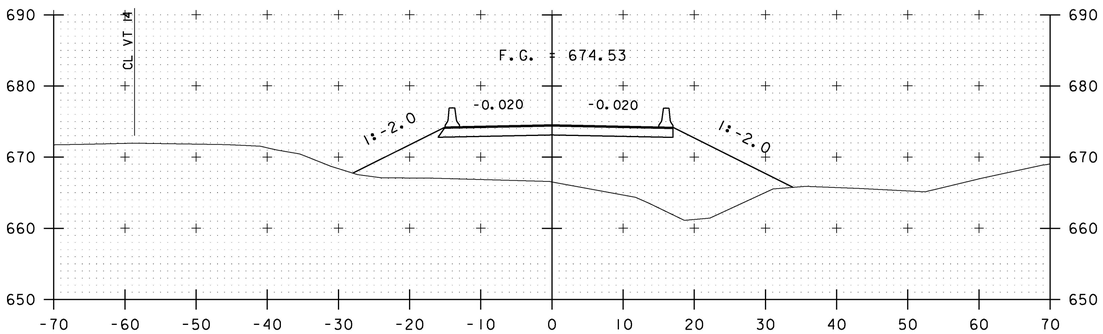

5+50

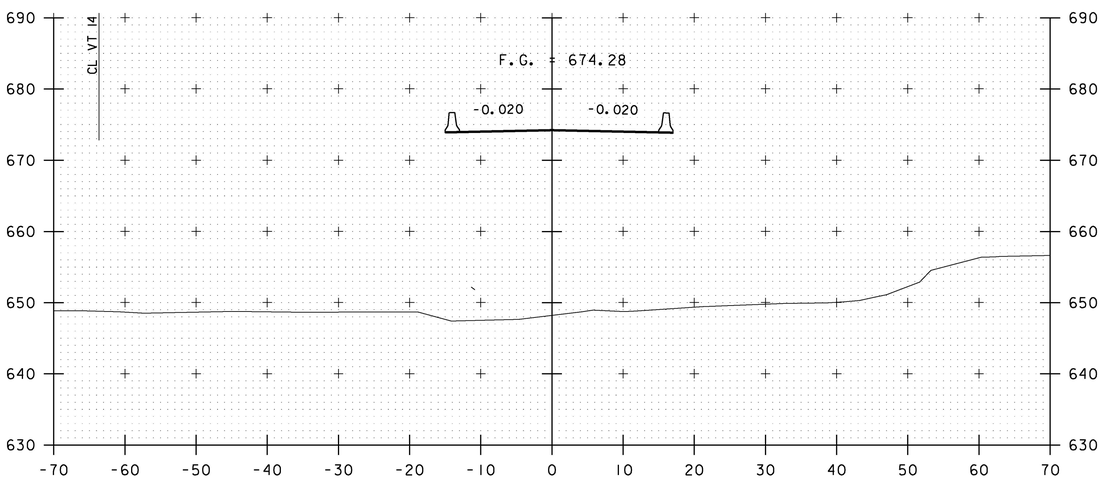

5+00

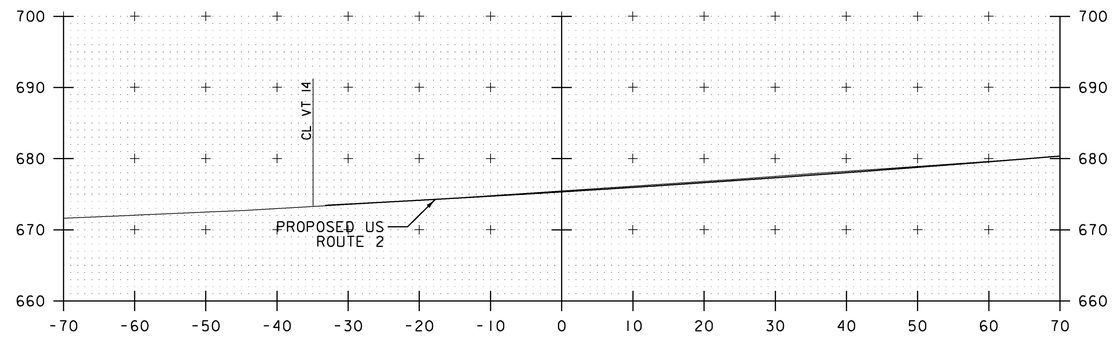

6+34

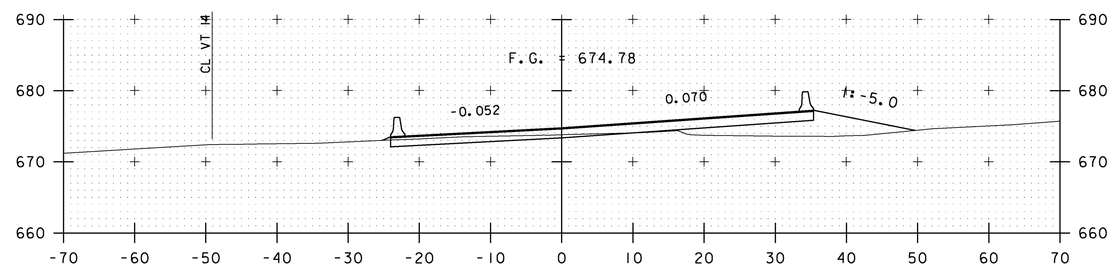

6+00

STA. 5+00 TO STA. 6+34

Stantec

PROJECT NAME: EAST MONTPELIER	
PROJECT NUMBER: BRF 037-1(7)	
FILE NAME: 32_Cross Sections.dgn	PLOT DATE: 2/17/2017
PROJECT LEADER: T. KNIGHT	DRAWN BY: C. GENDRON
DESIGNED BY: C. GENDRON	CHECKED BY: K. RICHARDSON
TEMPORARY CROSS SECTIONS TXS-3	SHEET 116 OF 158