SEE SHEET 2 INDEX OF SHEETS

STATE OF VERMONT
AGENCY OF TRANSPORTATION

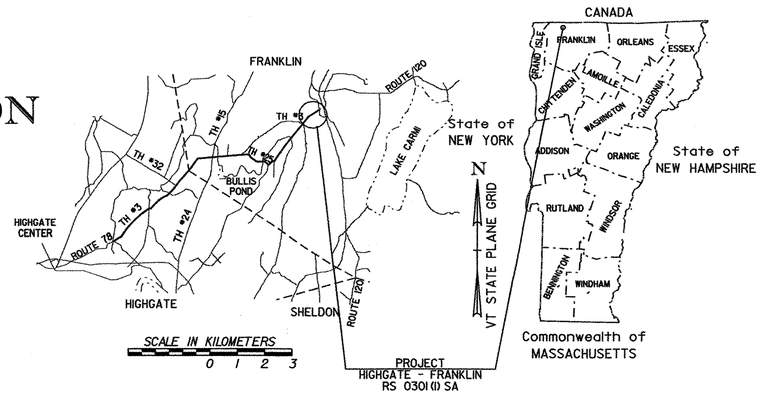

PROPOSED IMPROVEMENT
TOWN OF FRANKLIN
COUNTY OF FRANKLIN

TOWN HIGHWAY NO. 3, CLASS 2 (MAJOR COLLECTOR)

PROJECT LOCATION:
BEGINNING ON FRANKLIN TOWN HIGHWAY 3, 0.438KM FROM THE INTERSECTION OF FRANKLIN TOWN HIGHGWAY 21 AND 3, AND EXTENDING IN A NORTHEASTERLY DIRECTION TO END AT THE INTERSECTION OF FRANKLIN TOWN HIGHWAY 3 AND VERMONT ROUTE 120

LENGTH OF ROADWAY = 434.139 m = 0.434KM
LENGTH OF PROJECT = 434.139 m = 0.434KM

PROJECT DESCRIPTION:
RECONSTRUCTION OF TOWN HIGHWAY 3 IN THE VILLAGE OF FRANKLIN, INCLUDING NEW DRAINAGE SYSTEM, SUBBASE, BITUMINOUS CONCRETE PAVEMENT AND CURB

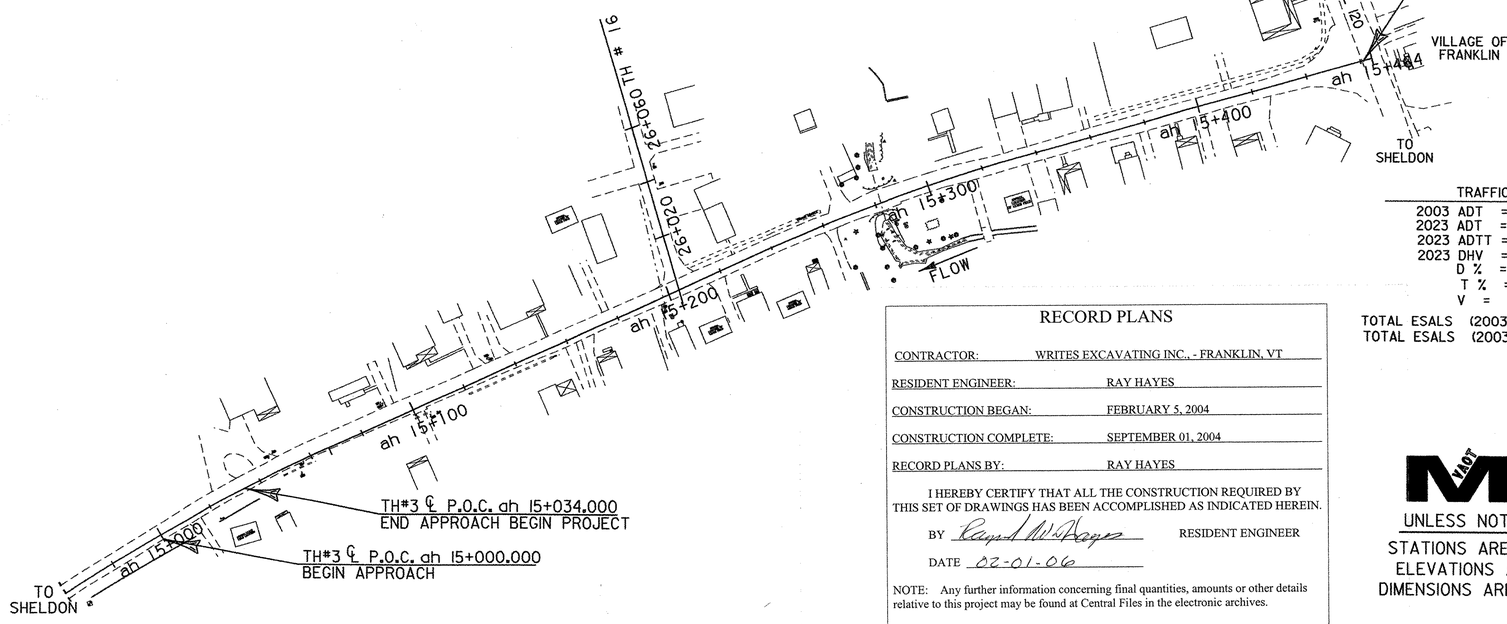

TRAFFIC DATA

2003 ADT	= 300
2023 ADT	= 400
2023 ADTT	= 30
2023 DHV	= 105
D %	= 59
T %	= 5
V	= 50 KPH

TOTAL ESALS (2003 ~ 2023) = 80,000
TOTAL ESALS (2003 ~ 2043) = 209,000

CONVENTIONAL SYMBOLS

COUNTY LINE
TOWN LINE
LIMITS OF ACCESS
POINT OF ACCESS
FENCE LINE
STONE WALL
TRAVELED WAY
GUARD RAIL
RAILROAD
SURVEY LINE
CULVERT
POWER POLE
TELEPHONE POLE
TREES
CONTROL OF ACCESS
PROPERTY LINE
R.O.W. TAKING LINE
SLOPE RIGHTS SR SR SR
TOP OF CUT
TOE OF SLOPE

SURVEYED BY :
SURVEYED DATE :

DATUM
VERTICAL NGVD 1929
HORIZONTAL N/A

0 20 40 60 80 100
SCALE IN METERS

RECORD PLANS

CONTRACTOR: WRITES EXCAVATING INC., - FRANKLIN, VT
RESIDENT ENGINEER: RAY HAYES
CONSTRUCTION BEGAN: FEBRUARY 5, 2004
CONSTRUCTION COMPLETE: SEPTEMBER 01, 2004
RECORD PLANS BY: RAY HAYES

I HEREBY CERTIFY THAT ALL THE CONSTRUCTION REQUIRED BY THIS SET OF DRAWINGS HAS BEEN ACCOMPLISHED AS INDICATED HEREIN.

BY Raymond W. Hayes RESIDENT ENGINEER
DATE 02-01-06

NOTE: Any further information concerning final quantities, amounts or other details relative to this project may be found at Central Files in the electronic archives.

VAOT Metric
UNLESS NOTED OTHERWISE
STATIONS ARE IN KILOMETERS
ELEVATIONS ARE IN METERS
DIMENSIONS ARE IN MILLIMETERS

THESE PLANS ARE SUBJECT TO SUCH ENGINEERING CHANGES AS MAY BE REQUIRED BY THE FEDERAL HIGHWAY ADMINISTRATION OR THE DIRECTOR OF PROGRAM DEVELOPMENT.

CONSTRUCTION IS TO BE CARRIED ON IN ACCORDANCE WITH THESE PLANS AND THE STANDARD SPECIFICATIONS FOR CONSTRUCTION DATED 2001, AS APPROVED BY THE FEDERAL HIGHWAY ADMINISTRATION ON JANUARY 4, 2001 FOR USE ON THIS PROJECT, INCLUDING ALL SUBSEQUENT REVISIONS AND SUCH REVISED SPECIFICATIONS AND SPECIAL PROVISIONS AS ARE INCORPORATED IN THESE PLANS.

...85c060/design/dc0602nul.dgn
(2)dc060111.1

DIRECTOR OF PROGRAM DEVELOPMENT
APPROVED Daniel J. Boyle DATE 4/3/03

PROJECT MANAGER : G. DuBray

PROJECT NAME : FRANKLIN
PROJECT NUMBER : STP 0301(18)

SHEET 1 OF 60 SHEETS

INDEX OF SHEETS

Metric

1	TITLE SHEET
2	INDEX OF SHEET
3	TYPICAL SHEETS
4-7	QUANTITY SHEETS
8-9	DRAINAGE SHEETS
10	ITEM DETAIL SHEET
11	EARTHWORKS SHEET
12-16	R.O.W. SHEETS
17-23	PLAN SHEETS AND PROFILE SHEETS
24-26	HEADWALL PLAN AND DETAIL SHEETS
28-29	BANKING TRANSITION SHEETS
30-33	EROSION CONTROL SHEETS
34-36	PAVEMENT MARKINGS & TRAFFIC SIGNING SHEETS
37-38	TRAFFIC SIGN SUMMARY SHEETS
39	CONSTRUCTION APPROACH SIGN SHEET
40-44	LANDSCAPE DETAIL SHEETS
45-55	CROSS SECTION SHEETS
56-58	SIDELINE CROSS SECTION SHEETS
59-60	UNDERGROUND UTILITIES SHEET

STANDARDS

A-76M	STANDARDS FOR TOWN & DEVELOPMENT ROADS	6/13/97
B-5M	SLOPE GRADING, EMBANKMENTS, MUCK	1/3/00
B-11M	UNDERDRAIN - ROCK SUBGRADE, SLOPE STABILIZ.	6/13/97
B-12M	SIDE ROAD INTERSECTION, DEPRESSED RAMP	1/3/00
B-71M	RESIDENTIAL AND COMMERCIAL DRIVES	3/1/01
C-1M	CURBS, BITUMINOUS CONCRETE SIDEWALKS	1/3/00
	GRANITE SLOPE EDGING, VERTICAL GRANITE CURB	
	PRECAST REINFORCED CONCRETE CURB	
	CAST IN PLACE CONCRETE CURB	
	BITUMINOUS CONCRETE CURB, TREATED TIMBER CURB	
C-2AM	CEMENT CONCRETE SIDEWALK, CONCRETE CURB	1/3/00
C-3M	SIDEWALK RAMPS	1/3/00
D-2M	C.R.M. HEADWALLS, UNDERDRAIN	6/13/97
	C.R.M. HEADWALLS & RETAINING WALLS	
	RIPRAP LIGHT TYPE SLOPE HEADWALL	
	REINFORCED CONCRETE HEADWALL,	
	UNDERDRAIN & CARRIER PIPE CONSTRUCTION DETAILS	
D-4M	FLUSHING BASINS, END SECTION, ELBOWS	6/13/97
	TYPICAL WATERFALL FOR CULVERTS UP TO AND	
	INCLUDING 48'' DIA	
	EXTENSION SERVICE BOX AND CURB STOP	
	CORRUGATED PIPE ELBOW	
	GRANULAR BORROW AT CULVERT LOCATIONS	
	UNDERDRAIN FLUSHING BASIN	
	CORRUGATED STEEL PIPE END SECTION	
	CORRUGATED STEEL PIPE ARCH END SECTION	
D-9M	REINFORCED CONCRETE DROP INLET TOPS VERTICAL CURB & THROAT ADAPTER	6/13/97
D-13M	CONCRETE CATCH BASIN WITH CAST IRON GRATE &	1/3/00
	CONCRETE MANHOLE WITH CAST IRON GRATE	
D-15M	PRECAST REINF. CONC. MANHOLE GRATES (BICYCLE SAFE)	6/13/97
	CAST IRON GRATE WITH FRAME, TYPE D	
	CAST IRON GRATE WITH FRAME, TYPE E	

E-100M	CONSTRUCTION APPROACH SIGNS	6/13/97
E-100AM	CONSTRUCTION APPROACH SIGNS	2/2/98
E-101M	CONSTRUCTION SIGN DETAILS	6/13/97
E-102M	CONSTRUCTION SIGN DETAILS	6/13/97
E-102AM	CONSTRUCTION SIGN DETAILS	6/13/97
E-106M	TRAFFIC CONTROL - MISCELLANEOUS DETAILS	6/13/97
E-107M	DELINEATION, BARRICADES AND DETOURS FOR U-TURNS ON DIVIDED HIGHWAY	6/13/97
E-107AM	BREAKAWAY BARRICADE DETAILS	6/13/97
E-108M	CONSTRUCTION ZONE LONGITUDINAL DROP OFFS	6/13/97
E-110M	MAJOR MAINTENANCE OPERATION LANE CLOSURE	6/13/97
E-121M	STANDARD SIGN PLACEMENT - CONVENTIONAL ROAD	6/13/97
E-123M	GUIDE SIGN PLACEMENT - MISCELLANEOUS DETAILS	6/13/97
E-134M	BRIDGE NUMBER PLAQUE	6/13/97
E-138M	MILEMARKER DETAILS - STATE & TOWN HIGHWAYS	6/13/97
E-141M	REGULATORY SIGN DETAILS	6/13/97
E-142M	REGULATORY SIGN DETAILS	6/13/97
E-143M	REGULATORY SIGN DETAILS	6/13/97
E-160M	FLANGED CHANNEL STEEL SIGN POST	6/13/97
E-164M	SQUARE STEEL SIGN POST	6/13/97
E-191M	PAVEMENT MARKING DETAILS	2/1/99
E-193M	PAVEMENT MARKING DETAILS	6/13/97
G-1M	STEEL BEAM GUARDRAIL (50MPH & OVER)	1/3/00
	HEAVY DUTY STEEL BEAM GUARDRAIL	
	TWISTED END TERMINAL	
J-3M	MAILBOX SUPPORT DETAILS	6/13/97
T-1M	TEMPORARY EROSION CONTROL DETAILS	6/13/97
T-2M	TEMPORARY EROSION CONTROL DETAILS	6/13/97

PROJECT NAME:	FRANKLIN
PROJECT NUMBER:	STP 0301(18)
FILE NAME: ...85c060/design/dc060pms.dgn	PLOT DATE: 20-MAR-2003
PROJECT LEADER: DELLASANTA	DRAWN BY: SQUAD B
DESIGNED BY: SQUAD B	CHECKED BY: SQUAD B
IPAM FILE NAME: (2)dc060ind.i	SHEET 2 OF 60

TYPICAL SECTIONS

NOT TO SCALE

150 mm BITUMINOUS CONCRETE PAVEMENT
(PLACED IN TWO LIFTS: 50mm TYPE III, 100mm TYPE I)
450 mm SUBBASE OF DENSE GRADED CRUSHED STONE
650 mm SAND BORROW
(ah 15+000 TO ah 15+464.139)
BITUMINOUS CONCRETE PAVEMENT REQUIRES THE
USE OF PERFORMANCE GRADED ASPHALT, 58-34

VTrans Metric

MATERIALS TOLERANCE TABLE

MATERIAL ITEM	THICKNESS TOLERANCE
PAVEMENT (TOTAL DEPTH)	±5 mm
SUBBASE	±30 mm
SAND BORROW	±30 mm

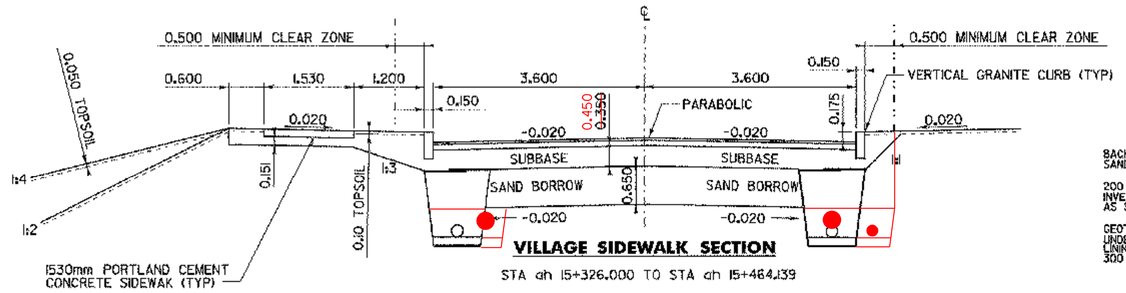

VILLAGE SIDEWALK SECTION

STA ah 15+326.000 TO STA ah 15+464.139

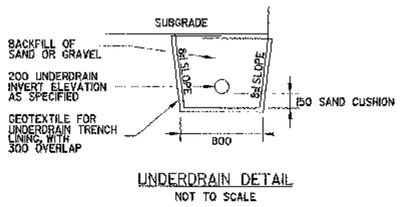

UNDERDRAIN DETAIL
NOT TO SCALE

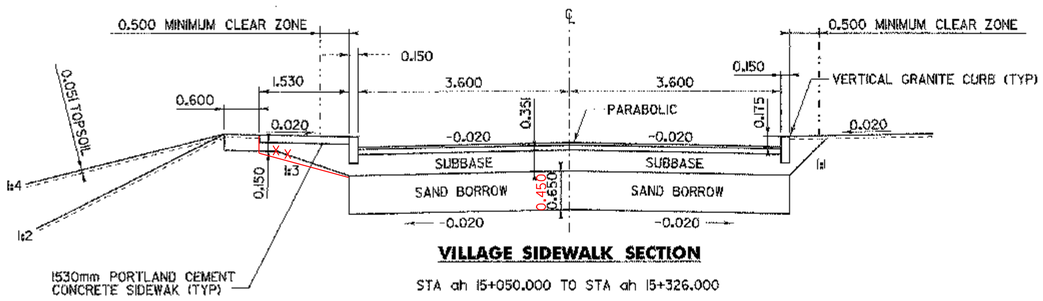

VILLAGE SIDEWALK SECTION

STA ah 15+050.000 TO STA ah 15+326.000

SEEDING FORMULA

RURAL AREAS

% WT.	kg/ha	NAME	PUR.%	GERM.%
5.0	4	RED TOP	95	90
37.5	26	CREEPING RED FESCUE	98	85
15.0	10	BIRDS FOOT TREFOIL (VAR. EMPIRE)	98	85
37.5	26	TALL FESCUE	95	90
5.0	4	ANNUAL RYE GRASS	95	85
100.0	70			

URBAN AREAS

% WT.	kg/ha	NAME	PUR.%	GERM.%
42.5	38	CREEPING RED FESCUE (VAR. PENNLAWN)	98	85
42.5	38	KENTUCKY BLUEGRASS (COMMON)	85	85
10.0	9	PERENNIAL RYE GRASS (VAR. PENNFINE)	95	90
5.0	5	ANNUAL RYE GRASS	95	85
100.0	90			

GENERAL NOTES

THE SEED MIXTURE SHALL NOT HAVE A WEED CONTENT EXCEEDING 0.40% BY WEIGHT AND SHALL BE FREE FROM ALL NOXIOUS WEED SEED.

SEED - TO BE APPLIED PER SEEDING FORMULAS DIRECTED BY THE ENGINEER.

FERTILIZER - FORMULA 10-20-10 TO BE USED WITH SEED, APPLIED AT THE RATE OF 560 kg/ha.

AGRICULTURAL LIMESTONE - TO BE APPLIED AT A RATE OF 4500 kg/ha OR AS DIRECTED BY THE ENGINEER.

HAY MULCH - TO BE PLACED ON EARTH SLOPES AT THE RATE OF 4500 kg/ha OR AS DIRECTED BY THE ENGINEER.

TOPSOIL - TO BE USED WITH SEED, AS INDICATED ON THE PLANS, OR AS DIRECTED BY THE ENGINEER.

MARKER POSTS - TO BE PLACED AS DIRECTED BY ENGINEER.

SLOPE ROUNDING - ALL CUT SLOPES TO BE ROUNDED IN ACCORDANCE WITH STANDARD SHEET B-5M.

TACK COAT: EMULSIFIED ASPHALT IS TO BE APPLIED AT THE RATE OF 0.07 L/m2 BETWEEN SUCCESSIVE COURSES OF PAVEMENT AS DIRECTED BY THE ENGINEER.

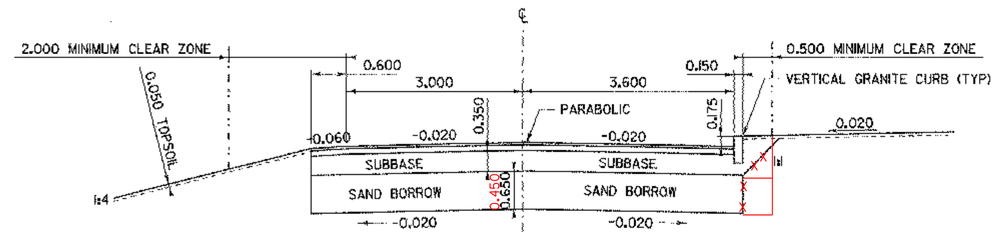

VILLAGE CURBED SECTION

STA ah 15+00.00 TO STA ah 15+050.00

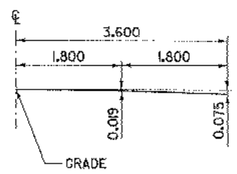

PARABOLIC DETAIL

3.6M LANE

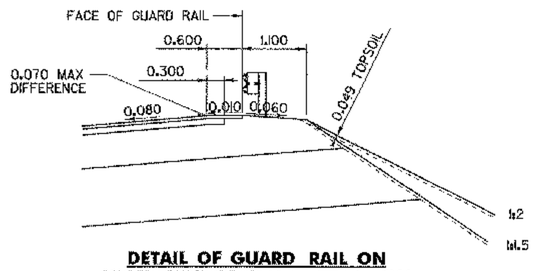

DETAIL OF GUARD RAIL ON HIGH SIDE OF BANKED SECTION

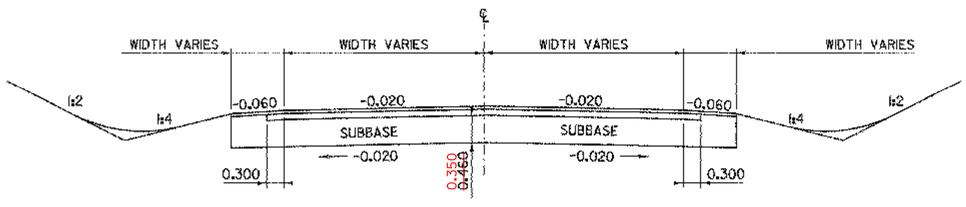

TOWH HIGHWAY TYPICAL SECTION

TH #16

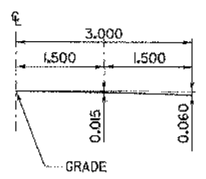

PARABOLIC DETAIL

3.0M LANE

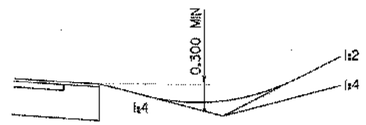

DETAILS OF DITCH & BACKSLOPE FOR LOW SIDE OF BANK < 0.040

NOT TO SCALE

ALL DIMENSIONS IN M UNLESS OTHERWISE NOTED

PROJECT NAME:	HIGHGATE - FRANKLIN
PROJECT NUMBER:	STP RS 030(I) SA
FILE NAME:	85a060/design/(2)dc060typ.dgn
PROJECT LEADER:	DELLASANTA
DESIGNED BY:	SQUAD B
IPARM FILE NAME:	dc060typ.i
PLOT DATE:	28-MAR-2003
DRAWN BY:	SQUAD B
CHECKED BY:	SQUAD B
SHEET	3 OF 60

STATE OF VERMONT
AGENCY OF TRANSPORTATION

QUANTITY SHEET

VAOT Metric

SUMMARY OF ESTIMATED QUANTITIES

		LAND-SCAPING	FULL E&C	EROSION CONTROL	HEADWALL	ROADWAY	QUANTITIES GRAND TOTAL	UNIT	ITEMS	ITEM NUMBER	RND
						1	1	L.S.	CLEARING AND GRUBBING (INCLUDING INDIV. TREES & STUMPS)	201.10	-
						5500	5500	M^3	COMMON EXCAVATION	203.15	-
						20	20	M^3	SOLID ROCK EXCAVATION	203.16	2.1
					10		10	M^3	UNCLASSIFIED CHANNEL EXCAVATION	203.27	EST
						50	50	M^3	EARTH BORROW	203.30	EST
						2500	2500	M^3	SAND BORROW	203.31	285
						4850	4850	M^2	FINE GRADING - SUBGRADE	203.40	22
						25	25	M^3	TRENCH EXCAVATION OF EARTH (MOD)	204.20	EST
				20		1700	1720	M^3	TRENCH EXCAVATION OF EARTH	204.20	19
						10	10	M^3	TRENCH EXCAVATION OF ROCK	204.21	8
					55		55	M^3	GRANULAR BACKFILL FOR STRUCTURES	204.30	EST
					70		70	M^3	COFFERDAM EXCAVATION EARTH	208.30	EST
					5		5	M^3	COFFERDAM EXCAVATION ROCK	208.35	EST
					1		1	L	COFFERDAM	208.40	EST
						100	100	M^2	COLD PLANING - BIT. PAVEMENT	210.10	15
				100		1800	1900	M^3	SUBBASE OF DENSE GRADED CRUSHED STONE	301.35	75
						75	75	M^3	AGGREGATE SURFACE COARSE	401.10	24
						275	275	KG	EMULSIFIED ASPHALT	404.65	11
						1550	1550	T	BITUMINOUS CONCRETE PAVEMENT (PG 58-34)	406.25	21
					18	11	29	M 3	CONCRETE HIGH PERFORMANCE CLASS B	501.34	2.13
					1300	300	1600	KG	REINFORCING STEEL	507.15	2.4
					6		6	L	WATER REPELLENT	514.10	EST
						25.5	25.5	M	450 MM PCCSP 1.63 MM (68 MM X 12 MM)	601.0415	-
						6.0	6.0	M	750 MM PCCSP 2.01 MM (68 MM X 12 MM)	601.0436	-
									•••BEGIN OPTION PIPES•••		
						444.5	444.5	M	450 MM CAAP 1.52 MM (68 MM X 12 MM)	601.0215	-
						444.5	444.5	M	450 MM PCCSP 1.63 MM (68 MM X 12 MM)	601.0415	-
						444.5	444.5	M	450 MM RCP CLASS III	601.0815	-
						444.5	444.5	M	450 MM CPEP (SL)	601.2615	-
						83.5	83.5	M	750 MM CAAP 1.91 MM (68 MM X 12 MM)	601.0306	-
						83.5	83.5	M	750 MM PCCSP 2.01 MM (68 MM X 12 MM)	601.0436	-
						83.5	83.5	M	750 MM RCP CLASS III	601.0835	-
						83.5	83.5	M	750 MM CPEP(SL)	601.2625	-
									•••END OPTION PIPES•••		
						30	30	M	RELAYING PIPE CULVERT	601.99	EST

DETAILED SUMMARY OF QUANTITIES

QUANTITIES	UNIT	ITEMS
		COMMON EXCAVATION
4398	M^3	MAINLINE (INCL. DESIGNED SAND BORROW)
331	M^3	TOWN HIGHWAY * 16
548	M^3	DRIVES
223	M^3	ROUNDING
5500	M^3	TOTAL
		SOLID ROCK EXCAVATION
18	M^3	MAINLINE (REMOVAL OF EXISTING SIDEWALK)
2	M^3	ROUNDING
20	M^3	TOTAL
		SUBBASE DENSE GRADED CRUSHED STONE
1556	M^3	MAINLINE
169	M^3	TOWN HIGHWAY * 16
100	M^3	TEMPORARY EROSION CONTROL
75	M^3	ROUNDING
1900	M^3	TOTAL
		BITUMINOUS CONCRETE PAVEMENT
1363	T	MAINLINE
125	T	TOWN HIGHWAY * 16
41	T	DRIVES
21	T	ROUNDING
1550	T	TOTAL
		FINE GRADING - SUBGRADE
3464	M^2	MAINLINE
389	M^2	TOWN HIGHWAY * 16
975	M^2	DRIVES
22	M^2	ROUNDING
4850	M^2	TOTAL
		TRENCH EXCAVATION OF EARTH
615	M^3	DESIGNED DRAINAGE
1066	M^3	UNDERDRAIN (INS ESTIMATED)
19	M^3	ROUNDING
1700	M^3	TOTAL

DETAILED SUMMARY OF QUANTITIES

QUANTITIES	UNIT	ITEMS
		TEMPORARY EROSION CONTROL (INC IN EROSION CONTROL)
20	M^3	TRENCH EXCAVATION OF EARTH
100	M^3	SUBBASE DENSE GRADED CRUSHED STONE
10	M^3	STONE FILL TYPE I
100	M^2	GEOTEXTILE FOR SILT FENCE
7	KG	SEED-WINTER RYE
1.0	T	HAY MULCH
50	M^2	EROSION MATTING

PROJECT NAME: FRANKLIN
PROJECT NUMBER: STP 0301(18)

FILE NAME: ...85c060/design/dc060pms.dgn PLOT DATE: 16-MAY-2003
PROJECT LEADER: DELLASANTA DRAWN BY: SQUAD B
DESIGNED BY: SQUAD B CHECKED BY: SQUAD B
IPAM FILE NAME: (2)dc060q01.i SHEET 4 OF 60

STATE OF VERMONT
AGENCY OF TRANSPORTATION

QUANTITY SHEET

VAOT Metric

SUMMARY OF ESTIMATED QUANTITIES

		LAND-SCAPING	FULL E&C	EROSION CONTROL	HEADWALL	ROADWAY	QUANTITIES GRAND TOTAL	UNIT	ITEMS	ITEM NUMBER	RND
						20	20	EA	CONCRETE CATCH BASIN W/ CAST IRON GRATE	604.10	-
						4	4	EA	CAST IRON GRATE WITH FRAME, TYPE D	604.47	-
						750	750	M	150 MM UNDERDRAIN	605.10	30
						30	30	M	150 MM UNDERDRAIN CARRIER PIPE	605.20	15
						25	25	EA	UNDERDRAIN FLUSHING BASINS	605.95	-
						50	50	HR	ROADWAY PATROL MAINTENANCE	607.10	18
						10	10	HR	BULLDOZER RENTAL, TYPE I	608.10	EST
						10	10	HR	POWER GRADER RENTAL	608.15	EST
						10	10	HR	ALL PURPOSE EXCAVATOR RENTAL, TYPE I	608.25	EST
						10	10	HR	POWER BROOM RENTAL	608.30	EST
						10	10	HR	TRUCK RENTAL	608.37	EST
						10	10	HR	LOADER RENTAL, TYPE I	608.40	EST
						930	930	M^3	DUST CONTROL WITH WATER	609.10	EST
						1.6	1.6	T	DUST AND ICE CONTROL WITH CALCIUM CHLORIDE	609.15	EST
				10			10	M^3	STONE FILL TYPE I	613.10	EST
					21	3.0	24	M^3	STONE FILL TYPE II	613.11	7.0
						815	815	M	VERTICAL GRANITE CURB	616.21	4.2
						8	8	EA	RELOCATE MAILBOX, SINGLE SUPPORT	617.10	-
						630	630	M^2	PORTLAND CEMENT CONCRETE SIDEWALK, 125 MM	618.10	4
						2	2	EA	REMOVING AND RESETTING PROPERTY MARKERS	619.20	EST
						25	25	M	REMOVING AND RESETTING FENCE	620.50	1
						38	38	M	STEEL BEAM GUARD RAIL	621.20	6.1
						4	4	EA	ANCHOR FOR STEEL BEAM RAIL	621.60	-
						25	25	M	REMOVAL AND DISPOSAL OF GUARD RAIL	621.80	6.0
						25	25	M	SEAMLESS COPPER WATER TUBE(3/4")	629.23	EST
						5	5	EA	EXTENSION SERVICE BOX AND CURB STOP	629.25	EST
						25	25	M	PLASTIC WATER PIPE, RIGID(8" CL150 PVC WATERLINE)	629.33	EST
						25	25	M	PIPE INSULATION	629.44	EST
						130	130	HR	UNIFORMED TRAFFIC OFFICERS	630.10	EST

DETAILED SUMMARY OF QUANTITIES

QUANTITIES	UNIT	ITEMS

DETAILED SUMMARY OF QUANTITIES

QUANTITIES	UNIT	ITEMS

PROJECT NAME: FRANKLIN
PROJECT NUMBER: STP 0301(18)

FILE NAME: ...85c060/design/dc060pms.dgn PLOT DATE: 24-APR-2003
PROJECT LEADER: DELLASANTA DRAWN BY: SQUAD B
DESIGNED BY: SQUAD B CHECKED BY: SQUAD B
IPAM FILE NAME: (2)dc060q02.I SHEET 5 OF 60

STATE OF VERMONT
AGENCY OF TRANSPORTATION

QUANTITY SHEET

VAOT Metric

SUMMARY OF ESTIMATED QUANTITIES

		LAND-SCAPING	FULL E&C	EROSION CONTROL	HEADWALL	ROADWAY	QUANTITIES GRAND TOTAL	UNIT	ITEMS	ITEM NUMBER	RND
						400	400	HR	FLAGGERS	630.15	EST
			1				1	L.S.	FIELD OFFICE - ENGINEERS	631.10	-
			1				1	L.S.	TESTING EQUIPMENT - CONCRETE	631.16	-
			1				1	L.S.	TESTING EQUIPMENT - BITUMINOUS	631.17	-
			1				1	L.U.	FIELD OFFICE TELEPHONE (NOT A BID ITEM)	631.25	-
						1	1	L.S.	MOBILIZATION	635.10	-
						1	1	L.S.	TRAFFIC CONTROL	641.10	-
						1050	1050	M	DURABLE 100 MM WHITE LINE	646.40	20
						950	950	M	DURABLE 100 MM YELLOW LINE	646.41	40
						14.5	14.5	M	DURABLE 600 MM STOP BARS	646.46	-
						8	8	EA	DURABLE LETTER OR SYMBOL	646.50	-
						1050	1050	M	TEMPORARY 100 MM WHITE LINE	646.60	20
						950	950	M	TEMPORARY 100 MM YELLOW LINE	646.61	40
						14.5	14.5	M	TEMPORARY 600 MM STOP BARS	646.66	-
						8	8	EA	TEMPORARY LETTER OR SYMBOL	646.70	-
						44	44	EA	LINE STRIPING TARGETS	646.76	EST
				20	40		60	M^2	GEOTEXTILE UNDER STONE FILL	649.31	EST
				2500			2500	M^2	GEOTEXTILE FOR UNDERDRAIN TRENCH LINING	649.41	59
				300			300	M^2	GEOTEXTILE FOR SILT FENCE	649.51	5
				50			50	KG	SEED	651.15	0.1
				7			7	KG	SEED-WINTER RYE	651.17	0.1
				415			415	KG	FERTILIZER	651.18	2.2
				4			4	T	AGRICULTURAL LIMESTONE	651.20	0.7
				4			4	T	HAY MULCH	651.25	-
				50			50	M^2	SODDING	651.30	EST
						100	100	M^3	TOPSOIL	651.35	8
					25		25	M^2	GRUBBING MATERIAL	651.40	EST
				1			1	LS	EROSION & SEDIMENT CONTROL AND STORMWATER MANAGEMENT PLAN	652.10	-
				1			50	HR	MONITORING EROSION & SEDIMENT AND STORMWATER MANAGEMENT PLAN	652.20	EST

DETAILED SUMMARY OF QUANTITIES

QUANTITIES	UNIT	ITEMS

DETAILED SUMMARY OF QUANTITIES

QUANTITIES	UNIT	ITEMS

PROJECT NAME: FRANKLIN
PROJECT NUMBER: STP 0301(18)

FILE NAME: ...85c060/design/dc060pms.dgn PLOT DATE: 07-MAY-2003
PROJECT LEADER: DELLASANTA DRAWN BY: SQUAD B
DESIGNED BY: SQUAD B CHECKED BY: SQUAD B
IPAM FILE NAME: (2)dc060q03.i SHEET 6 OF 60

STATE OF VERMONT
AGENCY OF TRANSPORTATION

QUANTITY SHEET

VAOT Metric

SUMMARY OF ESTIMATED QUANTITIES

		LAND-SCAPING	FULL E&C	EROSION CONTROL	HEADWALL	ROADWAY	QUANTITIES GRAND TOTAL	UNIT	ITEMS	ITEM NUMBER	RND
				1			1	LU	FEILD MAINTENANCE OF EROSION & SEDIMENT CONTROL & STORMWATER MANAGEMENT PLAN	652.30	-
				50			50	M^2	EROSION MATTING	654.10	8.2
		10					10	EA	DECIDOUS SHRUBS(EVERGREEN)	656.25	-
		14					14	EA	DECIDUOUS TREES	656.30	-
		2					2	EA	TRANSPLANTING TREES	656.45	-
		3					3	EA	TRANSPLANTING SHRUBS	656.50	-
						3.1	3.1	M^2	TRAFFIC SIGNS TYPE A	675.20	-
									*** BEGIN SIGN POSTS OPTIONS ***		
						27.0	27.0	M	FLANGED CHANNEL SIGN POSTS	675.301	0.65
						27.0	27.0	M	SQUARE TUBE STEEL SIGN POSTS	675.341	0.65
									*** END SIGN POSTS OPTIONS ***		
						10	10	EA	REMOVING SIGNS	675.50	-
						4	4	EA	ERECTING SALVAGED SIGNS	675.60	-

DETAILED SUMMARY OF QUANTITIES

QUANTITIES	UNIT	ITEMS

DETAILED SUMMARY OF QUANTITIES

QUANTITIES	UNIT	ITEMS

PROJECT NAME: FRANKLIN
PROJECT NUMBER: STP 0301(18)

FILE NAME: ...85c060/design/dc060pms.dgn
PROJECT LEADER: DELLASANTA
DESIGNED BY: SQUAD B
IPAM FILE NAME: (2)dc060q04.1

PLOT DATE: 24-APR-2003
DRAWN BY: SQUAD B
CHECKED BY: SQUAD B
SHEET 7 OF 60

ITEM DETAIL AND DRAINAGE SHEET

STATE OF VERMONT
AGENCY OF TRANSPORTATION

DRAINAGE STRUCTURES

From Bk-3

Part 1 of 2: Station, pipe and option columns

Pg	STA.	STA.	POSITION	ASKEW	TYPE IN	DITCH IN	DITCH OUT	PIPE ARCH S (IN)	PIPE ARCH R (IN)	PIPE ARCH L (FT)	PIPE D (MM)	PIPE L (M)	PCCSP	CAAP	RCP (CL)	CSP (TH)	CPEP	PCCSP PI (TH)	PIPE ELBOW (NO-DEG)	ES (EA)	CB	PRCCP	DEPTH DI
60	15+032	15+045.9	RT.							✓	450	13.2	X										
64	15+047.1	15+101.9	RT.		PRCCB	1					450	54.9					X						
66	15+103.1	15+155.9	RT.		PRCCB	1					450	52.8					X						
74	15+157.1	15+188.7	RT.		PRCCB	1					450	31.5					X						
76	15+124.6	15+173.4	LT.		PRCCB	1					450	49.6					X						
78	15+174.6	15+190.4	LT.		PRCCB	1					450	15.6					X						
80	15+191	15+189.5	L/R		PRCCB	1					450	5.8					X						
82	15+190.3	15+213.2	RT.		PRCCB	1				✓	750	24.3					X						
86	15+214.8	15+257.8	RT.		PRCCB	1				·	750	43.9					X						
88	15+259.3	15+275.2	RT.		PRCCB	1				✓	750	16.4					X						
90	15+276.8	15+280	RT		PRCCB	1				✓	250	6.1	X										
	TH # 16																						
94	26+039RT	26+036.5LT	C/L		PRCDI	1					450	5.4					X						
96	26+036.5	26+013.5	LT		PRCDI	1					450	21.4					X						
98	TH 26+013.5	M/L 15+214RT	C/L		PRCDI	1					450	18.6					X						
	MAIN LINE	EAST OF BROOK																					
100	15+283.5	15+293	RT		PRCCB	1					450	12.3	X										
102	15+293.6	15+310.6	RT		PRCDI	1					450	17.2					X						
104	15+311.5	15+318.4	RT		PRCCB	1					450	7.1					X						
106	15+319.6	15+344.4	RT		PRCCB	1					450	25.0					X						
108	15+345.6	15+362.4	RT		PRCCB	1					450	17.0					X						
110	15+363		C/L		PRCCB	1					450	5.0					X						
112	15+363.6	15+382.4	RT		PRCCB	1					450	19.0					X						
114	15+363.6	15+414.2	LT		PRCCB	1					450	51.6					X						
116	15+415LT	15+425.6RT	C/L		PRCCB	1					450	10.5					X						
118	15+415.8	15+439.4	LT		PRCCB	1					450	23.6					X						
120	15+440		C/L		PRCCB	1					450	5.5					X						
								450 PCCSP				25.5											
								450 CPEP				437.1											
					PRCCB	20		750 PCCSP				6.1											
	TOTALS				PRCDI	4		750 CPEP				84.6											

Part 2 of 2: Flushing basins, excavation, fill and underdrain columns

Pg	Flushing Basins		DI GRATE (TYPE)	CHAN ELEV	CRM (CY)	TR EXCAV EARTH (M³)	TR EXCAV ROCK (M³)	COMM EXC (CY)	UNC CHAN EXC (CY)	STRUC EXCAV (CY)	GRAN BKF STRUC (M³)	GRAN BORR (CY)	Fabric (M²) (comp. found)	STONE FILL (CY)	STONE FILL (TYPE)	MRKR POSTS LT	MRKR POSTS RT	UNDER-DRAIN (M) (Field Meas)	Carrier Pipe (M) (Field Meas)	REMARKS
60						14.1					10.46		62.30					12.8		
64	15+046.7	1				86.19	1.7				74.88		276.89					56.8	1.52	
66	15+098.1	1				70.76					60.43		249.92					54.1	1.52	
74	15+157	1				62.44					57.69		171.36					32.6	1.52	
76	15+123.9	1				35.63					33.0		197.18					50.2	1.52	
78	15+174.2	1				26.75					22.58		71.8					15.7	1.52	
80						35.0					25.7									
82	15+189.26	1				97.25	1.9				74.84		156.68					24.2	1.52	
86	15+213.42	1				114.0					85.49		260.62					43.5	1.52	
88	15+258.8	1				31.11					21.25		75.29					17.0	1.52	
90					/	28.0					18.8									
94						19.11					15.07									
96	26+035	1				62.36					54.27		94.55					21.8	1.52	
98						65.41					52.04									
100						35.6					20.0									
102	15+311.3	1				23.44					19.76		74.25					18.0	1.52	
104	15+319.2	1				12.69					10.07		24.64					8.0	1.52	
106	15+345.2	1				28.53					24.19		103.81					26.0	1.52	
108	15+362.3	1				26.68					21.87		73.11					17.0	1.52	
110						11.62					9.14									
112	15+383.2	1				33.5					27.19		106.07					20.5	1.52	
114	15+416.2	1				59.77					52.02		230.67					53.0	1.52	
116						15.93					12.8									
118	15+440.46	1				38.63					32.62		112.0					25.0	1.52	
120						10.77					8.57									
TOTALS						1045.27 118.20 1163.47		3.6			844.73		2341.14 511.42 2852.56					496.2 159.2 655.4	24.32	

VWRF 01-07-05

GUARD RAIL

STA.	STA.	LT.	RT.	END TREATMENT	
TOTALS					

UNDERDRAIN (See Bk 3 Pg 129)

STA.	STA.	TYPE	POS.	D	L	TRENCH E	TRENCH R	Fabric	FB	Carr. Pipe	MKR PST
15+098.1	15+124.3		LT	150	26.2	13.1		72.83	1	1.52	
15+383.2	15+424.4		RT	150	41.2	7.8 11.5		85.22	1	1.52	
15+425.6	15+440.5		RT	150	14.9	4.9		34.47	1	1.52	
TH 16											
26+014.0			C/L	150	7.3	13.9		35.09	1	1.52	
26+014.0	26+039.5		RT	150	25.6	36.4		119.56	1	1.52	
26+039.5	26+059.7		RT	150	20.5	19.5		76.05	1	1.52	
26+036.5	26+059.7		LT	150	23.5	22.6		88.20	1	1.52	
TOTALS					159.2	118.2		511.42	7	10.64	

PROJECT NAME: FRANKLIN VWRF 01-07-05
PROJECT NUMBER: STP 0301(18)

FILE NAME: ______ PLOT DATE: 24-SEP-2001
PROJECT LEADER: ______ DRAWN BY: ______
DESIGNED BY: ______ CHECKED BY: ______
SHEET 007A OF ______

VWRF 01-07-05

STATE OF VERMONT
AGENCY OF TRANSPORTATION

DRAINAGE DETAIL SHEET

VAOT Metric

DRAINAGE STRUCTURES

STATION km + m	STATION km + m	POS.	ASKEW	INLET/OUTLET TYPE		DITCH		PIPE ARCH			PIPE		ALLOWABLE OPTIONS						PIPE ELBOW	ES	CB	RCCD I	DEPTH DI /CB mm	CONC CL B	REINF STEEL	DI GRATE	CHAN ELEV	CRM	TRENCH EXCAVATION		COMM EXC	UNC CHAN EXC	STRUCT EXCAV	GRAN BKFILL STRUCT	GRAN BORR	EROS MATT	STONE FILL		MARKER POSTS		REMARKS
				INLET	OUTLET	IN	OUT	SPAN mm	RISE mm	L m	D mm	L m	PCCSP mm	CAAP mm	RCP CL	CSP mm	CPEP SL mm	PCCSP PI mm	NO. DEG	EA	EA		mm	m^3	kg	TYPE	EA	m^3	EARTH m^3	ROCK m^3	m^3	m^3	m^3	m^3	m^3	m^2	m^3	TYPE	LT ea	RT ea	
MAIN LINE WEST OF BROOK																																							
15+032	15+046.5	RT.			C/B	X					450	13	1.63															5.9												PLUG PIPE @ STA. 15+032 FOR FUTURE USE.
15+048	15+061	RT.																																						REMOVE EXISTING DR. CULVERT(REMOVE WITH COMMON)
15+046.5	15+098	RT.		C/B	C/B						450	51	1.63	1.52	III		X				I		1840					30.2												CONCRETE CB @ INLET & OUTLET W/ CI GRATE. TYPE D.
15+098	15+156.5	RT.		C/B	C/B						450	57	1.63	1.52	III		X				I		2070					26.8												CONCRETE CB @ INLET & OUTLET W/ CI GRATE. TYPE D.
15+100	15+106	RT.																																						REMOVE EXISTING 380mm ACCGMP(REMOVE WITH COMMMON)
15+121	15+153	RT.																																						REMOVE EXISTING 450mm X 33M PIPE(REMOVE WITH COMMON)
15+153	15+156	RT.																																						REMOVE EXISTING 300mm X 3M PIPE(REMOVE WITH COMMON)
15+156.5	15+189.5	RT.		C/B	C/B						450	32	1.63	1.52	III		X				I		2060					31.7												CONCRETE CB @ INLET & OUTLET W/ CI GRATE. TYPE D.
15+124	15+173.5	LT.		C/B	C/B						450	49	1.63	1.52	III		X				I		1900					20.2												CONCRETE CB @ INLET & OUTLET W/ CI GRATE. TYPE D.
15+173.5	15+191	LT.		C/B	C/B						450	17	1.63	1.52	III		X				I		2070					17.8												CONCRETE CB @ INLET & OUTLET W/ CI GRATE. TYPE D.
15+191 LT.	15+189.5 RT.	C/L	35°-23'-43" RT.	C/B	C/B						450	5	1.63	1.52	III		X				I		3020					23.0												CONCRETE CB @ INLET & OUTLET W/ CI GRATE. TYPE D.
15+189.5	15+214	RT.		C/B	C/B						750	23	2.01	1.91	III		X				I		3100					58.1												CONCRETE CB @ INLET & OUTLET W/ CI GRATE. TYPE D.
15+191		RT.																										50.0	2											REMOVE EXIST. DI &PIPE. PIPE TYPE AND LOCATION UNKNOWN.
15+214	15+258.5	RT.		C/B	C/B						750	44	2.01	1.91	III		X				I		2800					60.4												CONCRETE CB @ INLET & OUTLET W/ CI GRATE. TYPE D.
15+258.5	15+276	RT.		C/B	C/B						750	16.5	2.01	1.91	III		X				I		1920					14.8												CONCRETE CB @ INLET & OUTLET W/ CI GRATE. TYPE D.
15+276	15+280	RT.		C/B	DITCH						750	6	2.01								I		1250					17.4								2.1	II			CONCRETE CB @ INLET. W/CI GRATE- (WITH STONE FILL TYPE II @OUTLET)
15+281		C/L																																						RETAIN EXISTING 7'-8" X 5'-5" CGMP
TH * 16	
26+039 RT	26+036.5 LT	C/L	14°-59'-50" LT.	DI	DI						450	5	1.63	1.52	III		X						1140	1.61	79.7	D		3.6												CONCRETE DI @ INLET & OUTLET W/ CI GRATE. TYPE D.
26+036.5	26+013.5	LT.		DI	DI						450	23	1.63	1.52	III		X						1310	1.91	92.9	D		11.9												CONCRETE DI @ INLET & OUTLET W/ CI GRATE. TYPE D.
TH 26+013.5	M/L 15+191	LT.		DI	C/B						450	16	1.63	1.52	III		X						1550	2.16	105	D		41.3												CONCRETE DI @ INLET & CB @ OUTLET W/ CI GRATE. TYPE D.
TOTALS FOR SHEET											450	255.0	1.63	1.52	III		X				10			5.68	277.6	3-D		413.1	2							2.1	II			
											450	13.0	1.63																											
											750	83.5	2.01	1.91	III		X																							
											750	6.0	2.01																											

PROJECT NAME: FRANKLIN
PROJECT NUMBER: STP 0301(18)

FILE NAME: ...85c060/design/dc060pms.dgn
PROJECT LEADER: DELLASANTA
DESIGNED BY: SQUAD B
IPAM FILE NAME: (2)dc060dr1.i

PLOT DATE: 31-MAR-2003
DRAWN BY: SQUAD B
CHECKED BY: SQUAD B

STATE OF VERMONT
AGENCY OF TRANSPORTATION

DRAINAGE DETAIL SHEET

VAOT Metric

DRAINAGE STRUCTURES

STATION km + m	STATION km + m	POS.	ASKEW	INLET/OUTLET TYPE		DITCH		PIPE ARCH			PIPE		ALLOWABLE OPTIONS						PIPE ELBOW	ES	CB	PROCD'T	DEPTH DI /CB	CONC CL B	REINF STEEL	DI GRATE	CHAN ELEV	CRM	TRENCH EXCAVATION		COMM EXC	UNC CHAN EXC	STRUCT EXCAV	GRAN BKFILL STRUCT	GRAN BORR	EROS MATT	STONE FILL		MARKER POSTS				REMARKS
				INLET	OUTLET	IN	OUT	SPAN mm	RISE mm	L m	D mm	L m	PCCSP mm	CAAP mm	RCP CL	CSP mm	CPEP SL mm	PCCSP PI mm	NO. DEG	EA	EA		mm	m^3	kg	TYPE	EA	m^3	EARTH m^3	ROCK m^3	m^3	m^3	m^3	m^3	m^3	m^2	m^3	TYPE	LT ea	RT ea			
MAIN LINE EAST OF BROOK	
15+283.5	15+293	RT.		C/B	DITCH						450	12.5	1.63								1		2290					31.9								1.0	II				CONCRETE CB @ INLET/ DITCH @ OUTLET. W/CI GRATE. TYPE D(STONE FILL TYPE II @ OUTLET)
15+293	15+311	RT.		D/I	C/B						450	18	1.63	1.52	III		X						1580	2.19	121	D		37.1													CONCRETE DI @ INLET & CB @ OUTLET W/ CI GRATE. TYPE D.
15+311	15+319	RT.		C/B	D/I						450	8.0	1.63	1.52	III		X				1		2070					23.1													CONCRETE CB @ INLET W/CI GRATE. TYPE D & DI @ OUTLET
15+319	15+345	RT.		C/B	C/B						450	25	1.63	1.52	III		X				1		2070					14.5													CONCRETE CB @ INLET & OUTLET W/ CI GRATE. TYPE D.
15+345	15+363	RT.		C/B	C/B						450	17	1.63	1.52	III		X				1		2220					15.1													CONCRETE CB @ INLET & OUTLET W/ CI GRATE. TYPE D.
15+363		C/L	90°-00'-00"	C/B	C/B						450	4.5	1.63	1.52	III		X				1		2020					8.7													CONCRETE CB @ INLET & OUTLET W/ CI GRATE. TYPE D.
15+363	15+383	RT.		C/B	C/B						450	19	1.63	1.52	III		X				1		2210					18.0													CONCRETE CB @ INLET & OUTLET W/ CI GRATE. TYPE D.
15+363	15+415	LT.		C/B	C/B						450	51	1.63	1.52	III		X				1		2130					26.0													CONCRETE CB @ INLET & OUTLET W/ CI GRATE. TYPE D.
15+415 LT	15+425.6 RT	C/L	27°-12'-46"RT	C/B	C/B						450	18	1.63	1.52	III		X				1		2150					15.4													CONCRETE CB @ INLET & OUTLET W/ CI GRATE. TYPE D.
15+415	15+440	LT.		C/B	C/B						450	24	1.63	1.52	III		X				1		2220					20.0													CONCRETE CB @ INLET & OUTLET W/ CI GRATE. TYPE D.
15+440		C/L	90°-00'-00"	C/B	C/B						450	5	1.63	1.52	III		X				1		2120					9.3													CONCRETE CB @ INLET & OUTLET W/ CI GRATE. TYPE D.
TOTALS FOR SHEET											450	189.5	1.63	1.52	III		X				10		2.19	121	1-D			201.1								1.0	II				
											450	11.5	1.63																											
PROJECT GRAND TOTAL											450	444.5	1.63	1.52	III		X				20		7.87	398.6	4-D			614.2	2							3.1	II				
											450	25.5	1.63																											
											750	83.5	2.01	1.91	III		X																							
											750	6.0	2.01																											

PROJECT NAME:	FRANKLIN
PROJECT NUMBER:	STP 0301(18)

FILE NAME: ...85c060/design/dc060pms.dgn		PLOT DATE:	31-MAR-2003
PROJECT LEADER:	DELLASANTA	DRAWN BY:	SQUAD B
DESIGNED BY:	SQUAD B	CHECKED BY:	SQUAD B
IPAM FILE NAME:	dc060dr2.1	SHEET	9 OF 60

STATE OF VERMONT
AGENCY OF TRANSPORTATION

ITEM DETAIL SHEET

VAST Metric

GUARD RAIL

BEGIN STATION km + m	END STATION km + m	POSITION LEFT m	POSITION RIGHT m	END TREATMENT BEGIN EA	END TREATMENT END EA
15+279	15+294		20.27		
~~15+277~~ LT	~~15+295~~ LT		~~19~~	STA. G-Idm	
15+272	15+291		16.46		
~~15+275~~ RT	~~15+290~~ RT		~~19~~	STA. G-Idm	
			36.73		
	TOTALS		~~38~~		
ANCHORS FOR STEEL BEAM RAIL			621.60	4 EA.	

UNDERDRAIN

BEGIN STATION km + m	END STATION km + m	TYPE	POSITION	DIA. mm	LENGTH m	TRENCH EARTH m^3	TRENCH ROCK m^3	GRAN BKFILL m^3	FB EA	MKR PST EA
FRANKLIN										
15+032	15+046.5	U	RT	150	16	5.2				
15+048	15+098	U	RT	150	51	23.6			1	
15+098	15+124	U	LT	150	24	9.6			1	
15+099.5	15+156.5	U	RT	150	57	38.6			1	
15+125.5	15+173.5	U	LT	150	49	33.7			1	
15+158	15+189.5	U	RT	150	15	11.1			1	
15+175	15+191	U	LT	150	17	8.7			1	
15+190	15+214	U	RT	150	23	0.0			1	
15+215	15+258.5	U	RT	150	44	0.0			1	
15+259.5	15+276	U	RT	150	16.5	8.3			1	
15+293	15+310	U	RT	150	16	10.0			1	
15+311	15+317.5	U	RT	150	8	5.0			1	
15+319	15+343.5	U	RT	150	24	9.4			1	
15+345	15+361.5	U	RT	150	17	7.9			1	
15+363	15+381.5	U	RT	150	19	7.9			1	
15+363	15+413.5	U	LT	150	51.0	14.0			1	
15+383	15+424	U	RT	150	41.5	21.8			1	
15+415	15+438.5	U	LT	150	24.0	8.3			1	
15+425	15+438.5	U	RT	150	13.5	3.3			1	
TH # 16										
26+060	26+039	U	RT	150	22.0	10.5			1	1
26+037.5	26+013	U	RT	150	23.0	12.7			1	
26+013	26+013	U	RT/LT	150	5.0	4.0			1	
26+060	26+036.5	U	LT	150	23.0	11.9			1	1
26+035	26+013	U	LT	150	23.0	11.1			1	
M/L 15+192.5	TH 26+013	U	LT	150	17.0	9.0			1	
EST. UNDERDRAIN		U		150	80	751			1	1
EST. CARRIER		C		150	15.0	29.0				
TOTAL		U		150	720	1036			25	3
TOTAL		C		150	15.0	29.0				
TOTAL TRENCH EARTH						1066				
TOTAL F/B AND MP									25	3

BEGIN STATION km + m	END STATION km + m	POSITION LEFT m	POSITION RIGHT m	REMARKS

BEGIN STATION km + m	END STATION km + m	POSITION LEFT m	POSITION RIGHT m	REMARKS

BEGIN STATION km + m	END STATION km + m	POSITION LEFT m	POSITION RIGHT m	REMARKS

PROJECT NAME: FRANKLIN
PROJECT NUMBER: STP 030I(18)

FILE NAME: ...85c060/design/dc060pms.dgn PLOT DATE: 27-MAR-2003
PROJECT LEADER: DELLASANTA DRAWN BY: SQUAD B
DESIGNED BY: SQUAD B CHECKED BY: SQUAD B
IPAM FILE NAME: (2)dc0601dl.i SHEET 10 OF 60

STATE OF VERMONT
AGENCY OF TRANSPORTATION

EARTHWORKS

VAOT Metric

STATION km + m	DIST m	TOTAL EXCAVATION EARTH AND ROCK AREA m²	TOTAL EXCAVATION EARTH AND ROCK VOLUME m³	ROCK EXCAVATION AREA m²	ROCK EXCAVATION VOLUME m³	EMBANKMENT AREA m²	EMBANKMENT VOLUME m³		
MAINLINE									
AH 15+000		1.637				2.332			
	20		58.640				29.630		
+020		4.227				.631			
	20		131.680				6.310		
+040		8.941				0		C=	776
	20		201.910				.180	F=	46
+060		11.250				.018		F FAC=	1.15
	20		198.210				3.360	EX C=	723
+080		8.571				.318			
	20		185.790				6.210		
+100		10.008				.303			
	20		194.550				5.760		
+120		9.447				.273			
	20		198.450				3.590		
+140		10.398				.086		C=	999
	20		204.110				1.060	F=	16
+160		10.013				.020		F FAC=	1.15
	20		196.450				1.040	EX C=	981
+180		9.632				.084			
	20		205.750				4.820		
+200		10.943				.398			
	20		206.120				5.620		
+220		9.669				.164			
	20		187.550				1.720		
+240		9.086				.008		C=	902
	20		169.570				3.560	F=	114
+260		7.871				.348		F FAC=	1.15
	20		170.190				45.640	EX C=	771
+280		9.148				4.216			
	20		168.900				57.420		
+300		7.742				1.526			
	20		134.320				32.820		
+320		5.690				1.756			
	20		131.970				28.900		
+340		7.507				1.134		C=	825
	20		157.130				18.180	F=	87
+360		8.206				.684		F FAC=	1.15
	20		187.620				6.840	EX C=	725
+380		10.556				0			
	20		214.220				0		
+400		10.866				0			
	20		213.720				0		
+420		10.506				0		C=	894
	20		179.750				.040	F=	0
+440		7.469				.004		F FAC=	1.15
	20		500.920				.040	EX C=	894
+460		42.623	BUTT			0			
SIDELINE (TH 16)									
26+010		14.085							
	10		112.040						
+020		8.323						C=	331
	20		132.220					F=	0
+040		4.899						F FAC=	1.15
	20		86.380					EX C=	331
+060		3.739	BUTT						

STATION km + m	DIST m	TOTAL EXCAVATION EARTH AND ROCK AREA m²	TOTAL EXCAVATION EARTH AND ROCK VOLUME m³	ROCK EXCAVATION AREA m²	ROCK EXCAVATION VOLUME m³	EMBANKMENT AREA m²	EMBANKMENT VOLUME m³		

STATION km + m	DIST m	TOTAL EXCAVATION EARTH AND ROCK AREA m²	TOTAL EXCAVATION EARTH AND ROCK VOLUME m³	ROCK EXCAVATION AREA m²	ROCK EXCAVATION VOLUME m³	EMBANKMENT AREA m²	EMBANKMENT VOLUME m³		

SUMMARY AND BALANCES

STATION TO STATION km + m	km + m	TOTAL EXC. EARTH+ROCK m³	ROCK EXCAVATION m³	EMBANKMENT m³	EXCESSES CUT	EXCESSES FILL	ACCUMULATIVE EXCESSES CUT	ACCUMULATIVE EXCESSES FILL
MAINLINE								
AH 15+000	AH 15+100	776		53	723		723	
AH 15+100	AH 15+200	999		18	981		1704	
AH 15+200	AH 15+300	902		131	771		2475	
AH 15+300	AH 15+400	825		100	725		3200	
AH 15+400	AH 15+460	894		0	894		4094	
SIDELINE								
26+010	26+060	331		0	331		4425	
DRIVES		548		23	525		4950	
TOTALS		5275		325			4950	

REMARKS

EARTH AND ROCK EXCAVATION	4950
SOLID ROCK EXCAVATION	
EARTH EXCAVATION	4950
PLANIMETERED FILL	325
LESS FACTORED SOLID ROCK	
LESS DISPLACEMENT OF ANY LARGE STRUCTURES	
NET PLANIMETERED FILL	325
FACTOR	
PLANIMETERED FILL INCLUDING FACTOR	(325 X 1.15) = 374
MATERIALS AVAILABLE FOR FILLS	
EARTH EXCAVATION	4950
CHANNEL EXCAVATION	
UNDERDRAIN EXCAVATION	(0.65 X 1066) = 640
STRUCTURE EXCAVATION	
TOTAL MATERIAL AVAILABLE FOR FILL	5590
TOTAL FILL INCLUDING FACTOR	375
TOTAL MATERIAL FOR FILL	5965
BORROW	
EXCESS EXCAVATION	5789

PROJECT NAME: FRANKLIN
PROJECT NUMBER: STP 0301(18)

FILE NAME: ...85c060/design/dc060pms.dgn
PROJECT LEADER: DELLASANTA
DESIGNED BY: SQUAD B
IPARM FILE NAME: (2)dc060ewl.i
PLOT DATE: 27-MAR-2003
DRAWN BY: SQUAD B
CHECKED BY: SQUAD B
SHEET 11 OF 60

Metric

STATE OF VERMONT
AGENCY OF TRANSPORTATION
RIGHT OF WAY PLANS
DETAIL SHEET

TABLE OF PROJECT PROPERTY ACQUISITION

PARCEL NO.	GRANTOR	SHEET NO.	BEGINNING STATION	ENDING STATION	TAKING	REM.	RIGHTS	TITLE TAKEN	DATE	TOWN OR CITY RECORDED	BK.	PG.	REMARKS
36	BENOIT, PIERRE & BETTY A.	8	AH 15+042.0 LT.				DRIVE (T)						GRAVEL 3.6M WIDE
37	LAURIE-DAY, ANNE S.	8	AH 15+038.4 RT.	AH 15+046.8 RT.			SLOPE (T) 8.3 SM±						89 S.F.±
			AH 15+046.6 RT.				REMOVE & RESET (T) 50 SM±						50 MM SPRUCE
			AH 15+047.9 RT.				REMOVE & RESET (T)						50 MM SPRUCE
			AH 15+051.0 RT.				DRIVE (T)						GRAVEL 3M WIDE
38	MAGNANT, TIMOTHY A. &	8	AH 15+053.4 RT.	AH 15+062.9 RT.			SLOPE (T) 23 SM±						248 S.F.±
	MARTHA E.		AH 15+068.0 RT.				DRIVE (T)						GRAVEL 3.6M WIDE
39	BENOIT, PIERRE & BETTY A.	8	AH 15+093.0 LT.				DRIVE (T)						GRAVEL 3M WIDE
	& JACOBS, GARY P.												
40	NOT USED												
41	DOMINA, LEE	8	AH 15+102.0 RT.				DRIVE (T)						GRAVEL 3M WIDE
42	BISHOP, LAWRENCE F. &	9	AH 15+160.0 RT.				DRIVE (T)						PAVED 3M WIDE
	VERA VIVIAN												
43	WILLIAMS, RODNEY L. &	9	AH 15+136.0 LT.				DRIVE (T)						GRAVEL 3.2M WIDE
	DARLENE N.		AH 15+154.0 LT.				INSTALL (T)						SIDEWALK
			AH 15+158.6 LT.				REMOVE & RESET (T)						LILAC
			AH 15+169.1 LT.	AH 15+170.4 LT.			SLOPE (T) 0.1 SM±						1 S.F.±
44	BULLIS, CLIFFORD J. &	9	AH 15+177.0 LT.				DRIVE (T)			FRANKLIN			GRAVEL 2.4M WIDE
	HILL, STARLENE A.		AH 15+180.0 LT.	AH 15+187.2 LT.			SLOPE (T) 1 SM±						11 S.F±
			AH 15+194.0 LT.	AH 15+197.0 LT.			REMOVE & RESET (T)						FENCE
			AH 15+197.1 LT.	AH 15+197.6 LT.			CULVERT (P)						
			TH16 26+043 LT.				DRIVE (T)						GRAVEL 6M WIDE
45	BRAYSON, MICHAEL C.	9	AH 15+162.2 RT.	AH 15+162.8 RT.			SLOPE (T) 0.3 SM±						3 S.F.±
			AH 15+169.0 RT.				DRIVE (T)						PAVED 2.8M WIDE
46	BARRETTE, STEPHEN D. &	9	AH 15+194.0 RT.				DRIVE (T)						GRAVEL 2.5M WIDE
	QUINTIN, GINA C.		AH 15+204.0 RT.				CONNECT (T)						CELLAR DRAIN
47	LOTHIAN, KEVIN E. &	9	AH 15+218.0 RT.				DRIVE (T)						PAVED 3.7M WIDE
	DARLA J.		AH 15+227.0 RT.				INSTALL (T)						SIDEWALK
			AH 15+231.0 RT.				CONNECT (T)						CELLAR DRAIN
48	WILLIAMS, MATTHEW L. &	9	AH 15+216.0 LT.	AH 15+220.0 LT.			SLOPE (T) 2 SM±						22 S.F.±
	JESSICA L.		AH 15+219.1 LT.				REMOVE (T)						450 MM MAPLE
			AH 15+227.0 LT.				INSTALL (T)						SIDEWALK
			AH 15+242.0 LT.				REMOVE & RESET (T)						IRON PIN
			TH16 26+031 RT.				DRIVE (T)						GRAVEL 11.3M WIDE

REVISION NO.	SHEET	DESCRIPTION OF REVISION	DATE	MADE BY	APPROVED BY
1	6,8	PARCEL NO. 37 LAURIE-DAY. DELETE EDWARD F. DAY. PER C.O. 9237.	05-24-02	M.J.R.	R.P.D.
2	6,8	PARCEL NO. 39 LEWIS. CHANGE NAME TO: BENOIT, PIERRE & BETTY A.; JACOBS, GARY P. PER C.O. 9238.	05-24-02	M.J.R.	R.P.D.
3	6,9	PARCEL NO. 46 LOTHIAN. CHANGE NAME TO: BARRETT, STEPHEN D. & QUINTIN, GINA C. PER C.O. 9239.	05-24-02	M.J.R.	R.P.D.
4	6,9	PARCEL NO. 47 LOTHIAN. CHANGE NAME TO: LOTHIAN, KEVIN E. & DARLA J. PER C.O. 9240	05-24-02	M.J.R.	R.P.D.
5	7,10	PARCEL NO. 52 GRANGER. REMOVE BEATRICE M. GRANGER FROM TITLE. PER C.O. 9241.	05-24-02	M.J.R.	R.P.D.
6	7,10	PARCEL NO. 53 TIPPER. REMOVE KIMBERLY L. TIPPER FROM TITLE. PER C.O. 9242.	05-24-02	M.J.R.	R.P.D.
7	10	PARCEL NO. 55 COOPER. CHANGE LAYOUT SO IT SHOWS FENCE ON EASTERLY BOUNDARY. NO ADDITIONAL RIGHTS NECESSARY. PER C.O. 9243.	05-24-02	M.J.R.	R.P.D.
8	7,10	PARCEL NO. 56 LUCE. ADD KING, CECIL AS OWNER. DELETE THE RIGHT 'REMOVE & RESET (T)' FOR FENCE. PER C.O. 9244.	05-24-02	M.J.R.	R.P.D.
9	1-10	CREATED NEW R.O.W. SET. RE-NUMBERED SHEETS. NEW SUB-PROJECT FOR VILLAGE OF FRANKLIN PORTION. ALL PARCELS(36-57) AFFECTED. RIGHTS REVISED FOR PARCELS 49(COOPER), 50(PIERCE) AND 51(LOTHIAN).	09-27-02	G.J.F.	R.P.D.
10	6,9	PARCEL NO. 46 BARRETT & QUINTIN. CHANGED SPELLING OF BARRETT, STEPHEN D. TO BARRETTE, STEPHEN D. PER C.O. 9266 ELECTRONIC IPARMS TO ROADWAY 4-28-03	01-09-03	P.J.H.	R.P.D.

DR.(P)- DRAINAGE RIGHT
DIT.(P)- DITCHING RIGHT
CH.(P)- CHANNEL RT.
DRIVE (T)- DRIVE RIGHT
CUL.(P)- CULVERT RIGHT
[W]- WATER SOURCES

PRESENT R.O.W.
TAKING WITHOUT ACCESS
TAKING WITHOUT ACCESS ALONG PROPERTY LINE
TAKING WITH ACCESS
(P) PERMANENT EASEMENT
(T) TEMPORARY EASEMENT

LEGEND
C&T (P) CLEARING & TRIMMING
CZ (P) CLEAR ZONE
CONST.(T) CONSTRUCTION EASEMENT
SR SR SLOPE RIGHTS
P L PROPERTY LINE
TOP OF CUT
TOE OF SLOPE
UE (P) PERMANENT UTILITY EASEMENT

APPROVED: ROGER P. DUMAS DATE: 10-01-02
CHIEF, PLANS & TITLES

R.O.W. PLANS
HIGHGATE-FRANKLIN
STP RS 0301(I)SA
VILLAGE PORTION
6 10
SHEET 12 OF 60

ACCT.gmeunier
\\vaot_cadd\filingcabinet$\85c060\RightOfWay\village_rc060d.dgn
DATE PLOTTED 28-APR-2003

Metric

STATE OF VERMONT
AGENCY OF TRANSPORTATION
RIGHT OF WAY PLANS
DETAIL SHEET

TABLE OF PROJECT PROPERTY ACQUISITION

PARCEL NO.	GRANTOR	SHEET NO.	BEGINNING STATION	ENDING STATION	TAKING	REM.	RIGHTS	TITLE TAKEN	DATE	TOWN OR CITY RECORDED	BK.	PG.	REMARKS
49	COOPER, FREDERICK A. &	9	AH 15+278.00 LT.	AH 15+288.26 LT.	68 SM±					FRANKLIN			732 S.F.±
	RUTH		AH 15+268.0 LT.				DRIVE (T)						GRAVEL 3.7M WIDE
			AH 15+275.4 LT.	AH 15+279.1 LT.			SLOPE (T) 4 SM±						43 S.F.±
50	PIERCE, ROBERT J.	9	AH 15+275.0 RT.	AH 15+281.32 RT.±	17 SM±					FRANKLIN			183 S.F.±
			AH 15+255 RT.				CONNECT (T)						CELLAR DRAIN
			AH 15+264 RT.				DRIVE (T)						PAVED 4.7M WIDE
			AH 15+265.6 RT.				REMOVE (T)						STUMP
			AH 15+269.2 RT.	AH 15+281.8 RT.			CONST. (T) 22 SM±						INC. EROSION CONTROL
													237 S.F.±
			AH 15+272.6 RT.	AH 15+275.0 RT.			SLOPE (T) 1.4 SM±						15 S.F.±
			AH 15+276.2 RT.	AH 15+281.4 RT.			CHANNEL (P) 16 SM±						172 S.F.±
51	LOTHIAN, MERRIMAN E. &	9,10	AH 15+280.94 RT.±	AH 15+288.00 RT.	18 SM±					FRANKLIN			194 S.F.±
	LUCILLE		AH 15+280.8 RT.	AH 15+287.7 RT.			CHANNEL (P) 21 SM±						226 S.F.±
			AH 15+281.4 RT.	AH 15+298.2 RT.			CONST. (T) 27 SM±						291 S.F.±
			AH 15+288.0 RT.	AH 15+290.4 RT.			SLOPE (T) 3 SM±						32 S.F.±
			AH 15+316.0 RT.				DRIVE (T)						GRAVEL 3.2M WIDE
			AH 15+339.0 RT.				DRIVE (T)						GRAVEL 6.4M WIDE
			AH 15+361.8 RT.	AH 15+362.2 RT.			SLOPE (T) 0.1 SM±						1 S.F.±
52	GRANGER, JOHN P.	10	AH 15+366.0 RT.	AH 15+368.0 RT.			REMOVE & RESET (T)						FENCE
			AH 15+379.0 RT.				DRIVE (T)						GRAVEL 3M WIDE
53	TIPPER, ROBERT C., JR.	10	AH 15+391.0 RT.				INSTALL (T)						SIDEWALK
			AH 15+400.0 RT.										DRIVE
54	PLOOF, MARSHALL W. &	10	AH 15+416.0 RT.				DRIVE (T)						GRAVEL 14.6M WIDE
	COLETTE J., LESSOR												
	THE UNITED STATES POSTAL												
	SERVICE, LESSEE												
55	COOPER, RICHARD L. &	10	AH 15+333.0 LT.				DRIVE (T)						GRAVEL 8.6M WIDE
	DARLENE J.		AH 15+337.6 LT.	AH 15+357.5 LT.			SLOPE (T) 37 SM±						398 S.F.±
			AH 15+338.0 LT.	AH 15+343.0 LT.			INSTALL (T)						SIDEWALK
			AH 15+339.0 LT.	AH 15+341 LT.			REMOVE & RESET (T)						2 ROSE BUSHES
			AH 15+360.0 LT.				DRIVE (T)						GRAVEL 2.1M WIDE
			AH 15+361.1 LT.	AH 15+370.1 LT.			SLOPE (T) 8 SM±						86 S.F.±
56	LUCE, JACQUELINE C. &	10	AH 15+449.0 LT.	AH 15+456.07 LT.	36 SM±					FRANKLIN			388 S.F.±
	KING, CECIL		AH 15+370.1 LT.	AH 15+408.9 LT.			SLOPE (T) 15 SM±						161 S.F.±
			AH 15+412.0 LT.				DRIVE (T)						GRAVEL 3.2M WIDE
			AH 15+415.9 LT.	AH 15+450.1 LT.			SLOPE (T) 20 SM±						215 S.F.±
			AH 15+444.9 LT.	AH 15+451.3 LT.			INSTALL & MAINT. (P)						SIDEWALK
			AH 15+450.1 LT.	AH 15+454.2 LT.			SLOPE (T) 10 SM±						108 S.F.±
57	LEWIS, EDWARD P. SR.	9	TH16 26+050 RT.				DRIVE (T)						GRAVEL 3M WIDE
	& SANDRA P.												

REVISION NO.	SHEET	DESCRIPTION OF REVISION	DATE	MADE BY	APPROVED BY
11	7,10	PARCEL NO. 56 LUCE & KING. ADD 6' CURB CUT BETWEEN APPROX. STA. 15+370.5 LT. AND 15+372.3 LT. PER C.O. 9267	03-21-03	G.J.F.	R.P.D.
12	7,10	PARCEL NO. 51 LOTHIAN. REMOVE 600MM MAPLE TREE @ APPROX. STA. 15+329 RT. REMOVE MAPLE @ APPROX. STA. 15+345 RT. PER C.O. 9269	03-21-03	G.J.F.	R.P.D.
13	7,8	PARCEL NO. 38 MAGNANT. INCREASE DISTANCE AT CURB CUT OPENING TO A MINIMUM OF FIFTEEN FEET(15')[4.57 METERS±]WIDE AT APPROX. STA. AH 15+068.0 RT. PER C.O. 9277	03-21-03	G.J.F.	R.P.D.
14	7,9	PARCEL NO. 43 WILLIAMS. STRAIGHTEN ALIGNMENT OF NEW SIDEWALK TO BE INSTALLED BETWEEN APPROX. STA. AH 15+142.0 LT. AND STA. AH 15+170.0 LT. DELETE THE WORD 'SAVE' WHERE IT APPEARS IN CONNECTION WITH THE THREE MAPLE TREES LOCATED WITHIN THE RIGHT OF WAY IN FRONT OF OWNERS PARCEL. PER C.O. 9279	03-21-03	G.J.F.	R.P.D.
15	7,9	PARCEL NO. 44 BULLIS. STRAIGHTEN ALIGNMENT OF NEW SIDEWALK TO BE INSTALLED BETWEEN APPROX. STA. AH 15+170.0 LT. AND STA. AH 15+190.0 LT. PER C.O. 9280	03-21-03	G.J.F.	R.P.D.

DR.(P)- DRAINAGE RIGHT
DIT.(P)- DITCHING RIGHT
CH.(P)- CHANNEL RT.
DRIVE (T)- DRIVE RIGHT
CUL.(P)- CULVERT RIGHT
[W]- WATER SOURCES

PRESENT R.O.W.
TAKING WITHOUT ACCESS
TAKING WITHOUT ACCESS ALONG PROPERTY LINE
TAKING WITH ACCESS
(P) PERMANENT EASEMENT
(T) TEMPORARY EASEMENT

LEGEND
C&T (P) CLEARING & TRIMMING
CZ (P) CLEAR ZONE
CONST. (T) CONSTRUCTION EASEMENT
SR SR SLOPE RIGHTS
P PROPERTY LINE
L
TOP OF CUT
TOE OF SLOPE
UE (P) PERMANENT UTILITY EASEMENT

ACCT.gmeunier
\\vaot_cadd\filingcabinet$\85c060\RightOfWay\village_rc060d.dgn
DATE PLOTTED 28-APR-2003

APPROVED: ROGER P. DUMAS DATE: 10-01-02
CHIEF, PLANS & TITLES

R.O.W. PLANS
HIGHGATE-FRANKLIN
STP RS 0301(I)SA
VILLAGE PORTION
7 10
SHEET 13 OF 60

CONSTRUCT DRIVE

15+042	LT	GRAVEL
15+051	RT	GRAVEL
15+068	RT	GRAVEL
15+093	LT	GRAVEL
15+102	RT	GRAVEL

VERTICAL GRANITE CURB

15+033.8 TO 15+048.8 RT
15+040.1 TO 15+091.4 LT
15+053.0 TO 15+064.4 RT
15+068.2 TO 15+100.4 RT
15+095.0 TO 15+120.0 RT
15+103.5 TO 15+120.0 RT

RELOCATE MAIL BOX, SINGLE SUPPORT

15+048 LT TO 15+046 LT
15+057 RT TO 15+053 RT.
15+090 LT TO 15+091 LT.
15+107 RT TO 15+105 RT.

PORTLAND CEMENT CONCRETE SIDEWALK, 1530MM

15+051 TO 15+091 LT
15+095 TO 15+120 LT

TRANSPLANTING TREES

15+046.6 RT 50 SM+/-
15+047.9 RT 50 SM+/-
(FINAL LOCATION WILL BE AT A MUTUALLY AGREED UPON LOCATION BETWEEN THE ENGINEER AND PROPERTY OWNER)

CURVE #32

Δ 14° 35' 45" RT
R 700.000 M
L 178.323 M
T 89.647 M
E 5.717 M
B 3.000%

STA. 15+000
BEGIN APPROACH
PI ah 14+978.362 =
ah 14+977.390

STA. 15+034
BEGIN PROJECT
STP0301(18)

BEGIN R.O.W. PROJECT
RS 0301-9(1) SA
STA ah 15+038.4 5.68m. RT.

STA ah 15+095 LT
CONSTRUCT TYPICAL DRIVE WITH 1530 SIDEWALK ADJACENT TO VERTICAL GRANITE CURB IN ACCORDANCE WITH STANDARD C-2AM

STA ah 15+091 LT
CONSTRUCT TYPICAL DRIVE WITH 1530 SIDEWALK ADJACENT TO VERTICAL GRANITE CURB IN ACCORDANCE WITH STANDARD C-2AM

STA ah 15+051 LT
CONSTRUCT SIDEWALK RAMP TYPE I

STA ah 15+098 ~ STA ah 15+124 LT
NEW 150mm X 23M UNDERDRAIN W/ F.B. @ 15+098 LT

BENOIT, PIERRE & BETTY A. (36)
GARAGE AND BARN
1½SWF HOUSE
BENOIT, PIERRE & BETTY A.
JACOBS, GARY P. (39)
MOBILE HOME
BAILEY, HOWARD S. & BRENDA L.
1½SWF HO.
LAURIE-DAY, ANNE S. (37)
MAGNANT, TIMOTHY A. & MARTHA E. (38B)
DOMINA, LEE (41)
BISHOP, LAWRENCE F. & VERA VIVIAN (42)

FARMLAND
AERIAL E&T
ACL R.T.I.
CONST(T)
COLD PLANING AREA
APPROX. LEACH FIELD LOCATION
DRY WELL
DRIVE (T)
SR(T)
REMOVE & RESET
REMOVE&RESET(T)
SAVE
600 MPL SAVE
LILAC
STUMP
750 MPL
450 MPL REMOVE
150 BAL
150 SPR
N65° 36' 37" E 171.944
MATCH TO SHEET 9 OF 10

STA ah 15+032 ~ STA ah 15+046.5 RT
NEW 450mm X 13M (RCCSP 1.63)
NEW 450mm X 16M UNDERDRAIN
PLUG PIPE & UNDERDRAIN FOR FUTURE USE
@ ST. 15+032 RT.

STA ah 15+048 ~ STA ah 15+061 RT
REMOVE EXISTING DRIVE CULVERT
REMOVE WITH COMMON

STA ah 15+046.5 ~ STA ah 15+098 RT
NEW 450mm X 51M OPTION PIPE
W/CB @ INLET & OUTLET

STA ah 15+048 ~ STA ah 15+098 RT
NEW 450mm X 51M UNDERDRAIN
W/ FB @ STA ah 15+048 RT

STA ah 15+100 TO STA ah 15+106 RT
REMOVE EXISTING 380mm ACCOMP
REMOVE WITH COMMON

) R.O.W. PROJECT
TP RS 0301(1) SA
TA. ah15+038.4
5.68M RT.

1:250

LINES SHOWN ON THIS PLAN AS EXISTING PROPERTY LINES (P/L) ARE BELIEVED TO BE ACCURATE BUT SHOULD NOT BE RELIED UPON FOR PURPOSES UNRELATED TO THE TOWN OF FRANKLIN'S ACQUISITION OF LAND AND RIGHTS FOR THIS PROJECT.

○ DENOTES TREE OR STUMP REMOVAL

ALL DRIVE RADII SHALL BE 6M UNLESS OTHERWISE NOTED PER STD B-7IM

FOR R.O.W. USE ONLY

PROJECT NAME:	HIGHGATE - FRANKLIN VILLAGE PORTION
PROJECT NUMBER:	STP RS 0301(1) SA
FILE NAME:	...85c060/design/dc060bdr.dgn
PROJECT LEADER:	DELLASANTA
DESIGNED BY:	SQUAD B
R.O.W. SHEET	8 OF 10
PLOT DATE:	28-APR-2003
DRAWN BY:	SQUAD B
CHECKED BY:	SQUAD B
SHEET	14 OF 60

MTO Metric

VERTICAL GRANITE CURB
15+120.0 TO 15+125.2 LT
15+120.0 TO 15+158.7 RT
15+128.6 TO 15+133.9 LT
15+138.0 TO 15+175.7 LT
15+161.8 TO 15+164.9 RT
15+168.8 TO 15+191.8 RT
15+178.4 TO 15+197.7 LT
15+195.2 TO 15+216.0 RT
SL 26+006.1 TO SL 26+037.3 LT
SL 26+036.9 TO SL 26+047.4 RT
SL 26+024.4 RT TO ML 15+212.4 LT
15+214.4 TO 15+266.1 LT
15+219.7 TO 15+260.8 RT
15+265.5 TO 15+300.0 RT
15+270.4 TO 15+300.0 LT

RELOCATE MAIL BOX, SINGLE SUPPORT
15+132 LT TO 15+131.11
15+196 RT TO 15+194.7
SL 26+038 RT
SL 26+045 RT

REMOVING AND RESETTING FENCE
15+194 TO 15+197 LT

TRANSPLANTING SHRUBS
15+158.6 LT - LILAC BUSH
(FINAL LOCATION WILL BE AT A MUTUALLY AGREED UPON LOCATION BETWEEN THE ENGINEER AND PROPERTY OWNER

STA ah 15+025 LT AND STA ah 15+029 LT
CONSTRUCT TYPICAL DRIVE
WITH 1530 SIDEWALK ADJACENT
TO VERTICAL GRANITE CURB
IN ACCORDANCE WITH STANDARD
C-2AM

STA ah 15+175 LT AND STA ah 15+179 LT
STA ah 15+039 LT AND STA ah 15+033 LT
CONSTRUCT TYPICAL DRIVE
WITH 1530 SIDEWALK ADJACENT
TO VERTICAL GRANITE CURB
IN ACCORDANCE WITH STANDARD
C-2AM

STA ah 15+196 LT
CONSTRUCT SIDEWALK RAMP TYPE I

TH #16 STA. 26+060.000
END CONSTRUCTION
CONSTRUCT SATISFACTORY APPROACH

PORTLAND CEMENT CONCRETE WALK
15+227 RT (6.0M BACK)
15+227 LT (2.0M BACK)
15+154 LT 3M BACK

PORTLAND CEMENT CONCRETE SIDEWALK, 1530MM
15+212 TO 15+300 LT

CONSTRUCT DRIVE
15+127 LT GRAVEL
15+136 LT GRAVEL
15+160.3 RT PAVED
15+168 RT PAVED
15+177 LT GRAVEL
15+194 RT GRAVEL
15+218 RT PAVED
15+264 RT PAVED
15+268 LT GRAVEL
TH #16 STA 26+031RT GRAVEL
TH #16 STA 26+043 LT GRAVEL
TH #16 STA 26+050 RT GRAVEL

CELLAR DRAIN SHALL BE ADJUSTED AS DIRECTED BY THE RESIDENT ENGINEER TO DRAIN INTO NEW UNDERDRAIN
15+204 RT
15+231 RT
15+255 RT

STONE FILL TYPE II
15+278 TO 15+280 RT
15+281.5 TO 15+283.5 RT

REMOVE & RESET PROPERTY MARKER
15+242.0 LT

REMOVE EXISTING SIDEWALK
15+154.250 (8.9M BACK) LT
15+226.970 (6.0M BACK) LT
15+226.570 (6.0M BACK) RT
15+210.150 TO 15+261.140 LT

STA ah 15+216 LT
CONSTRUCT SIDEWALK RAMP TYPE I

STA ah 15+246 LT AND STA ah 15+261 LT
CONSTRUCT TYPICAL DRIVE
WITH 1530 SIDEWALK ADJACENT
TO VERTICAL GRANITE CURB
IN ACCORDANCE WITH STANDARD
C-2AM

STEEL BEAM GUARD RAIL
15+277 LT TO 15+295 RT
15+275 RT TO 15+290 RT

PI ah 15+287.269 = ah 15+287.084

CURVE #33
Δ 08° 41' 50" RT
R 635.000 M
L 96.391 M
T 48.288 M
E 1.833 M
B 3.300%

STA ah 15+281 ℄ RETAIN EXISTING 7'-8"X5'-5" CGMP

BULLIS, CLIFFORD J. & HILL, STARLENE A. (44)
LEWIS, EDWARD P. SR. & SANDRA P. (57)
BAILEY, HOWARD S. & BRENDA L. (43)
WILLIAMS, RODNEY L. & DARLENE N. (43)
WILLIAMS, MATTHEW L. & JESSICA L. (48)
COOPER, FREDRICK A. & RUTH
TOWN OF FRANKLIN (49)
BISHOP, LAWRENCE F. & VERA VIVIAN (42)
BARRETTE, STEPHEN D. QUINTIN, GINA C. (46)
BRAYSON, MICHAEL C. (45)
LOTHIAN, KEVIN E. & DARLA J. (47)
PIERCE, ROBERT J. (50)
LOTHIAN, MERRIMAN E. & LUCILLE (51)

TH #3 CONST. ℄ P.O.T. AH 15+203.980 =
TH #16 P.O.T. 26+000.000
ASKEW = 82° 01' 44" LT

BM #28
N.E. COR. OF BOT. CONC. STEP
ELEV. 137.380 m

N65° 36' 37" E
171.944

MATCH TO SHEET 8 OF 10
MATCH TO SHEET 10 OF 10

0 5 10 15
1:250

LINES SHOWN ON THIS PLAN AS EXISTING PROPERTY LINES (P/L) ARE BELIEVED TO BE ACCURATE BUT SHOULD NOT BE RELIED UPON FOR PURPOSES UNRELATED TO THE TOWN OF FRANKLIN'S ACQUISITION OF LAND AND RIGHTS FOR THIS PROJECT.

○ DENOTES TREE OR STUMP REMOVAL

ALL DRIVE RADII SHALL BE 6M UNLESS OTHERWISE NOTED PER STD B-7IM

FOR R.O.W. USE ONLY

PROJECT NAME: HIGHGATE - FRANKLIN VILLAGE PORTION
PROJECT NUMBER: STP RS 0301(1) SA

FILE NAME: ...85c060/design/dc060bdr.dgn
PROJECT LEADER: DELLASANTA
DESIGNED BY: SQUAD B
R.O.W. SHEET 9 OF 10

PLOT DATE: 28-APR-2003
DRAWN BY: SQUAD B
CHECKED BY: SQUAD B
SHEET 15 OF 60

MADOT Metric

VERTICAL GRANITE CURB
15+300.0 TO 15+328.8 LT
15+300.0 TO 15+313.8 RT
15+317.1 TO 15+336.0 RT
15+317.9 TO 15+338.6 LT
15+322.5 TO 15+357.4 RT
15+341.4 TO 15+410.1 LT
15+380.6 TO 15+398.2 RT
15+401.5 TO 15+408.6 RT
15+413.9 TO 15+454.7 LT
15+423.2 TO 15+458.9 RT

CONSTRUCT DRIVE
15+316 RT GRAVEL
15+333 LT GRAVEL
15+339 RT GRAVEL
15+360 LT GRAVEL
15+379 RT GRAVEL
15+400 RT GRAVEL
15+412 LT GRAVEL
15+416 RT GRAVEL

PORTLAND CEMENT CONCRETE SIDEWALK, 1530MM
15+300 TO 15+451 LT

PORTLAND CEMENT CONCRETE WALK
15+338 TO 15+343 LT (BACK 4.6 M)
15+349 RT 3M BACK
15+391 RT 4.6M BACK

REMOVAL OF EXISTING SIDEWALK
15+363.830 TO 15+455.220 LT

TRANSPLANTING SHRUBS
15+339 LT - ROSE BUSHES
15+341 LT - ROSE BUSHES
FINAL LOCATION WILL BE AT A MUTUALLY AGREED APON LOCATION BETWEEN THE ENGINEER AND THE PROPERTY OWNER

REMOVING AND RESETTING FENCE
15+305 TO 15+323 LT
15+366 TO 15+368 RT

STA ah 15+414 LT AND STA ah 15+409 LT
CONSTRUCT NON-COMMERCIAL
DRIVE WITH GRASS PLOT AND
VERTICAL GRANITE CURB

STA ah 15+358 LT AND STA ah 15+362 LT
CONSTRUCT NON-COMMERCIAL
DRIVE WITH GRASS PLOT AND
VERTICAL GRANITE CURB

APPROXIMATE: STA ah 15+370.5 LT ~ STA ah 15+372.5 LT
1.8M CURB CUT

STA ah 15+227 LT AND STA ah 15+239 LT
CONSTRUCT NON-COMMERCIAL
DRIVE WITH GRASS PLOT AND
VERTICAL GRANITE CURB

CONSTRUCT WALK

TO CANADA

TO SHELDON

MATCH TO SHEET 9 OF 10

TOWN OF FRANKLIN

HISTORIC LOG CABIN

GARDEN

GARAGE

DRIVE(T) 8.6M

REMOVE & RESET(T)

INSTALL(T)

SR(T)

WOOD POST

P BROOKS'

1½SWF HOUSE

2.1M

DRIVE(T)

3.2M

DRIVE(T)

COOPER, RICHARD L. & DARLENE J.
55

LUCE, JACQUELINE C. & KING, CECIL

STA ah 15+363 ~ STA ah 15+413.5 LT
NEW 150mm X 5M UNDERDRAIN
W/ FB @ STA ah 15+413.5 LT

STA ah 15+415
NEW 150mm X 24M UNDERDRAIN
W/ FB @ STA ah 15+438.5 LT

STA ah 15+438.5 LT

GR. DR.

GR. DR.

2½STORY BRICK HOUSE

56

ah 15+455.19
18.00M LT.

SIGN

INSTALL & MAINTAIN(P)

R = 11.00M

ah 15+440.00
1.55M LT.

2.5M

10.50M

7.61M

FILLER PIPE

PUMP FOUND

GARAGE

PAVED SHOULDER

END R.O.W. PROJECT
RS 0301-9(1) SA
STA ah 15+456.07 7.54m. LT.

STA. 15+464.139
END PROJECT
STP0301(18)

STA ah 15+461.170
MATCH EXISTING PAVEMENT

PAVED

2 SWF HOUSE

TH#3 ℄ P.O.T. ah 15+464.139
ROUTE 120 P.O.T. 304+095.461
END PROJECT

ROUTE 120

GR. DR.

HASTON LIBRARY

TOWN OF FRANKLIN

ah 15+300 ah 15+320 ah 15+340 ah 15+360 ah 15+380 ah 15+400 ah 15+420 ah 15+440 ah 15+460 ah 15+464

N74° 18' 27" E
128.767

LILAC

R32

R 30

600 MPL REMOVE

400 MPL SAVE

600 MPL SAVE

APPROX. LOCATION OF LEACH FIELD

Sta 15+335.372

6.4M DRIVE(T)

MPL REMOVE

1½SWF HOUSE

3M DRIVE(T)

1½SWF HOUSE

3.9M

INSTALL(T)

DRIVE(T) 14.6M

R = 17 M

R = 11 M

3.2M DRIVE(T)

LILAC

LILAC

200 BAL

100 BAL

200 BAL

GARAGE

STA ah 15+317.5 RT.
NEW 150mm X 8M UNDERDRAIN
W/ FB @ STA ah 15+317.5 RT

STA ah 15+311 ~ STA ah 15+343.5 RT.
NEW 450mm X 8.0M OPTION PIPE
W/CB @ INLET & DI @ OUTLET

STA ah 15+39 ~ STA ah 15+343.5 RT.
NEW 150mm X 24M UNDERDRAIN
W/ FB @ STA ah 15+343.5 RT

STA ah 15+39 ~ STA ah 15+345 RT.
NEW 450mm X 25M OPTION PIPE
W/CB @ INLET & OUTLET

STA ah 15+345 ~ STA ah 15+361.5 RT.
NEW 150mm X 17M UNDERDRAIN
W/ FB @ STA ah 15+361.5 RT

STA ah 15+345 ~ STA ah 15+363 RT.
NEW 450mm X 17M OPTION PIPE
W/CB @ INLET & OUTLET

STA ah 15+363 ~ STA ah 15+381.5 RT.
NEW 450mm X 4.5M OPTION PIPE
W/CB @ INLET & OUTLET
SKEW 90-00-00°.

STA ah 15+363 ~ STA ah 15+381.5 RT.
NEW 150mm X 19M UNDERDRAIN
W/ FB @ STA ah 15+381.5 RT

STA ah 15+363 ~ STA ah 15+393 RT.
NEW 450mm X 19M OPTION PIPE
W/CB @ INLET & OUTLET

STA ah 15+363 ~ STA ah 15+415 LT.
NEW 450mm X 5M OPTION PIPE
W/CB @ INLET & OUTLET

STA ah 15+383 ~ STA ah 15+424 RT.
NEW 150mm X 41.5M UNDERDRAIN
W/ FB @ STA ah 15+424 RT

STA ah 15+415 LT ~ STA ah 15+425.6 RT.
NEW 450mm X 18M OPTION PIPE
W/CB @ INLET & OUTLET
ASKEW 27-32-46° RT.

STA ah 15+415 ~ STA ah 15+440 LT.
NEW 450mm X 24M OPTION PIPE
W/CB @ INLET & OUTLET

STA ah 15+425 ~ STA ah 15+438.5 RT.
NEW 150mm X 13.5M UNDERDRAIN
W/ FB @ STA ah 15+438.5 RT

STA ah 15+440 ℄
NEW 450mm X 5M OPTION PIPE
W/CB @ INLET & OUTLET
SKEW 90-00-00°.

51
LOTHIAN, MERRIMAN E. & LUCILLE

52
GRANGER, JOHN P.

53
TIPPER, ROBERT C., JR.

54
PLOOF, MARSHALL W. & COLETTE J., LESSOR
THE U. S. POSTAL SERVICE, LESSEE

PROFILE OF WALK MAY NEED TO BE ADJUSTED AS DIRECTED BY RESIDENT ENGINEER

LINES SHOWN ON THIS PLAN AS EXISTING PROPERTY LINES (P/L) ARE BELIEVED TO BE ACCURATE BUT SHOULD NOT BE RELIED UPON FOR PURPOSES UNRELATED TO THE TOWN OF FRANKLIN'S ACQUISITION OF LAND AND RIGHTS FOR THIS PROJECT.

0 5 10 15
1:250

○ DENOTES TREE OR STUMP REMOVAL

ALL DRIVE RADII SHALL BE 6M UNLESS OTHERWISE NOTED PER STD B-7IM

FOR R.O.W. USE ONLY

PROJECT NAME: HIGHGATE - FRANKLIN VILLAGE PORTION
PROJECT NUMBER: STP RS 0301(1) SA

FILE NAME: ...85c060/design/dc060bdr.dgn PLOT DATE: 28-APR-2003
PROJECT LEADER: DELLASANTA DRAWN BY: SQUAD B
DESIGNED BY: SQUAD B CHECKED BY: SQUAD B
R.O.W. SHEET 10 OF 10 SHEET 16 OF 60

Metric

CONSTRUCT DRIVE
15+042 LT GRAVEL
15+051 RT GRAVEL
15+068 RT GRAVEL
15+093 LT GRAVEL
15+102 RT GRAVEL

VERTICAL GRANITE CURB
33.5 15+~~033.8~~ TO 15+~~048.6~~ RT 47.8
47.6 15+~~040.1~~ TO 15+~~081.4~~ LT 90.6
58.9 15+~~053.0~~ TO 15+064.4 RT
71.2 15+~~068.2~~ TO 15+1~~00.4~~ RT 99.6
97.6 15+~~095.0~~ TO 15+120.0 LT
105.0 15+1~~03.5~~ TO 15+120.0 RT

RELOCATE MAIL BOX, SINGLE SUPPORT
~~15+048 LT TO 15+046 LT~~
15+057 RT TO 15+053 RT. (2)
15+090 LT TO 15+091 ~~LT~~ RT
~~15+107 RT TO 15+105 RT.~~

PORTLAND CEMENT CONCRETE SIDEWALK, 1530MM
047 15+~~051~~ TO 15+091 LT
15+095 TO 15+120 LT

TRANSPLANTING TREES
15+046.6 RT 50 SM+/-
15+047.9 RT 50 SM+/-
(FINAL LOCATION WILL BE AT A MUTUALLY AGREED UPON LOCATION BETWEEN THE ENGINEER AND PROPERTY OWNER)

N
MAGNETIC 1983

CURVE #32
Δ 14° 35' 45" RT
R 700.000 M
L 178.323 M
T 89.647 M
E 5.717 M
B 3.000%

STA. 15+000
BEGIN APPROACH

PI ah 14+978.362 =
ah 14+977.390

STA. 15+034
BEGIN PROJECT
STP030I(18)

FARMLAND

GARAGE AND BARN

1½SWF HOUSE

STA ah 15+051 LT
CONSTRUCT SIDEWALK RAMP TYPE I

STA ah 15+095 LT
CONSTRUCT TYPICAL DRIVE WITH 1530 SIDEWALK ADJACENT TO VERTICAL GRANITE CURB IN ACCORDANCE WITH STANDARD C-2AM

STA ah 15+091 LT
CONSTRUCT TYPICAL DRIVE WITH 1530 SIDEWALK ADJACENT TO VERTICAL GRANITE CURB IN ACCORDANCE WITH STANDARD C-2AM

STA ah 15+098 ~ STA ah 15+124 LT
NEW 150mm X 24M UNDERDRAIN W/ F.B. @ 15+098 LT.

MOBILE HOME

1½SWF HO.

MATCHLINE

AERIAL E&T

COLD PLANING AREA

ah 15+000

ah 15+020

ah 15+040

ah 15+060

ah 15+080

ah 15+100

N65° 36' 37" E
71.944

CZ

4.4M

3.6M

3m

REMOVE & RESET

APPROX. LEACH FIELD LOCATION

DRY WELL

3.0M

600 MPL SAVE

600 MPL

450 MPL

150 MPL

150 BAL

150 SPR

MB

MBC

GUY

STA ah 15+032 ~ STA ah 15+046.5 RT
NEW 450mm X 13M (PCCSP 1453) X 16M UNDERDRAIN PLUG PIPE & UNDERDRAIN FOR FUTURE USE @ ST. 15+032 RT.

STA ah 15+048 ~ STA ah 15+061 RT
REMOVE EXISTING DRIVE CULVERT
REMOVE WITH COMMON

STA ah 15+046.5 ~ STA ah 15+098 RT
NEW 450mm X 5M OPTION PIPE W/ CB @ INLET & OUTLET

STA ah 15+048 ~ STA ah 15+098 RT
NEW 150mm X 5M UNDERDRAIN W/ FB @ STA ah 15+048 RT

STA ah 15+100 TO STA ah 15+106 RT
REMOVE EXISTING 380mm ACCGMP
REMOVE WITH COMMON

0 5 10 15
1:250

○ DENOTES TREE OR STUMP REMOVAL

ALL DRIVE RADII SHALL BE 6M UNLESS OTHERWISE NOTED PER STD B-71M

LAYOUT SHEET

PROJECT NAME:	FRANKLIN
PROJECT NUMBER:	STP 030I(18)
FILE NAME:	85c060/design/2bdr.dgn
PROJECT LEADER:	DELLASANTA
DESIGNED BY:	SQUAD B
IPARM FILE NAME:	(2)dc060101.i
PLOT DATE:	24-MAR-2003
DRAWN BY:	SQUAD B
CHECKED BY:	SQUAD B
SHEET	17 OF 60

Metric

VERTICAL GRANITE CURB

15+120.0 TO 15+~~125.2~~ LT
15+120.0 TO 15+~~158.7~~ RT 157.2
15+128.6 TO 15+133.9 LT 133.5
140.4 15+~~136.0~~ TO 15+~~175.7~~ LT 174.8
15+~~161.8~~ TO 15+~~164.9~~ RT
168.1 15+~~168.8~~ TO 15+191.8 RT 189.6
180.2 15+~~178.4~~ TO 15+~~187.7~~ LT 193
15+195.2 TO 15+~~216.9~~ RT 214.5
003.9 SL 26+~~000.1~~ TO SL 26+037.3 LT 037.1
036.5 SL 26+~~036.9~~ TO SL 26+~~047.4~~ RT 641.3
~~SL 26+024.4 RT TO ML 15+212.4 LT~~
219.6 15+~~214.4~~ TO 15+~~266.1~~ LT 263.7
220.9 15+~~218.7~~ TO 15+~~260.8~~ RT 259.0
265.6 15+~~265.5~~ TO 15+300.0 RT
271.5 15+~~270.4~~ TO 15+300.0 LT
SL 26+005.0 TO 26+025.0 RT

RELOCATE MAIL BOX, SINGLE SUPPORT

15+140 RT 2
15+158 RT
15+210 RT
15+257 RT
15+260 RT
~~15+132 LT TO 15+131~~
~~15+196 RT TO 15+194.7~~
~~SL 26+038 RT~~
~~SL 26+045 RT~~

REMOVING AND RESETTING FENCE
~~15+194 TO 15+197 LT~~

TRANSPLANTING SHRUBS
~~15+158.6 LT - LILAC BUSH~~
(FINAL LOCATION WILL BE AT A MUTUALLY AGREED UPON LOCATION BETWEEN THE ENGINEER AND PROPERTY OWNER

STA ah 15+025 LT AND STA ah 15+029 LT
CONSTRUCT TYPICAL DRIVE WITH 1530 SIDEWALK ADJACENT TO VERTICAL GRANITE CURB IN ACCORDANCE WITH STANDARD C-2AM

STA ah 15+175 LT AND STA ah 15+179 LT
STA ah 15+039 LT AND STA ah 15+033 LT
CONSTRUCT TYPICAL DRIVE WITH 1530 SIDEWALK ADJACENT TO VERTICAL GRANITE CURB IN ACCORDANCE WITH STANDARD C-2AM

STA ah 15+196 LT
CONSTRUCT SIDEWALK RAMP TYPE I

TH #16 STA. 26+060.000
END CONSTRUCTION
CONSTRUCT SATISFACTORY APPROACH

PORTLAND CEMENT CONCRETE WALK

224 15+~~227~~ RT (6.0M BACK)
224 15+~~227~~ LT (2.0M BACK)
155 15+~~154~~ LT 3M BACK

PORTLAND CEMENT CONCRETE SIDEWALK, 1530MM

195 15+~~212~~ TO 15+300 LT

CELLAR DRAIN SHALL BE ADJUSTED AS DIRECTED BY THE RESIDENT ENGINEER TO DRAIN INTO NEW UNDERDRAIN

15+204 RT 26+013 RT 15+044 RT
15+231 RT 15+158 LT 15+178 RT
15+255 RT 15+158 RT

REMOVE & RESET PROPERTY MARKER
~~15+242.0 LT~~

REMOVE EXISTING SIDEWALK
15+154.250 (8.9M BACK) LT
15+226.970 (6.0M BACK) LT
15+226.570 (6.0M BACK) RT
15+210.150 TO 15+261.140 LT

STA ah 15+216 LT
CONSTRUCT SIDEWALK RAMP TYPE I

STA ah 15+246 LT AND STA ah 15+261 LT
CONSTRUCT TYPICAL DRIVE WITH 1530 SIDEWALK ADJACENT TO VERTICAL GRANITE CURB IN ACCORDANCE WITH STANDARD C-2AM

STEEL BEAM GUARD RAIL

219 15+~~277~~ LT TO 15+~~295~~ RT 294
272 15+~~275~~ RT TO 15+~~290~~ RT 291

CONSTRUCT DRIVE

15+127 LT GRAVEL
15+136 LT GRAVEL
15+160.3 RT PAVED
15+168 RT PAVED
15+177 LT GRAVEL
15+194 RT GRAVEL
15+218 RT PAVED
15+264 RT PAVED
15+268 LT GRAVEL
TH #16 STA 26+031 RT GRAVEL
TH #16 STA 26+043 LT GRAVEL
TH #16 STA 26+050 RT GRAVEL

STONE FILL TYPE II
15+278 TO 15+280 RT
15+281.5 TO 15+283.5 RT

PI ah 15+287.269 =
ah 15+287.084

CURVE #33
Δ 08° 41' 50" RT
R 635.000 M
L 96.391 M
T 48.288 M
E 1.833 M
SS 3.300%

N16° 29' 07" W

N65° 36' 37" E
171.944

TH #3 CONST. ℄ P.O.T. AH 15+203.980 =
TH #16 P.O.T. 26+000.000
ASKEW = 82° 01' 44" LT

BM #28
N.E. COR. OF BOT. CONC. STEP
ELEV. 137.380 m

0 5 10 15
1:250

○ DENOTES TREE OR STUMP REMOVAL

ALL DRIVE RADII SHALL BE 6M UNLESS OTHERWISE NOTED PER STD B-71M

LAYOUT SHEET

PROJECT NAME:	FRANKLIN
PROJECT NUMBER:	STP 030(18)
FILE NAME:	85c060/design/2bdr.dgn
PROJECT LEADER:	DELLASANTA
DESIGNED BY:	SQUAD B
IPARM FILE NAME:	(2)dc060102.1
PLOT DATE:	18-APR-2003
DRAWN BY:	SQUAD B
CHECKED BY:	SQUAD B
SHEET	18 OF 60

Metric

VERTICAL GRANITE CURB

15+300.0 TO 15+~~328.8~~ LT 324.1
15+300.0 TO 15+~~313.8~~ RT 312.2
318.1 15+~~317.1~~ TO 15+~~336.0~~ RT 334.3
15+317.9 TO 15+338.6 LT 356.4
344.0 15+~~322.5~~ TO 15+~~357.4~~ RT 376.0
~~15+341.4 TO 15+410.1 LT~~
15+380.6 TO 15+~~398.2~~ RT 395.9
402.5 15+~~401.5~~ TO 15+408.6 RT 408.1
15+413.9 TO 15+454.7 LT
424.3 15+~~423.2~~ TO 15+458.9 RT 458.0
15+36.25 TO 15+408.7 LT

CONSTRUCT DRIVE

15+316 RT GRAVEL
15+333 LT GRAVEL
15+339 RT GRAVEL
15+360 LT GRAVEL
15+379 RT GRAVEL
15+400 RT GRAVEL
15+412 LT GRAVEL
15+416 RT GRAVEL

PORTLAND CEMENT CONCRETE SIDEWALK, 1530MM

15+300 TO 15+~~451~~ LT 454

PORTLAND CEMENT CONCRETE WALK

15+338 TO 15+343 LT (BACK 4.6 M)
15+349 RT 3M BACK
~~15+391 RT 4.6M BACK~~

REMOVAL OF EXISTING SIDEWALK

15+363.830 TO 15+455.220 LT

TRANSPLANTING SHRUBS

~~15+339 LT ROSE BUSHES~~
~~15+341 LT ROSE BUSHES~~
FINAL LOCATION WILL BE AT A MUTUALLY AGREED APON LOCATION BETWEEN THE ENGINEER AND THE PROPERTY OWNER

REMOVING AND RESETTING FENCE

~~15+305 TO 15+323 LT~~
~~15+366 TO 15+368 RT~~

STA ch 15+358 LT AND STA ch 15+362 LT
CONSTRUCT NON-COMMERCIAL
DRIVE WITH GRASS PLOT AND
VERTICAL GRANITE CURB

STA ch 15+414 LT AND STA ch 15+409 LT
CONSTRUCT NON-COMMERCIAL
DRIVE WITH GRASS PLOT AND
VERTICAL GRANITE CURB

APPROXIMATE: STA ch 15+370.5 LT ~ STA ch 15+372.5 LT
1.8M CURB CUT

STA ch 15+227 LT AND STA ch 15+239 LT
CONSTRUCT NON-COMMERCIAL
DRIVE WITH GRASS PLOT AND
VERTICAL GRANITE CURB

N 74°18'27" E
128.767

TO CANADA

TO SHELDON

PROFILE OF WALK MAY NEED TO BE ADJUSTED AS DIRECTED BY RESIDENT ENGINEER

0 5 10 15
1:250

○ DENOTES TREE OR STUMP REMOVAL

ALL DRIVE RADII SHALL BE 9M UNLESS OTHERWISE NOTED PER STD B-71M

STA. 15+464.139
END PROJECT
STP0301(18)

TH#3 & P.O.T. ch 15+464.139
ROUTE 120 P.O.T. 304+095.461
END PROJECT

STA ch 15+461.70
MATCH EXISTING PAVEMENT

LAYOUT SHEET

PROJECT NAME:	FRANKLIN
PROJECT NUMBER:	STP 0301(18)

FILE NAME:	85c060/design/2bdr.dgn	PLOT DATE:	24-MAR-2003
PROJECT LEADER:	DELLASANTA	DRAWN BY:	SQUAD B
DESIGNED BY:	SQUAD B	CHECKED BY:	SQUAD B
IPARM FILE NAME:	(2)dc06013.I	SHEET	19 OF 60

Metric

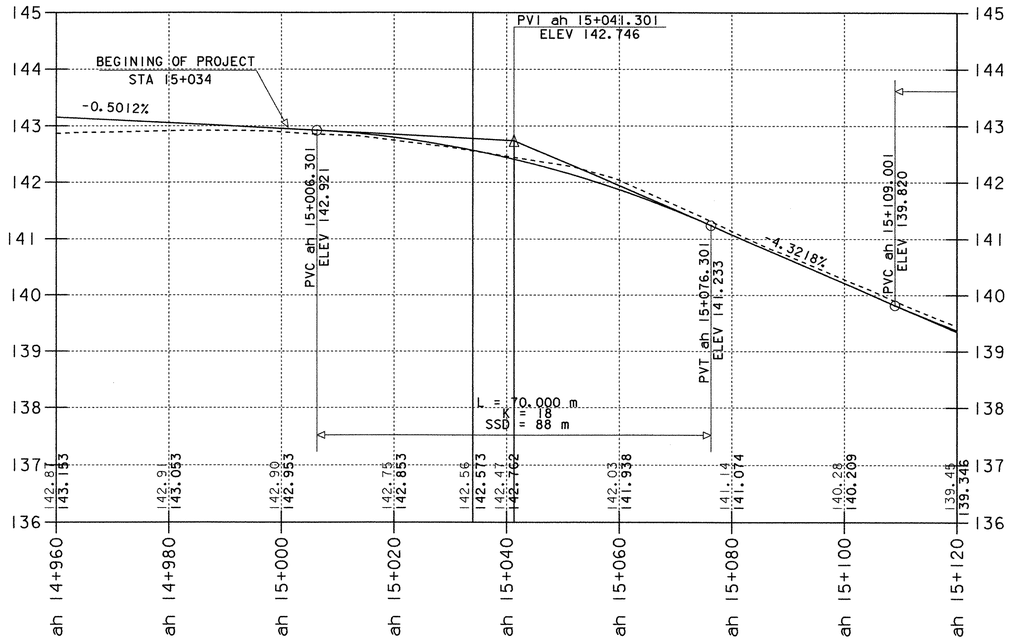

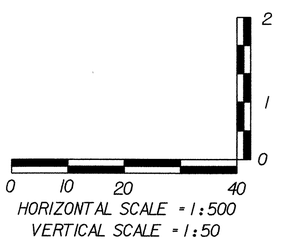

HORIZONTAL SCALE = 1:500
VERTICAL SCALE = 1:50

PROJECT NAME: FRANKLIN	
PROJECT NUMBER: STP 0301(18)	
FILE NAME: ...85c060/design/dc060xsl.dgn	PLOT DATE: 24-MAR-2003
PROJECT LEADER: DELLASANTA	DRAWN BY: SQUAD B
DESIGNED BY: SQUAD B	CHECKED BY: SQUAD B
IPARM FILE NAME: (2)dc060p01.i	SHEET 20 OF 60

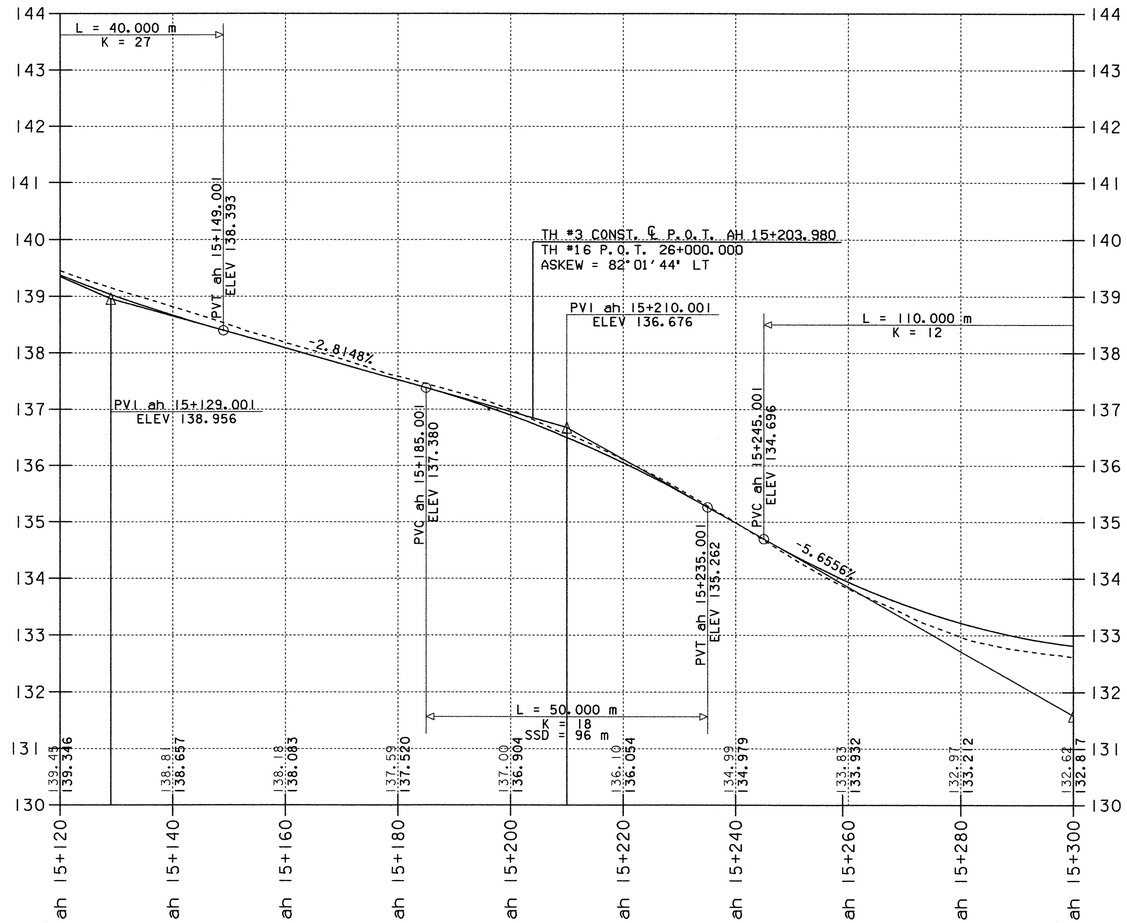

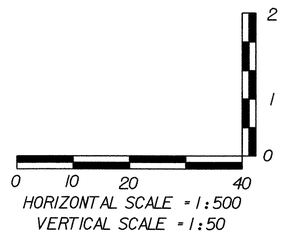

PROJECT NAME:	FRANKLIN
PROJECT NUMBER:	STP 0301(18)
FILE NAME: ...85c060/design/dc060xsl.dgn	PLOT DATE: 24-MAR-2003
PROJECT LEADER: DELLASANTA	DRAWN BY: SQUAD B
DESIGNED BY: SQUAD B	CHECKED BY: SQUAD B
IPARM FILE NAME: (2)dc060p02.i	SHEET 21 OF 60

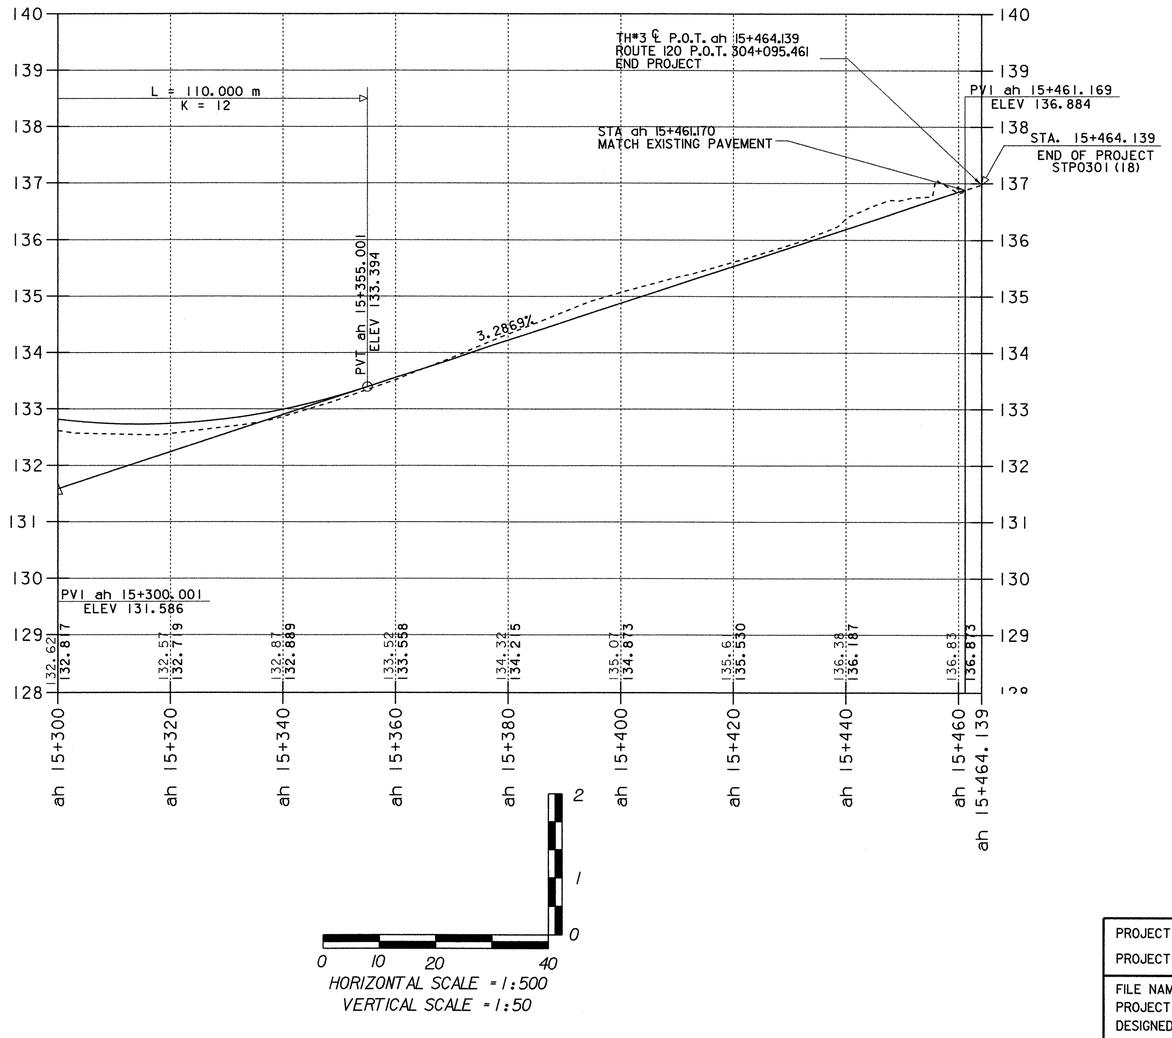

PROJECT NAME:	FRANKLIN
PROJECT NUMBER:	STP 0301(18)
FILE NAME: ...85c060/design/dc060xsl.dgn	PLOT DATE: 24-MAR-2003
PROJECT LEADER: DELLASANTA	DRAWN BY: SQUAD B
DESIGNED BY: SQUAD B	CHECKED BY: SQUAD B
IPARM FILE NAME: (2)dc060p03.I	SHEET 22 OF 60


TH #16 PROFILE

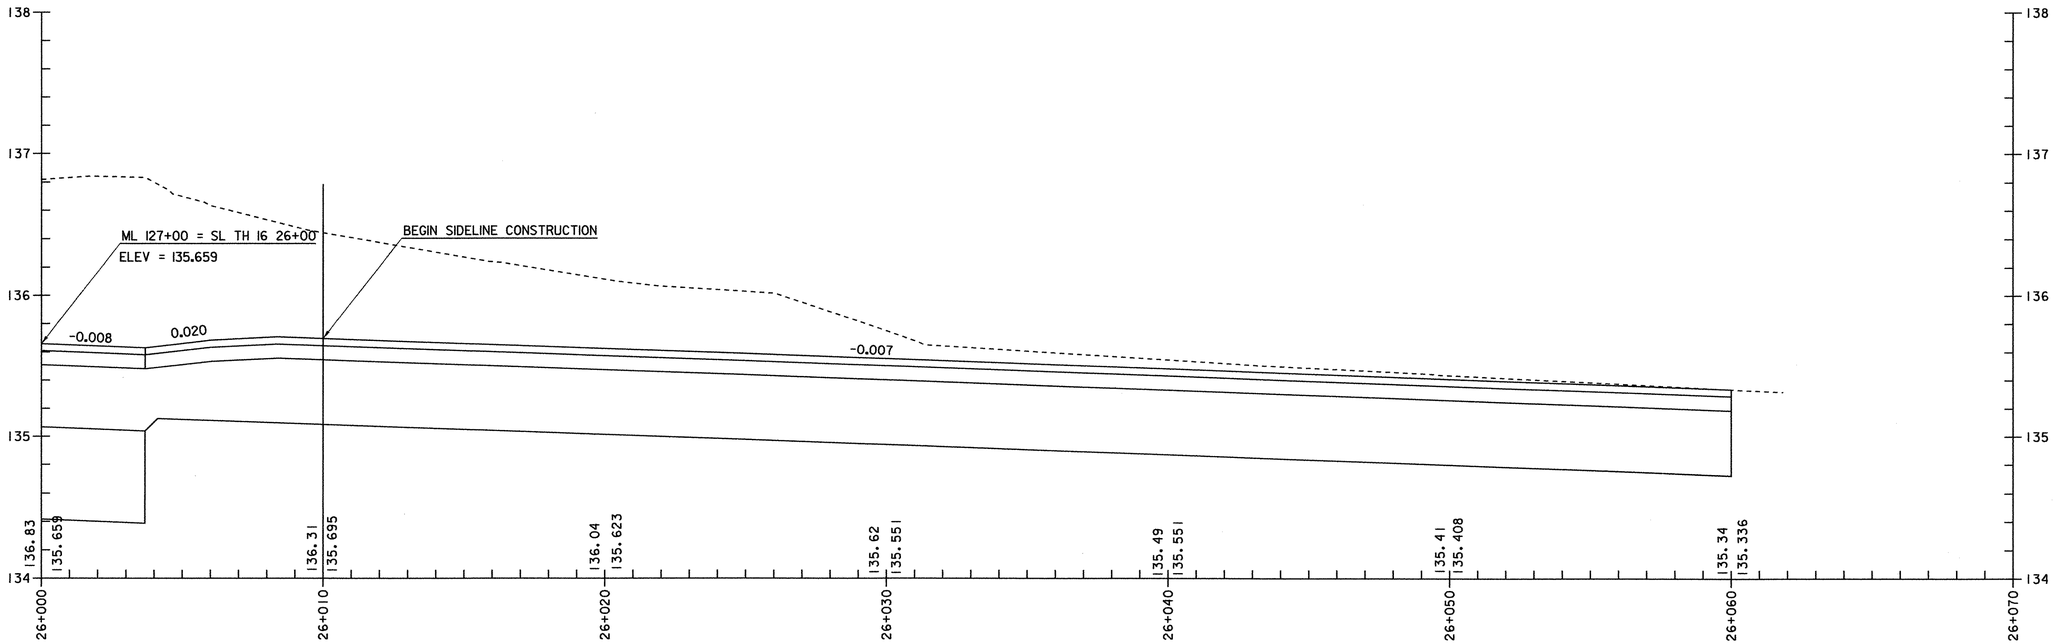

0 2 4 6 8 10
SCALE 1:100

PROJECT NAME: FRANKLIN	
PROJECT NUMBER: STP 0301(18)	
FILE NAME: ...85c060\design\dc060x12.dgn	PLOT DATE: 20-MAR-2003
PROJECT LEADER: DELLASANTA	DRAWN BY: SQUAD B
DESIGNED BY: SQUAD B	CHECKED BY: SQUAD B
IPARM FILE NAME: (2)dc060p04.I	SHEET 23 OF 60

MAINLINE STA. ah 15+282.18
CHANNEL LINE STA. 110+000.00
ASKEW 85°-18'-53" FROM
TANGENT TO CURVE

N15° 48' 22.8"W

110+000

ah 15+260

ah 15+280

ah 15+300

TYPE II
STONEFILL

109+990

109+985

APPROXIMATE LOCATION OF
EXISTING UNDERGROUND WATERLINE
SEE GENERAL NOTE 2

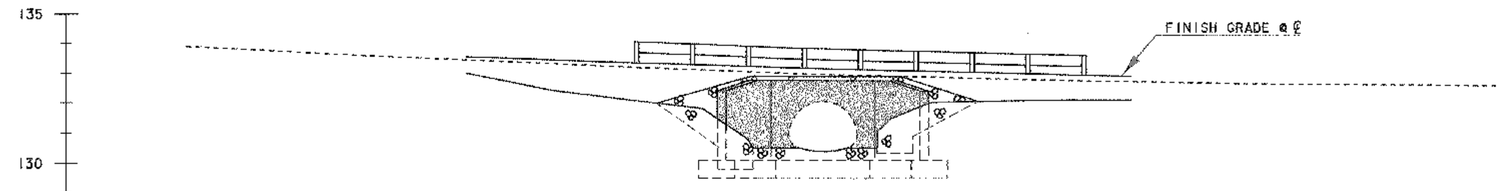

ELEVATION VIEW

0 2 4 6 8 10
SCALE 1:100

PLAN AND ELEVATION SHEET

PROJECT NAME: FRANKLIN
PROJECT NUMBER: STP 030I(18)

FILE NAME: /85c060/str/sc85c060bdr.dg
PROJECT LEADER: S. FARNSWORTH
DESIGNED BY: M. FOWLER
sc060pel5282.i

PLOT DATE: 21-MAR-2003
DRAWN BY: R. PELLETT
CHECKED BY: G. SPILAK
SHEET 24 OF 60

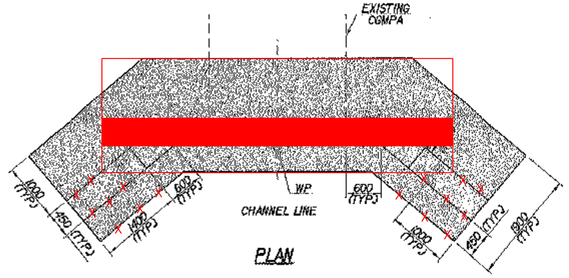

PLAN

• CHANGE TO STRAIGHTEN HEADWALL BECAUSE OF WATERLINE CONFLICT

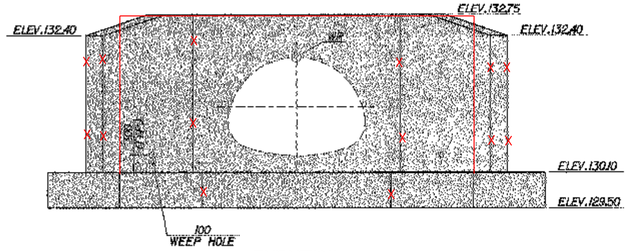

ELEVATION

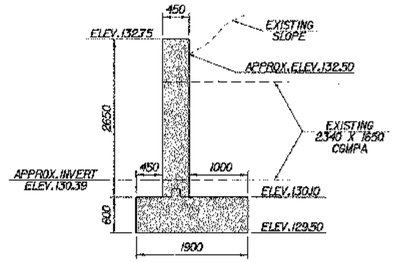

SECTION @ ℄ CGMPA AND MIDPOINT OF HEADWALL

1- ROW GALVANIZED ANCHOR BOLTS SPACED IN ALTERNATE CIRCUMFERENTIAL SEAM HOLES (ACTUAL ANCHOR BOLT SPACING TO BE DETERMINED IN THE FIELD. THE COST OF ALL WORK AND MATERIALS ASSOCIATED WITH THE INSTALLATION OF THE ANCHOR BOLTS SHALL BE INCLUDED IN THE COST OF CONCRETE, HIGH PERFORMANCE CLASS B.

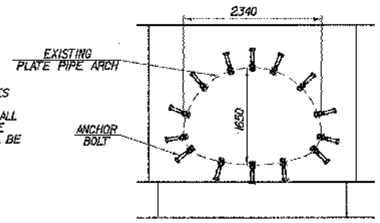

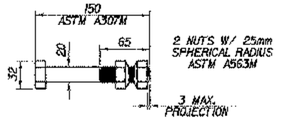

ANCHOR BOLT DETAIL

(NOT TO SCALE)

HEADWALL DETAILS

0 1 2 3 4 5

SCALE = 1:50

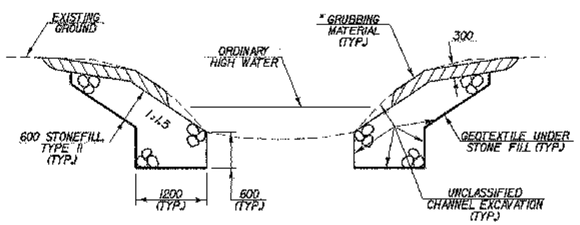

TYPICAL CHANNEL SECTION

(NOT TO SCALE)

* GRUBBING MATERIAL SHALL NOT BE PLACED ON THE STONE FILL FROM THE END WINGWALLS TO CGMPA INLET. WHENEVER CHANNEL SLOPE INTERSECTS ROADWAY SUBBASE, GRUBBING MATERIAL SHALL BEGIN AT THE BOTTOM OF SUBBASE.

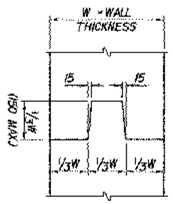

TYPICAL CONCRETE CONSTRUCTION JOINT

NOT TO SCALE

GENERAL NOTES

1) ALL MATERIALS AND CONSTRUCTION SHALL CONFORM TO AGENCY OF TRANSPORTATION STANDARD SPECIFICATIONS DATED 2001, AND THE LATEST AASHTO STANDARD SPECIFICATIONS FOR HIGHWAY BRIDGES.

2) THE APPROXIMATE HORIZONTAL LOCATION OF AN EXISTING FRANKLIN VILLAGE WATERLINE IS SHOWN ON THE PLANS WITHIN THE PROPOSED CONSTRUCTION AREA OF THE HEADWALL. THERE HAS BEEN NO VERIFICATION OF THE LOCATION, EITHER HORIZONTALLY OR VERTICALLY, ASSOCIATED WITH THIS WATERLINE CROSSING AND IT HAS BEEN ASSUMED THERE WILL BE NO CONFLICT WITH THE PROPOSED FOOTING ELEVATION. IF DURING CONSTRUCTION IT IS FOUND THIS ASSUMPTION IS INCORRECT THE PROJECT MANAGER SHALL BE CONTACTED IMMEDIATELY WITH ALL PERTINENT DETAILS TO DETERMINE AN APPROPRIATE COURSE OF ACTION. ITEMS HAVE BEEN INCLUDED ON THE CONTRACT TO RELOCATE THE WATERLINE IF RELOCATION IS DETERMINED TO BE THE ONLY VIABLE OPTION.

3) IN-STREAM CONSTRUCTION SHALL BE RESTRICTED TO JUNE 1 TO OCTOBER 1, UNLESS THE CONTRACTOR OBTAINS WRITTEN PERMISSION FROM THE AGENCY OF NATURAL RESOURCES TO DO WORK OUTSIDE OF THAT TIME FRAME.

4) THE CONTRACTOR SHALL TAKE ALL PRECAUTIONS NECESSARY TO PREVENT SILTATION OR POLLUTION, ESPECIALLY THE DISCHARGE OF RAW CONCRETE, INTO ANY BROOK, STREAM, OR RIVER.

5) WHEN CONSTRUCTION MACINERY IS WORKING OVER THE EXISTING PIPE, THE CONTRACTOR SHALL MAINTAIN A MINIMUM COVER OF 1000 mm OF COMPACTED MATERIAL.

6) LIMITS OF THE COFFERDAM SHALL BE DETERMINED BY THE CONTRACTOR. PAY LIMITS FOR COFFERDAM EXCAVATION, EARTH AND COFFERDAM EXCAVATION, ROCK SHALL BE 600 mm OUTSIDE THE PERIMETER OF THE FOOTING. IF A COFFERDAM IS CONSTRUCTED WHICH IS LARGER THAN THE COFFERDAM EXCAVATION PAY LIMITS, PAYMENT FOR ALL UNCLASSIFIED CHANNEL EXCAVATION, INCLUDING THAT PORTION WHICH IS INSIDE THE COFFERDAM BUT OUTSIDE THE COFFERDAM EXCAVATION PAY LIMITS, WILL BE MADE AT THE CONTRACT UNIT PRICE FOR UNCLASSIFIED CHANNEL EXCAVATION.

7) ITEM 208.30, COFFERDAM SHALL INCLUDE ALL NECESSARY WORK REQUIRED TO SAFELY CONSTRUCT THE FOUNDATION, FOOTING HEADWALL, AND WINGWALLS IN THE DRY. ANY AND ALL WORK ASSOCIATED WITH THE TEMPORARY WATER DIVERSION REQUIRED DURING CONSTRUCTION SHALL BE INCLUDED IN THE COST OF THIS ITEM. THE CONTRACTOR SHALL SUBMIT A CONSTRUCTION SEQUENCE AND EROSION CONTROL PLAN BEFORE WORK MAY BEGIN.

8) THE FOLLOWING TABLE OF ALLOWABLE STRESSES AND WEIGHTS APPLY TO THESE PLANS FOR DESIGN PURPOSES:

CONCRETE, HIGH PERFORMANCE CLASS B: f'c = 25 MPa fc = 10 MPa

REINFORCING STEEL: Ft = 166 MPa GRADE 420
SOIL UNIT WEIGHT: 2250 kg/m3

DESIGN LOAD FOR SPREAD FOOTINGS ON SOIL: 190 KPa

9) THE KEY IN CONCRETE CONSTRUCTION JOINTS SHALL BE MONOLITHIC AND CONTINUOUS FOR THE FULL LENGTH OF THE JOINT, ANY UPWARD KEY SHALL BE PLACED INTEGRALLY WITH THE CONCRETE BELOW THE JOINT.

10) ALL EXPOSED EDGES OF CONCRETE SHALL BE CHAMFERED 25mm BY 25mm.

11) JOINTS AND SCORE MARKS IN CONCRETE SHALL BE CONSTRUCTED AS INDICATED ON THE PLANS OR AS DIRECTED BY THE ENGINEER.

12) ALL REINFORCING STEEL SHALL BE DETAILED AND FABRICATED USING PROCEDURES AND TOLERANCES IN ACCORDANCE WITH APPLICABLE PUBLICATIONS OF THE CONCRETE REINFORCING STEEL INSTITUTE (CRSI).

REINFORCING PLACEMENT TOLERANCES SHALL BE:
SPACING +/- 25 mm
CLEARANCE +/- 5 MM

13) MINIMUM COVER FOR REINFORCING STEEL SHALL BE FIFTY (50) MILLIMETERS ALONG THE BACK FACES OF WALLS AGAINST EARTH, AND EIGHTY (80) MILLIMETERS ELSEWHERE, UNLESS OTHERWISE NOTED.

14) IT IS THE RESPONSIBILITY OF THE CONTRACTOR TO VERIFY IN THE FIELD ALL EXISTING DIMENSIONS IN THE PLANS. ALL DIMENSIONS ARE HORIZONTAL OR VERTICAL AND ARE GIVEN AT 20 DEGREES CELSIUS UNLESS OTHERWISE NOTED.

HYDRAULIC DATA

DRAINAGE AREA = 360 HA	DESIGN FLOW = Q25	
DESIGN TAILWATER DEPTH = 1.6 M	ELEVATION = 132.0	
ORDINARY HIGH WATER DEPTH = 0.5 M +/-		
Q 2.33 FLOW = 2.1 CM/S	HEADWATER ELEVATION = 131.3	
Q 10 FLOW = 4.1 CM/S	HEADWATER ELEVATION = 131.7	
Q 25 FLOW = 5.2 CM/S	HEADWATER ELEVATION = 132.0	
Q 50 FLOW = 6.4 CM/S	HEADWATER ELEVATION = 132.2	
Q100 FLOW = 7.2 CM/S	HEADWATER ELEVATION = 132.4	

COMMENTS: DEPTHS ARE APPROXIMATE BASED ON INLET CONTROL ANALYSIS.

ESTIMATED QUANTITIES

NO.	ITEM	UNIT	TOTAL	FINAL
203.27	UNCLASSIFIED CHANNEL EXCAVATION	CM	10	23
204.30	GRANULAR BACKFILL FOR STRUCTURES	CM	55	43.1
208.30	COFFERDAM EXCAVATION, EARTH	CM	70	52
208.35	COFFERDAM EXCAVATION, ROCK	CM	5	4.5
208.40	COFFERDAM	LS	1	1
501.34	CONCRETE, HIGH PERFORMANCE CLASS B	CM	18	15.13
507.15	REINFORCING STEEL	KG	1300	1266
514.10	WATER REPELLENT	L	6	6
613.11	STONE FILL, TYPE II	CM	21	23
649.31	GEOTEXTILE UNDER STONE FILL	SM	40	38
651.40	GRUBBING MATERIAL	SM	25	25

PROJECT NAME: FRANKLIN
PROJECT NUMBER: STP 0301(18)

FILE NAME: /str/85c060/s85c060ww.dgn
PROJECT LEADER: S. FARNSWORTH
DESIGNED BY: M. FOWLER
sc060ww15282.1

PLOT DATE: 21-MAR-2003
DRAWN BY: R. PELLETT
CHECKED BY: G. SPILAK
SHEET 25 OF 60

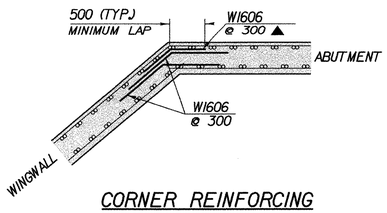

CORNER REINFORCING DETAIL

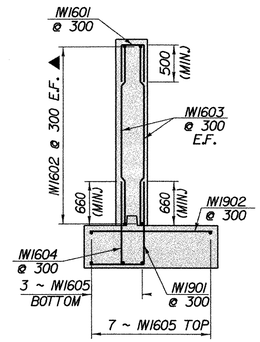

TYPICAL SECTION REINFORCING

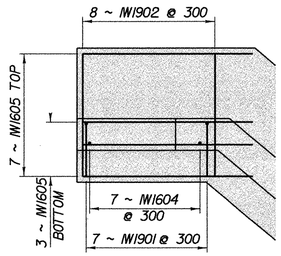

WINGWALL REINFORCING PLAN (TYPICAL)

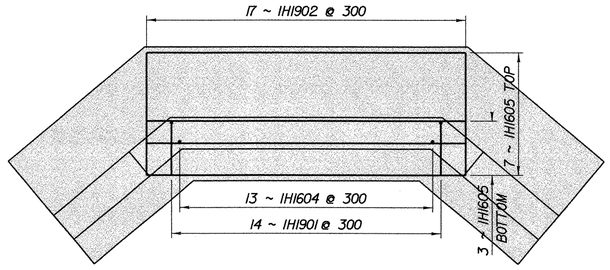

HEADWALL REINFORCING PLAN

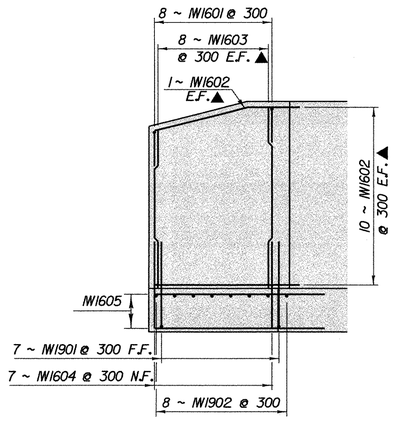

WINGWALL REINFORCING ELEVATION (TYPICAL)

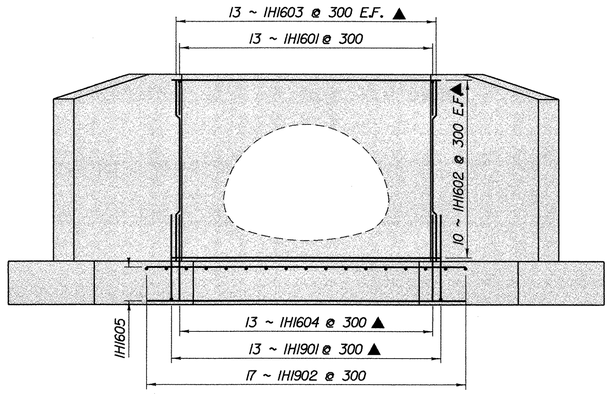

HEADWALL REINFORCING ELEVATION

REINFORCING STEEL NOTES

1. UNLESS OTHERWISE DESIGNATED, ALL BAR REINFORCEMENT FOR CONCRETE IN SIZES UP TO AND INCLUDING 55M SHALL CONFROM TO THE REQUIREMENT OF THE "SPECIFICATIONS FOR DEFORMED BILLET-STEEL BARS FOR CONCRETE REINFORCEMENT", AASHTO M 31M (ASTM A 615M-SI). ALL BARS SHALL BE GRADE 420, UNLESS OTHERWISE DESIGNATED.
2. FOR TYPICAL BENDING DETAILS, RECOMMENDED PIN DIAMETER "D" OF BENDS AND HOOKS, AND OTHER STANDARD PRACTICE, SEE CURRENT CONCRETE REINFORCING STEEL INSTITUTE "MANUAL OF STANDARD PRACTICE".
3. "J" DIMENSION ON 180 DEGREE HOOKS ARE TO BE SHOWN ONLY WHEN NECESSARY TO RESTRICT HOOK SIZE. OTHERWISE, STANDARD HOOKS ARE TO BE USED.
4. "H" DIMENSION ON STIRRUPS ARE TO BE SHOWN ONLY WHEN NECCESSARY TO MAINTAIN CLEARANCES.
5. WHERE SLOPE DIFFERS FROM 45 DEGREES, DIMENSIONS "H" AND "K" MUST BE SHOWN.
6. ▲ DENOTES BARS TO BE CUT IN FIELD.

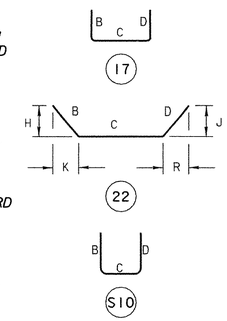

REINFORCING STEEL SCHEDULE

NO. PIECES	SIZE	LENGTH	MARK	TYPE	A	B	C	D	H	J	K	R
58	16	3.83 ▲	W1602	STR	3.83							
50	16	2.57 ▲	W1603	STR	2.57							
27	16	1.21 ▲	W1604	STR	1.21							
30	16	4.53 ▲	W1605	STR	4.53							
33	19	1.74	W1902	STR	1.74							
28	19	1.98 ▲	W1901	17		0.77	1.21	—				
60	16	1.60 ▲	W1606	22		0.80	0.80	—	0.51	—	0.61	—
29	16	1.32	W1601	S10		0.50	0.32	0.50				

* REINFORCING STEEL LENGTHS IN METERS
* CUT BAR LENGTHS REUSED IN APPROPRIATE PLACES

NOTE:

NF = NEAR FACE
FF = FAR FACE
EF = EACH FACE
▲ = CUT TO FIT IN FIELD
75 CLR. UNLESS OTHERWISE SPECIFIED ON THE PLANS.

0 1 2 3 4 5

SCALE = 1:40

REINFORCING DETAIL SHEET

PROJECT NAME: FRANKLIN
PROJECT NUMBER: STP 0301(18)

FILE NAME: /str/85c060/s85c060ww.dgn
PROJECT LEADER: S. FARNSWORTH
DESIGNED BY: M. FOWLER
sc060wrl5282.1

PLOT DATE: 24-MAR-2003
DRAWN BY: R. PELLETT
CHECKED BY: G. SPILAK
SHEET 26 OF 60

Metric

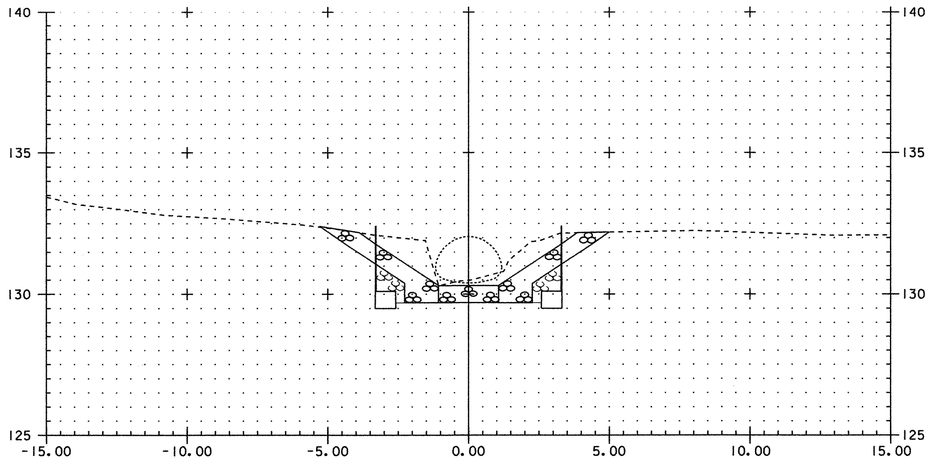

109+992.15

STA 109+992.16 END GRUBBING MATERIAL

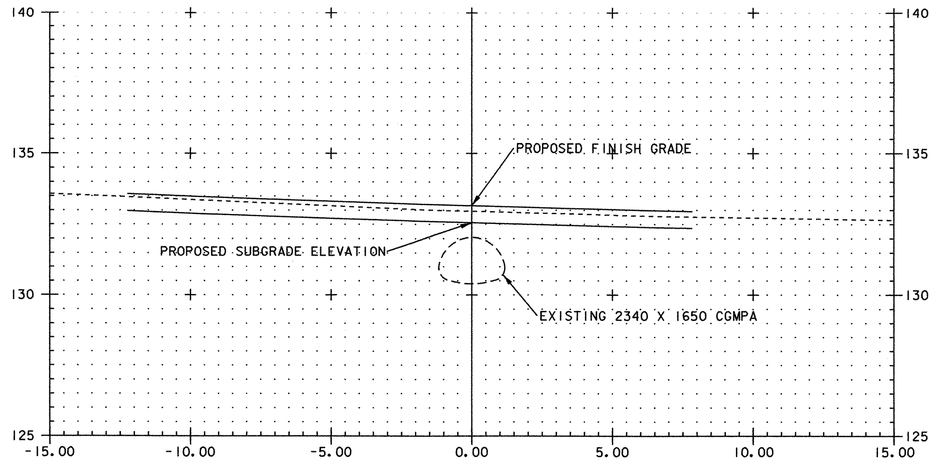

110+000.00

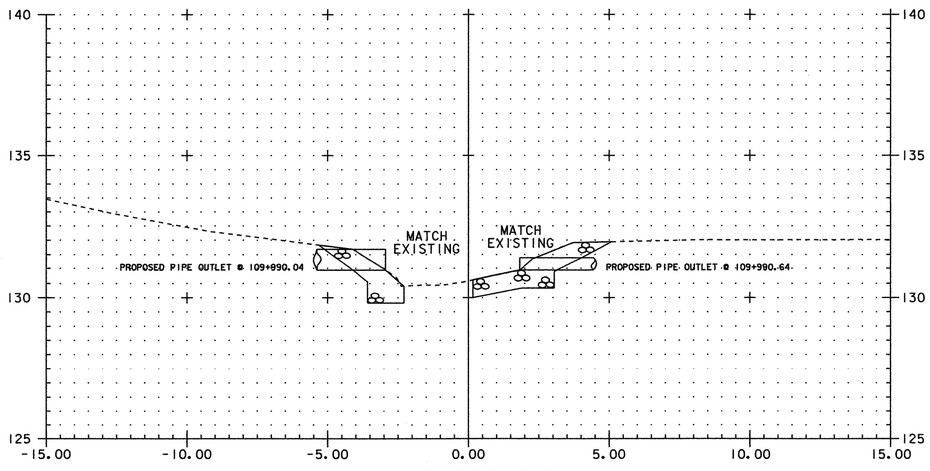

109+990.00

BEGIN TYPE II STONE FILL W/GEOTEXTILE UNDER STONE FILL AND GRUBBING MATERIAL

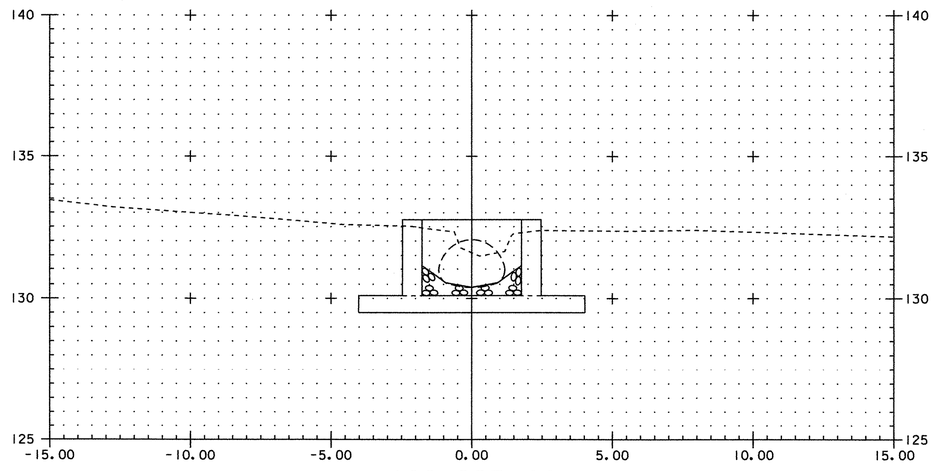

109+993.44

STA 109+993.43 END TYPE II STONE FILL
STA 109+992.98 END GEOTEXTILE UNDER STONE FILL

0 2 4 6 8 10
SCALE 1:100

PIPE STA. 15+282 – CHANNEL SECTIONS

PROJECT NAME: FRANKLIN	
PROJECT NUMBER: STP 0301(18)	
FILE NAME: /85c060/str/s85c060xs.dgn	PLOT DATE: 21-MAR-2003
PROJECT LEADER: S. FARNSWORTH	DRAWN BY: R. PELLETT
DESIGNED BY: M. FOWLER	CHECKED BY: G. SPILAK
sc060xsl5282.i	SHEET 27 OF 60

Metric

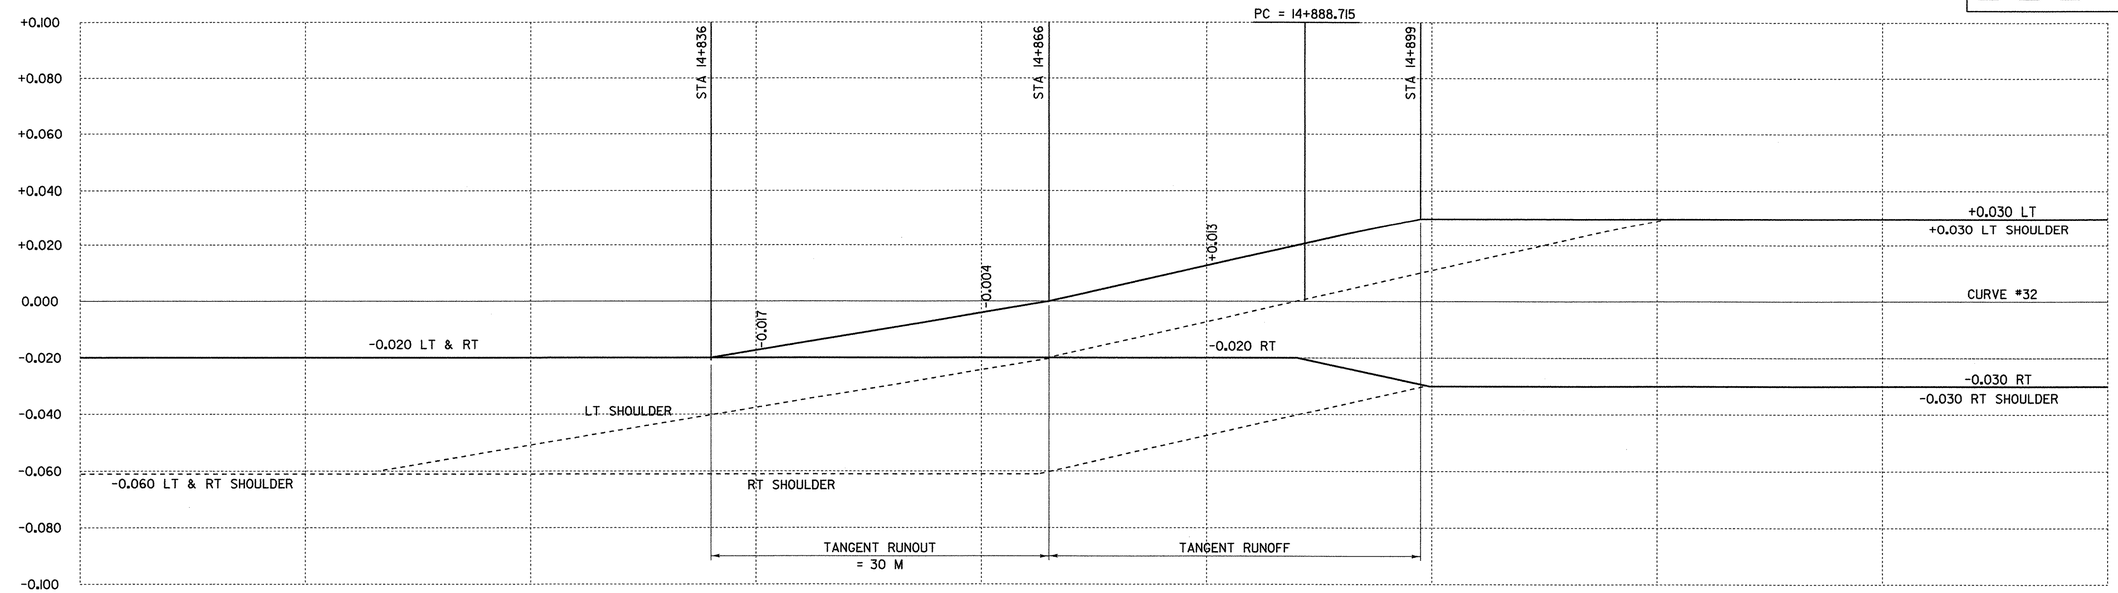

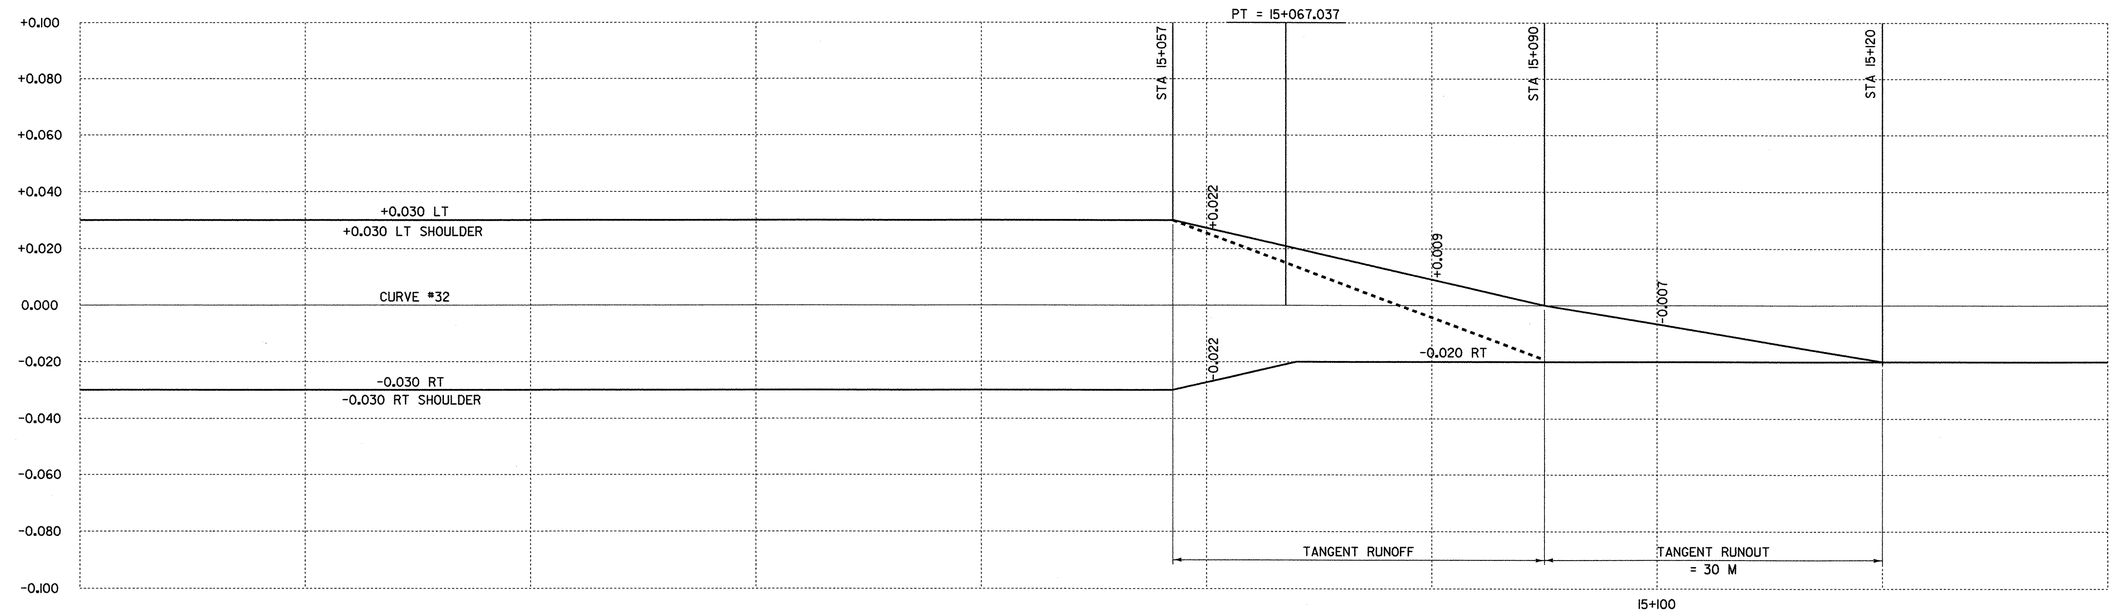

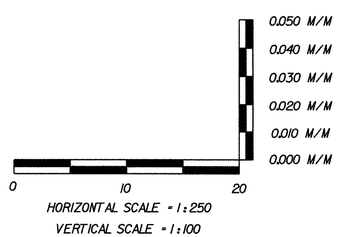

PROJECT NAME:	FRANKLIN
PROJECT NUMBER:	STP 0301(18)
FILE NAME: ...85c060/design/dc060xsl.dgn	PLOT DATE: 31-MAR-2003
PROJECT LEADER: DELLASANTA	DRAWN BY: SQUAD B
DESIGNED BY: SQUAD B	CHECKED BY: SQUAD B
IPARM FILE NAME: dc060b24.i	SHEET 28 OF 60

Metric

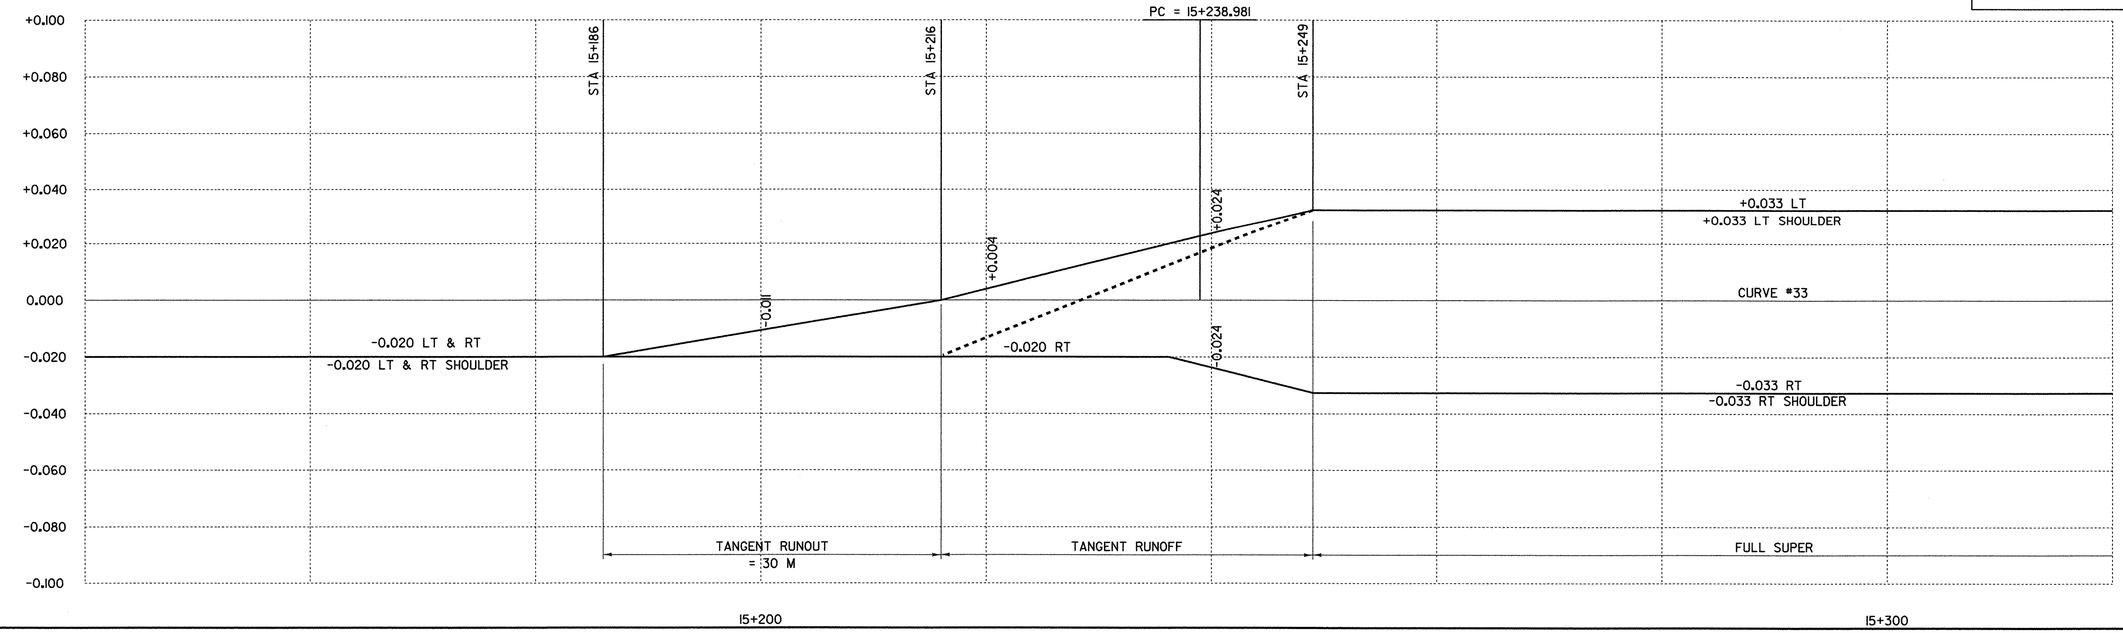

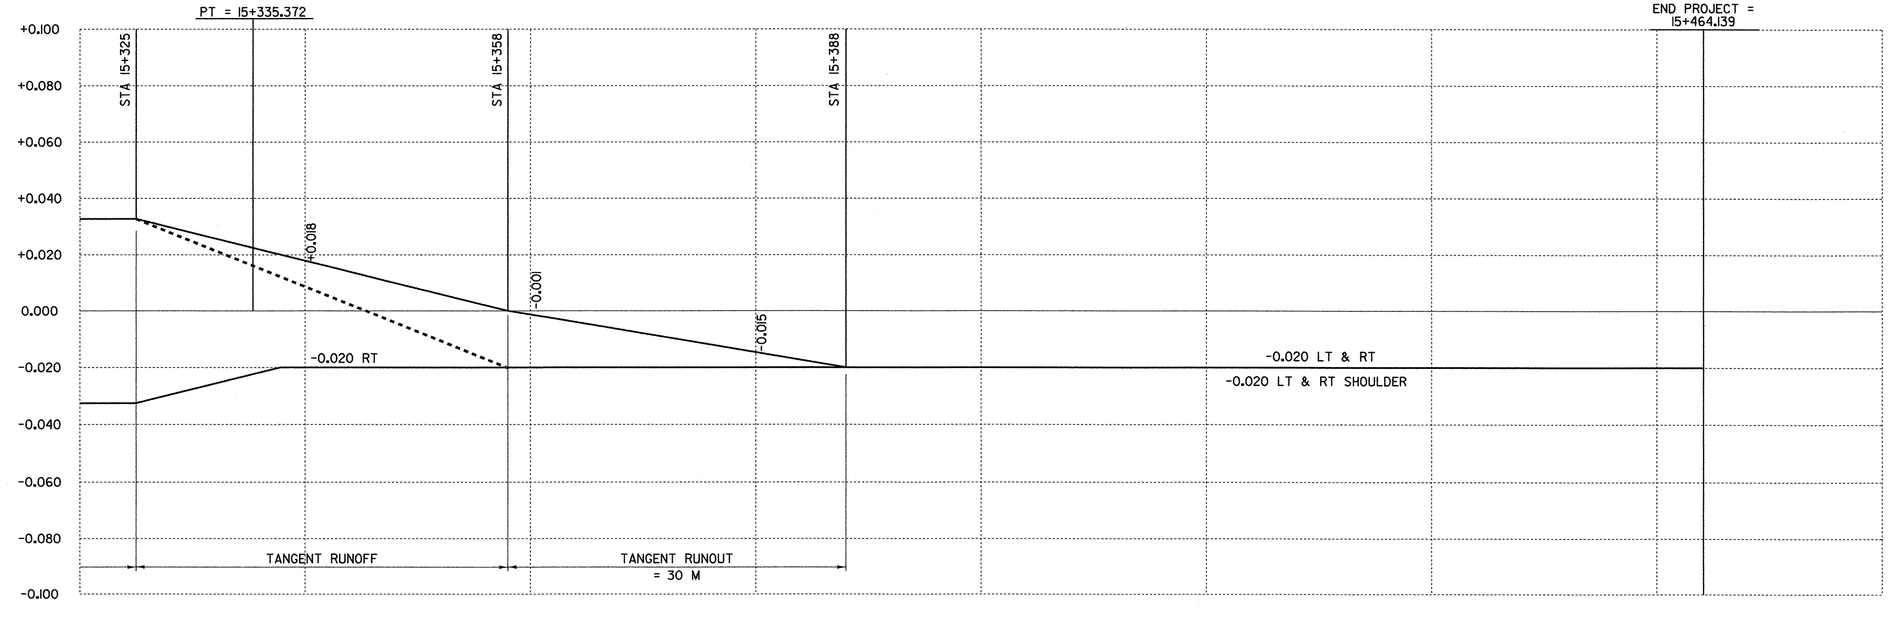

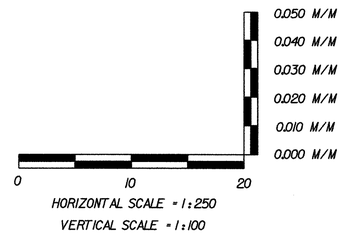

PROJECT NAME: FRANKLIN
PROJECT NUMBER: STP 0301(18)

FILE NAME: ...85c060/design/dc060xsl.dgn
PROJECT LEADER: DELLASANTA
DESIGNED BY: SQUAD B
IPARM FILE NAME: dc060b25.i

PLOT DATE: 31-MAR-2003
DRAWN BY: SQUAD B
CHECKED BY: SQUAD B
SHEET 29 OF 60

EROSION CONTROL LAYOUT


GEOTEXTILE FOR SILT FENCE
ah 15+000 ~ ah 15+023 LT. (25M)

SODDING
ah 15+056 ~ ah 15+090 LT. (31M)
ah 15+096 ~ ah 15+120 LT. (25M)
ah 15+096 ~ ah 15+120 LT. (16M)

NOTES
SODDING SHALL BE APPLIED IMMEDIATELY ON ALL LAWNS DISTURBED BEYOND THE WORK AREA DELINEATED ON THESE PLANS. ALL CONSTRUCTION SHALL BE PERFORMED FROM THE ROADWAY OUT.
OUTSIDE OF THE ROADWAY BOXED EXCAVATION, ALL NEWLY CONSTRUCTED SLOPES (EXCAVATED OR EMBANKMENT) SHALL BE SEALED WITH 5MM THICK TOPSOIL AND MULCHED AT THE END OF EACH WORKDAY IN ACCORDANCE WITH THE SPECIFICATION AND THESE PLANS.

NOTES
EXISTING DRAINAGE SHALL BE UTILIZED AS LONG AS POSSIBLE UNTIL NEW SYSTEM CAN BE PUT INTO SERVICE. NEW CB AND DISTRUCTURES SHALL BE COVERED DURING CONSTRUCTION UNTIL TOPS CAN BE SET AND SYSTEM PUT INTO SERVICE

N

MAGNETIC 1993

CURVE #32
Δ 14° 35' 45" RT
R 700.000 M
L 178.323 M
T 89.647 M
E 5.717 M
B 3.000%

PI ah 14+978.362 =
ah 14+977.390

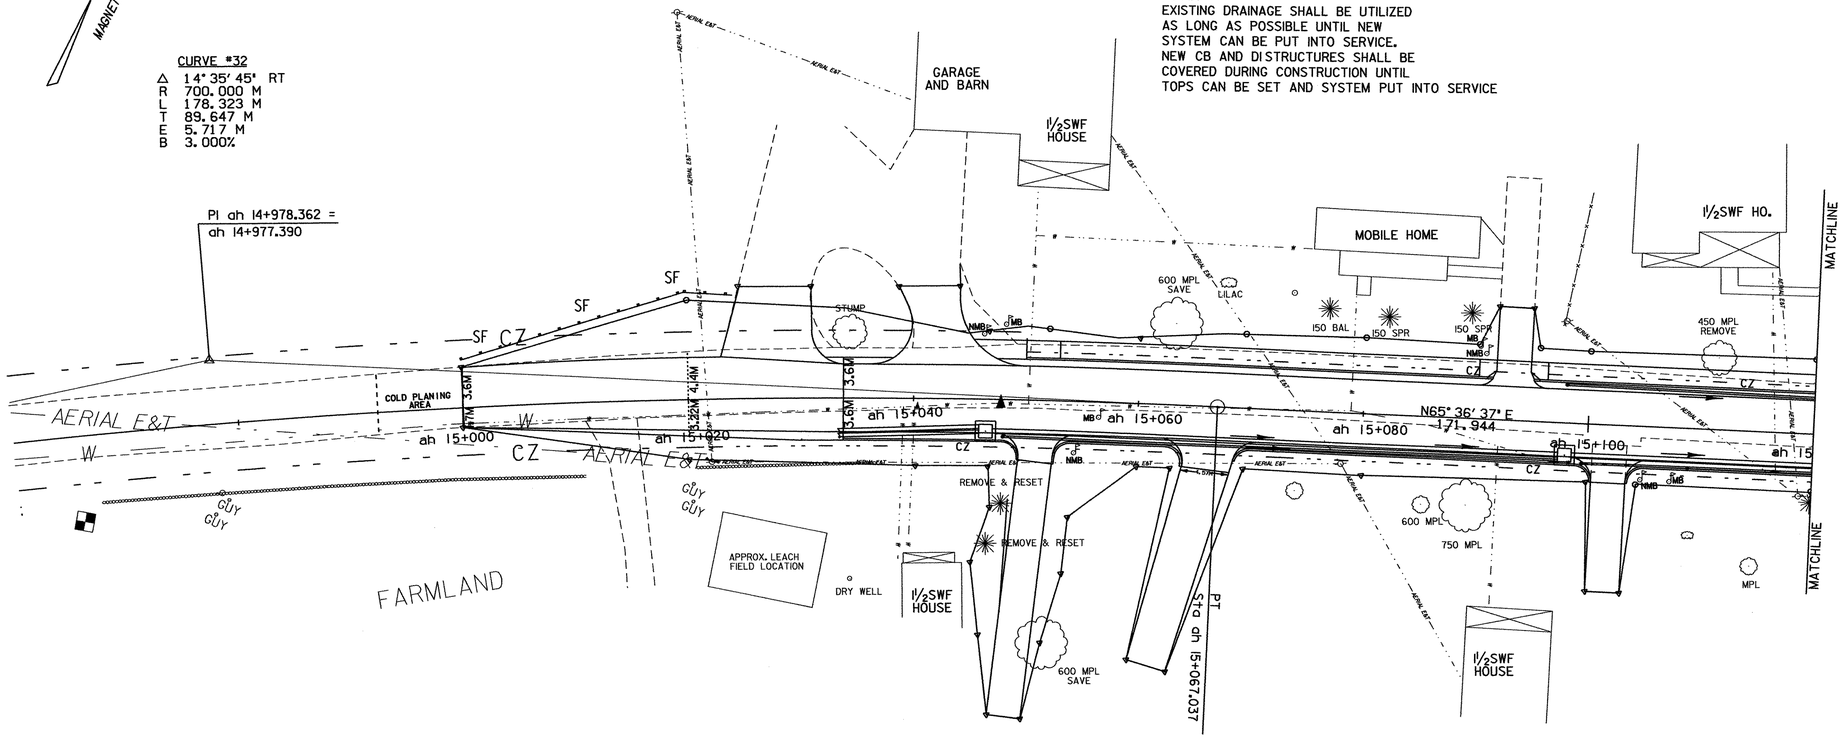

0 5 10 15
1:250

○ DENOTES TREE OR STUMP REMOVAL

ALL DRIVE RADII SHALL BE 6M UNLESS OTHERWISE NOTED PER STD B-71M

EROSION CONTROL LAYOUT

PROJECT NAME:	FRANKLIN
PROJECT NUMBER:	STP 0301(18)

FILE NAME:	85c060/design/2bdr.dgn	PLOT DATE:	27-MAR-2003
PROJECT LEADER:	DELLASANTA	DRAWN BY:	SQUAD B
DESIGNED BY:	SQUAD B	CHECKED BY:	SQUAD B
IPARM FILE NAME:	(2)dc060ecl.i	SHEET	30 OF 60

EROSION CONTROL LAYOUT

NOTES
SODDING SHALL BE APPLIED IMMEDIATELY ON ALL LAWNS DISTURBED BEYOND THE WORK AREA DELINEATED ON THESE PLANS. ALL CONSTRUCTION SHALL BE PERFORMED FROM THE ROADWAY OUT.
OUTSIDE OF THE ROADWAY BOXED EXCAVATION, ALL NEWLY CONSTRUCTED SLOPES (EXCAVATED OR EMBANKMENT) SHALL BE SEALED WITH 5MM THICK TOPSOIL AND MULCHED AT THE END OF EACH WORKDAY IN ACCORDANCE WITH THE SPECIFICATION AND THESE PLANS.

NOTES
EXISTING DRAINAGE SHALL BE UTILIZED AS LONG AS POSSIBLE UNTIL NEW SYSTEM CAN BE PUT INTO SERVICE. NEW CB AND DISTRUCTURES SHALL BE COVERED DURING CONSTRUCTION UNTIL TOPS CAN BE SET AND SYSTEM PUT INTO SERVICE

SODDING
ah 15+120 ~ ah 15+125 LT. (5M)
ah 15+130 ~ ah 15+133 LT. (4M)
ah 15+140 ~ ah 15+152 LT. (32M)
ah 15+160 ~ ah 15+197 LT. (17M)
ah 15+272 ~ ah 15+279 LT. (18M)
ah 15+288 ~ ah 15+300 LT. (19M)
ah 15+120 ~ ah 15+137 RT. (40M)
ah 15+268 ~ ah 15+279 RT. (17M)
ah 15+285 ~ ah 15+300 RT. (21M)
TH 26+019 ~ ah 26+039 LT. (32M)
TH 26+049 ~ ah 26+060 LT. (11M)
TH 26+037 ~ ah 26+048 RT. (11M)

GEOTEXTILE FOR SILT FENCE
ah 15+271 ~ ah 15+292 RT. (30M)
ah 15+270 ~ ah 15+280 RT. (25M)

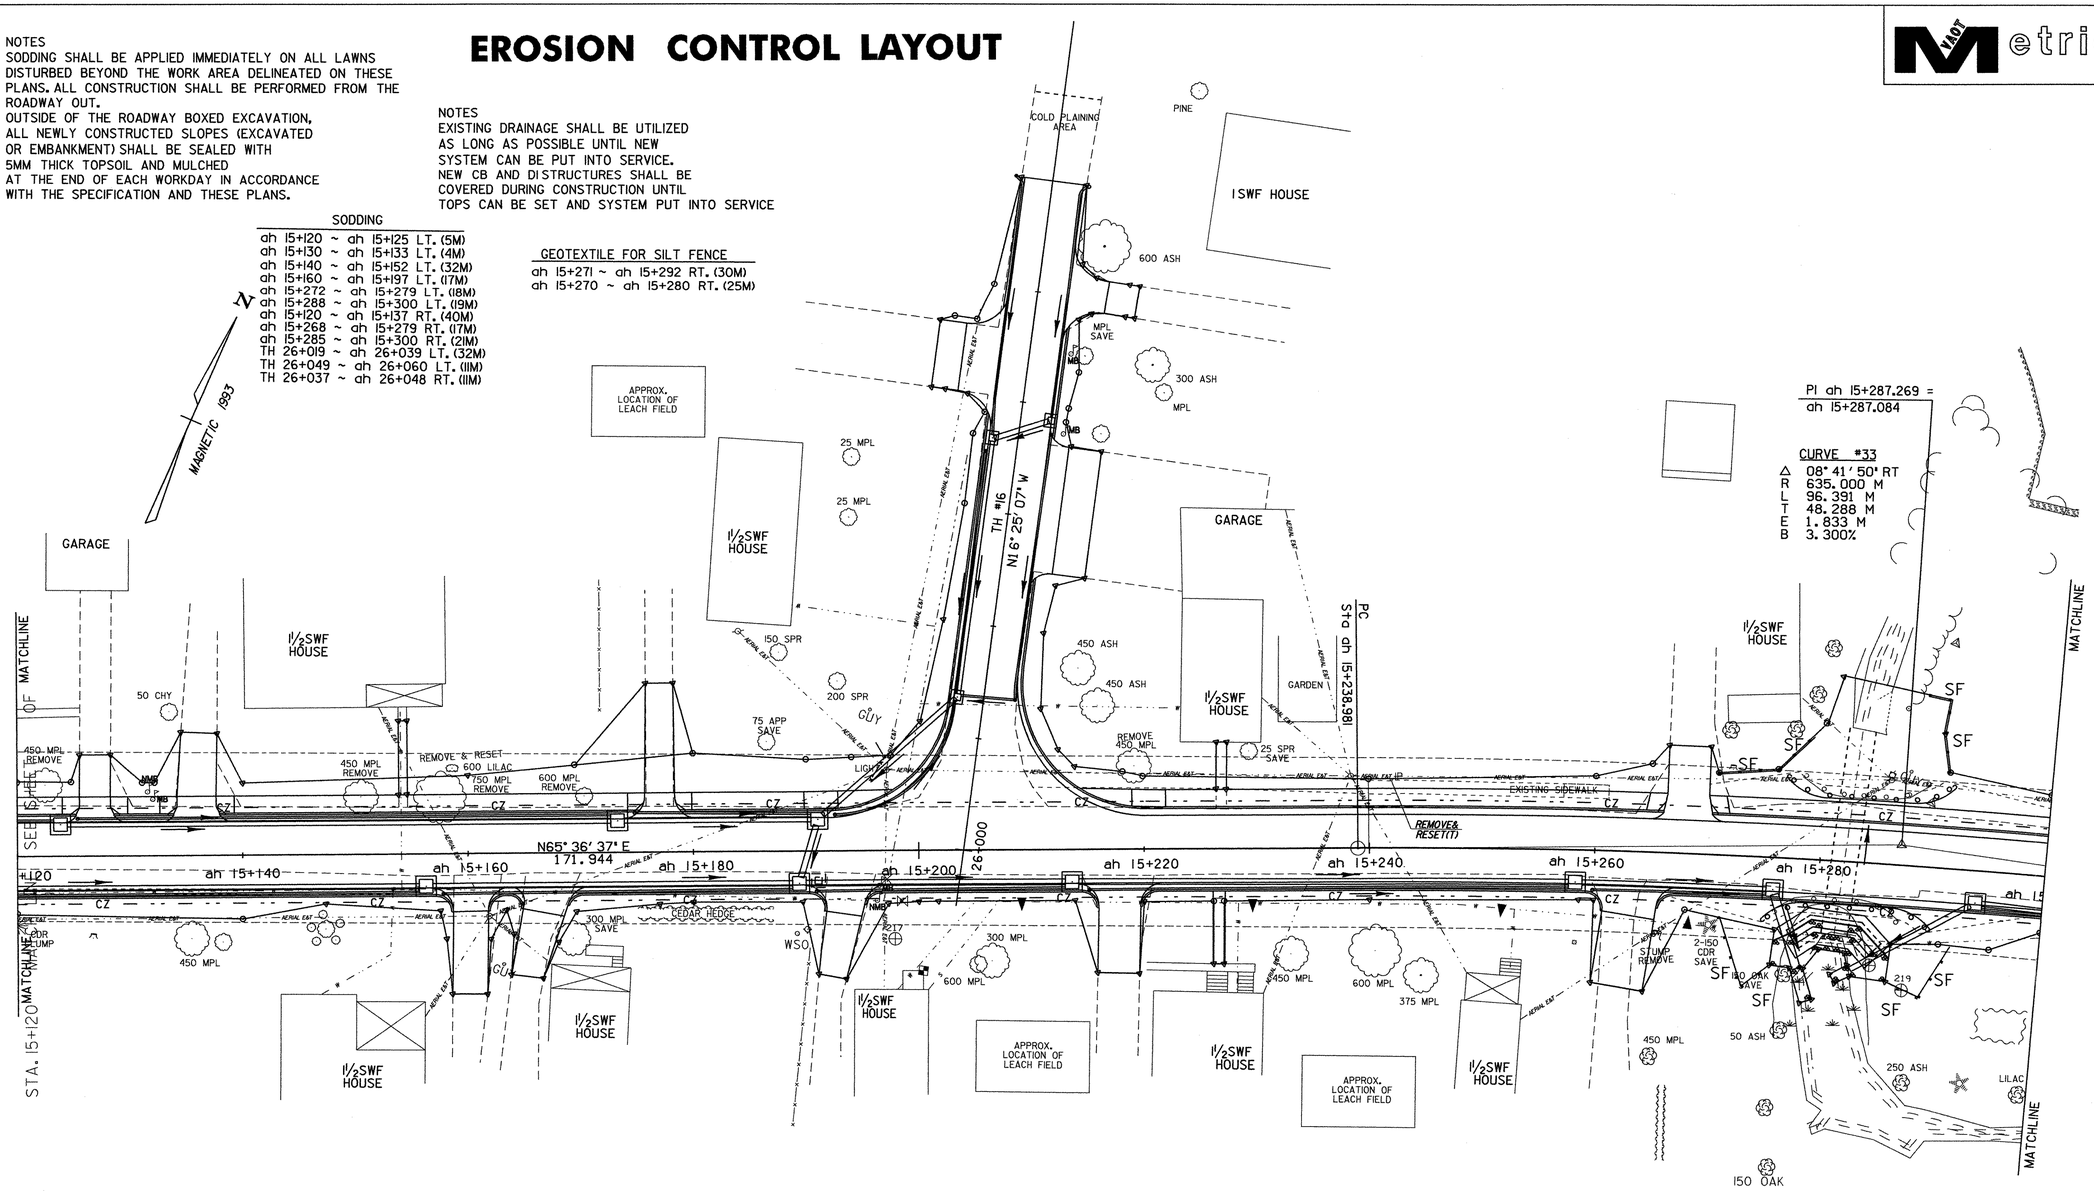

0 5 10 15
1:250

○ DENOTES TREE OR STUMP REMOVAL

ALL DRIVE RADII SHALL BE 6M UNLESS OTHERWISE NOTED PER STD B-71M

EROSION CONTROL LAYOUT

PROJECT NAME: FRANKLIN	
PROJECT NUMBER: STP 0301(18)	
FILE NAME: ...85c060/design/dc060bdr.dgn	PLOT DATE: 10-APR-2003
PROJECT LEADER: DELLASANTA	DRAWN BY: SQUAD B
DESIGNED BY: SQUAD B	CHECKED BY: SQUAD B
IPARM FILE NAME: (2)dc060ec2.i	SHEET 31 OF 60

EROSION CONTROL LAYOUT

N

MAGNETIC 1993

SODDING
ah 15+300 ~ ah 15+313 RT. (13M)
ah 15+320 ~ ah15+334 RT. (15M)
ah 15+344 ~ ah 15+348 RT. (5M)
ah 15+349 ~ ah 15+371 RT. (26M)
ah 15+425 ~ ah 15+458 RT. (40M)
ah 15+300 ~ ah 15+328 LT. (29M)
ah 15+344 ~ ah 15+348 LT. (4M)
ah 15+349 ~ ah 15+353 LT. (9M)

NOTES
SODDING SHALL BE APPLIED IMMEDIATELY ON ALL LAWNS DISTURBED BEYOND THE WORK AREA DELINEATED ON THESE PLANS. ALL CONSTRUCTION SHALL BE PERFORMED FROM THE ROADWAY OUT.
OUTSIDE OF THE ROADWAY BOXED EXCAVATION, ALL NEWLY CONSTRUCTED SLOPES (EXCAVATED OR EMBANKMENT) SHALL BE SEALED WITH 5MM THICK TOPSOIL AND MULCHED AT THE END OF EACH WORKDAY IN ACCORDANCE WITH THE SPECIFICATION AND THESE PLANS.

NOTES
EXISTING DRAINAGE SHALL BE UTILIZED AS LONG AS POSSIBLE UNTIL NEW SYSTEM CAN BE PUT INTO SERVICE.
NEW CB AND DI STRUCTURES SHALL BE COVERED DURING CONSTRUCTION UNTIL TOPS CAN BE SET AND SYSTEM PUT INTO SERVICE

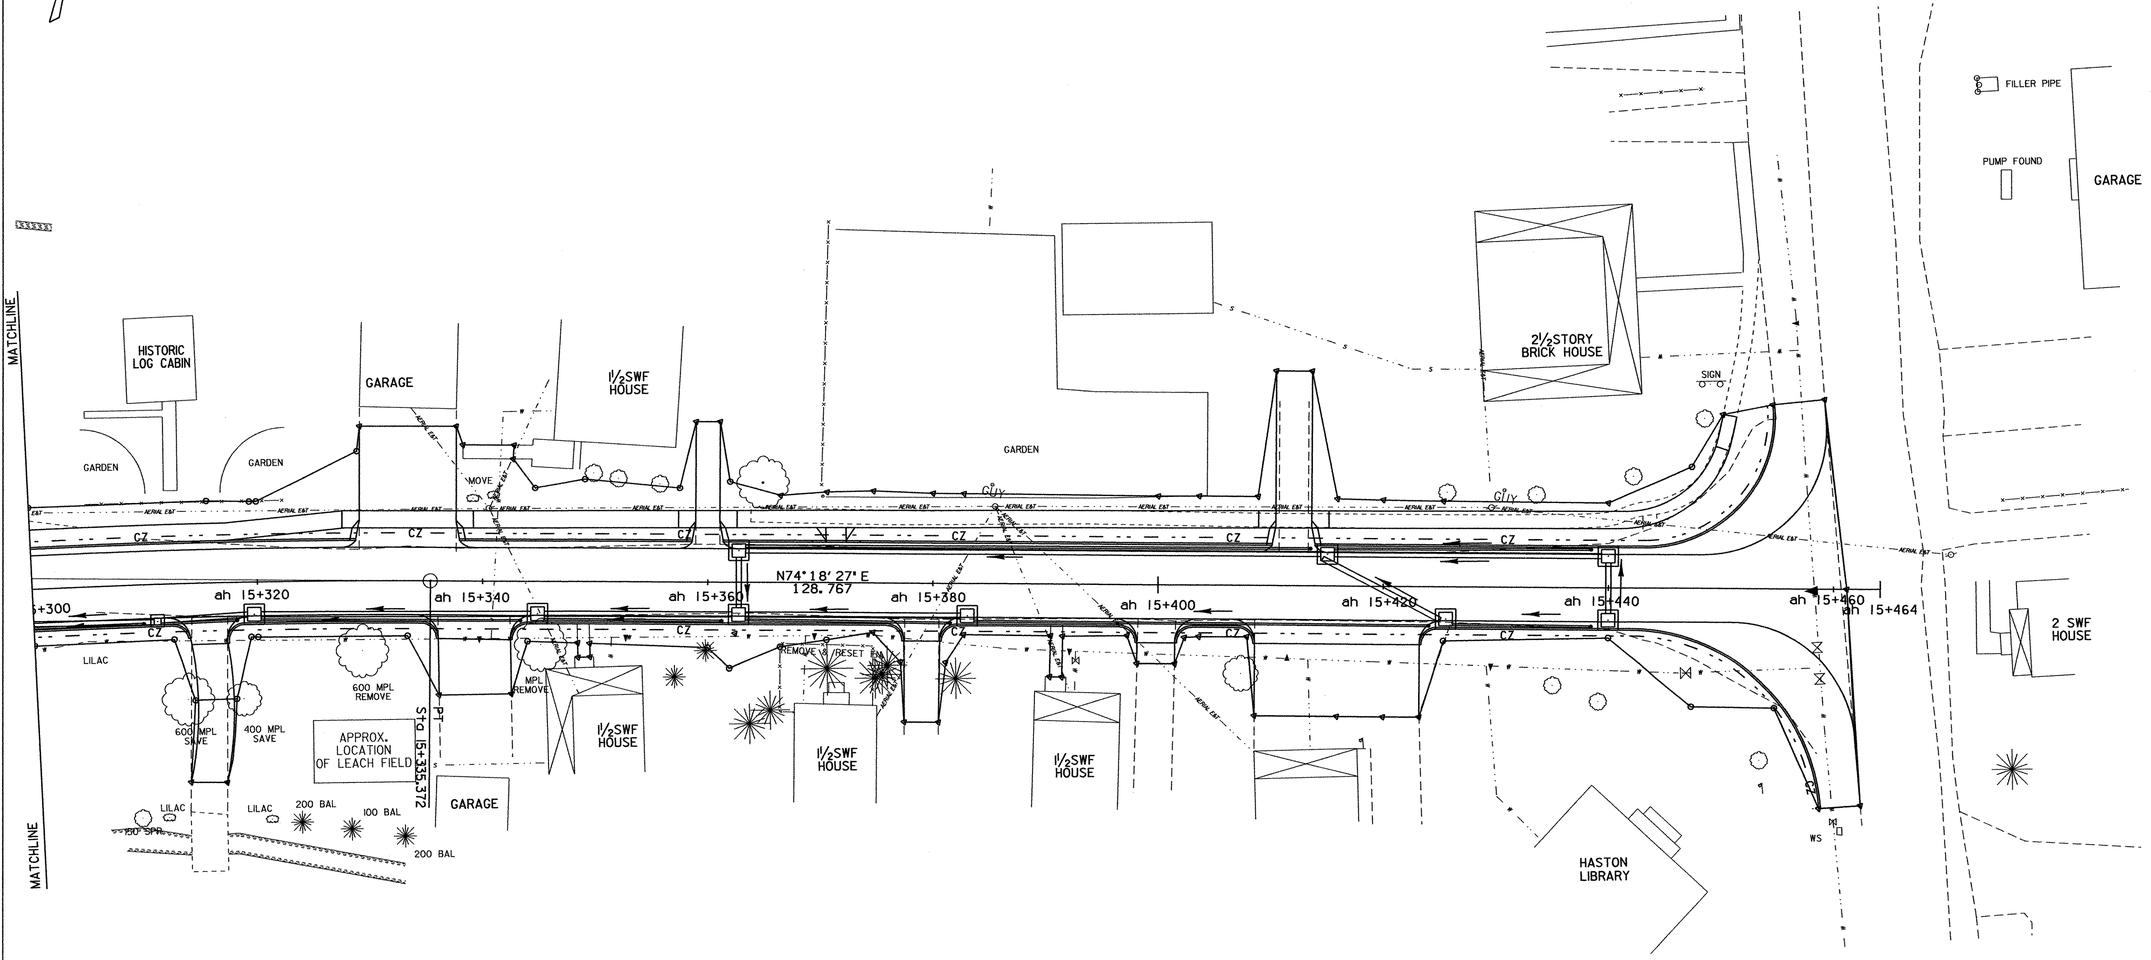

0 5 10 15
1:250

○ DENOTES TREE OR STUMP REMOVAL

ALL DRIVE RADII SHALL BE 6M UNLESS OTHERWISE NOTED PER STD B-7IM

EROSION CONTROL LAYOUT

PROJECT NAME:	FRANKLIN
PROJECT NUMBER:	STP 0301(18)
FILE NAME: ...85c060/design/dc060bdr.dgn	PLOT DATE: 27-MAR-2003
PROJECT LEADER: DELLASANTA	DRAWN BY: SQUAD B
DESIGNED BY: SQUAD B	CHECKED BY: SQUAD B
IPARM FILE NAME: (2)dc060ec3.I	SHEET 32 OF 60

Metric

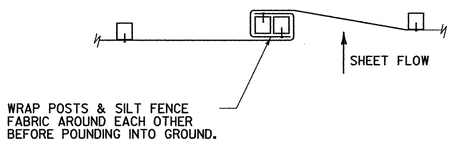

SPLICE DETAIL

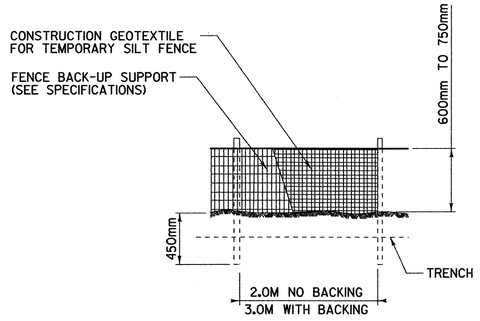

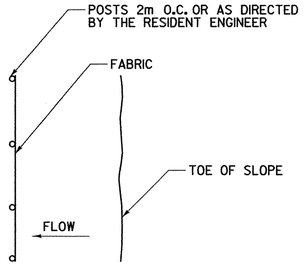

PLAN

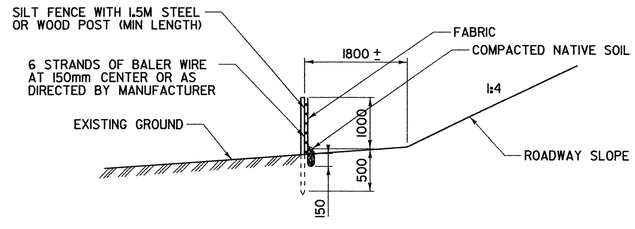

ELEVATION

SILT FENCE

NOT TO SCALE

NOTES:

1. FILTER TO BE BURIED APPROXIMATELY 150 mm INTO THE GROUND
2. FABRIC TO BE ATTACHED TO WIRE ON SLOPE SIDE
3. CONTRACTOR WILL FURNISH COMMERCIALLY AVAILABLE SILT FENCE THAT MEETS VAOT STANDARD SPECIFICATIONS FOR CONSTRUCTION
4. HAY BALES OR WIRE MESH MAY BE USED AT ENGINEERS DISCRETION IN CONJUCTION WITH THE SILT FENCE
5. HAY BALES SHALL NOT BE USED IN AREAS OF CONCENTRATED FLOW

ALL DIMENSIONS IN mm UNLESS OTHERWISE NOTED.

EROSION CONTROL DETAIL

PROJECT NAME:	FRANKLIN
PROJECT NUMBER:	STP 0301(18)

FILE NAME: 85c060/design/(2)dc060pms.dgn		PLOT DATE:	20-MAR-2003
PROJECT LEADER:	DELLASANTA	DRAWN BY:	SQUAD B
DESIGNED BY:	SQUAD B	CHECKED BY:	SQUAD B
IPARM FILE NAME:	(2)dc060edl.i	SHEET	33 OF 60

PAVMENT MARKING & TRAFFIC SIGNING LAYOUT

Metric

TEMPORARY 100mm WHITE LINE

~~ah 15+000 ~ ah 15+120 RT. EDGE LINE-SOLID~~
~~ah 15+000 ~ ah 15+120 LT. EDGE LINE-SOLID~~

DURABLE 100mm WHITE LINE

ah 15+000 ~ ah 15+120 RT. EDGE LINE-SOLID
ah 15+000 ~ ah 15+120 LT. EDGE LINE-SOLID

TEMPORARY 100mm YELLOW LINE

ah 15+000 C/L ah 15+120 C/L DBL. LINE-SOLID

DURABLE 100mm YELLOW LINE

ah 15+000 C/L ah 15+120 C/L DBL. LINE-SOLID

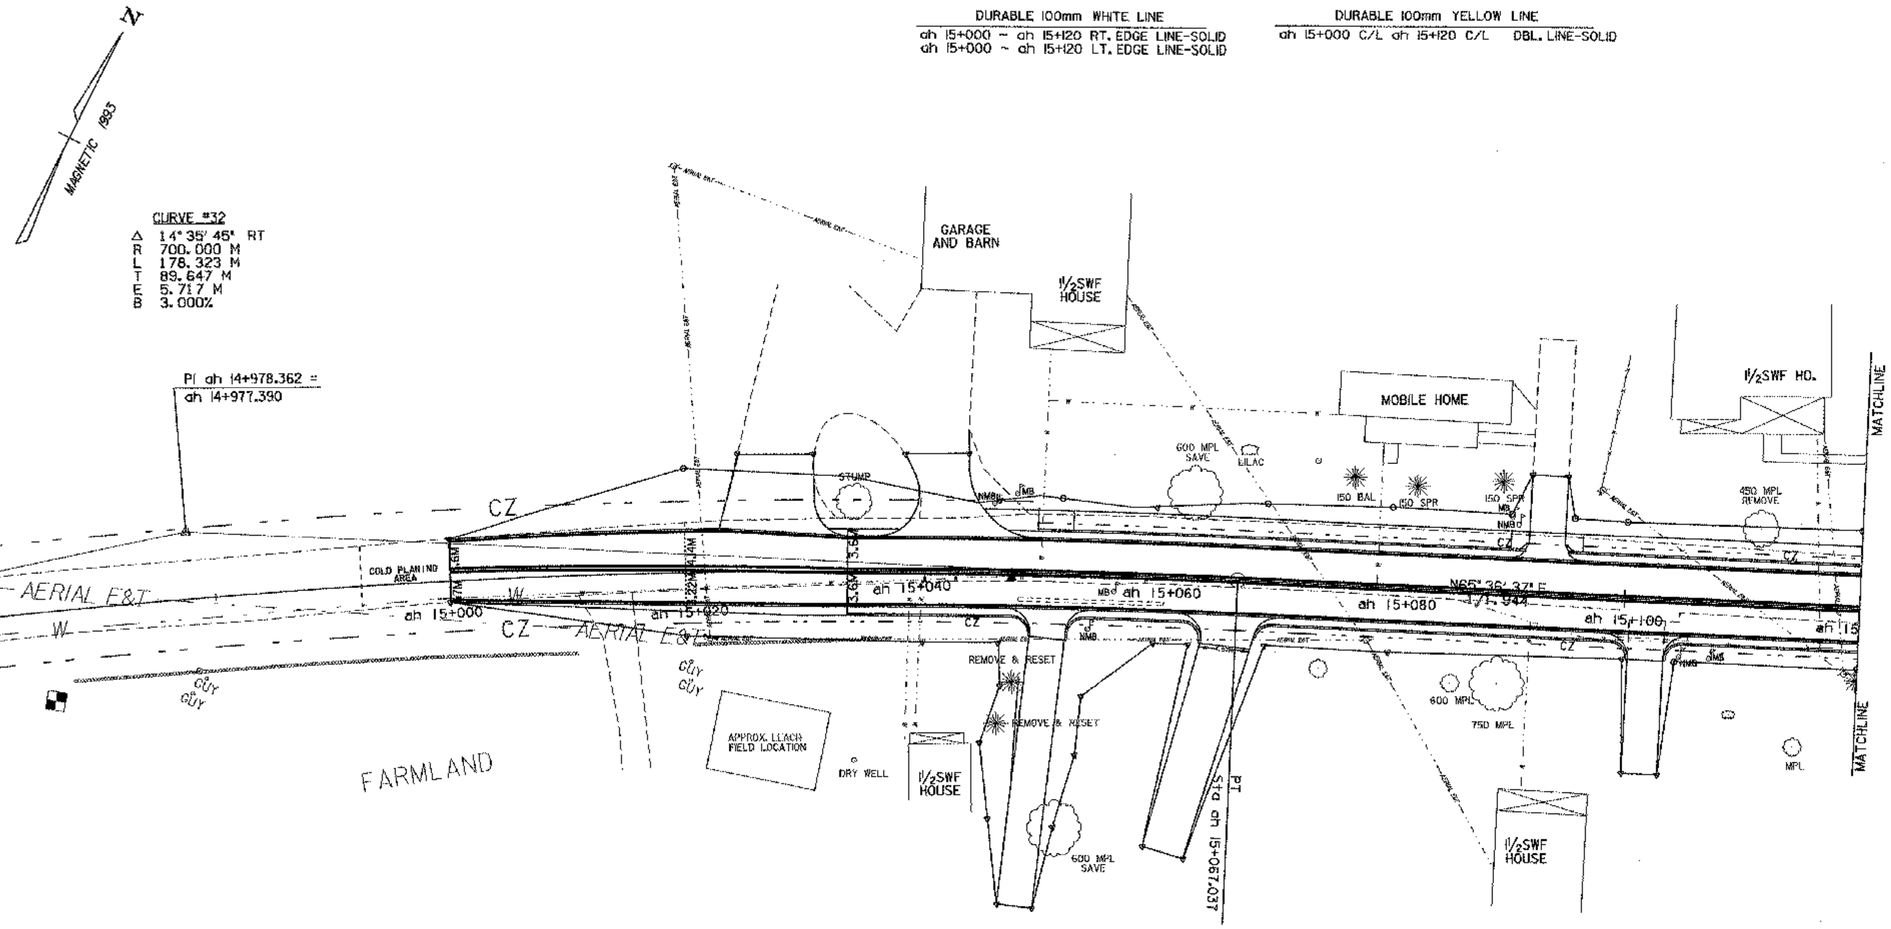

LEGEND

R = REMOVE
N = NEW
R&S = REMOVE & SALVAGE
RET = RETAIN

0 5 10 15
1:250

DENOTES TREE OR STUMP REMOVAL

ALL DRIVE RADII SHALL BE 6M UNLESS OTHERWISE NOTED PER STD B-7IM

PAVEMENT MARKING & TRAFFIC SIGNING LAYOUT

PROJECT NAME:	FRANKLIN
PROJECT NUMBER:	STP 030I(18)

FILE NAME: ...85c060/design/da060bdr.dgn		PLOT DATE:	24-MAR-2003
PROJECT LEADER:	DELLASANTA	DRAWN BY:	SQUAD B
DESIGNED BY:	SQUAD B	CHECKED BY:	SQUAD B
IPARM FILE NAME:	da060pml.i	SHEET	34 OF 60

PAVMENT MARKING & TRAFFIC SIGNING LAYOUT

TEMPORARY 100mm WHITE LINE

~~M/L ah 15+120 LT ~ SL 26+060 LT. EDGE LINE-SOLID~~
~~S/L 26+060 RT ~ ah 15+300 LT. EDGE LINE-SOLID~~
~~M/L ah 15+120 ~ ah 15+300 RT. EDGE LINE-SOLID~~

DURABLE 100mm WHITE LINE

M/L ah 15+120 LT ~ SL 26+060 LT. EDGE LINE-SOLID
S/L 26+060 RT ~ ah 15+300 LT. EDGE LINE-SOLID
M/L ah 15+120 ~ ah 15+300 RT. EDGE LINE-SOLID

TEMPORARY 100mm YELLOW LINE

M/L ah 15+120 C/L ~ 15+198 C/L DBL. LINE-SOLID
M/L ah 15+210 C/L ~ ah 15+300 C/L DBL. LINE-SOLID
S/L 26+010 C/L ~ 26+060 C/L DBL. LINE-SOLID

DURABLE 100mm YELLOW LINE

M/L ah 15+120 C/L ~ ah 15+198 C/L DBL. LINE-SOLID
M/L ah 15+210 C/L ~ ah 15+300 C/L DBL. LINE-SOLID
S/L 26+010 C/L ~ 26+060 C/L DBL. LINE-SOLID

REMOVING SIGNS

ah 15+212 C/L LT (2) 3
S/L 26+045 S/L RT.
15+199 LT

DURABLE 24" STOP BAR

S/L 26+004 C/L ~ 26+04.5 C/L LT (7M)

DURABLE LETTER OR SYMBOL

S/L 26+013.5 C/L ~ 26+015.9 C/L LT (STOP)

ST. SL 26+045 RT
SPEED LIMIT 35 R

ST. SL 26+045 RT
SPEED LIMIT 35 N

ST. ah 15+199 LT.
STOP N

ST. ah 15+212 LT.
SQUARE RD R&S
HANNA RD R&S

ST. ah 15+214 LT.
SQUARE RD S
HANNA RD S

WILMINGTON 23 →
FRANKLIN SCHOOL →

PI ah 15+287.269 =
ah 15+287.084

CURVE #33
Δ 06° 41' 50" RT
R 635.000 M
L 96.391 M
T 48.288 M
E 1.833 M
B 3.300%

PC Sta ah 15+238.981

N16° 25' 07" W

N65° 36' 37" E 171.944

26+000

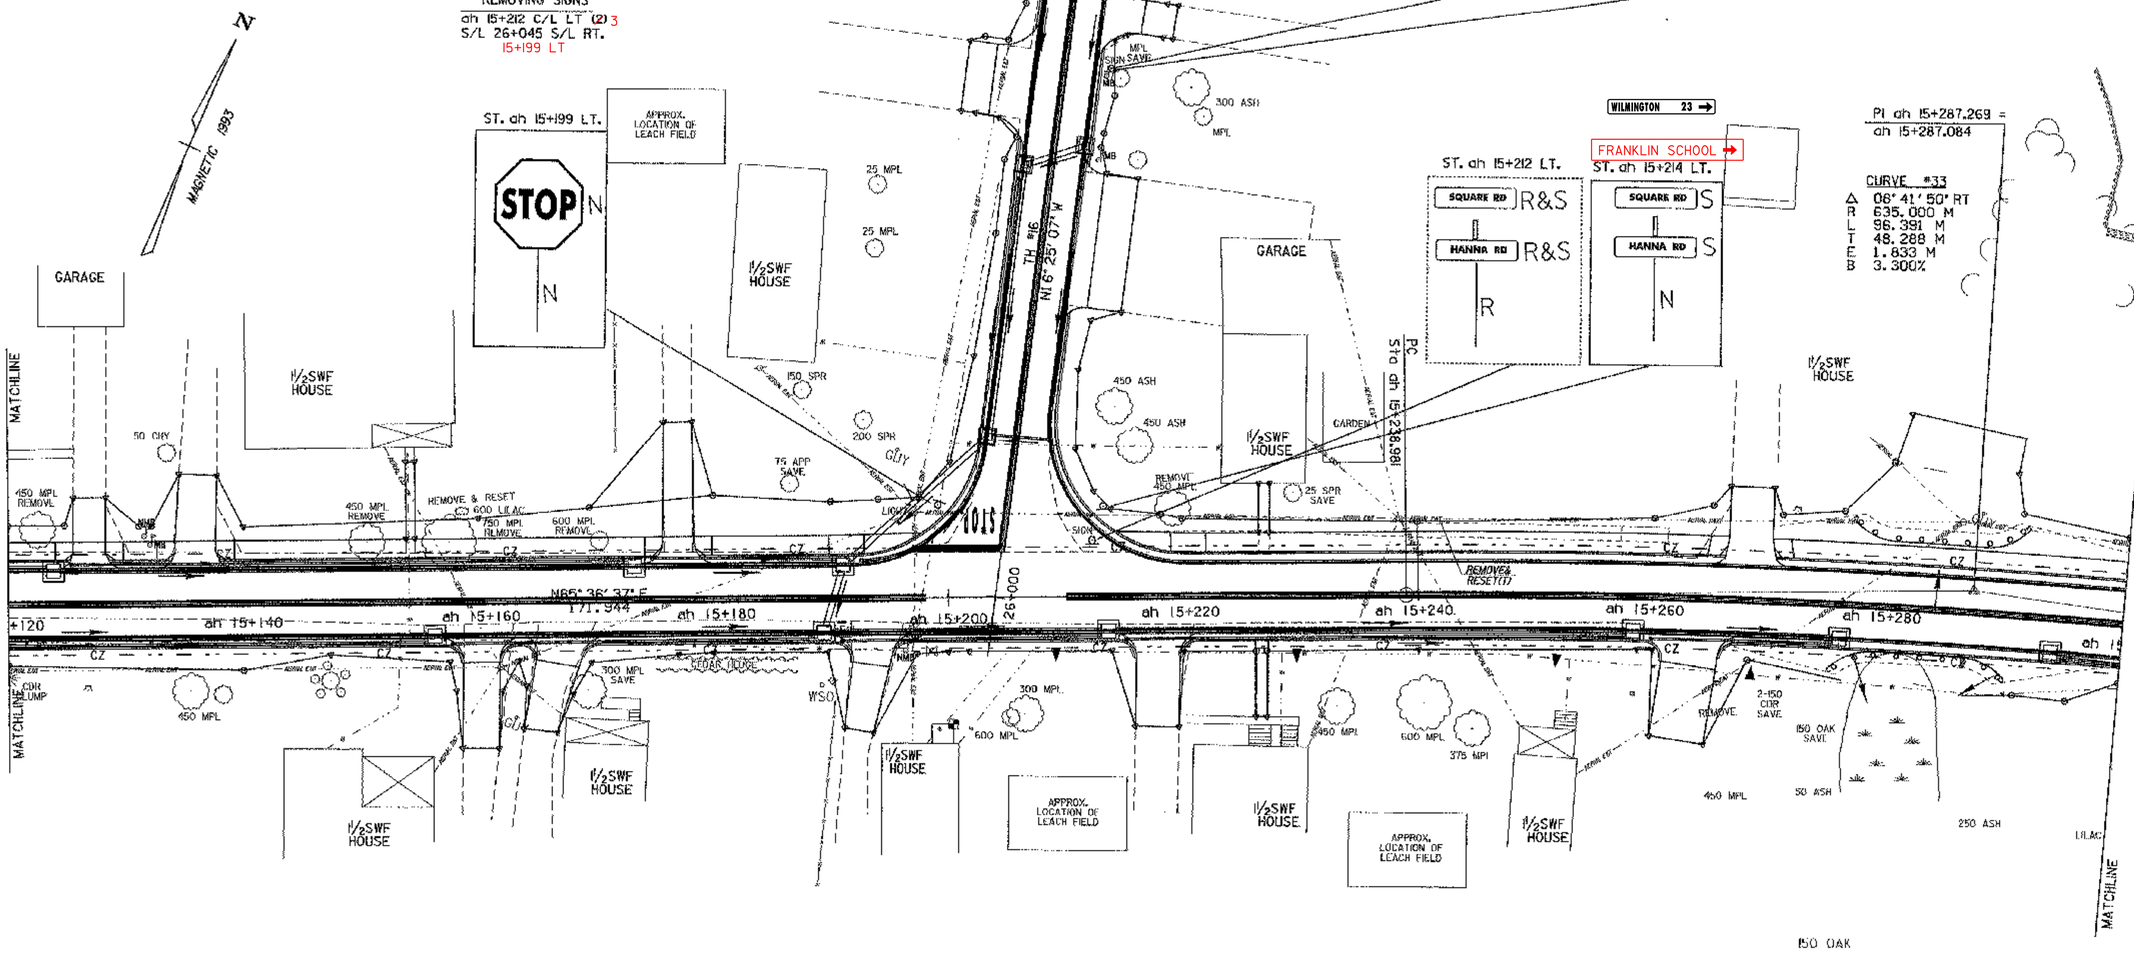

LEGEND

R = REMOVE
N = NEW
R&S = REMOVE & SALVAGE
RET = RETAIN

PAVEMENT MARKING &TRAFFIC SIGNING LAYOUT

0 5 10 15
1:250

○ DENOTES TREE OR STUMP REMOVAL

ALL DRIVE RADII SHALL BE 6M UNLESS OTHERWISE NOTED PER STD B-7IM

PROJECT NAME:	FRANKLIN
PROJECT NUMBER:	STP 0301(18)
FILE NAME: ...85c060/design/dc060bdr.dgn	PLOT DATE: 27-MAR-2003
PROJECT LEADER: DELLASANTA	DRAWN BY: SQUAD B
DESIGNED BY: SQUAD B	CHECKED BY: SQUAD B
IPARM FILE NAME: (2) dc060pms2	SHEET 35 OF 60

PAVMENT MARKING & TRAFFIC SIGNING LAYOUT

Metric

N

MAGNETIC 1993

TEMPORARY 4" WHITE LINE

~~M/L ah 15+300 ~ ah 15+459 LT. EDGE LINE-SOLID~~
~~M/L ah 15+300 ~ ah 15+462 RT. EDGE LINE-SOLID~~

DURABLE 4" WHITE LINE

M/L ah 15+300 ~ ah 15+459 LT. EDGE LINE-SOLID
M/L ah 15+300 ~ ah 15+462 RT. EDGE LINE-SOLID

TEMPORARY 4" YELLOW LINE

M/L ah 15+300 C/L ~ ah 15+459 C/L DBL. LINE-SOLID

DURABLE 4" YELLOW LINE

M/L ah 15+300 C/L ~ ah 15+459 C/L DBL. LINE-SOLID

DURABLE 24" STOP BAR

M/L 15+458.8 C/L ~ ah 15+459.5 C/L RT (7M)

DURABLE LETTER OR SYMBOL

M/L 15+449.1 C/L ~ ah 15+451.5 C/L RT (STOP)

REMOVING SIGNS

ah 15+428 LT (2)
ah 15+438 LT
ah 15+449 RT (2)
ah 15+454 RT (2)

SPEED LIMIT 35

ST. ah 15+428 LT

R SPEED LIMIT 35 R
CAUTION MACHINERY
R

ST. ah 15+428 LT

~~SPEED LIMIT 35~~
N
N
N

ST. ah 15+438 LT

LEGAL LOAD LIMIT 24,000 POUNDS
R
R

ST. ah ~~15+438~~ LT 15+446

LEGAL LOAD LIMIT 24,000 POUNDS
N
N

MATCHLINE

HISTORIC LOG CABIN
GARDEN
GARDEN
GARAGE
1½SWF HOUSE
GARDEN
2½STORY BRICK HOUSE
FILLER PIPE
PUMP FOUND
GARAGE
2 SWF HOUSE
HASTON LIBRARY
MOVE
REMOVE & RESET
N74°18'27"E
128.787
CZ
ah 15+300
ah 15+320
ah 15+340
ah 15+360
ah 15+380
ah 15+400
ah 15+420
ah 15+440
ah 15+460
ah 15+464
LILAC
600 MPL REMOVE
600 MPL SAVE
400 MPL SAVE
MPL REMOVE
APPROX. LOCATION OF LEACH FIELD
Sta 15+336.372
PT
1½SWF HOUSE
1½SWF HOUSE
1½SWF HOUSE
GARAGE
LILAC
LILAC
200 BAL
100 BAL
200 BAL
MATCHLINE

0 5 10 15
1:250

STOP R
1200
0407
0345
R
R
ST. ah 15+449 RT

STOP N
1200
0607
0348
N
N
ST. ah 15+450 RT

R&S MAIN ST
R&S HANNA RD
R
ST. ah 15+454 RT

MAIN ST S
HANNA RD S
N
ST. ah 15+454.5 RT

LEGEND

R = REMOVE
N = NEW
R&S = REMOVE & SALVAGE
RET = RETAIN

PAVEMENT MARKING &TRAFFIC SIGNING LAYOUT

○ DENOTES TREE OR STUMP REMOVAL

ALL DRIVE RADII SHALL BE 6M UNLESS OTHERWISE NOTED PER STD B-7M

PROJECT NAME:	FRANKLIN
PROJECT NUMBER:	STP 0301(18)
FILE NAME: ...85c060/design/dc060bdr.dgn	PLOT DATE: 27-MAR-2003
PROJECT LEADER: DELLASANTA	DRAWN BY: SQUAD B
DESIGNED BY: SQUAD B	CHECKED BY: SQUAD B
IPARM FILE NAME: dc060pms3	SHEET 36 OF 60

STATE OF VERMONT
AGENCY OF TRANSPORTATION

TRAFFIC SIGN SUMMARY SHEET

Metric

KILOMETER MARKER, STATION, OR SIGN NUMBER	SIGN LEGEND	SIGN DIMENSIONS: EA	WIDTH (mm)	HEIGHT (mm)	NEW & SALVAGED SIGNS: "A"	"B"	SALV SIGN	SALV TIS	EXIST POST: RETAIN	SALVAGE	NO. OF POSTS	FLANGED CHANNEL kg/m: 1.7	3.0	4.5	SQUARE STEEL (mm) kg/m: 44 3.4	50 3.9	63 5.0	ANCHOR	SLEEVE	TUBULAR ALUMINUM Ø (mm) kg/m: 75 1.9	100 2.5	100 MOD 2.5	TUBULAR STEEL Ø (mm) FOUNDATION	75 11.3	89 13.4	100 16.1	125 21.7	W-SHAPE STEEL FTG. SIZE: 600 mm	750 mm	WEIGHT	POST SIZE	SIGN FRAME REQUIRED	REMARKS	SIGN DETAIL: DETAIL ON SHEET NUMBER	STD. SHEET NUMBER
												OPTION ITEMS																								
ah 15+199 LT.	STOP	1	750	750	0.562						1			X			3.66 X																	RI-1		E-143M
ah 15+214 LT.	SQUARE RD						X				1			X			3.66 X																	POST TOP MOUNTING		E-123M
	HANNA RD.						X																											POST TOP MOUNTING		E-123M
ah 15+~~428~~ 446 LT.	SPEED LIMIT 35	1	600	750	0.450						1			X			3.96 X																	R2-4		E-142M
ah 15+428 lt		1	750	750	0.562																														36	
ah 15+~~438~~ 446 LT.	LEGAL LOAD LIMIT 24,000 POUNDS	1	600	750	0.450						1			X			4.27 X																	VR-017		E-141M
ah 15+450 RT.	STOP	1	750	750	0.562						1			X			3.96 X																	RI-1		E-143M
	1200 0607 0345	1	150	200	0.030																													VD-700		E-138M
ah 15+454 LT.	MAIN ST						X				1			X			3.66 X																	POST TOP MOUNTING		E-123M
	HANNA RD.						X																											POST TOP MOUNTING		E-123M
												m	m	m 23	m	m	m 23		EA	kg	kg	kg		kg	kg	kg	kg								
	TOTALS				m² 2.62	m²	EA.	m²				m 23			m 23					kg			EA.	kg				EA.	EA.	kg					

FINAL POST LENGTHS ARE TO BE DETERMINED IN THE FIELD. POST SIZES ARE COMPUTED BASED ON INFORMATION FURNISHED ON THE STANDARD SHEETS AND THE TRAFFIC & SAFETY DIVISION'S "SIGN POST DESIGN GUIDELINE."

PROJECT NAME: FRANKLIN
PROJECT NUMBER: STP 0301(18)

FILE NAME: ...85c060/design/dc060pms.dgn PLOT DATE: 27-MAR-2003
PROJECT LEADER: DELLASANTA DRAWN BY: SQUAD B
DESIGNED BY: SQUAD B CHECKED BY: SQUAD B
IPARM FILE NAME: (2)dc060tss.i SHEET 37 OF 60

STATE OF VERMONT
AGENCY OF TRANSPORTATION

TRAFFIC SIGN SUMMARY SHEET

VAOT Metric

KILOMETER MARKER, STATION, OR SIGN NUMBER	SIGN LEGEND	SIGN DIMENSIONS EA	WIDTH (mm)	HEIGHT (mm)	NEW & SALVAGED SIGNS "A"	"B"	SALV SIGN	SALV TIS	EXIST POST RETAIN	EXIST POST SALVAGE	NEW SIGN POSTS NO. OF POSTS	FLANGED CHANNEL kg/m 1.7	3.0	4.5	SQUARE STEEL (mm) kg/m 44 3.4	50 3.9	63 5.0	ANCHOR	SLEEVE	TUBULAR ALUMINUM Ø (mm) kg/m 75 1.9	100 2.5	100 MOD 2.5	TUBULAR STEEL FOUNDATION	Ø (mm) kg/m 75 11.3	89 13.4	100 16.1	125 21.7	W-SHAPE STEEL FTG. SIZE 600 mm	750 mm	WEIGHT	POST SIZE	SIGN FRAME REQUIRED	REMARKS	SIGN DETAIL DETAIL ON SHEET NUMBER	STD. SHEET NUMBER
												OPTION ITEMS																									
	TH = 16																																			
SL 26+045 RT.	SPEED LIMIT 35	1	600	750	0.450						1			X			3.96 X																R2-4		E-142M

W11-5

NOTE: OPTICALLY CENTER

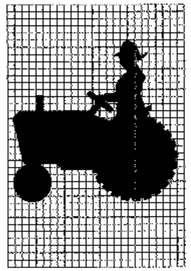

SCALE - 1 SQUARE = 1 UNIT

SIGN	DIMENSIONS (INCHES) A	B	C	D
MIN.	600	10	15	50
STD.	750	13	20	50
EXPWY.	900	15	25	60
SPECIAL	1200	20	30	700

FINAL POST LENGTHS ARE TO BE DETERMINED IN THE FIELD. POST SIZES ARE COMPUTED BASED ON INFORMATION FURNISHED ON THE STANDARD SHEETS AND THE TRAFFIC & SAFETY DIVISION'S "SIGN POST DESIGN GUIDELINE."

								m	m	m 4	m	m	m 4		EA	kg	kg	kg		kg	kg	kg	kg												
TOTALS GRAND TOTALS	m^2 0.450 (3.07)	m^2	EA.	m^2		m 4 (27)		m 4 (27)			kg	EA.	kg					EA.	EA.	kg																

PROJECT NAME: FRANKLIN
PROJECT NUMBER: STP 0301(18)

FILE NAME: ...85c060/design/dc060pms.dgn PLOT DATE: 27-MAR-2003
PROJECT LEADER: DELLASANTA DRAWN BY: SQUAD B
DESIGNED BY: SQUAD B CHECKED BY: SQUAD B
IPAM FILE NAME: (2)dc060tsh.i SHEET 38 OF 60

SIDE ROAD CONSTRUCTION APPROACH SIGNS

CONSTRUCTION APPROACH SIGNS

VDOT Metric

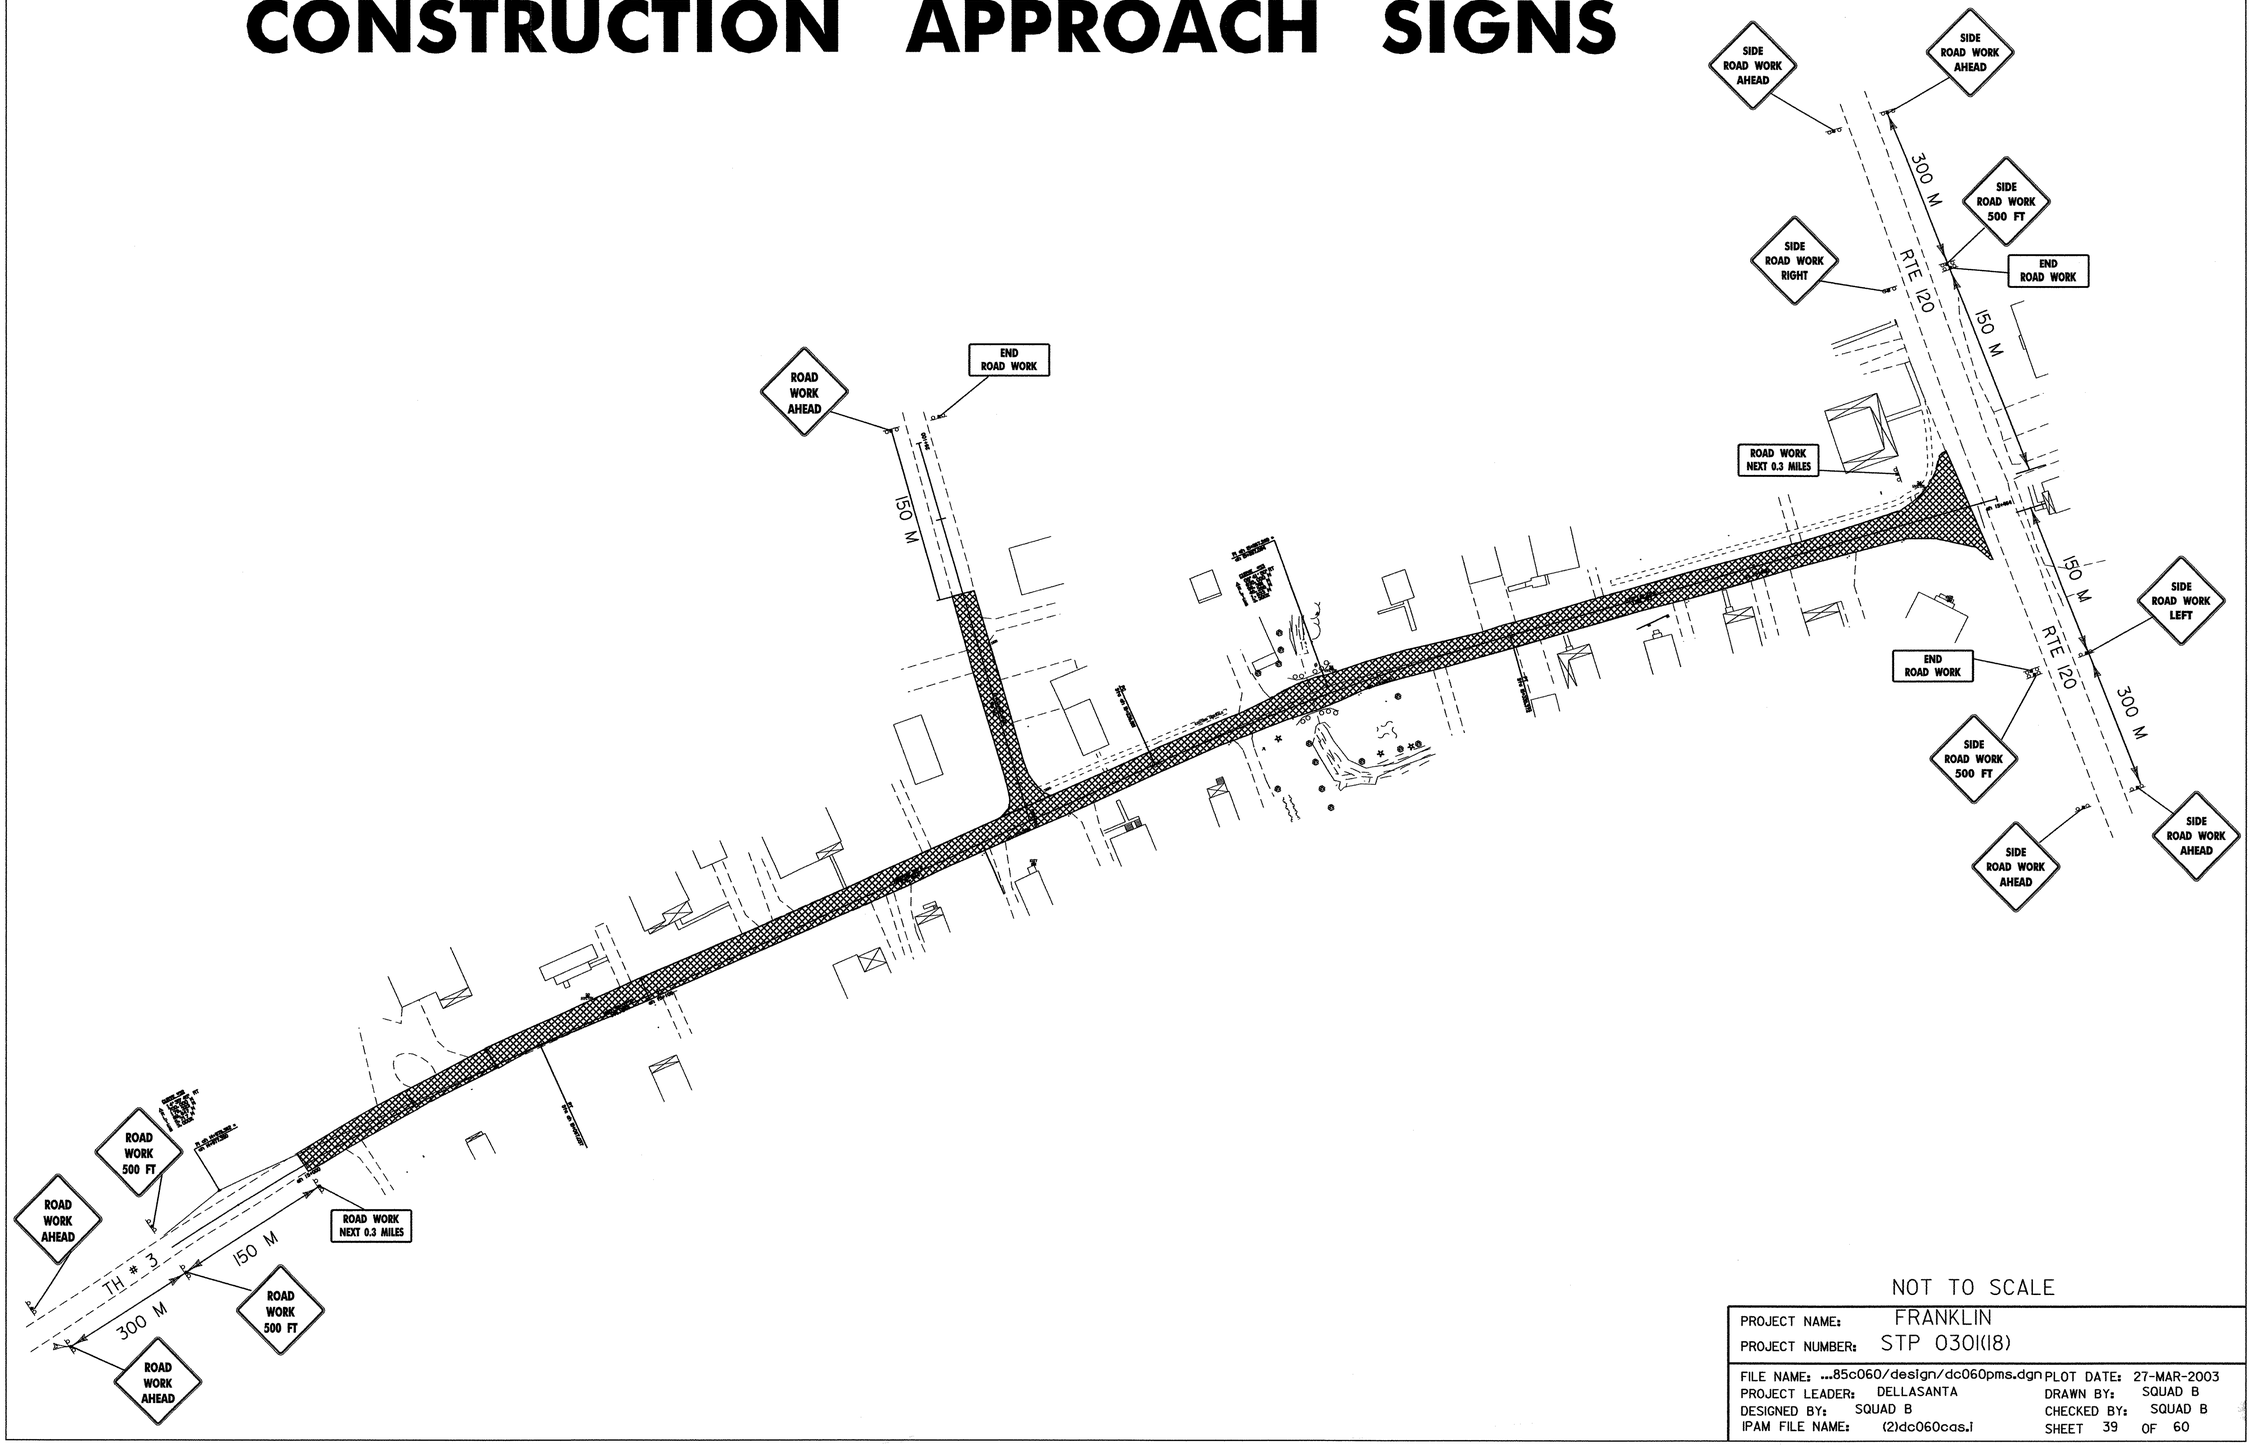

NOT TO SCALE

PROJECT NAME:	FRANKLIN
PROJECT NUMBER:	STP 0301(18)

FILE NAME:	...85c060/design/dc060pms.dgn	PLOT DATE:	27-MAR-2003
PROJECT LEADER:	DELLASANTA	DRAWN BY:	SQUAD B
DESIGNED BY:	SQUAD B	CHECKED BY:	SQUAD B
IPAM FILE NAME:	(2)dc060cas.i	SHEET	39 OF 60

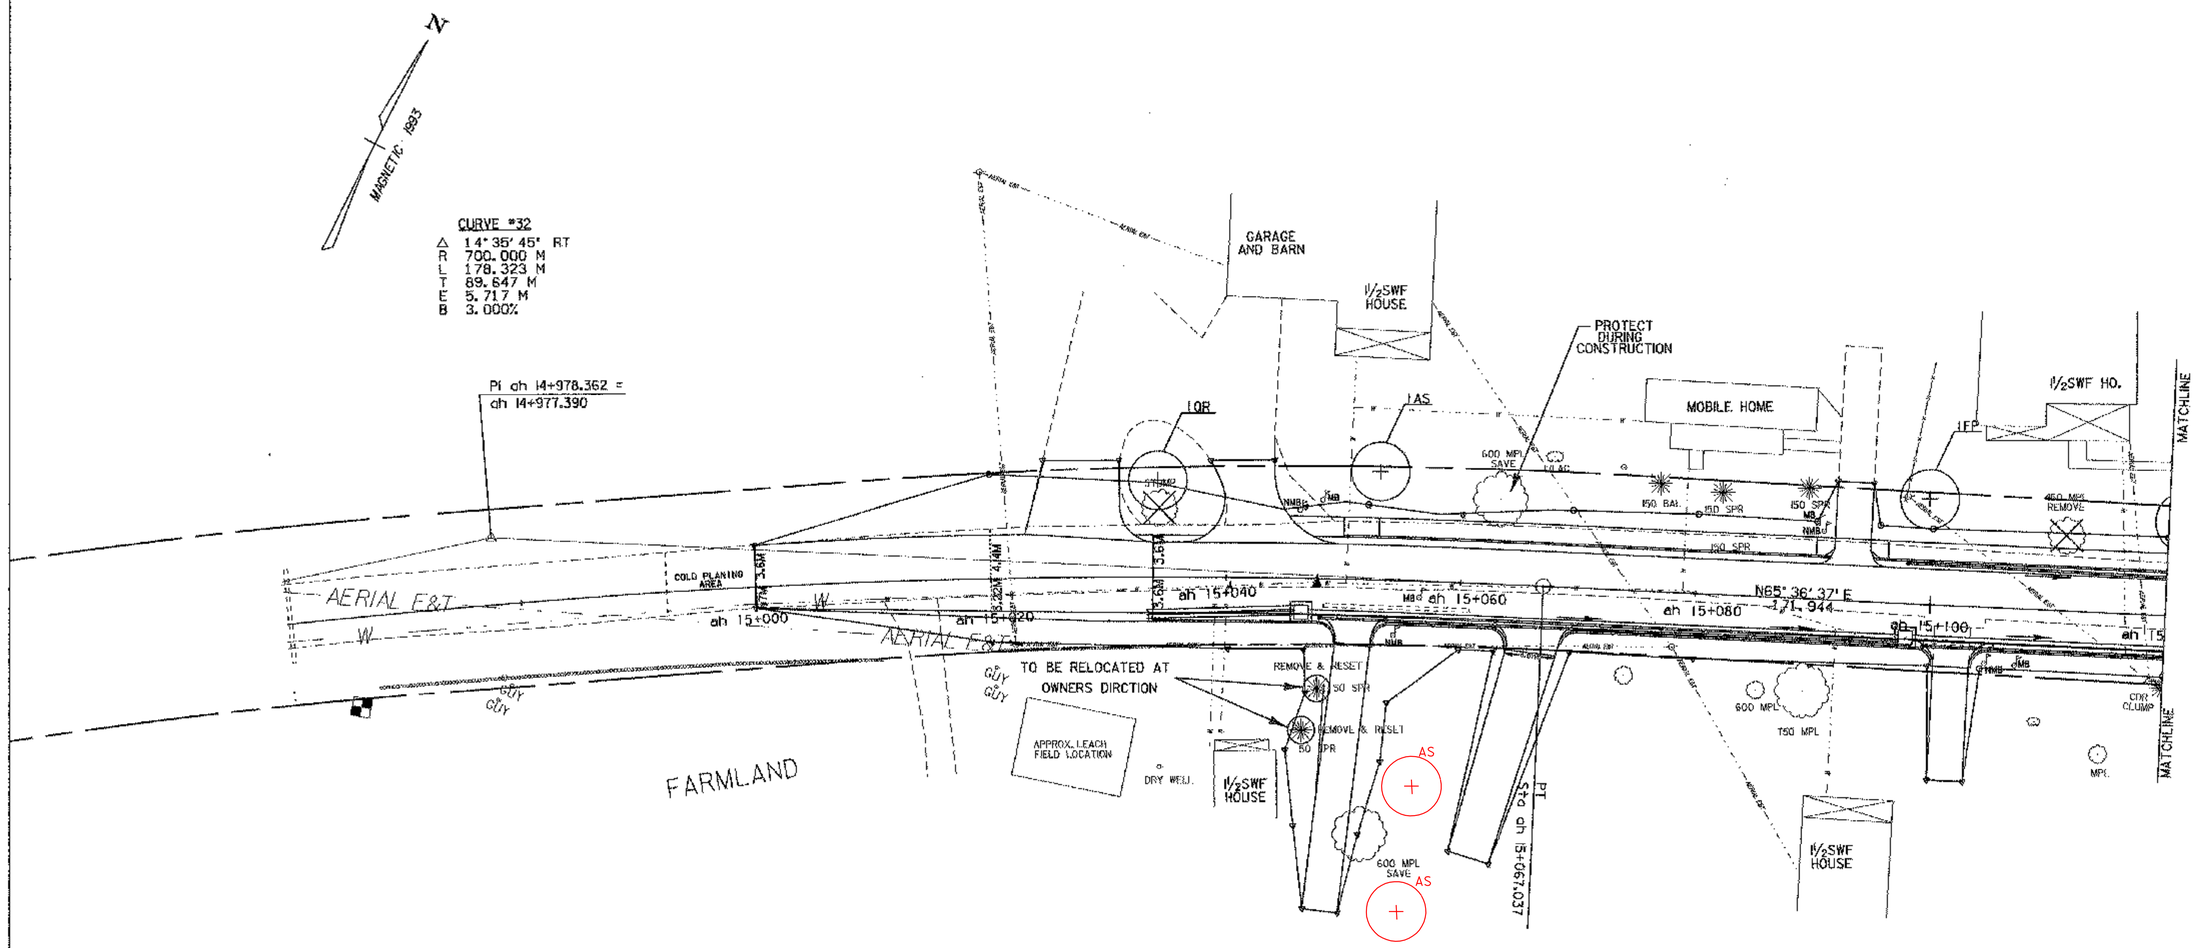

LEGEND

- TO BE REMOVED
- PROPOSED TREE
- TO BE RELOCATED BY OTHERS
- PROTECT EXISTING TREES DURING CONSTRUCTION (PROTECT)
- EXISTING TREE (TO REMAIN)

0 5 10 15
1:250

DENOTES TREE OR STUMP REMOVAL

ALL DRIVE RADII SHALL BE 6M UNLESS OTHERWISE NOTED PER STD B-71M

LANDSCAPE PLANS

PROJECT NAME: FRANKLIN
PROJECT NUMBER: STP 030I(18)

FILE NAME: 85c060/design/2bdr.dgn
PROJECT LEADER: DELLASANTA
DESIGNED BY: SQUAD B
IPARM FILE NAME: (2)dc060lnl.i

PLOT DATE: 27-MAR-2003
DRAWN BY: SQUAD B
CHECKED BY: SQUAD B
SHEET 40 OF 60

N

MAGNETIC 1993

GARAGE

MATCHLINE

1/2SWF HOUSE

1QR

50 CHY

SIDEWALK TO BE MOVED CLOSER TO EDGE OF ROAD

2 QR

450 MPL REMOVE

450 MPL REMOVE

(REMOVE & RESET) 600 LILAC

750 MPL REMOVE

600 MPL REMOVE

APPROX. LOCATION OF LEACH FIELD

1/2SWF HOUSE

25 MPL

25 MPL

150 SPR

200 SPR

75 APP SAVE

GUY

LIGHT

TH #16

N16° 25' 07" W

COLD PLAINING AREA

PINE

1SWF HOUSE

600 ASH

MPL SIGN SAVE

300 ASH

MPL

GARAGE

450 ASH

1AS

450 ASH

1/2SWF HOUSE

REMOVE 450 MPL

GARDEN

25 SPR SAVE

SIGN

REMOVE & RESET(T)

PC Sta ah 15+238.981

2 AR

PI ah 15+287.269 =
ah 15+287.084

CURVE #33
Δ 08° 41' 50" RT
R 635.000 M
L 96.391 M
T 48.288 M
E 1.833 M
B 3.300%

1/2SWF HOUSE

1AR

MATCHLINE

N65° 36' 37" E
171.944

ah 15+120
ah 15+140
ah 15+160
ah 15+180
ah 15+200
ah 15+220
ah 15+240
ah 15+260
ah 15+280

26.000

CDR STUMP

450 MPL

300 MPL SAVE

PROTECT DURING CONSTRUCTION

WSO

1/2SWF HOUSE

300 MPL

600 MPL

1/2SWF HOUSE

APPROX. LOCATION OF LEACH FIELD

450 MPL

600 MPL

375 MPL

1/2SWF HOUSE

APPROX. LOCATION OF LEACH FIELD

REMOVE

2-150 CDR SAVE

5 RLG

150 OAK SAVE

217

5 RLG

5 QR

450 MPL

50 ASH

250 ASH

LILAC

150 OAK

MATCHLINE

LEGEND

- TO BE REMOVED
- PROPOSED TREE
- TO BE RELOCATED BY OTHERS
- PROTECT EXISTING TREES DURING CONSTRUCTION
- EXISTING TREE (TO REMAIN)

PROTECT

0 5 10 15
1:250

DENOTES TREE OR STUMP REMOVAL

ALL DRIVE RADII SHALL BE 6M UNLESS OTHERWISE NOTED PER STD B-71M

SCAPE PLANS

LANDSCAPE PLANS

PROJECT NAME:	FRANKLIN
PROJECT NUMBER:	STP 030I(18)
FILE NAME:	85c060/design/(2)boreo.dgn
PLOT DATE:	27-MAR-2003
PROJECT LEADER:	DELLASANTA
DRAWN BY:	SQUAD B
DESIGNED BY:	SQUAD B
CHECKED BY:	SQUAD B
IPARM FILE NAME:	(2)dc060ln2.i
SHEET	41 OF 60

VDOT Metric

N

MAGNETIC 1993

MATCHLINE

HISTORIC LOG CABIN

GARDEN

GARDEN

GARAGE

1½SWF HOUSE

PROTECT DURING CONSTRUCTION

MPL

SPR SPR APP

MOVE

GARDEN

2½STORY BRICK HOUSE

MPL

MPL

PROTECT DURING CONSTRUCTION

FILLER PIPE

PUMP FOUND

GARAGE

2 SWF HOUSE

CZ

AERIAL E&T

CITY

N74°18'27"E
128.767

ah 15+300

ah 15+320

ah 15+340

ah 15+360

ah 15+380

ah 15+400

ah 15+420

ah 15+440

ah 15+460

ah 15+464

LILAC

600 MPL REMOVE

MPL REMOVE

REMOVE & RESET FN

4 BLK LOCUST

LILAC

4 BLK LOCUST

BLK LOCUST

2 BLK LOCUST

600 MPL SAVE

400 MPL SAVE

APPROX. LOCATION OF LEACH FIELD

1½SWF HOUSE

1½SWF HOUSE

1½SWF HOUSE

MPL

LFP

SPR

WS

HASTON LIBRARY

PT Sta 15+335.372

GARAGE

LILAC

LILAC

150 SPR

200 BAL

100 BAL

200 BAL

PROTECT DURING CONSTRUCTION

MATCHLINE

LEGEND

- TO BE REMOVED
- PROPOSED TREE
- TO BE RELOCATED BY OTHERS
- PROTECT — PROTECT EXISTING TREES DURING CONSTRUCTION
- EXISTING TREE (TO REMAIN)

0 5 10 15
1:250

DENOTES TREE OR STUMP REMOVAL

ALL DRIVE RADII SHALL BE 6M UNLESS OTHERWISE NOTED PER STD B-71M

LANDSCAPE PLANS

PROJECT NAME:	FRANKLIN
PROJECT NUMBER:	STP 0301(18)

FILE NAME:	85c060/design/(2)borec.dgn	PLOT DATE:	27-MAR-2003
PROJECT LEADER:	DELLASANTA	DRAWN BY:	SQUAD B
DESIGNED BY:	SQUAD B	CHECKED BY:	SQUAD B
IPARM FILE NAME:	(2)dc06ln3.i	SHEET	42 OF 60

LANDSCAPE DETAIL SHEET

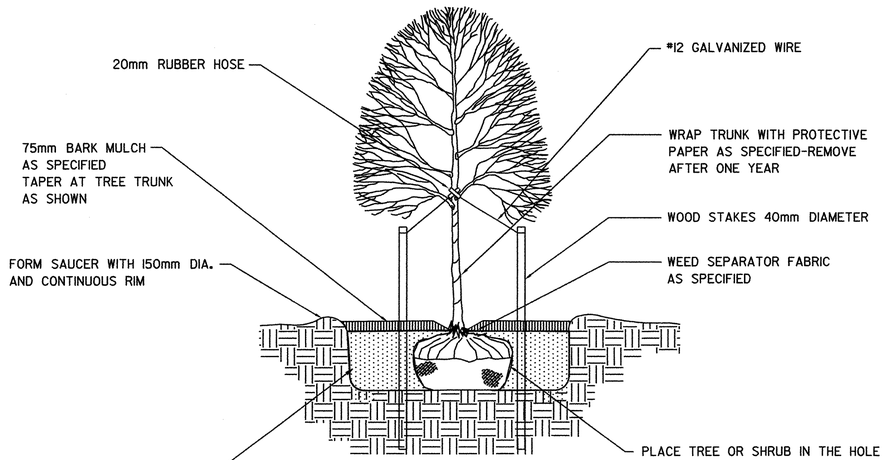

NOTES:

1. STAKE ONLY THOSE TREES PLANTE IN WINDY, EXPOSED LOCATIONS, WHERE THEY MIGHT BE BLOWN OVER OR VANDALIZED.
2. COMPLETELY REMOVE GUY WIRES, RUBBER HOSE AND STAKES ONE YEAR AFTER PLANTING.

TREE PLANTING DETAIL

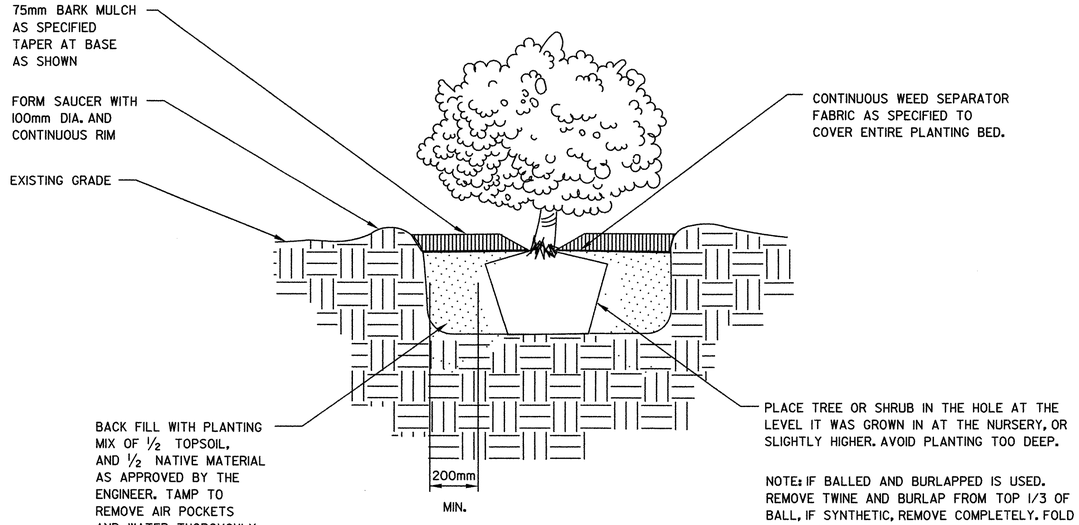

SHRUB PLANTING DETAIL

PRELIMINARY PLANS
NOT TO SCALE

PROJECT NAME:	HIGHGATE - FRANKLIN
PROJECT NUMBER:	STP RS 0301(1) SA

FILE NAME:	..85c060/design/(2)dc060ldt.dgn	PLOT DATE:	20-MAR-2003
PROJECT LEADER:	DELLASANTA	DRAWN BY:	SQUAD B
DESIGNED BY:	SQUAD B	CHECKED BY:	SQUAD B
IPARM FILE NAME:	(2)dc060ldt01.i	SHEET	43 OF 60

Metric

LANDSCAPE QUANTITY SHEET

QUANTITY	UNIT	KEY	BOTANICAL NAME	COMMON NAME	SIZE	SPACING	REMARKS	ITEM NO.
			DECIDUOUS TREES					
3	EA	AR	ACER RUBRUM	RED MAPLE "FREEMANI"	75MM -90MM CAL	AS SHOWN	B&B	
2	EA	AS	ACER SACHARUM	SUGAR MAPLE	75MM 90MM CAL	AS SHOWN	B&B	
24	EA	FP	FRAXINUS PENNSYLVANICA	GREEN ASH	75MM -90MM CAL	AS SHOWN	B&B	
7	EA	QR	QUERCUS RUBRA	NORTHERN RED OAK	75MM -90MM CAL	AS SHOWN	B&B	
			DECIDUOUS SHRUBS					
10	EA	RA	RHUS AROMATICA "GROLOW"	GROLOW SUMAC	600MM - 750MM	1M OC	CONTAINER	

NOTES:

PROJECT NAME: FRANKLIN
PROJECT NUMBER: STP RS 0301(18)

FILE NAME: ..85c060/design/(2)dc060ldt.dgn PLOT DATE: 20-MAR-2003
PROJECT LEADER: DELLASANTA DRAWN BY: SQUAD B
DESIGNED BY: SQUAD B CHECKED BY: SQUAD B
IPARM FILE NAME: (2)dc060lqt01.t SHEET 44 OF 60

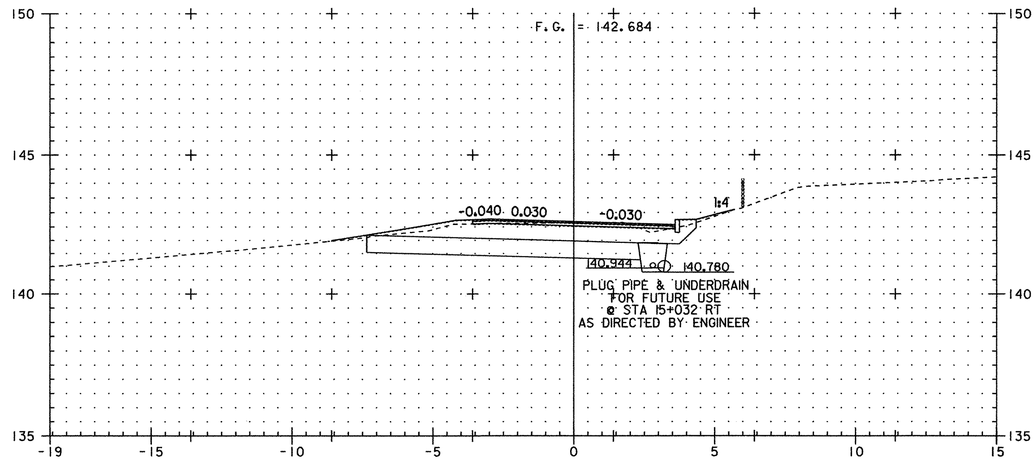

ah 15+034
BEGIN PROJECT

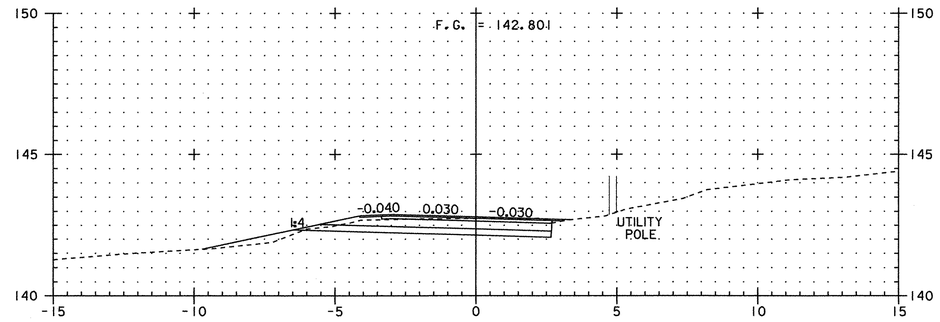

ah 15+020

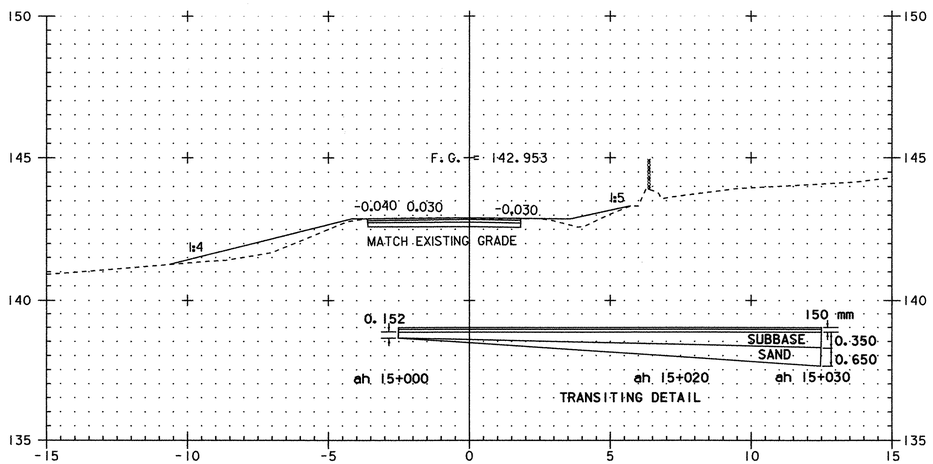

ah 15+000
BEGIN APPROACH CONSTRUCTION

0 2 4 6 8 10
SCALE 1:100

PROJECT NAME: FRANKLIN	
PROJECT NUMBER: STP 0301(18)	
FILE NAME: ...85c060\design\dc060xl2.dgn	PLOT DATE: 20-MAR-2003
PROJECT LEADER: DELLASANTA	DRAWN BY: SQUAD B
DESIGNED BY: SQUAD B	CHECKED BY: SQUAD B
IPARM FILE NAME: (2)dc060x01.i	SHEET 45 OF 60

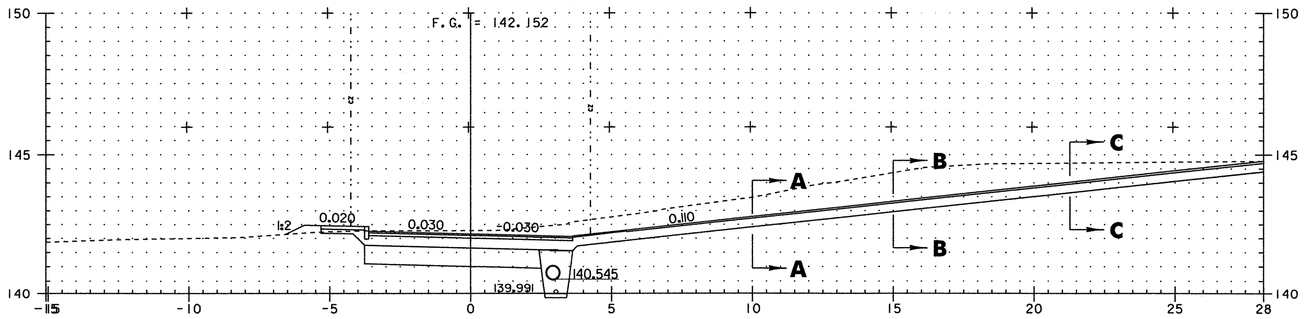

ah 15+051 DR RT

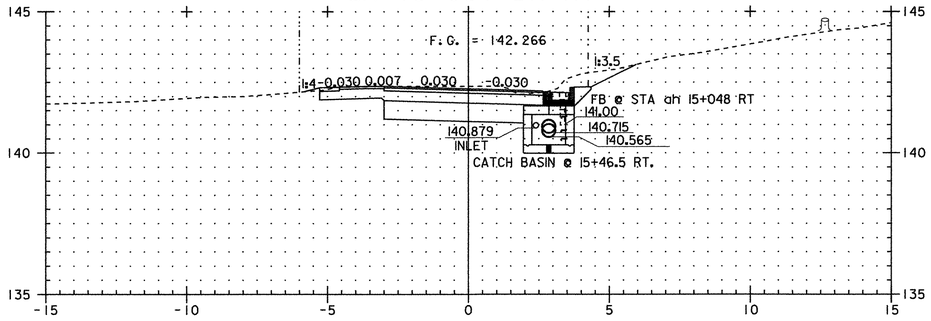

ah 15+047

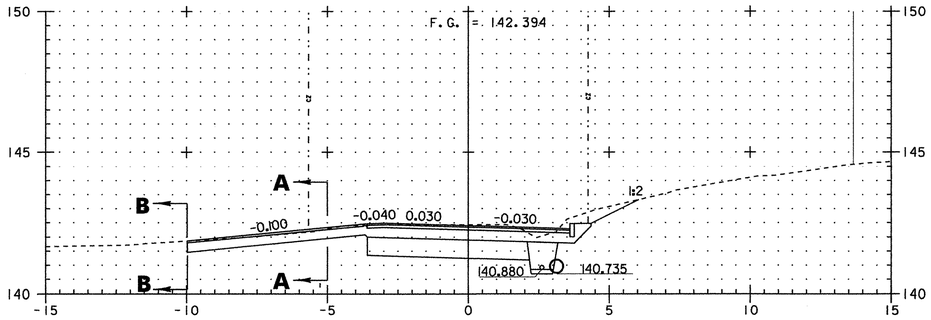

ah 15+042
DR LT

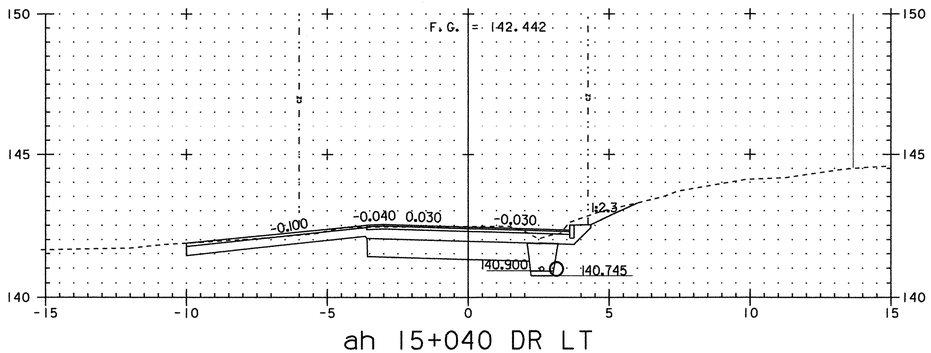

ah 15+040 DR LT

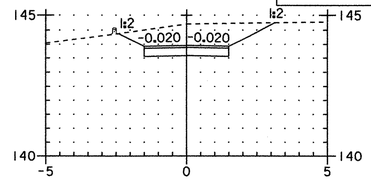

SECTION C - C

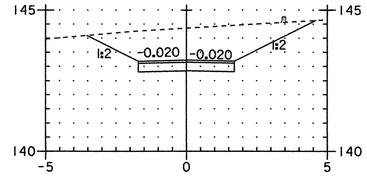

SECTION B - B

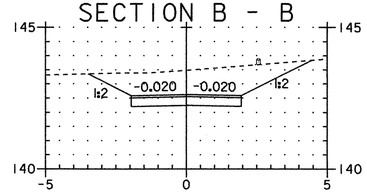

SECTION A - A
DRIVE @ ah 15+051 RT

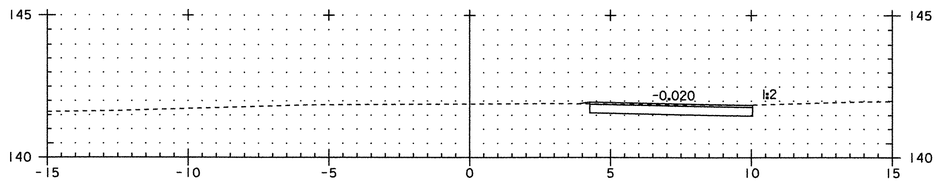

SECTION B - B

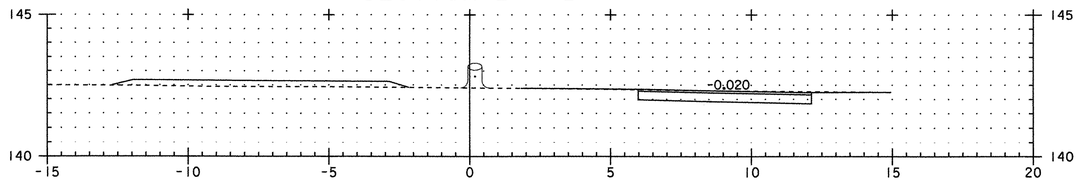

SECTION A - A
DRIVE @ ah 15+028 LT & ah 15+042 LT

0 2 4 6 8 10
SCALE 1:100

PROJECT NAME: FRANKLIN	
PROJECT NUMBER: STP 0301(18)	
FILE NAME: ...85c060\design\dc060x12.dgn	PLOT DATE: 20-MAR-2003
PROJECT LEADER: DELLASANTA	DRAWN BY: SQUAD B
DESIGNED BY: SQUAD B	CHECKED BY: SQUAD B
IPARM FILE NAME: (2)dc060x02.I	SHEET 46 OF 60

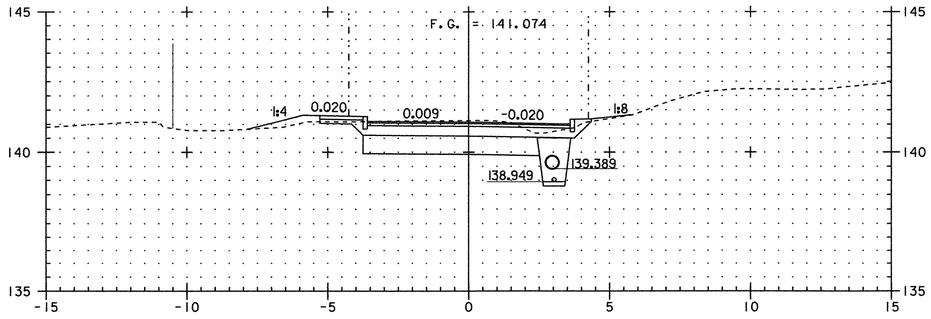

ah 15+080

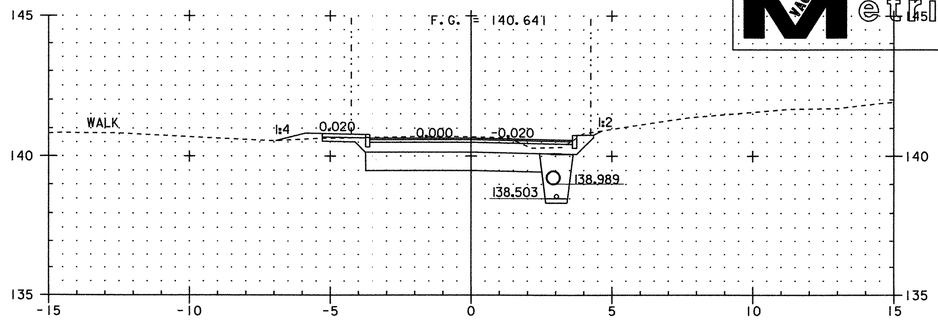

ah 15+090

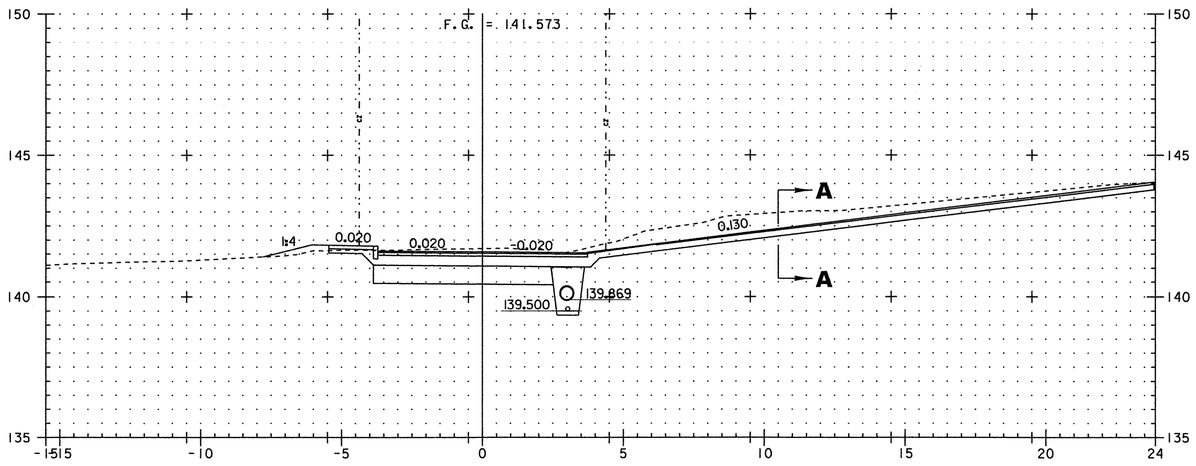

ah 15+068 DR RT

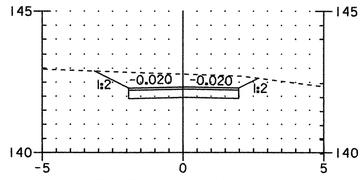

SECTION A - A
DRIVE @ ah 15+068 RT

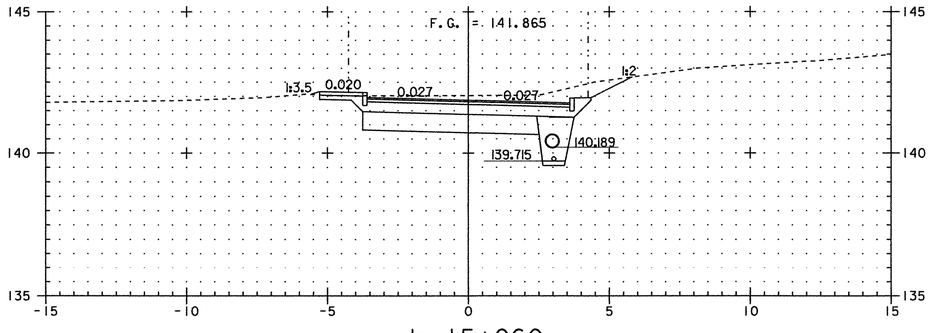

ah 15+060

PROJECT NAME: FRANKLIN	
PROJECT NUMBER: STP 0301(18)	
FILE NAME: ...85c060\design\dc060x12.dgn	PLOT DATE: 20-MAR-2003
PROJECT LEADER: DELLASANTA	DRAWN BY: SQUAD B
DESIGNED BY: SQUAD B	CHECKED BY: SQUAD B
IPARM FILE NAME: (2)dc060x03.I	SHEET 47 OF 60

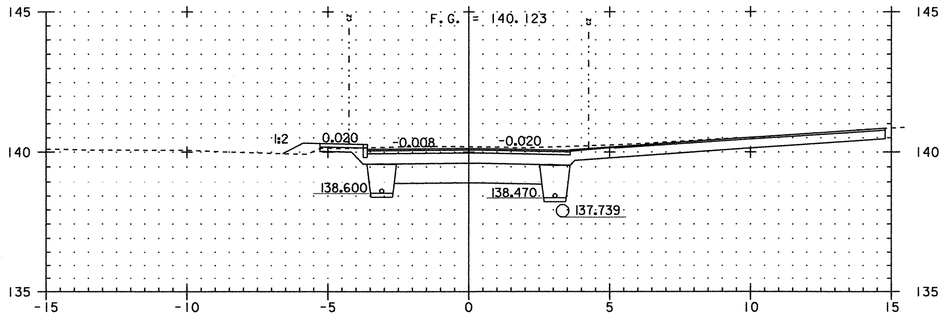

ah 15+102 DR RT

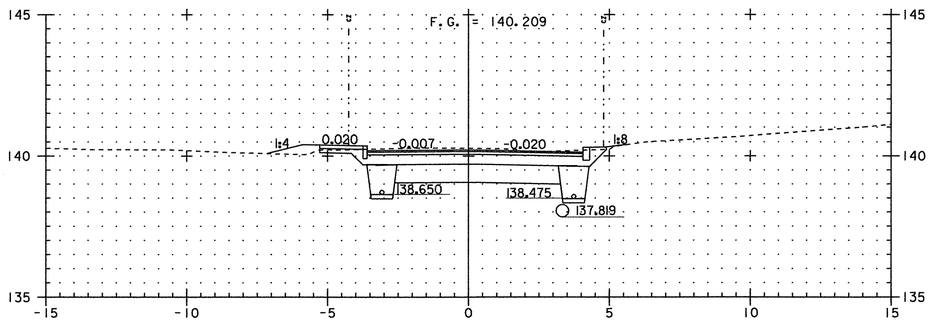

ah 15+100

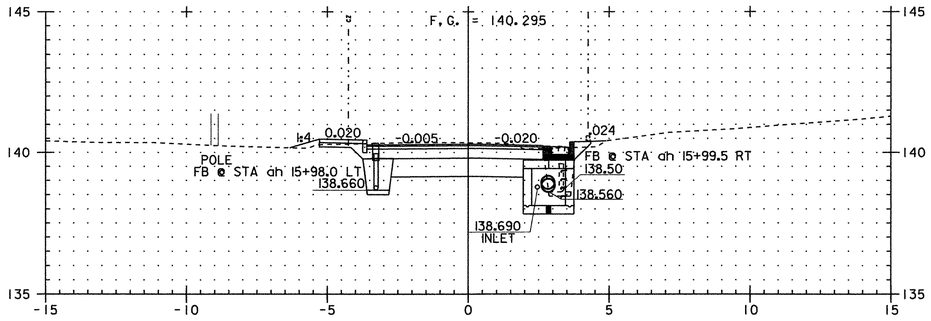

ah 15+098

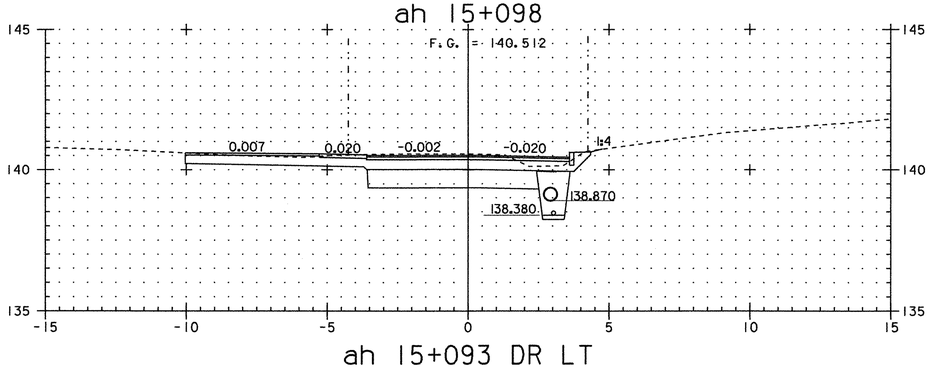

ah 15+093 DR LT

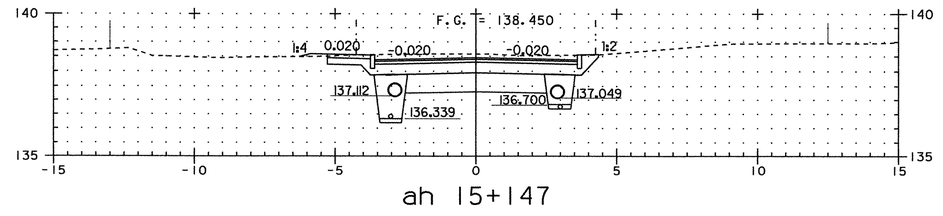

ah 15+147

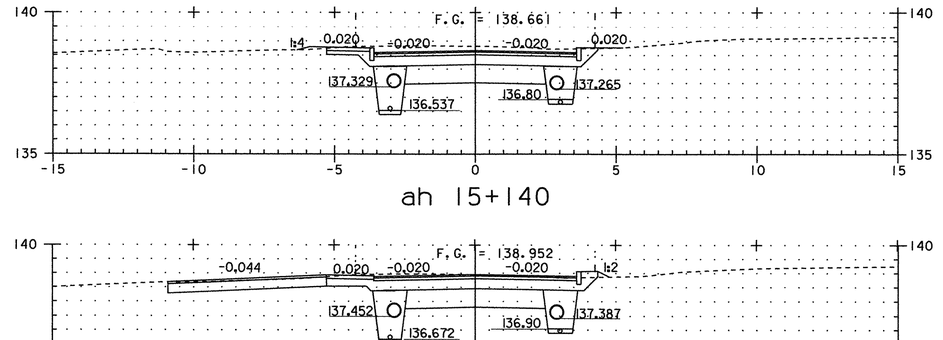

ah 15+140

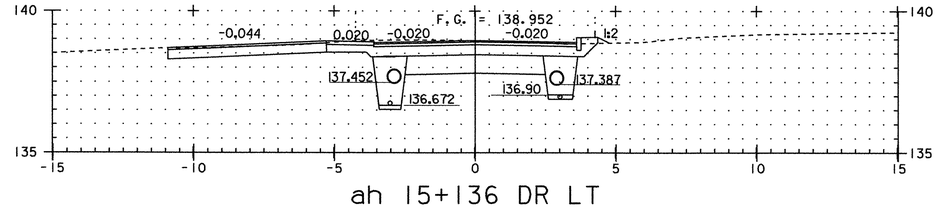

ah 15+136 DR LT

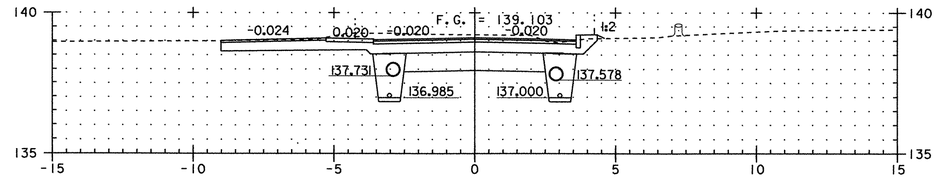

ah 15+127 DR LT

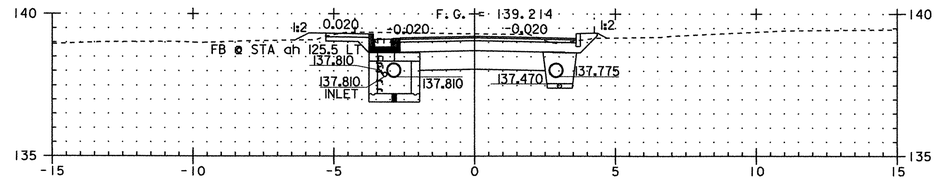

ah 15+124

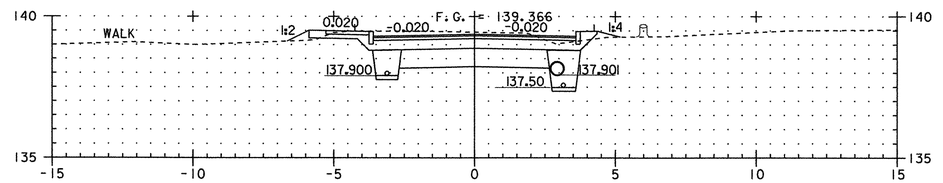

ah 15+120

0 2 4 6 8 10
SCALE 1:100

PROJECT NAME: FRANKLIN
PROJECT NUMBER: STP 0301(18)

FILE NAME: ...85c060\design\dc060xl2.dgn
PROJECT LEADER: DELLASANTA
DESIGNED BY: SQUAD B
IPARM FILE NAME: (2)dc060x04.i

PLOT DATE: 20-MAR-2003
DRAWN BY: SQUAD B
CHECKED BY: SQUAD B
SHEET 48 OF 60

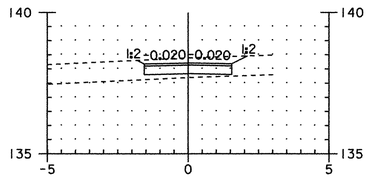

SECTION A - A
DRIVE @ ah 15+160.3 RT

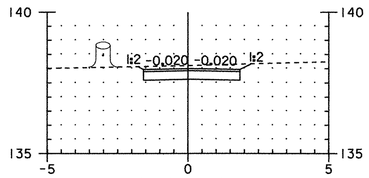

SECTION A - A
DRIVE @ ah 15+168 RT

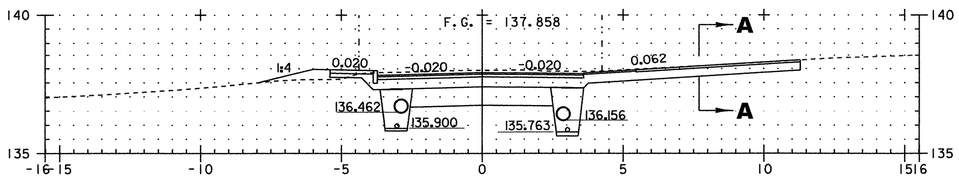

ah 15+168 DR RT

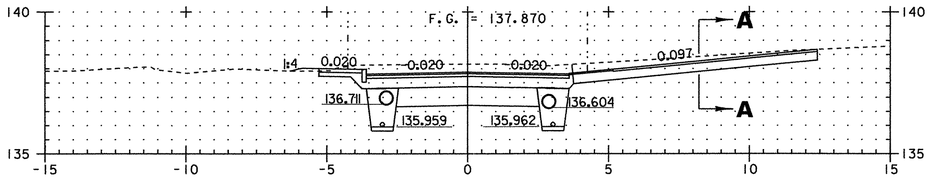

ah 15+160.3 DR RT

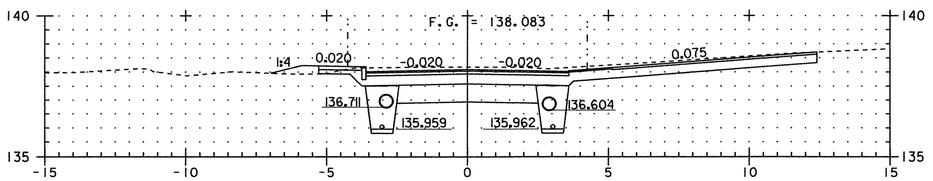

ah 15+160

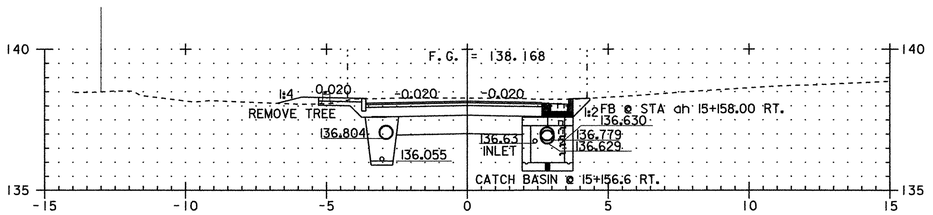

ah 15+157

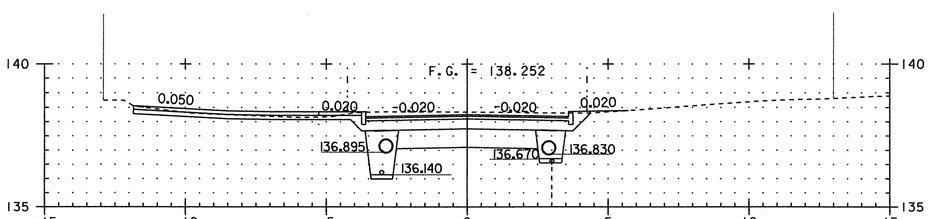

ah 15+154 WALK LT

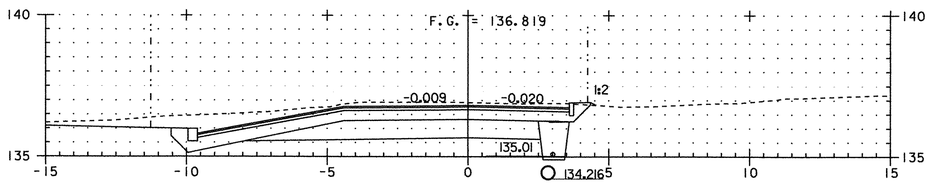

ah 15+202

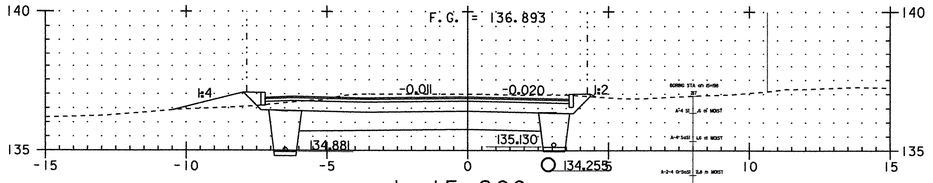

ah 15+200

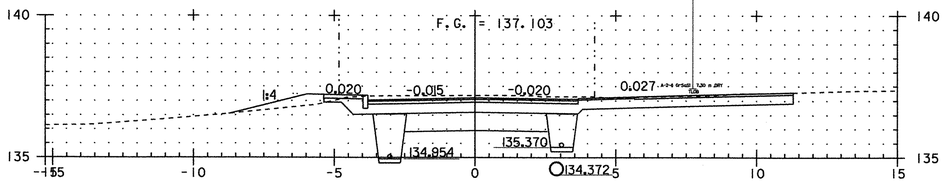

ah 15+194 DR RT

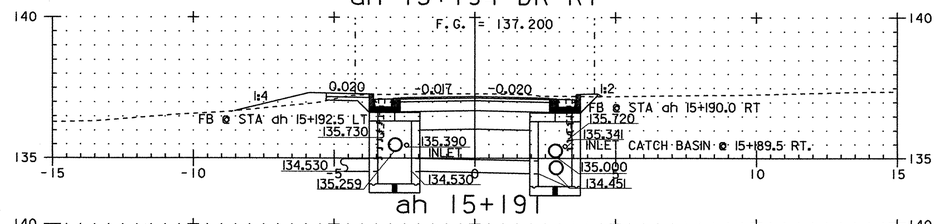

ah 15+191

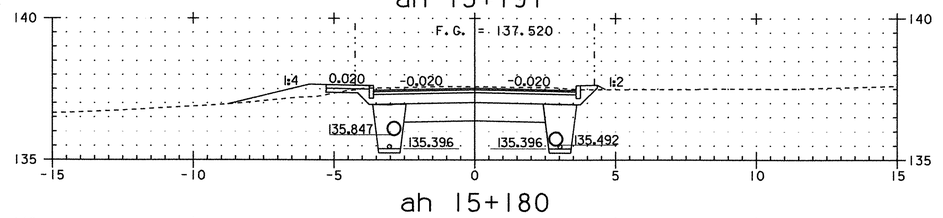

ah 15+180

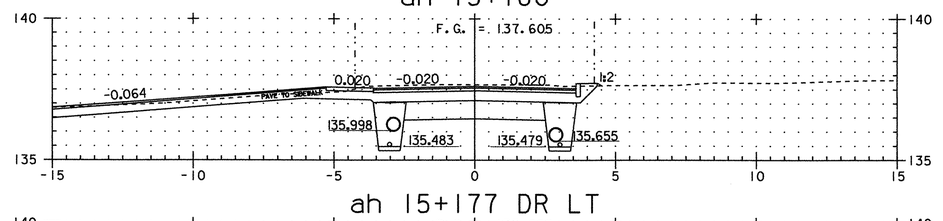

ah 15+177 DR LT

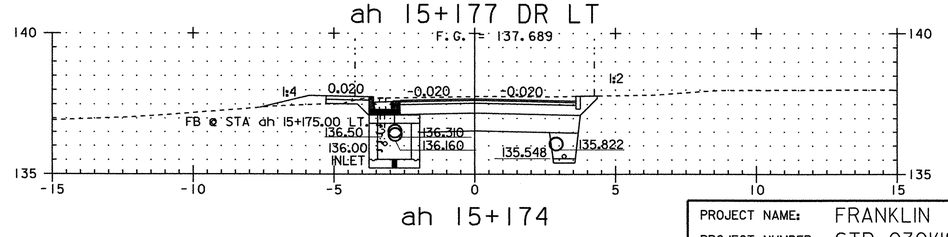

ah 15+174

0 2 4 6 8 10
SCALE 1:100

PROJECT NAME: FRANKLIN
PROJECT NUMBER: STP 0301(18)

FILE NAME: ...85c060\design\dc060xl2.dgn
PROJECT LEADER: DELLASANTA
DESIGNED BY: SQUAD B
IPARM FILE NAME: (2)dc060x05.i

PLOT DATE: 20-MAR-2003
DRAWN BY: SQUAD B
CHECKED BY: SQUAD B
SHEET 49 OF 60

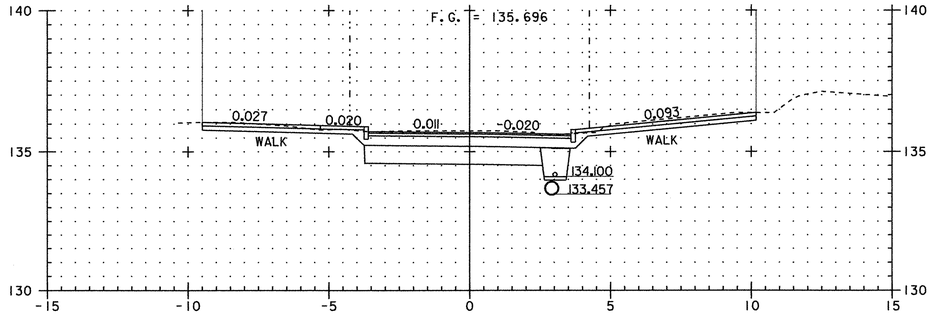

ah 15+227 WALK LT & RT

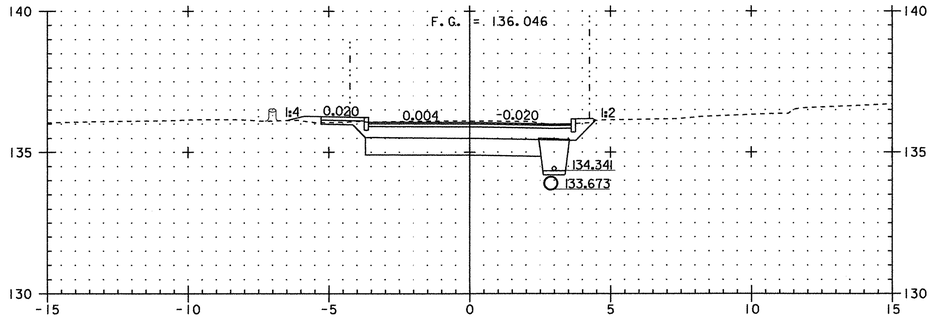

ah 15+220

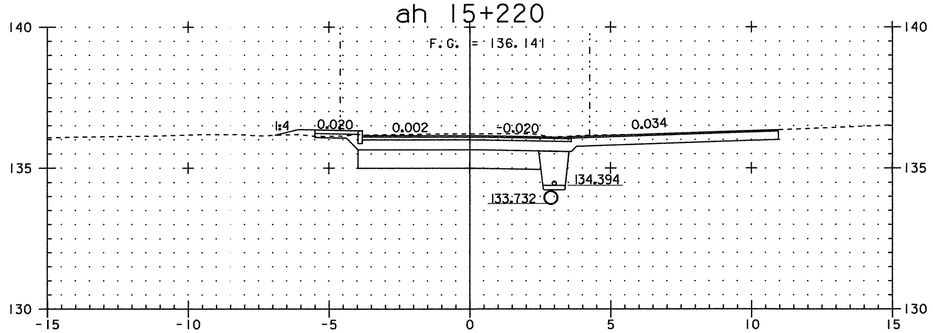

ah 15+218 RT RT

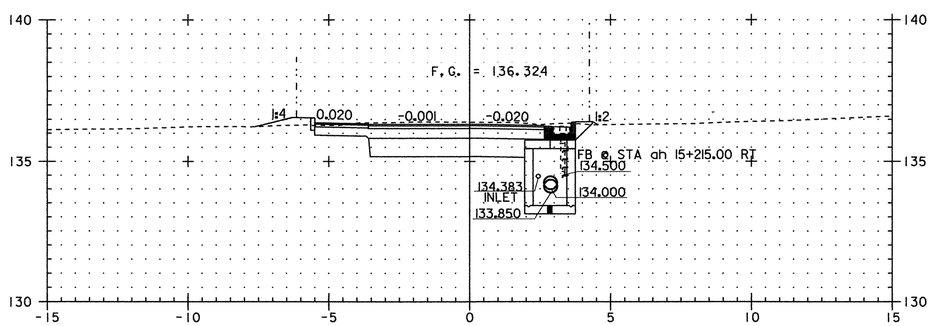

ah 15+214

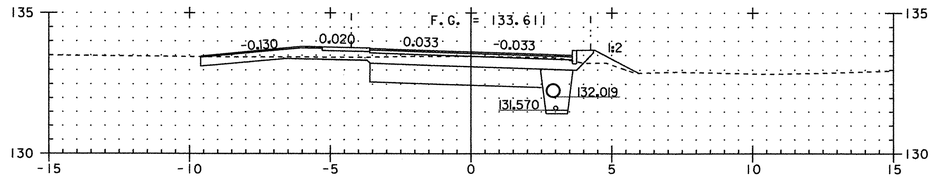

ah 15+268 DR LT

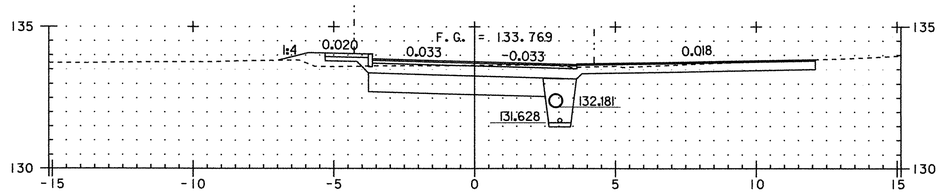

ah 15+264 DR RT

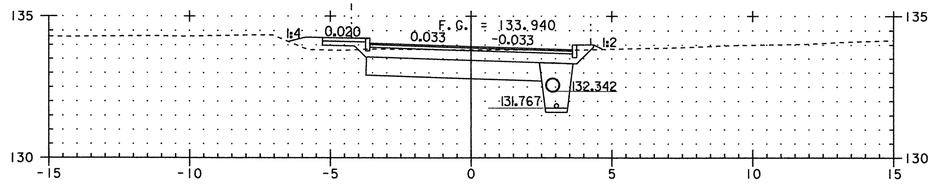

ah 15+260

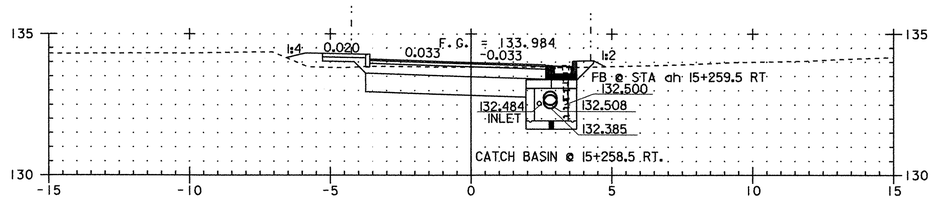

ah 15+259

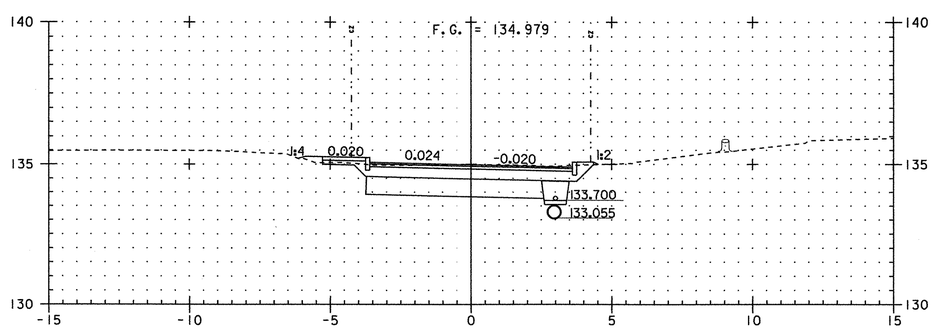

ah 15+240

0 2 4 6 8 10
SCALE 1:100

PROJECT NAME: FRANKLIN	
PROJECT NUMBER: STP 0301(18)	
FILE NAME: ...85c060\design\dc060xl2.dgn	PLOT DATE: 20-MAR-2003
PROJECT LEADER: DELLASANTA	DRAWN BY: SQUAD B
DESIGNED BY: SQUAD B	CHECKED BY: SQUAD B
IPARM FILE NAME: (2)dc060x06.I	SHEET 50 OF 60

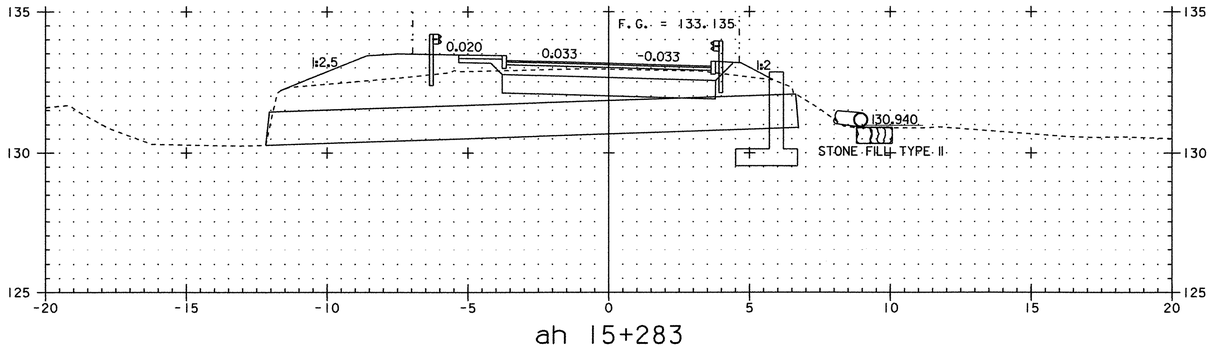

ah 15+283

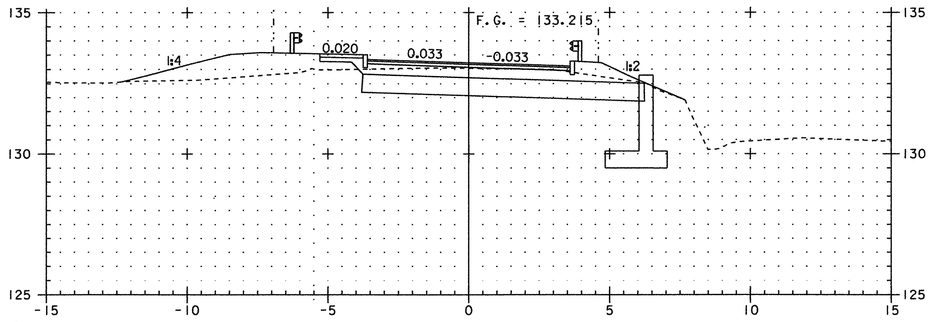

ah 15+280

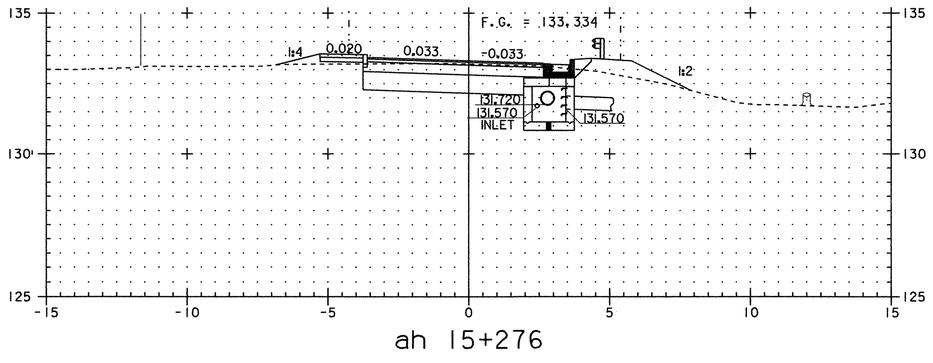

ah 15+276

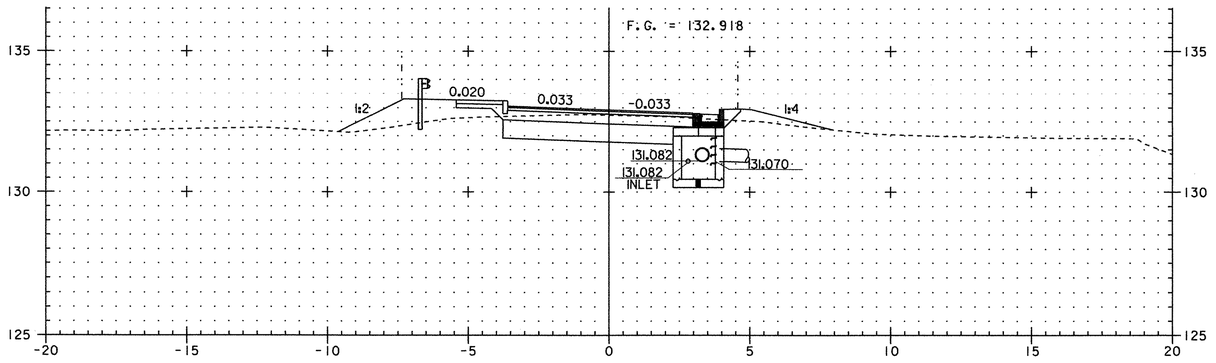

ah 15+293

0 2 4 6 8 10
SCALE 1:100

PROJECT NAME: FRANKLIN	
PROJECT NUMBER: STP 0301(18)	
FILE NAME: ...85c060\design\dc060xl2.dgn	PLOT DATE: 20-MAR-2003
PROJECT LEADER: DELLASANTA	DRAWN BY: SQUAD B
DESIGNED BY: SQUAD B	CHECKED BY: SQUAD B
IPARM FILE NAME: (2)dc060x07.i	SHEET 51 OF 60

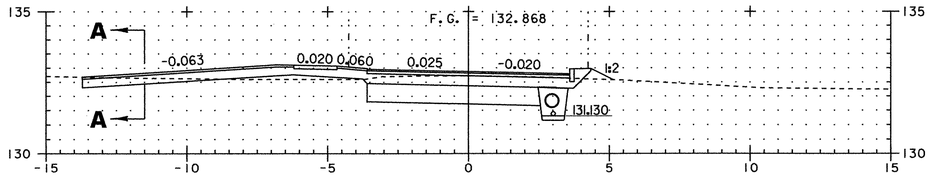

ah 15+333 DR LT

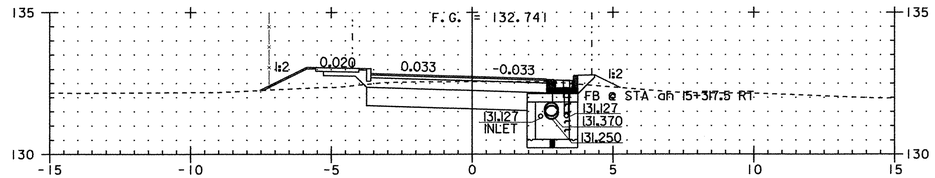

ah 15+320

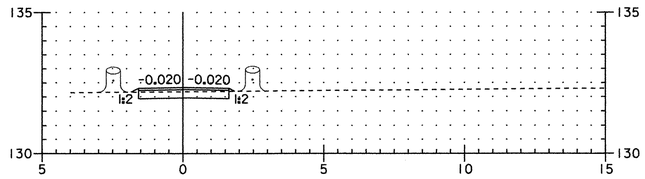

SECTION A - A
DRIVE @ ah 15+316 RT

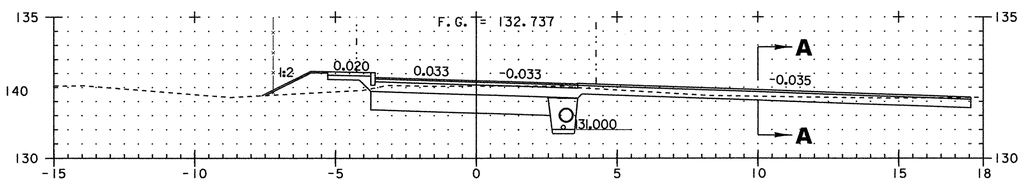

ah 15+316 DR RT

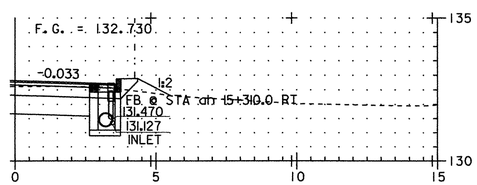

ah 15+311 DI RT

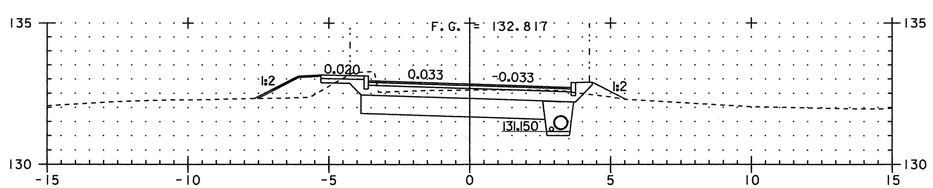

ah 15+300

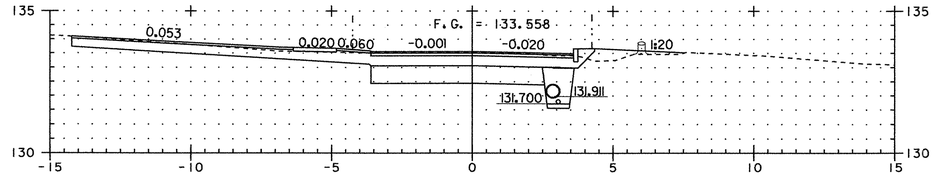

ah 15+360 DR LT

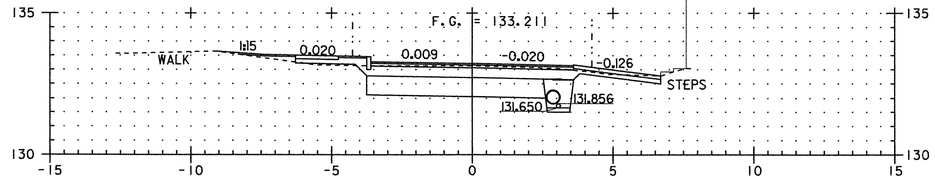

ah 15+349 WALK RT

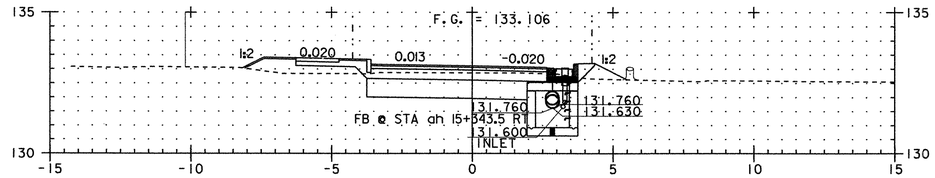

ah 15+345

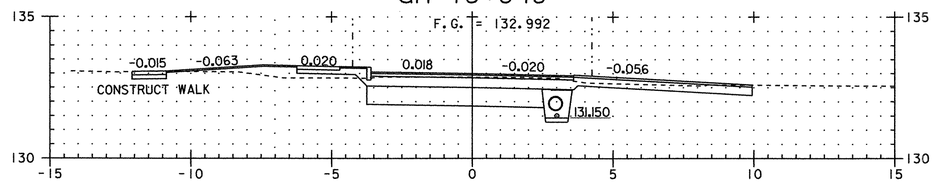

ah 15+340

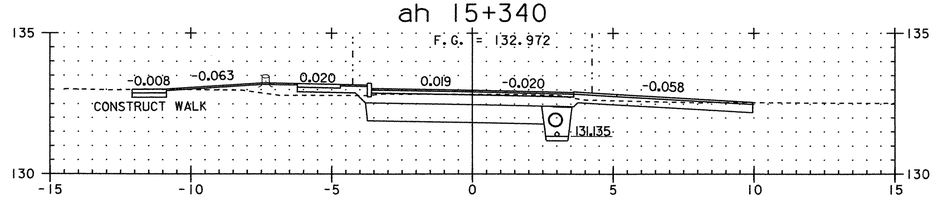

ah 15+339 DR RT

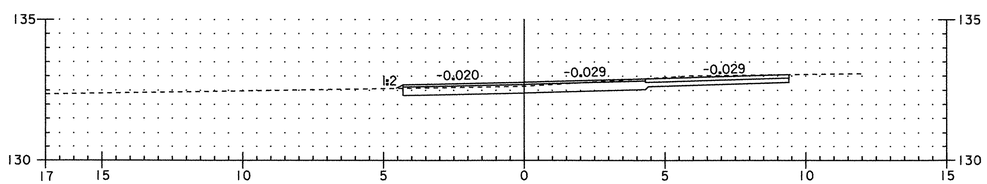

SECTION A - A
DRIVE @ ah 15+333 LT

0 2 4 6 8 10
SCALE 1:100

PROJECT NAME: FRANKLIN	
PROJECT NUMBER: STP 0301(18)	
FILE NAME: ...85c060\design\dc060xl2.dgn	PLOT DATE: 20-MAR-2003
PROJECT LEADER: DELLASANTA	DRAWN BY: SQUAD B
DESIGNED BY: SQUAD B	CHECKED BY: SQUAD B
IPARM FILE NAME: (2)dc060x08.i	SHEET 52 OF 60

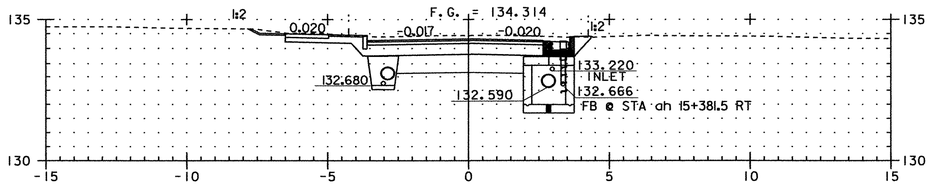

ah 15+383

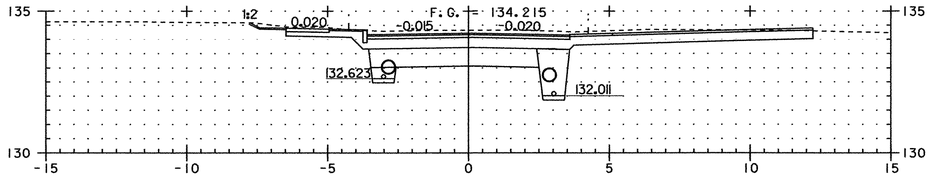

ah 15+380

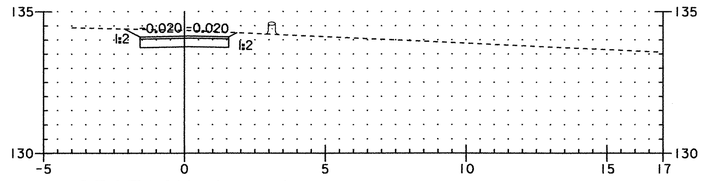

SECTION A - A
DRIVE @ ah 15+379 RT

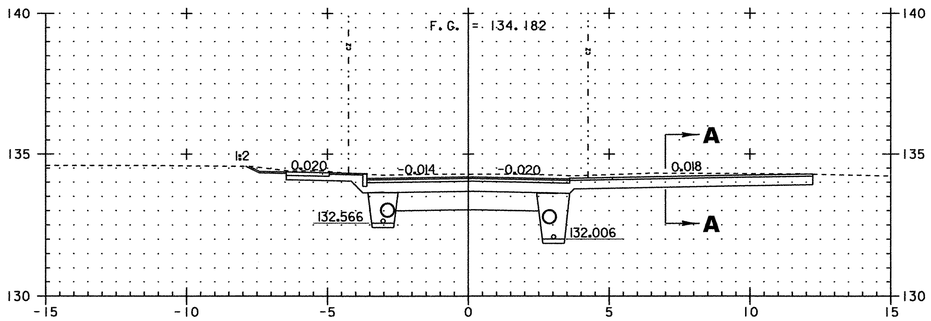

ah 15+379 DR RT

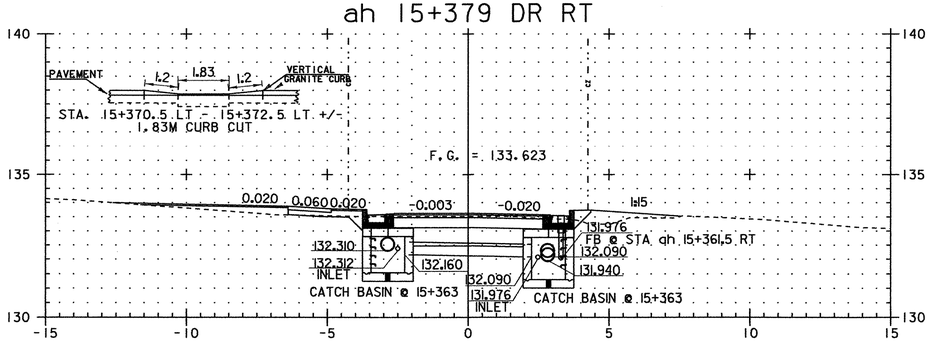

ah 15+362

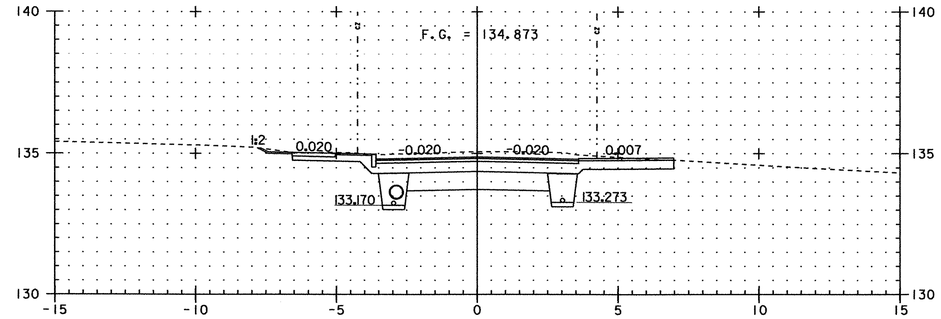

ah 15+400
DR RT

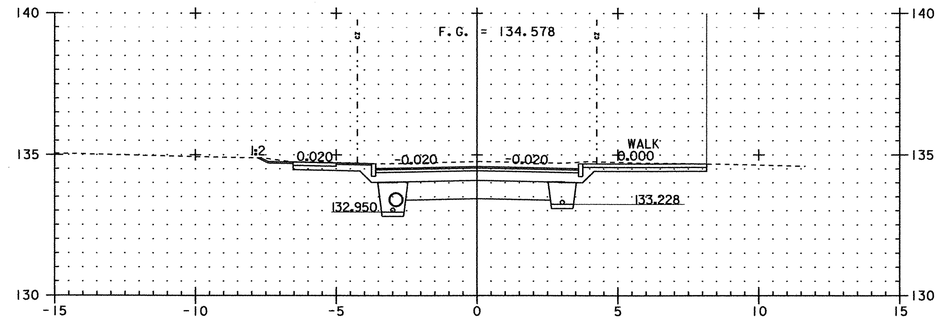

ah 15+391 WALK RT

0 2 4 6 8 10
SCALE 1:100

PROJECT NAME:	FRANKLIN
PROJECT NUMBER:	STP 0301(18)
FILE NAME: ...85c060\design\dc060x12.dgn	PLOT DATE: 20-MAR-2003
PROJECT LEADER: DELLASANTA	DRAWN BY: SQUAD B
DESIGNED BY: SQUAD B	CHECKED BY: SQUAD B
IPARM FILE NAME: (2)dc060x09.I	SHEET 53 OF 60

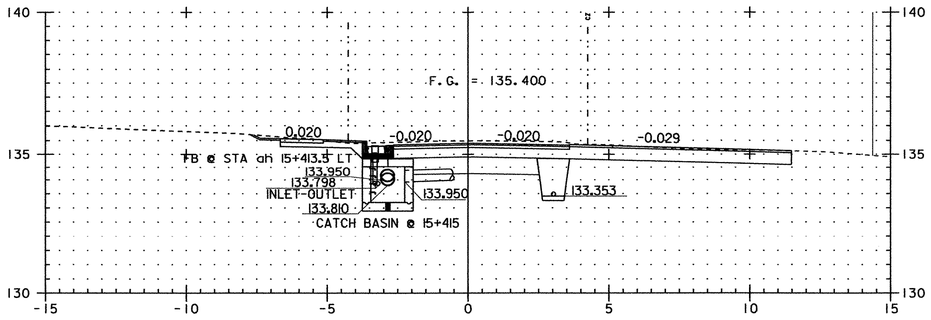

ah 15+416 DR RT

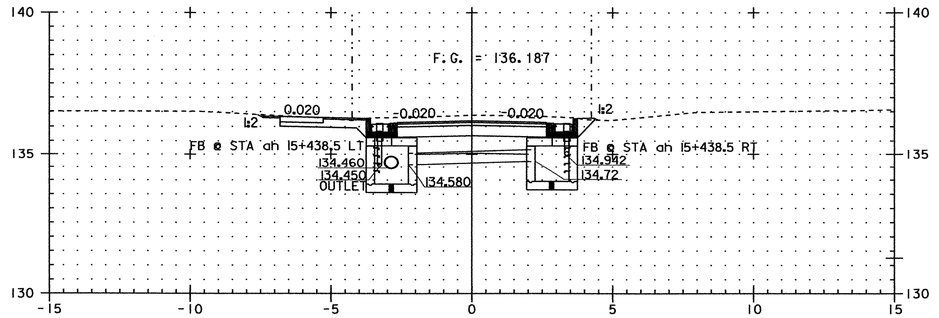

ah 15+440

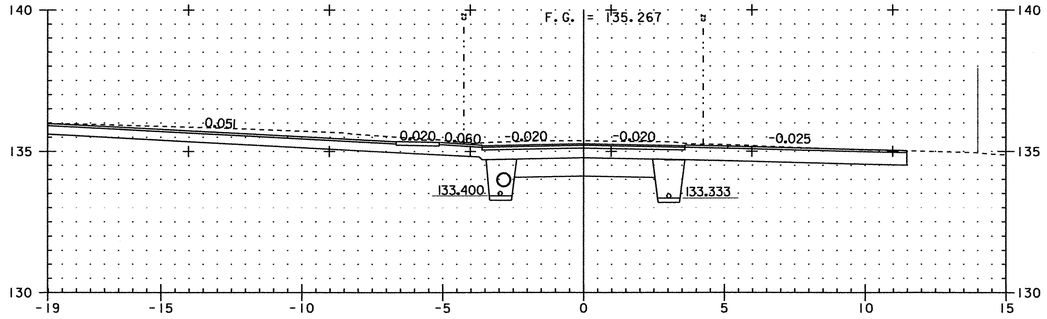

ah 15+412 DR LT

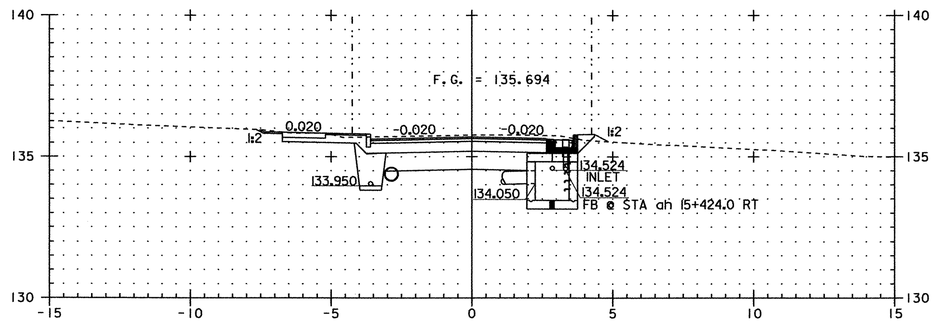

ah 15+425

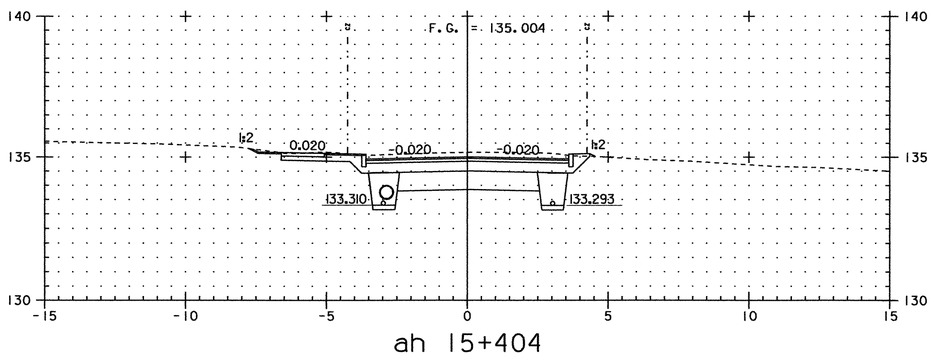

ah 15+404

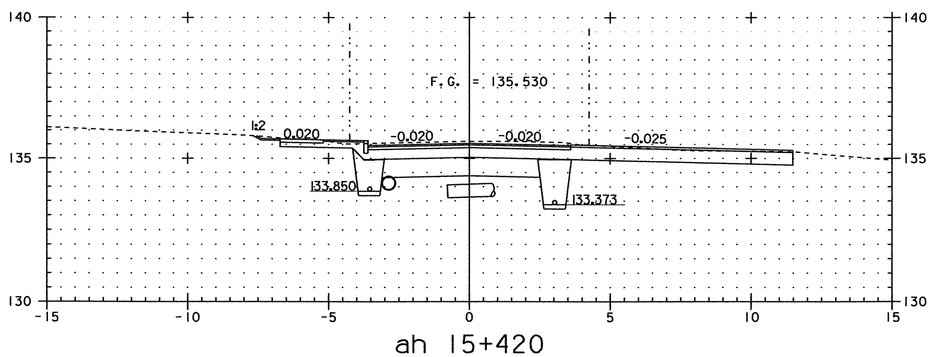

ah 15+420

0 2 4 6 8 10
SCALE 1:100

PROJECT NAME: FRANKLIN	
PROJECT NUMBER: STP 0301(18)	
FILE NAME: ...85c060\design\dc060xl2.dgn	PLOT DATE: 20-MAR-2003
PROJECT LEADER: DELLASANTA	DRAWN BY: SQUAD B
DESIGNED BY: SQUAD B	CHECKED BY: SQUAD B
IPARM FILE NAME: (2)dc060xl0.i	SHEET 54 OF 60

Metric

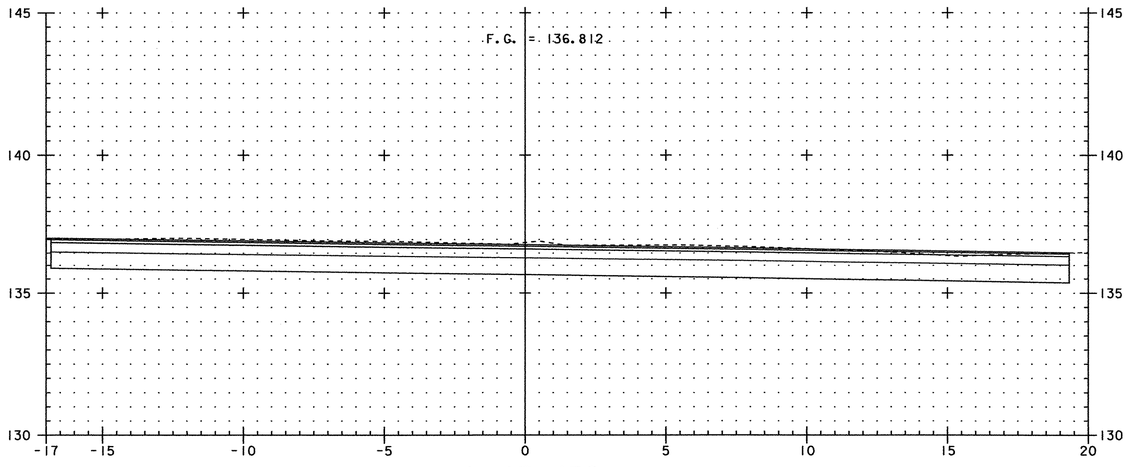

ah 15+459

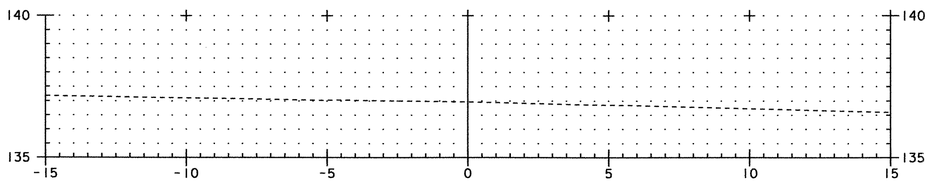

ah 15+464.13
END PROJECT

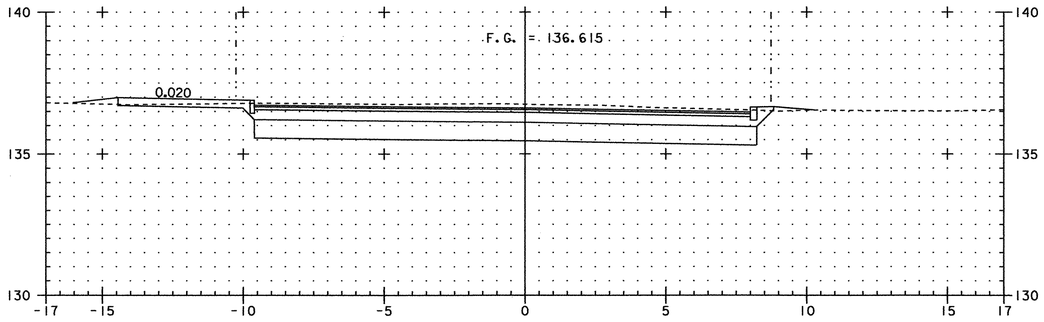

ah 15+453

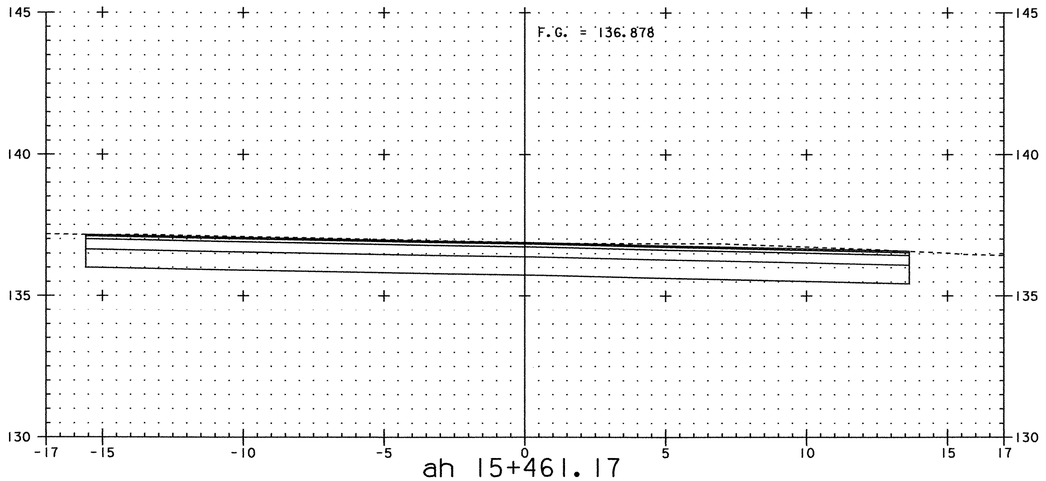

ah 15+461.17
MATCH EXISTING PAVEMENT

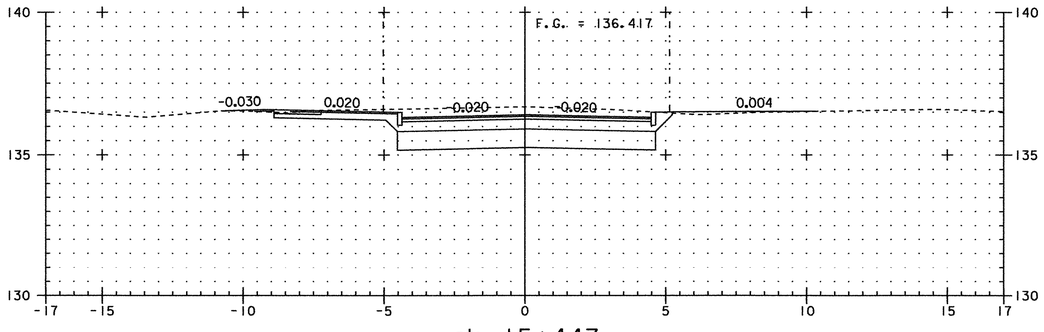

ah 15+447

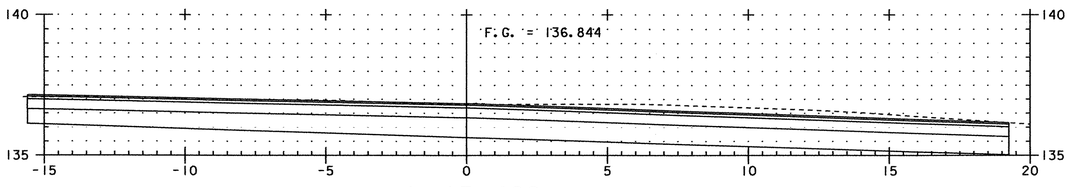

ah 15+460

0 2 4 6 8 10
SCALE 1:100

PROJECT NAME: FRANKLIN	
PROJECT NUMBER: STP 0301(18)	
FILE NAME: ...85c060\design\dc060xl2.dgn	PLOT DATE: 20-MAR-2003
PROJECT LEADER: DELLASANTA	DRAWN BY: SQUAD B
DESIGNED BY: SQUAD B	CHECKED BY: SQUAD B
IPARM FILE NAME: (2)dc060xll.i	SHEET 55 OF 60

TH #16 SECTIONS

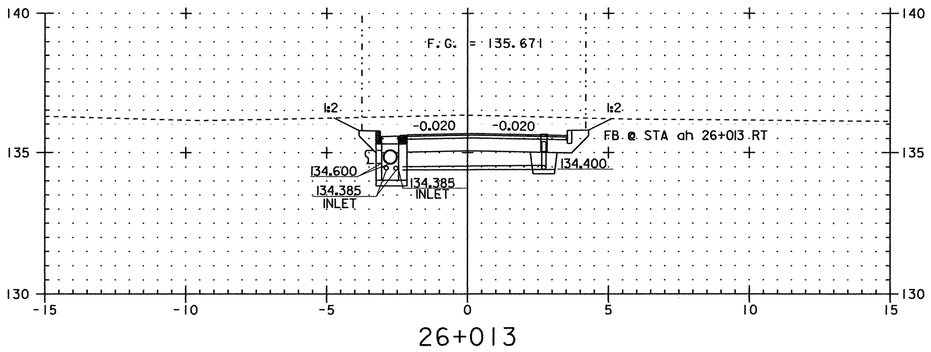

26+013

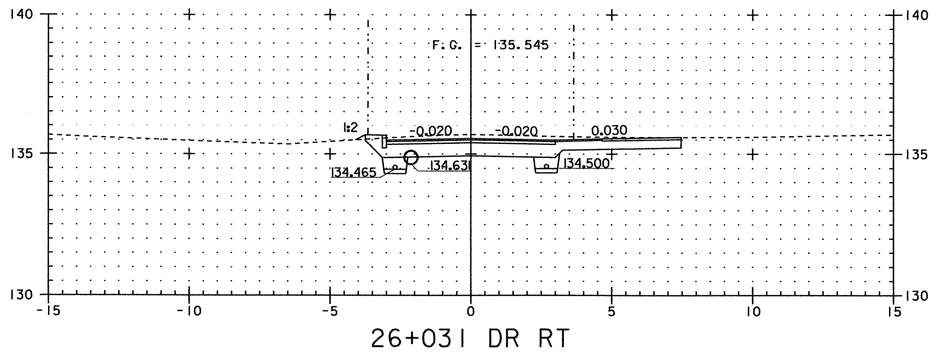

26+031 DR RT

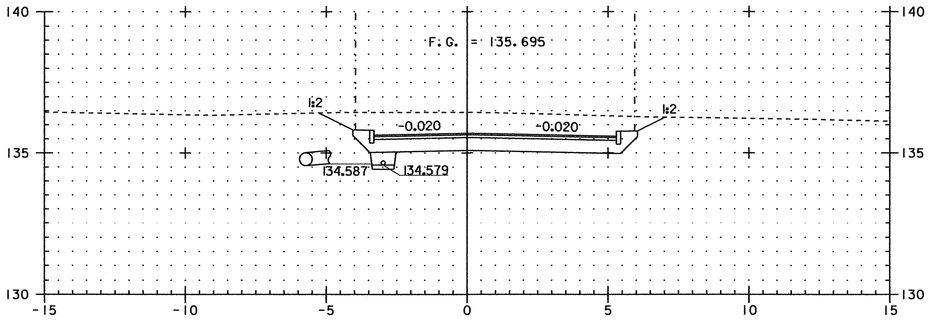

26+010
BEGIN SIDE LINE CONSTRUCTION

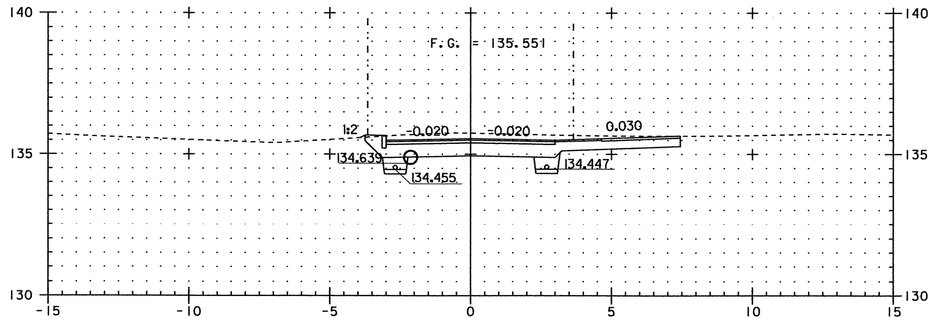

26+030

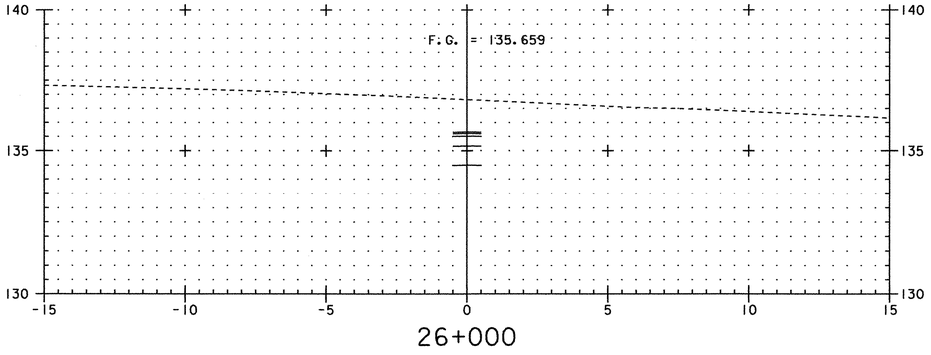

26+000

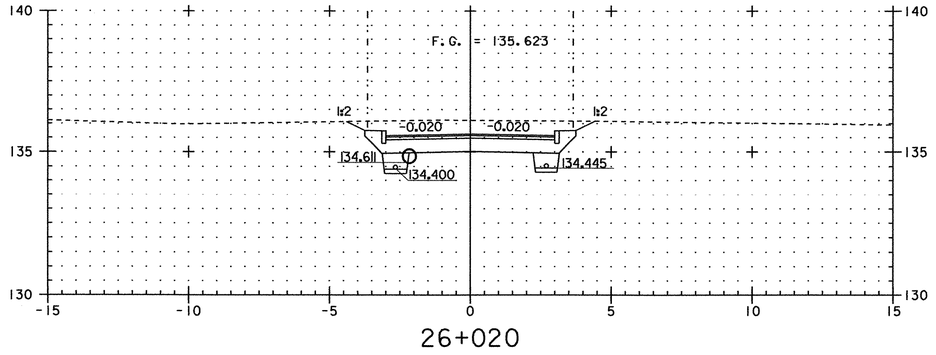

26+020

0 2 4 6 8 10
SCALE 1:100

PROJECT NAME: FRANKLIN	
PROJECT NUMBER: STP 0301(18)	
FILE NAME: ...85c060\design\dc060x12.dgn	PLOT DATE: 20-MAR-2003
PROJECT LEADER: DELLASANTA	DRAWN BY: SQUAD B
DESIGNED BY: SQUAD B	CHECKED BY: SQUAD B
IPARM FILE NAME: (2)dc060x12.i	SHEET 56 OF 60

TH #16 SECTIONS

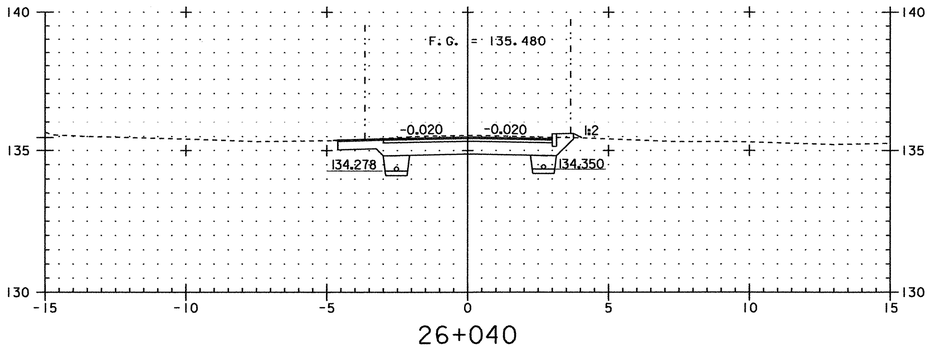

26+040

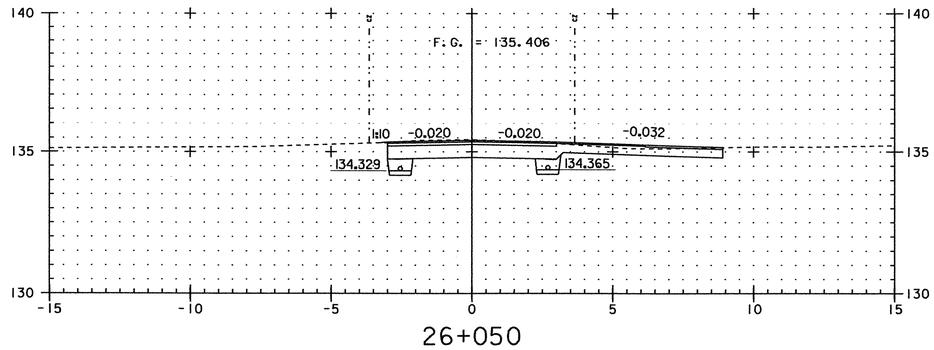

26+050
DR RT

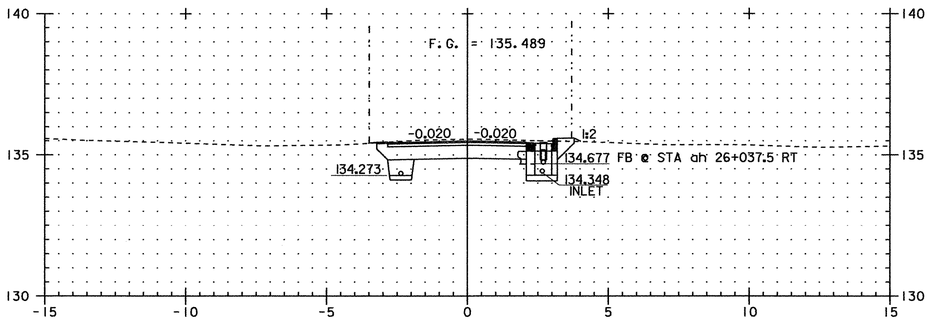

26+039

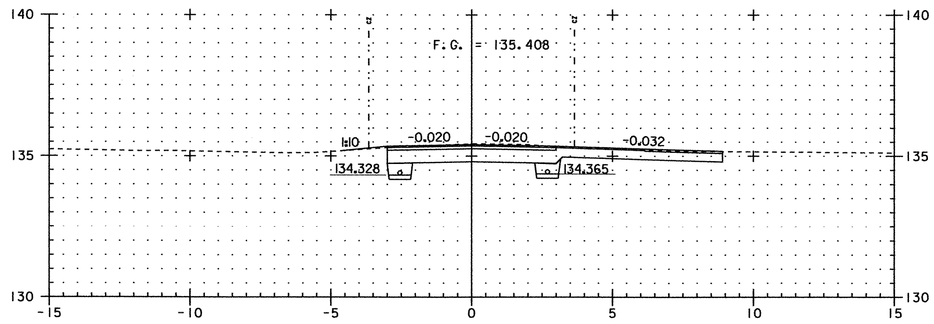

26+050

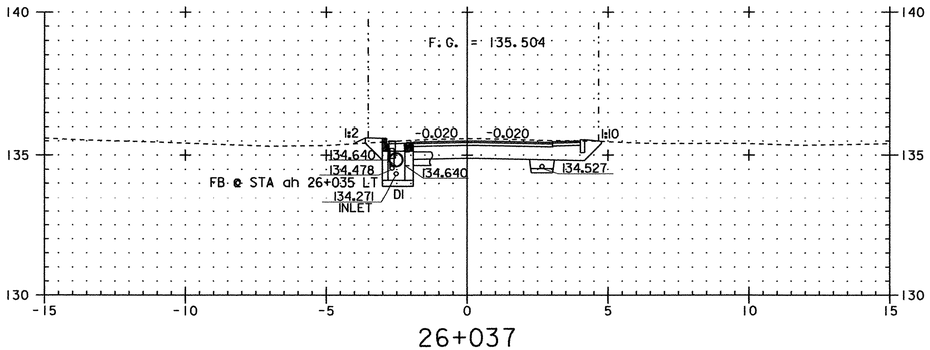

26+037

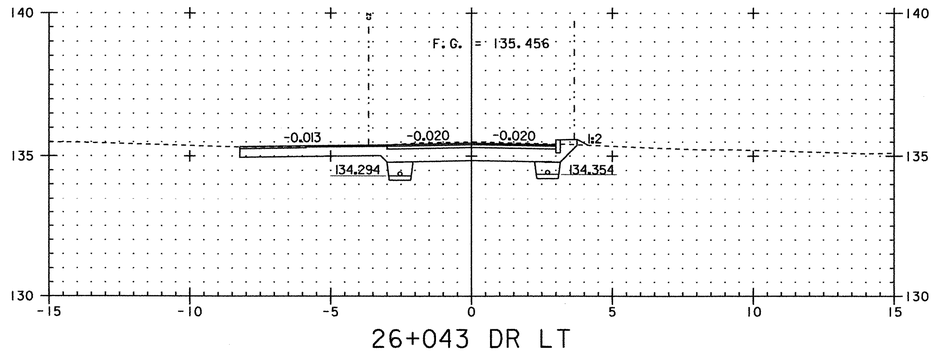

26+043 DR LT

0 2 4 6 8 10
SCALE 1:100

PROJECT NAME: FRANKLIN
PROJECT NUMBER: STP 0301(18)

FILE NAME: ...85c060\design\dc060xl2.dgn
PROJECT LEADER: DELLASANTA
DESIGNED BY: SQUAD B
IPARM FILE NAME: (2)dc060xl3.i

PLOT DATE: 20-MAR-2003
DRAWN BY: SQUAD B
CHECKED BY: SQUAD B
SHEET 57 OF 60

TH #16 SECTIONS

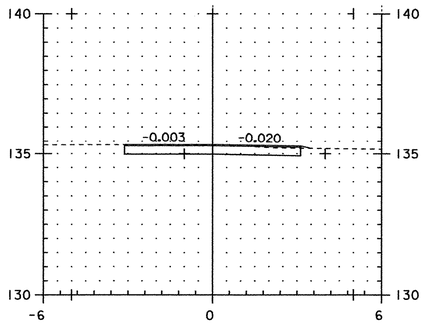

TH #16
DRIVE @ 26+043 LT
5M BACK FROM ℄

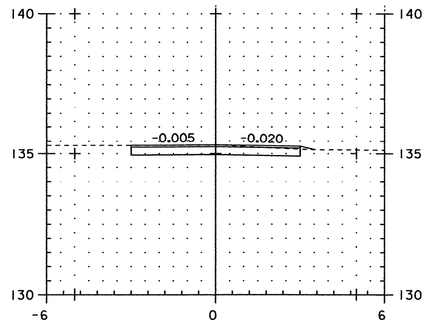

TH #16
DRIVE @ 26+043 LT
8M BACK FROM ℄

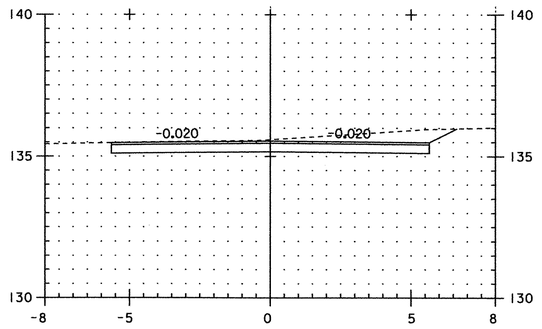

TH #16
DRIVE @ 26+030 RT
5M BACK FROM ℄

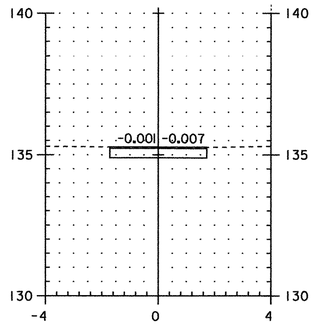

TH #16
DRIVE @ 26+050 RT
5M BACK FROM ℄

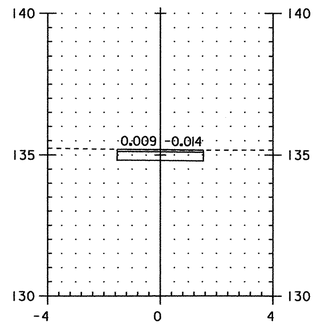

TH #16
DRIVE @ 26+050 RT
8M BACK FROM ℄

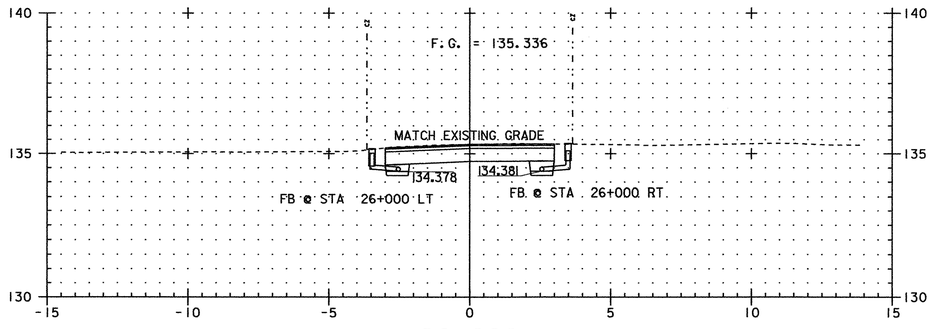

26+060

0 2 4 6 8 10
SCALE 1:100

PROJECT NAME: FRANKLIN	
PROJECT NUMBER: STP 0301(18)	
FILE NAME: ...85c060\design\dc060x12.dgn	PLOT DATE: 20-MAR-2003
PROJECT LEADER: DELLASANTA	DRAWN BY: SQUAD B
DESIGNED BY: SQUAD B	CHECKED BY: SQUAD B
IPARM FILE NAME: (2)dc060x14.1	SHEET 58 OF 60

at locations which may be in the immediate vicinity of underground utilities.

STA. 0+43.93 ORSE IN LEFT BANK OF BROOK, ELEV. = 452.93'

8" IN-LINE GATE VALVE STA. 10+38A

3/4" COPPER LIBERTY TYPE S BRICK

COPPER POST OFFICE

3/4" GALV. GOOW TYPE S NIP

3/4" COPPER GARAGE TYPE S NIP

3/4" COPPER LOTHIAN TYPE S NIP

COPPER PIERCE 2 GW NIP

8"x8"x8" TEE W/2 GATE VALVES STA. 18+32 AND 18+00C

LOTHIAN TYPE S NIP

TATRO TYPE S NIP

NEW HYDRANT STA. 18+81A 4"L

8"x10" REDUCER STA. 19+26A

NEW 10" IN-LINE GATE VALVE STA. 19+32A

BISHOP TYPE S NIP

3/4" COPPER

3/4" COPPER BAILEY TYPE S NIP

FIRE DEPARTMENT

3/4" COPPER

3/4" COPPER WELLHOUSE 2500 NIP

3/4" COPPER LUCE 2G BRICK NIP

8"x8"x8" TEE W/2 GATE VALVES STA. 13+00A AND 21+62B

NEW 8" CL 150 PVC WATERLINE

COPPER TYPE S NIP

3/4 COPPER

COPPER TYPE S NIP

3/4" COPPER CLOCE NIP

BULLS TYPE S NIP

3/4" PLASTIC

WILKINS TYPE S NIP

3/4" COPPER

BAILEY TYPE S NIP

TSM 6" L ORIKE TO 8" L AT STA. 21+49.86'

MAIN STREET

HIGHGATE STREET

GARAGE

METAL GARAGE

TOPHOUSE

PLAN VIEW
LINE "A"
1" = 40'

8"x8"x6" HYDRANT TEE STA. 18+81A

ORIGINAL GROUND

SANDY GRAVEL

3/4" WATER SERVICE SADDLES

5'-6" FALL LOVER

BROWN MOIST SILTY SAND W/ SMALL STONES

8"x8"x6" HYDRANT TEE STA. 18+81A

NEW 10" CL 150 PVC WATERLINE

8"x10" REDUCER STA. 19+26A

NEW 10" IN-LINE GATE VALVE STA. 19+32A

8"x8"x8" TEE W/2 GATE VALVES STA. 18+32 AND 18+00C

NEW 8" CL 150 PVC WATERLINE

3/4" WATER SERVICE SADDLES

NEW 8" IN-LINE GATE VALVE STA. 10+38A

NEW 8" CL 150 PVC WATERLINE

PART OF EXISTING 18" CMP TO BE CROWNED FOR NEW WATERLINE

30" CONCRETE ENCASEMENT (SEE DETAIL)

INSTALL 2" x 24" EXTRUDED POLYSTYRENE FOAM INSULATION STA. 15+67A TO 16+07A & STA. 16+30A TO 16+90A

PROFILE
LINE "A"
H 1"=40'
V 1"=4'

RECORD DRAWING
FEBRUARY 1990

2/20/90	RECORD DRAWING	TCR
DATE 7/6/88	REVISION ADDED GATE VALVE STA. 18+95A	BY AS

FRANKLIN FIRE DISTRICT No. 1
FRANKLIN, VERMONT

PLAN and PROFILE
10 + 00A to 21 + 00A

STATE OF VERMONT ALOIS STRANSKY NO. 5393 REGISTERED PROFESSIONAL ENGINEER

SURVEY MRM	Donald L. Hamlin CONSULTING ENGINEERS, INC. Essex Junction, Vermont		SCALE SHOWN
DESIGN AS			DATE 5/24/88
DRAWN JRD			DRW. NO. 2 of 20
CHECKED AS/MCW			59 OF 60
87-110	5813		

1-800-225-4977 prior to any excavation, at locations which may be in the immediate vicinity of underground utilities.

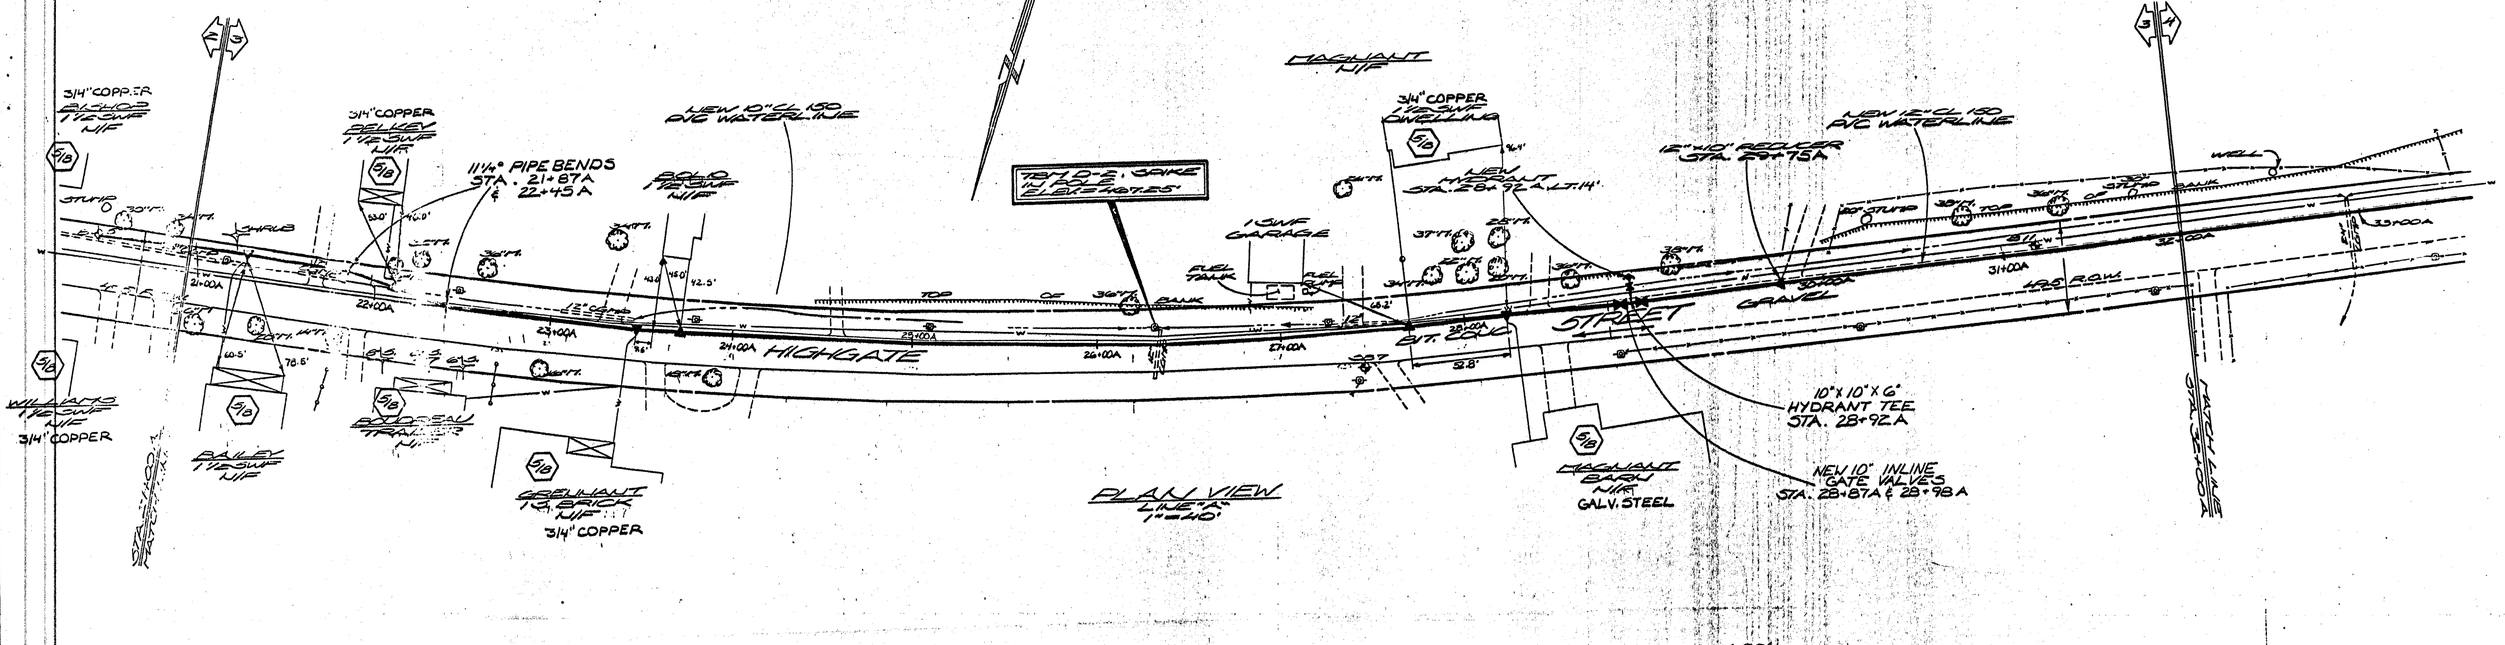

RECORD DRAWING
FEBRUARY 1990

DATE	REVISION	BY
2/20/90	RECORD DRAWING	TCR
7/6/88	ADD GATE VALVES STA. 27+20 & 27+30	AS

FRANKLIN FIRE DISTRICT No. 1
FRANKLIN, VERMONT

PLAN and PROFILE
21 + 00A to 32 + 00A

STATE OF VERMONT — ALOIS STRANSKY — NO. 5393 — REGISTERED PROFESSIONAL ENGINEER

SURVEY MRM	Donald L. Hamlin	SCALE SHOWN
DESIGN AS	CONSULTING ENGINEERS, INC. Essex Junction, Vermont	DATE 5/24/88
DRAWN JRD		DRW. NO. 3 of 20 60 OF 60
CHECKED AS/MCW		

87-110 | 5814

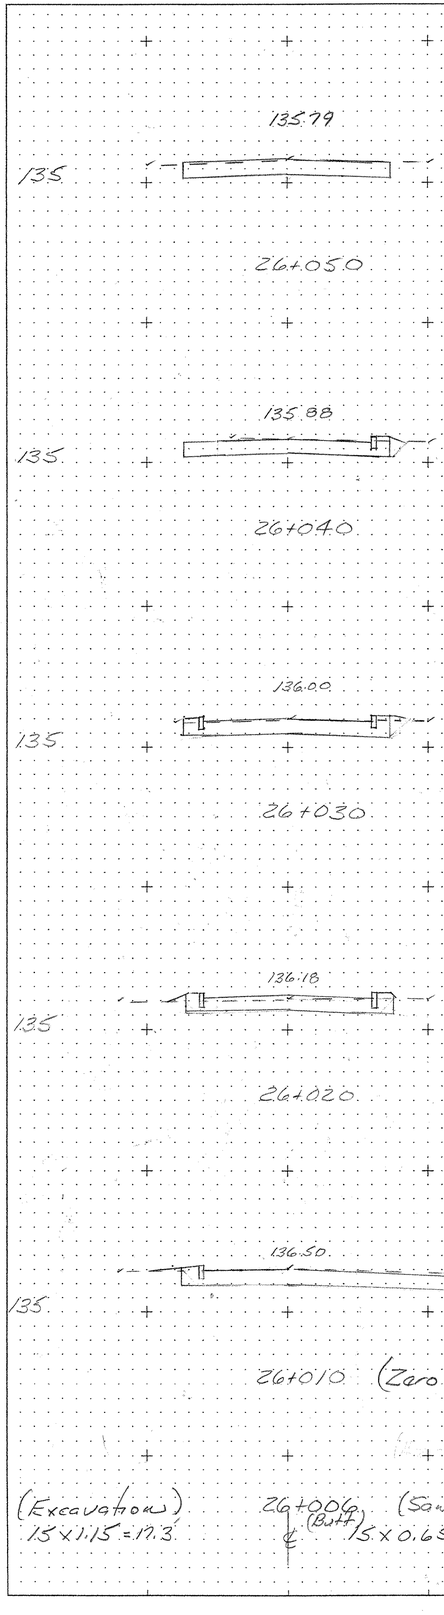

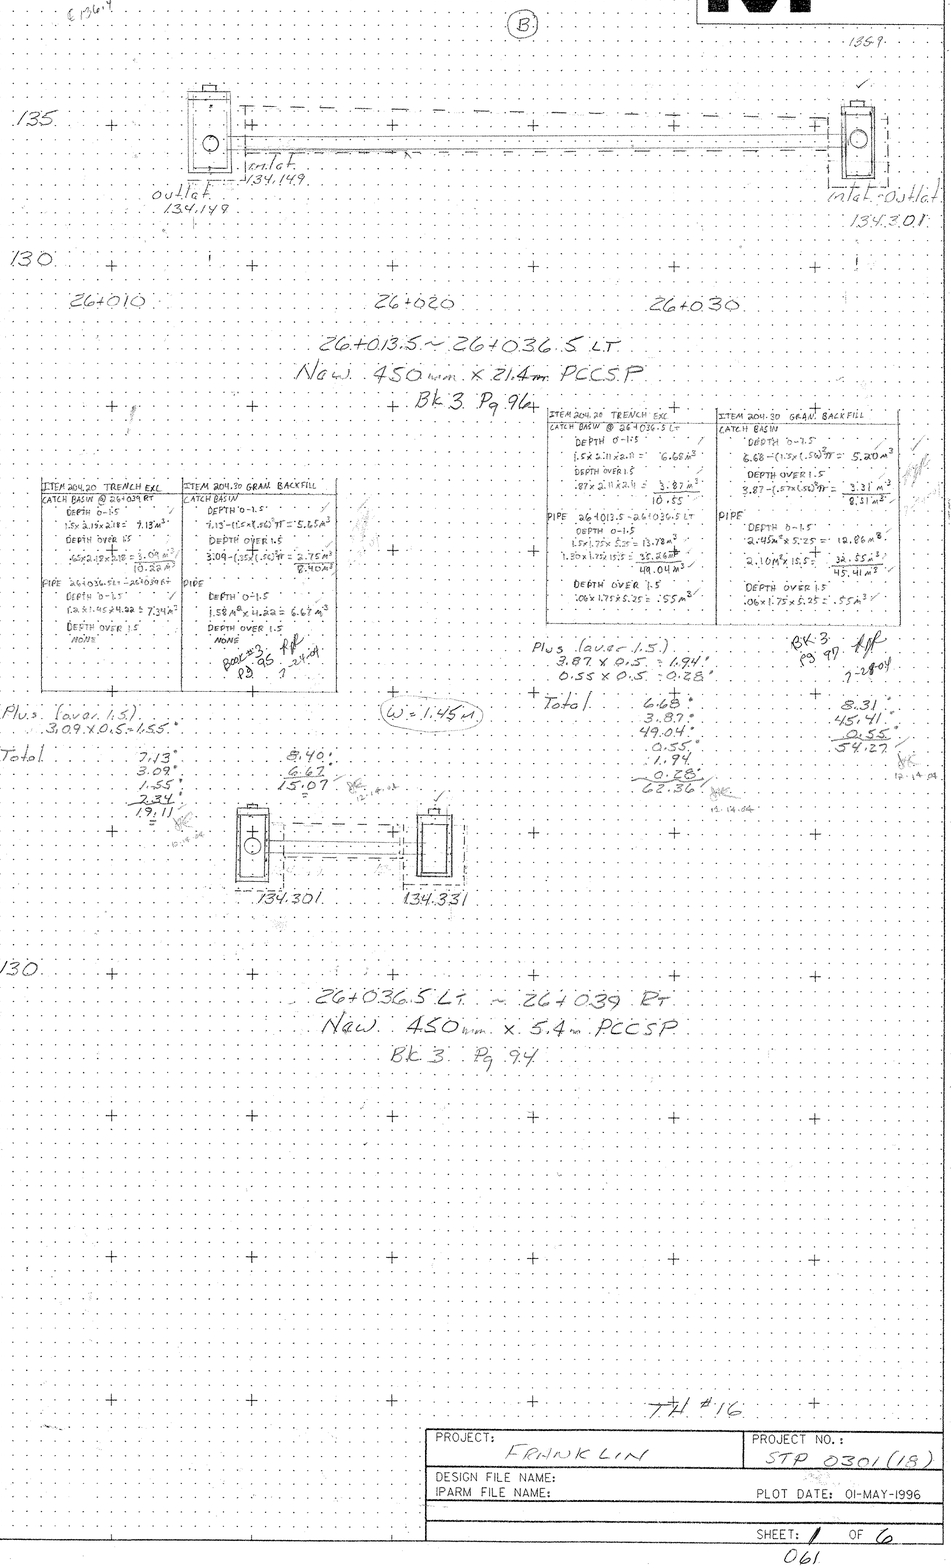

Ø1614

(B)

135.9

134.301

134.331

26+013.5 ~ 26+036.5 LT.
New 450mm x 21.4m PCCSP
Bk 3 Pg 96

ITEM 204.20 TRENCH EXC	
CATCH BASIN @ 26+039 RT	
DEPTH 0-1.5	
1.5x3.15x2.18 =	7.13 m³
DEPTH OVER 1.5	
4.62x1.9x2.18 =	3.09 m³
	10.22 m³
PIPE 26+039.5 RT - 26+039 RT	
DEPTH 0-1.5	
(2.81-1.45)x1.92 =	7.34 m³
DEPTH OVER 1.5	
NONE	

ITEM 204.30 GRAN. BACKFILL	
CATCH BASIN	
DEPTH 0-1.5	
7.13-(1.5x1.50)1T =	5.65 m³
DEPTH OVER 1.5	
3.09-(.5x1.5)1T =	2.75 m³
	8.40 m³
PIPE	
DEPTH 0-1.5	
1.58 m² x 4.22 =	6.67 m³
DEPTH OVER 1.5	
NONE	

Book #3 Pg 95 RP 1-24-04

Plus (over 1.5)
3.09 x 0.5 = 1.55 m³

Total 7.13 m³ / 3.09 m³ / 1.55 m³ / 2.34 m³ / 14.11 m³ = 8.40 m³ / 6.67 m³ / 15.07 m³

W = 1.45 m

ITEM 204.20 TRENCH EXC	
CATCH BASIN @ 26+036.5 LT	
DEPTH 0-1.5	
1.5x2.11x2.0 =	6.68 m³
DEPTH OVER 1.5	
.87x2.11x2.1 =	3.87 m³
	10.55 m³
PIPE 26+013.5 - 26+036.5 LT	
DEPTH 0-1.5	
1.0x1.75x5.25 =	13.78 m³
1.20x1.75x15.5 =	35.26 m³
	49.04 m³
DEPTH OVER 1.5	
.106x1.75x5.25 =	.55 m³

ITEM 204.30 GRAN. BACKFILL	
CATCH BASIN	
DEPTH 0-1.5	
6.68-(1.5x1.50)1T =	5.20 m³
DEPTH OVER 1.5	
3.87-(.5x1.5)1T =	3.31 m³
	8.51 m³
PIPE	
DEPTH 0-1.5	
2.45 m² x 5.25 =	12.86 m³
2.10 m² x 15.5 =	32.55 m³
	45.41 m³
DEPTH OVER 1.5	
.106x1.75x5.25 =	.55 m³

Plus (over 1.5)
3.87 x 0.5 = 1.94 m³
0.55 x 0.5 = 0.28 m³

Bk 3 Pg 99 RP 1-28-04

Total 6.68 m³ / 3.87 m³ / 49.04 m³ / 0.55 m³ / 1.94 m³ / 0.28 m³ / 62.36 m³ = 8.31 m³ / 45.41 m³ / 0.55 m³ / 54.27 m³

26+036.5 LT ~ 26+039 RT
New 450mm x 5.4m PCCSP
Bk 3 Pg 94

77 #16

PROJECT: FRANKLIN	PROJECT NO.: STP 0301(18)
DESIGN FILE NAME: IPARM FILE NAME:	PLOT DATE: 01-MAY-1996
	SHEET: 1 OF 6

061

MTO Metric

ITEM 204.20 TRENCH EXC	
CATCH BASIN @ 15+102.5 RT	
DEPTH 0-1.5	
1.5×2.5a×2.5a = 9.53 M^3	
DEPTH OVER 1.5	
.14×2.5a×2.5a = .89 M^3	
	10.42
PIPE 15+103.1 - 15+155.9 RT	
DEPTH 0-1.5	
.46×1.75×51.85 = 59.89 M^3	
DEPTH OVER 1.5	
NONE	
0.89×1.5 = 1.34	9.53
Total	59.89
	70.26

ITEM 204.30 GRAN. BACKFILL	
CATCH BASIN	
DEPTH 0-1.5	
9.53 - (1.37×1.37)M^3 = 7.17 M^3	
DEPTH OVER 1.5	
.14×2.5a×2.5a = .89 M^3	
	8.06
PIPE	
DEPTH 0-1.5	
1.01 M^2 × 51.85 = 52.37 M^3	
DEPTH OVER 1.5	
NONE	
Total	60.43
	12.14

Bk 3 Pg 67

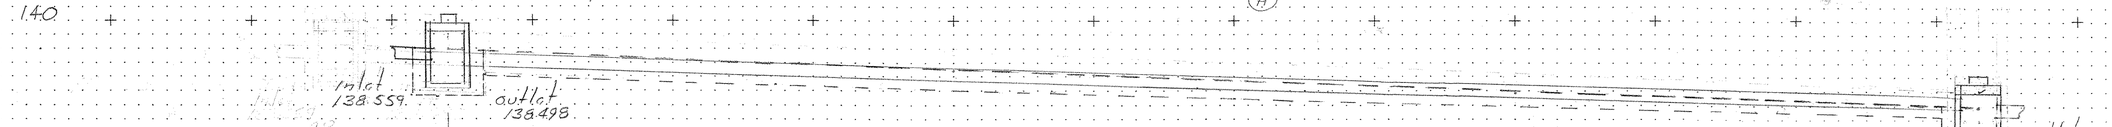

15+103.1 ~ 15+155.9 Rt
New 450mm x ~~525~~ 525 PCCSP
1.63m (68mm x 12mm)

ITEM 204.20 TRENCH EXC	
PIPE 15+032 - 15+045.9 RT	
DEPTH 0-1.5	
.61×1.75×13.2 = 14.1 M^3	
DEPTH OVER 1.5	
NONE	

ITEM 204.30 GRAN. BACKFILL	
PIPE	
DEPTH 0-1.5	
.89 M^2 × 13.2 = 10.46 M^3	
DEPTH OVER 1.5	
NONE	

Bk 83
Pg 61

ITEM 204.20 TRENCH EXC	
CATCH BASIN @ 15+046.5 RT	
DEPTH 0-1.5	
1.14×2.5a×2.5a = 8.89 M^3	
DEPTH OVER 1.5	
NONE	
PIPE 15+047.1 - 15+101.9 RT	
DEPTH 0-1.5	
.78×1.75×53.97 = 77.36 M^3	
DEPTH OVER 1.5	
NONE	
Total	86.19

ITEM 204.30 GRAN. BACKFILL	
CATCH BASIN	
DEPTH 0-1.5	
8.89 - (1.14×1.27)M^3 = 7.0 M^3	
DEPTH OVER 1.5	
NONE	
PIPE	
DEPTH 0-1.5	
1.26 M^2 × 53.97 = 67.98 M^3	
DEPTH OVER 1.5	
NONE	
Total	69.68
	74.89

Bk 3 Pg 65

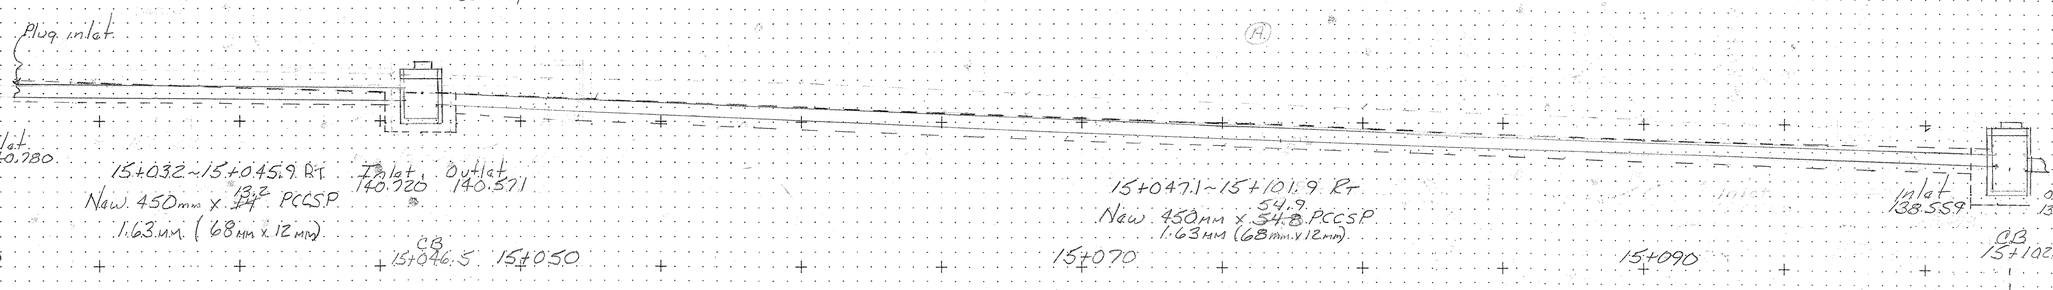

15+032 ~ 15+045.9 Rt
New 450mm x ~~13.2~~ 14 PCCSP
1.63mm (68mm x 12mm)
Inlet 140.720
Outlet 140.571

15+047.1 ~ 15+101.9 Rt
New 450mm x ~~54.8~~ 54.9 PCCSP
1.63mm (68mm x 12mm)

PROJECT: FRANKLIN	PROJECT NO.: STP 0301(18)
DESIGN FILE NAME:	
IPARM FILE NAME:	PLOT DATE: 01-MAY-1996
	SHEET: 2 OF 6

062

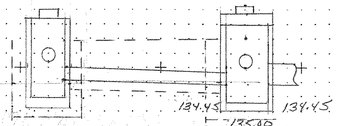

15+191 LT ~ 15+189 LT

New 450mm x 5.8PCCSP
1.63mm (68mm x 12mm)

Bk 3 Pg 80

Item 204.20 Trench Excav.

CB @ 15+191
0-1.5
1.5x2.48x2.48 = 9.2
OB over 1.5
1.15x2.48x2.48 x1.5 = 7.1 10-10
Ppa
0-1.5
1.5x1.75x4.45 = 11.7
over 1.5
0.13x1.75x4.45 x1.5 = 3.5
31.5 m³

Item 209.30 Gr. Struct.

CB @ 15+191
2.48x2.48x2.65 -(174.2x.11x.265) = 11.7

Ppa
1.8x1.75x4.45 = 14.0
25.7 m³

4.6

ITEM 204.20 TRENCH EXC.
CATCH BASIN @ 15+191 LT
DEPTH 0-1.5
1.3x3.55x3.55 = 8.26 m³
DEPTH OVER 1.5
NONE
PIPE 15+190.6 - 15+173.4 LT
DEPTH 0-1.5
.33x1.75x47.4 = 27.37 m³
DEPTH OVER 1.5
NONE
Total 35.63

ITEM 209.30 GRAN. BACKFILL
CATCH BASIN
DEPTH 0-1.5
8.26-(1.05x(.710)²) = 6.46m³
DEPTH OVER 1.5
NONE
PIPE
DEPTH 0-1.5
.56A²x47.4 = 26.54m³
33.00

ITEM 204.20 TRENCH EXC.
CATCH BASIN @ 15+174 LT
DEPTH 0-1.5
1.4x2.48x2.48 = 8.61 m³
DEPTH OVER 1.5
NONE
PIPE 15+174.6 - 15+190.4 LT
DEPTH 0-1.5
.71x1.75x14.6 = 18.19 m²
DEPTH OVER 1.5
NONE
Total 26.75

ITEM 209.30 GRAN. BACKFILL
CATCH BASIN
DEPTH 0-1.5
.92-(1.5x(.710)²) = 6.81m³
DEPTH OVER 1.5
NONE
PIPE
DEPTH 0-1.5
1.05A²x14.6 = 15.77m³
DEPTH OVER 1.5
NONE
22.58

Bk 3 Pg 79

140

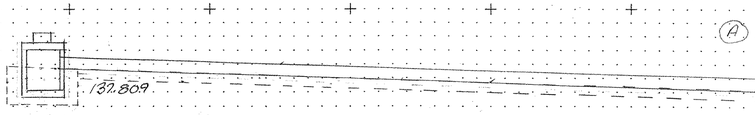

15+124.6 ~ 15+173.4 LT
New 450mm x 49.6m PCC SP
1.63mm (68mm x 12mm)
Bk 3 Pg 76

15+174.6 ~ 15+190.4 LT
New 450mm x 15.8 PCC SP
1.63mm (68mm x 12mm)
Bk 3 Pg 78

190

135

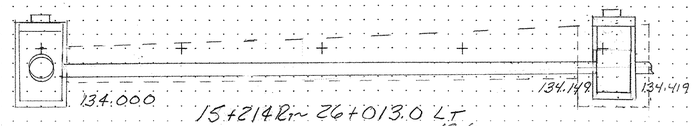

CB c
15+214 RT

15+214Rm 26+013.0 LT
New 450mm x 18.6 19.0m PCC SP
1.63mm (68mm x 12mm)
Bk 3 Pg 98

CB c
26+013.5 LT

ITEM 204.20 TRENCH EXC.
CATCH BASIN @ 26+013.5 LT
DEPTH 0-1.5
1.5x2.55x3.52 = 9.53 m³
DEPTH OVER 1.5
1.46x2.55x3.52 = 9.02 m³
PIPE 15+214RT - 26+013 LT
DEPTH 0-1.5
1.5x1.45x9.8 = 21.32 m³
1.16x1.45x9.8 = 16.77 m³
38.09 m³
DEPTH OVER 1.5
.82x1.45x9.8 = 2.84 m³
Totals 9.53
9.02x1.5 = 13.53
21.32
16.77
2.84x1.5 = 4.26
65.41

ITEM 209.30 GRAN. BACKFILL
CATCH BASIN
DEPTH 0-1.5
9.53-(1.5x(.710)²) = 6.95m³
DEPTH OVER 1.5
9.02-(1.1x(.710)²) = 7.15m³
PIPE
DEPTH 0-1.5
2.02A²x9.8 = 19.84 m²
1.64A²x9.8 = 15.42 m²
35.31 m³
DEPTH OVER 1.5
.27x9.8 = 2.65m³
7.80
52.04

Bk 3 Pg 98

13.2
4.3

PROJECT: FRANKLIN	PROJECT NO.: STP 0301(18)
DESIGN FILE NAME: IPARM FILE NAME:	PLOT DATE: 01-MAY-1996
	SHEET: 3 OF 6

063

Metric

ITEM 204.20 TRENCH EXC.

CATCH BASIN @ STA 15+214.8 - 15+215.8 RT
DEPTH 0 - 1.5M
1.5 x 2.83 x 2.83 = 12.01 M³
DEPTH OVER 1.5M
6.17 x 2.83 x 2.83 = 6.17 M³

PIPE @ STA 15+214.8 - 15+255.8 RT
DEPTH 0 - 1.5M
1.65 x 2.05 x 41.5 = 92.73 M³
DEPTH OVER 1.5M
NONE

6.17 x 1.5 = 9.26
Total 114.00

ITEM 204.30 GRAN. BACKFILL FOR STRUCTURES

CATCH BASIN
DEPTH 0 - 1.5M
1.20 - (1.5 x (.91)²) = 0.41
DEPTH OVER 1.5M
6.17 - (.49 x (.91)²) = 4.95
13.06

PIPE
1.69 x 1.65 x 41.5 = 72.43 M³
DEPTH OVER 1.5
NONE
Total 85.49

Bk 3 Pg 87

ITEM 204.20 TRENCH EXC.

CATCH BASIN @ STA 15+259.3 - 15+275.2 RT
DEPTH 0 - 1.5M
1.5 x 2.89 x 2.89 = 12.53 M³

DEPTH OVER 1.5M
NONE

PIPE @ STA 259.3 - 15+275.2 RT
DEPTH 0 - 1.5M
0.62 x 2.05 x 19.62 = 18.58 M³
DEPTH OVER 1.5M
NONE

Total 31.11

ITEM 204.30 GRAN. BACKFILL

CATCH BASIN
DEPTH 0-1.5
12.53 - 1.2 x (.91)² = 9.41 M³

PIPE
DEPTH 0-1.5M
.81 M² x 19.62 = 11.84 M³
DEPTH OVER 1.5
NONE

Total 21.25

Book 3
Pg 89
BL 7-28-04

135

Outlet
133.850

130

CB
15+214 RT

15+220

15+214.8 ~ 15+259.8 Rt
New 750mm x 43.9 PCCSP 2.01mm
(68mm x 12mm)
Bk 3 Pg 86

15+240

Inlet
132.39

Outlet
132.39

CB
15+258.5

15+259.3 ~ 15+275.2 Rt
New 750 mm x 16.4 PCCSP
2.01 mm (68 mm x 12 mm)
Bk 3 Pg 88

Inlet
131.719

CB
15+276

Outlet
131.570

130

ITEM 204 TRENCH EXCAVTH

CATCH BASIN @ 15+156.5 RT
DEPTH 0 - 1.5M
1.5 x 2.55 x 2.55 = 9.75 M³
DEPTH OVER 1.5
.12 x 2.55 x 2.55 = .78 M³
PIPE
DEPTH 0-1.5M
.97 x 1.75 x 30.35 = 51.52 M³
DEPTH OVER 1.5 = NONE

9.75
0.78 x 1.5 = 1.17
51.52
Total 62.44

Item 204.30 Grad Backfill For Structures

CATCH BASIN
DEPTH 0-1.5
9.75 - (1.32 x (.74)²) = 9.03 M³
DEPTH OVER
.12 x 2.55 x 2.55 = .78 M³

PIPE
1.52 M² x 31.5 = 47.88 M³

Total 57.69

Bk 3 Pg 75

ITEM 204.20 TRENCH EXC.

CATCH BASIN @ 15+189.5
DEPTH 0-1.5
1.5 x 2.82 x 2.82 = 11.93 M³
DEPTH OVER 1.5
1.1 x 2.82 x 2.82 = 8.83 M³

PIPE 15+180.3 - 15+213.2 RT
DEPTH 0-1.5
1.5 x 2.05 x 21.6 = 66.11
DEPTH OVER 1.5
.125 x 2.05 x 15.5 = 3.97 M³

8.83 x 1.5 = 11.93 / 13.25
66.11
3.97 x 1.5 = 5.96
Total 97.25

ITEM 204.30 Gran. Backfill

CATCH BASIN
DEPTH 0-1.5
11.93 - (1.5 x (.91)²) = 8.03 M³
DEPTH OVER 1.5
8.83 - (.81 x .91)² = 6.72 M³
14.75

PIPE
DEPTH 0-1.5
2.61 M² x 21.5 = 56.12 M³
DEPTH OVER 1.5
.125 x 2.05 x 15.5 = 3.97 M³
Total 74.84

Bk 3 Pg 83

135

Outlet
131.63

Inlet
135.000

Inlet
134.450

Outlet
134.450

15+157.1 ~ 15+188.7 Rt
New 450mm x 31.3 M PCCSP
1.63mm (68mm x 12mm)
Bk 3 Pg 74

15+180

15+190.3 ~ 15+213.2 Rt
New 750mm x 24.3 / 26.9 PCCSP
2.01mm (68mm x 12mm)
Bk 3 Pg 82

Inlet
134.000

Outlet
134.000

Outlet
133.850

135

15+150

CB
15+156.5

15+160

CB
15+189.5

15+200

CB
15+214

PROJECT: FRANKLIN	PROJECT NO.: STP 0301(18)
DESIGN FILE NAME: IPARM FILE NAME:	PLOT DATE: 01-MAY-1996
	SHEET: 4 OF 6

064

MTO Metric

ITEM 204.20 TRENCH EXC.	
CATCH BASIN @ 15+383 RT	
DEPTH 0-1.5	
1.55 x 2.55 x 2.55 = 9.75 m^3	
DEPTH OVER 1.5	
.225 x 2.55 x 2.55 = 1.46 m^3	
PIPE 15+363.6 - 15+382.4 RT	
DEPTH 0-1.5	
.71 x 1.75 x 17.35 = 21.56 m^3	
DEPTH OVER 1.5	
NONE	
9.75	
1.46 x 1.5 = 2.19	
Total 33.50	21.56
	11.94

ITEM 204.30 GRAN. BACKFILL	
CATCH BASIN	
DEPTH 0-1.5	
9.75 - (1.4 x (.7)^2) = 7.34 m^2	
DEPTH OVER 1.5	
.225 x 2.55 x 2.55 = 1.46 m^3	
8.80 m	
PIPE	
DEPTH 0-1.5	
1.06 m^2 x 17.35 = 18.39 m^3	
DEPTH OVER 1.5	
NONE	
8.80	
Total 18.39	27.19
	12.14

Bk 3 Pg 113

ITEM 204.20 TRENCH EXC.	
CATCH BASIN @ 15+363 LT	
DEPTH 0-1.5	
1.55 x 2.50 x 0.80 = 8.44 m^3	
DEPTH OVER 1.5	
NONE	
PIPE 15+363 LT - 15+363 RT	
DEPTH 0-1.5	
.6 x 1.18 x 3.65 = 3.18	
DEPTH OVER 1.5	
NONE	
Total 11.62	

ITEM 204.30 GRAN. BACKFILL	
CATCH BASIN	
DEPTH 0-1.5	
8.44 - (1.12 (.74)^2) = 6.55 m^3	
DEPTH OVER 1.5	
NONE	
PIPE	
DEPTH 0-1.5	
.971 m^2 x 3.65 = 2.59	
DEPTH OVER 1.5	
NONE	
Total 9.14	

Bk 3 Pg 111

W = 1.45 m

Ⓐ

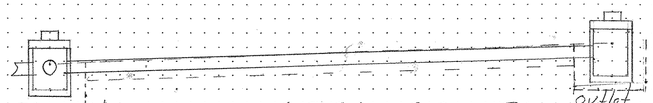

130

CB 15+363

15+363.6 ~ 15+382.4 Rt
New 450mm x 19.0m PCCSP
1.63mm (68mm x 12mm)
Bk 3 Pg 112

CB 15+383

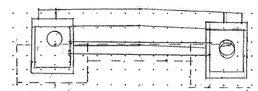

15+363
New 450mm x 5m PCCSP
1.63mm (68mm x 12mm)
Bk 3 Pg 110

10 of 2.8

ITEM 204.20 TRENCH EXC.	
CATCH BASIN @ 15+383 RT	
DEPTH 0-1.5	
1.35 x 2.15 x 2.15 = 6.21 m^3	
DEPTH OVER 1.5	
NONE	
PIPE 15+293.6 - 15+310.6 RT	
DEPTH 0-1.5	
.63 x 1.75 x 15.6 = 17.26 m^3	
DEPTH OVER 1.5	
NONE	
Total 23.44	

ITEM 204.30 GRAN. BACKFILL	
CATCH BASIN	
DEPTH 0-1.5	
6.24 - (1.0 x (.75)^2) = 5.26	
DEPTH OVER 1.5	
NONE	
PIPE	
DEPTH 0-1.5	
.93 m^2 x 15.2 = 14.5 m^3	
DEPTH OVER 1.5	
NONE	
Total 19.76	

Bk 3 Pg 103

ITEM 204.20 TRENCH EXC.	
CATCH BASIN @ 15+319 RT	
DEPTH 0-1.5	
1.30 x 2.5 x 2.5 = 8.12 m^3	
DEPTH OVER 1.5	
NONE	
PIPE 15+311.5 - 15+318.4 RT	
DEPTH 0-1.5	
.47 x 1.75 x 5.55 = 4.56 m^3	
DEPTH OVER 1.5	
NONE	
Total 12.68	
12.14	

ITEM 204.30 GRAN. BACKFILL	
CATCH BASIN	
DEPTH 0-1.5	
9.30 - (1.15 x (.74)^2) = 6.41 m^3	
DEPTH OVER 1.5	
NONE	
PIPE	
DEPTH 0-1.5	
.6 m^2 x 5.5 = 3.66 m^3	
DEPTH OVER 1.5	
NONE	
Total 10.07	

Bk 3 Pg 105

ITEM 204.20 TRENCH EXC.	
CATCH BASIN @ 15+345 RT	
DEPTH 0-1.5	
1.43 x 2.55 x 0.85 = 9.30 m^3	
DEPTH OVER 1.5	
NONE	
PIPE 15+319.6 - 15+344.4 RT	
DEPTH 0-1.5	
.47 x 1.75 x 25.35 = 19.03 m^3	
DEPTH OVER 1.5	
NONE	
Total 28.53	
12.14	

ITEM 204.30 GRAN. BACKFILL	
CATCH BASIN	
DEPTH 0-1.5	
9.30 - (1.15 x (.74)^2) = 7.36 m^3	
DEPTH OVER - NONE	
PIPE	
DEPTH 0-1.5	
.72 m^2 x 23.35 = 16.83 m^3	
DEPTH OVER 1.5	
NONE	
Total 24.19	

Bk 3 Pg 107

ITEM 204.20 TRENCH EXC.	
CATCH BASIN @ 15+363 RT	
DEPTH 0-1.5	
1.55 x 2.60 x 2.60 = 10.14 m^3	
DEPTH OVER 1.5	
NONE	
PIPE 15+345.6 - 15+362.4 RT	
DEPTH 0-1.5	
.61 x 1.75 x 15.99 = 16.54 m^3	
DEPTH OVER 1.5	
NONE	
Total 26.68	

ITEM 204.30 GRAN. BACKFILL	
CATCH BASIN	
DEPTH 0-1.5	
10.14 - (1.24 (.74)^2) = 9.08 m^3	
DEPTH OVER 1.5	
NONE	
PIPE	
DEPTH 0-1.5	
.88 m^2 x 15.49 = 13.79 m^3	
DEPTH OVER 1.5	
NONE	
Total 21.87	

Bk 3 Pg 109

Ⓑ Ⓑ Ⓐ Ⓐ

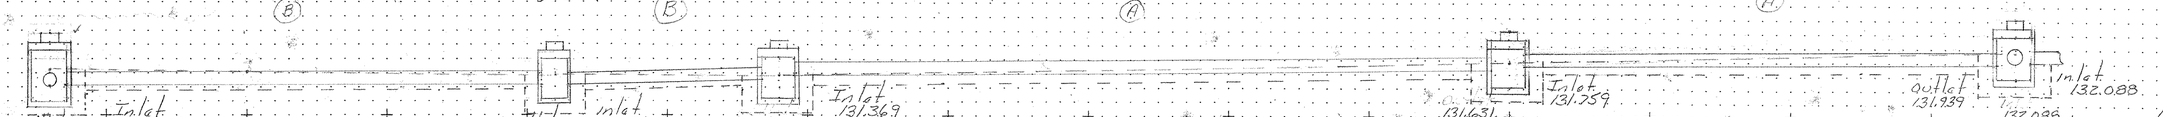

135

130

CB 15+293

15+293.6 ~ 15+310.6 Rt
New 450mm x 17.2 PCCSP
1.63mm (68mm x 12mm)
Bk 3 Pg 102

15+300

CB 15+311

CB 15+319

15+311.5 ~ 15+318.4 Rt
New 450mm x 7.4 m PCCSP
1.63mm (68mm x 12mm)
Bk 3 Pg 104

15+319.6 ~ 15+344.4 Rt
New 450mm x 25.0m PCCSP
1.63mm (68mm x 12mm)
Bk 3 Pg 106

CB 15+345

15+345.6 ~ 15+362.4 Rt
New 450mm x 17.0m PCCSP
1.63mm (68mm x 12mm)
Bk 3 Pg 108

CB 15+363

PROJECT: FRANKLIN	PROJECT NO.: STP 0301(18)
DESIGN FILE NAME:	
IPARM FILE NAME:	PLOT DATE: 01-MAY-1996
	SHEET: 5 OF 6

065

MTO Metric

ITEM 204.20 TRENCH EXC	ITEM 204.30 GRAN. BACKFILL
CATCH BASIN @ 15+440.5 RT DEPTH 0-1.5 1.47 x 2.5m x 2.5m = 9.2[illegible] m^3 DEPTH OVER 1.5 None	CATCH BASIN DEPTH 0-1.5 9.34 - (1.17 x (.74)^2)m^2 = 7.32 m^3 DEPTH OVER 1.5 NONE
PIPE 15+415 LT - 15+425.6 RT DEPTH 0-1.5 .48 x 1.45 x 9.28 = 6.50 m^3 DEPTH OVER 1.5 NONE	PIPE DEPTH 0-1.5 .39 m^2 x 9.28 = 5.47 m^3 DEPTH OVER 1.5 NONE
Total 15.93	Total 12.80

W = 7.45m

Bk3 Pg 117

ITEM 204.20 TRENCH EXC	ITEM 204.30 GRAN. BACKFILL
CATCH BASIN @ 15+440 RT DEPTH 0-1.5 1.35 x 2.48 x 2.48 = 8.30 m^3 DEPTH OVER 1.5 NONE	CATCH BASIN DEPTH 0-1.5 8.30 - (1.05 x (.74)^2)m^2 = 6.50 m^3 DEPTH OVER 1.5 NONE
PIPE 15+440 LT - 15+440 RT DEPTH 0-1.5 .50 x 1.45 x 2.40 = 2.47 m^3 DEPTH OVER 1.5 NONE	PIPE DEPTH 0-1.5 .61 m^2 x 3.40 = 2.07 m^3 DEPTH OVER 1.5 NONE
Total 10.77	Total 8.57

W = 14.5m

Bk3 Pg 121

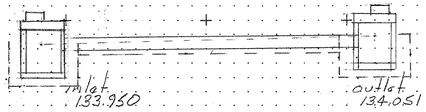

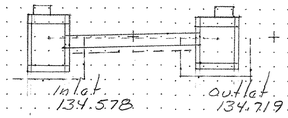

130

15+415 LT ~ 15+425.6 RT
New 450mm x 10.5m PCCSP
1.63mm x (68mm x 12mm)
Bk 3 Pg 116

15+440
New 450mm x 5.5m PCCSP
1.63mm (68mm x 12mm)
Bk 3 Pg 120

130

ITEM 204.20 TRENCH EXC	ITEM 204.30 GRAN. BACKFILL
CATCH BASIN @ 15+415 LT DEPTH 0-1.5 1.5 x 2.5m x 2.5m = 9.53 m^3 DEPTH OVER 1.5 NONE	CATCH BASIN DEPTH 0-1.5 9.53 - (1.2 x (.74)^2)m^2 = 7.47 m^3 DEPTH OVER 1.5 NONE
PIPE 15+363.6 - 15+414.2 LT DEPTH 0-1.5 .58 x 1.75 x 49.5 = 50.24 m^3 DEPTH OVER 1.5 NONE	PIPE DEPTH 0-1.5 .90 m^2 x 49.5 = 44.55 m^3 DEPTH OVER 1.5 NONE
Total 59.77	Total 52.02

Bk3 Pg 119

ITEM 204.20 TRENCH EXC	ITEM 204.30 GRAN. BACKFILL
CATCH BASIN @ 15+440 LT DEPTH 0-1.5 1.5 x 2.48 x 2.48 = 9.23 m^3 DEPTH OVER 1.5 NONE	CATCH BASIN DEPTH 0-1.5 9.23 - (1.25 x (.74)^2)m^2 = 7.08 m^3 DEPTH OVER 1.5 NONE
PIPE 15+415.8 - 15+439.4 LT DEPTH 0-1.5 .75 x 1.75 x 22.4 = 29.4 m^3 DEPTH OVER 1.5 NONE	PIPE DEPTH 0-1.5 1.14 m^2 x 22.4 = 25.54 m^3 DEPTH OVER 1.5 NONE
Total 38.63	Total 32.62

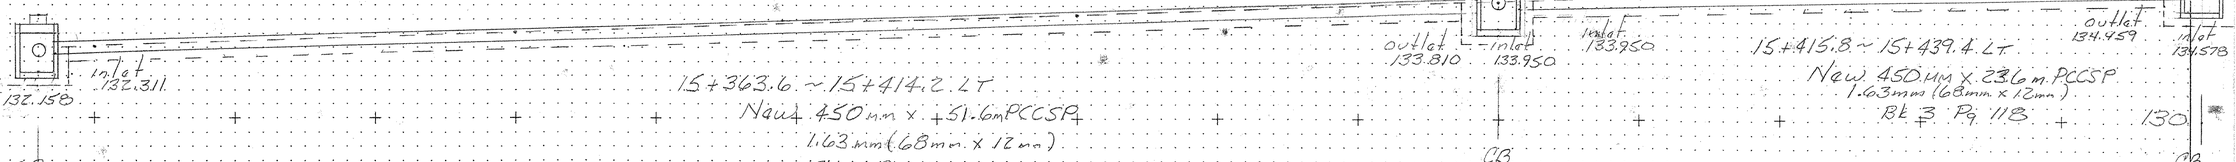

15+363.6 ~ 15+414.2 LT
New 450mm x 51.6m PCCSP
1.63mm (68mm x 12mm)
Bk 3 Pg 114

15+415.8 ~ 15+439.4 LT
New 450mm x 23.6m PCCSP
1.63mm (68mm x 12mm)
Bk 3 Pg 118

PROJECT: FRANKLIN	PROJECT NO.: STP 0301(18)
DESIGN FILE NAME: IPARM FILE NAME:	PLOT DATE: 01-MAY-1996
	SHEET: 6 OF 6

066