


ALL EXISTING GUARDRAIL TO BE REMOVED, AND REPLACED WITH NEW GUARDRAIL BETWEEN STA. 4+00 AND STA. 5+75 RT. AND LT.

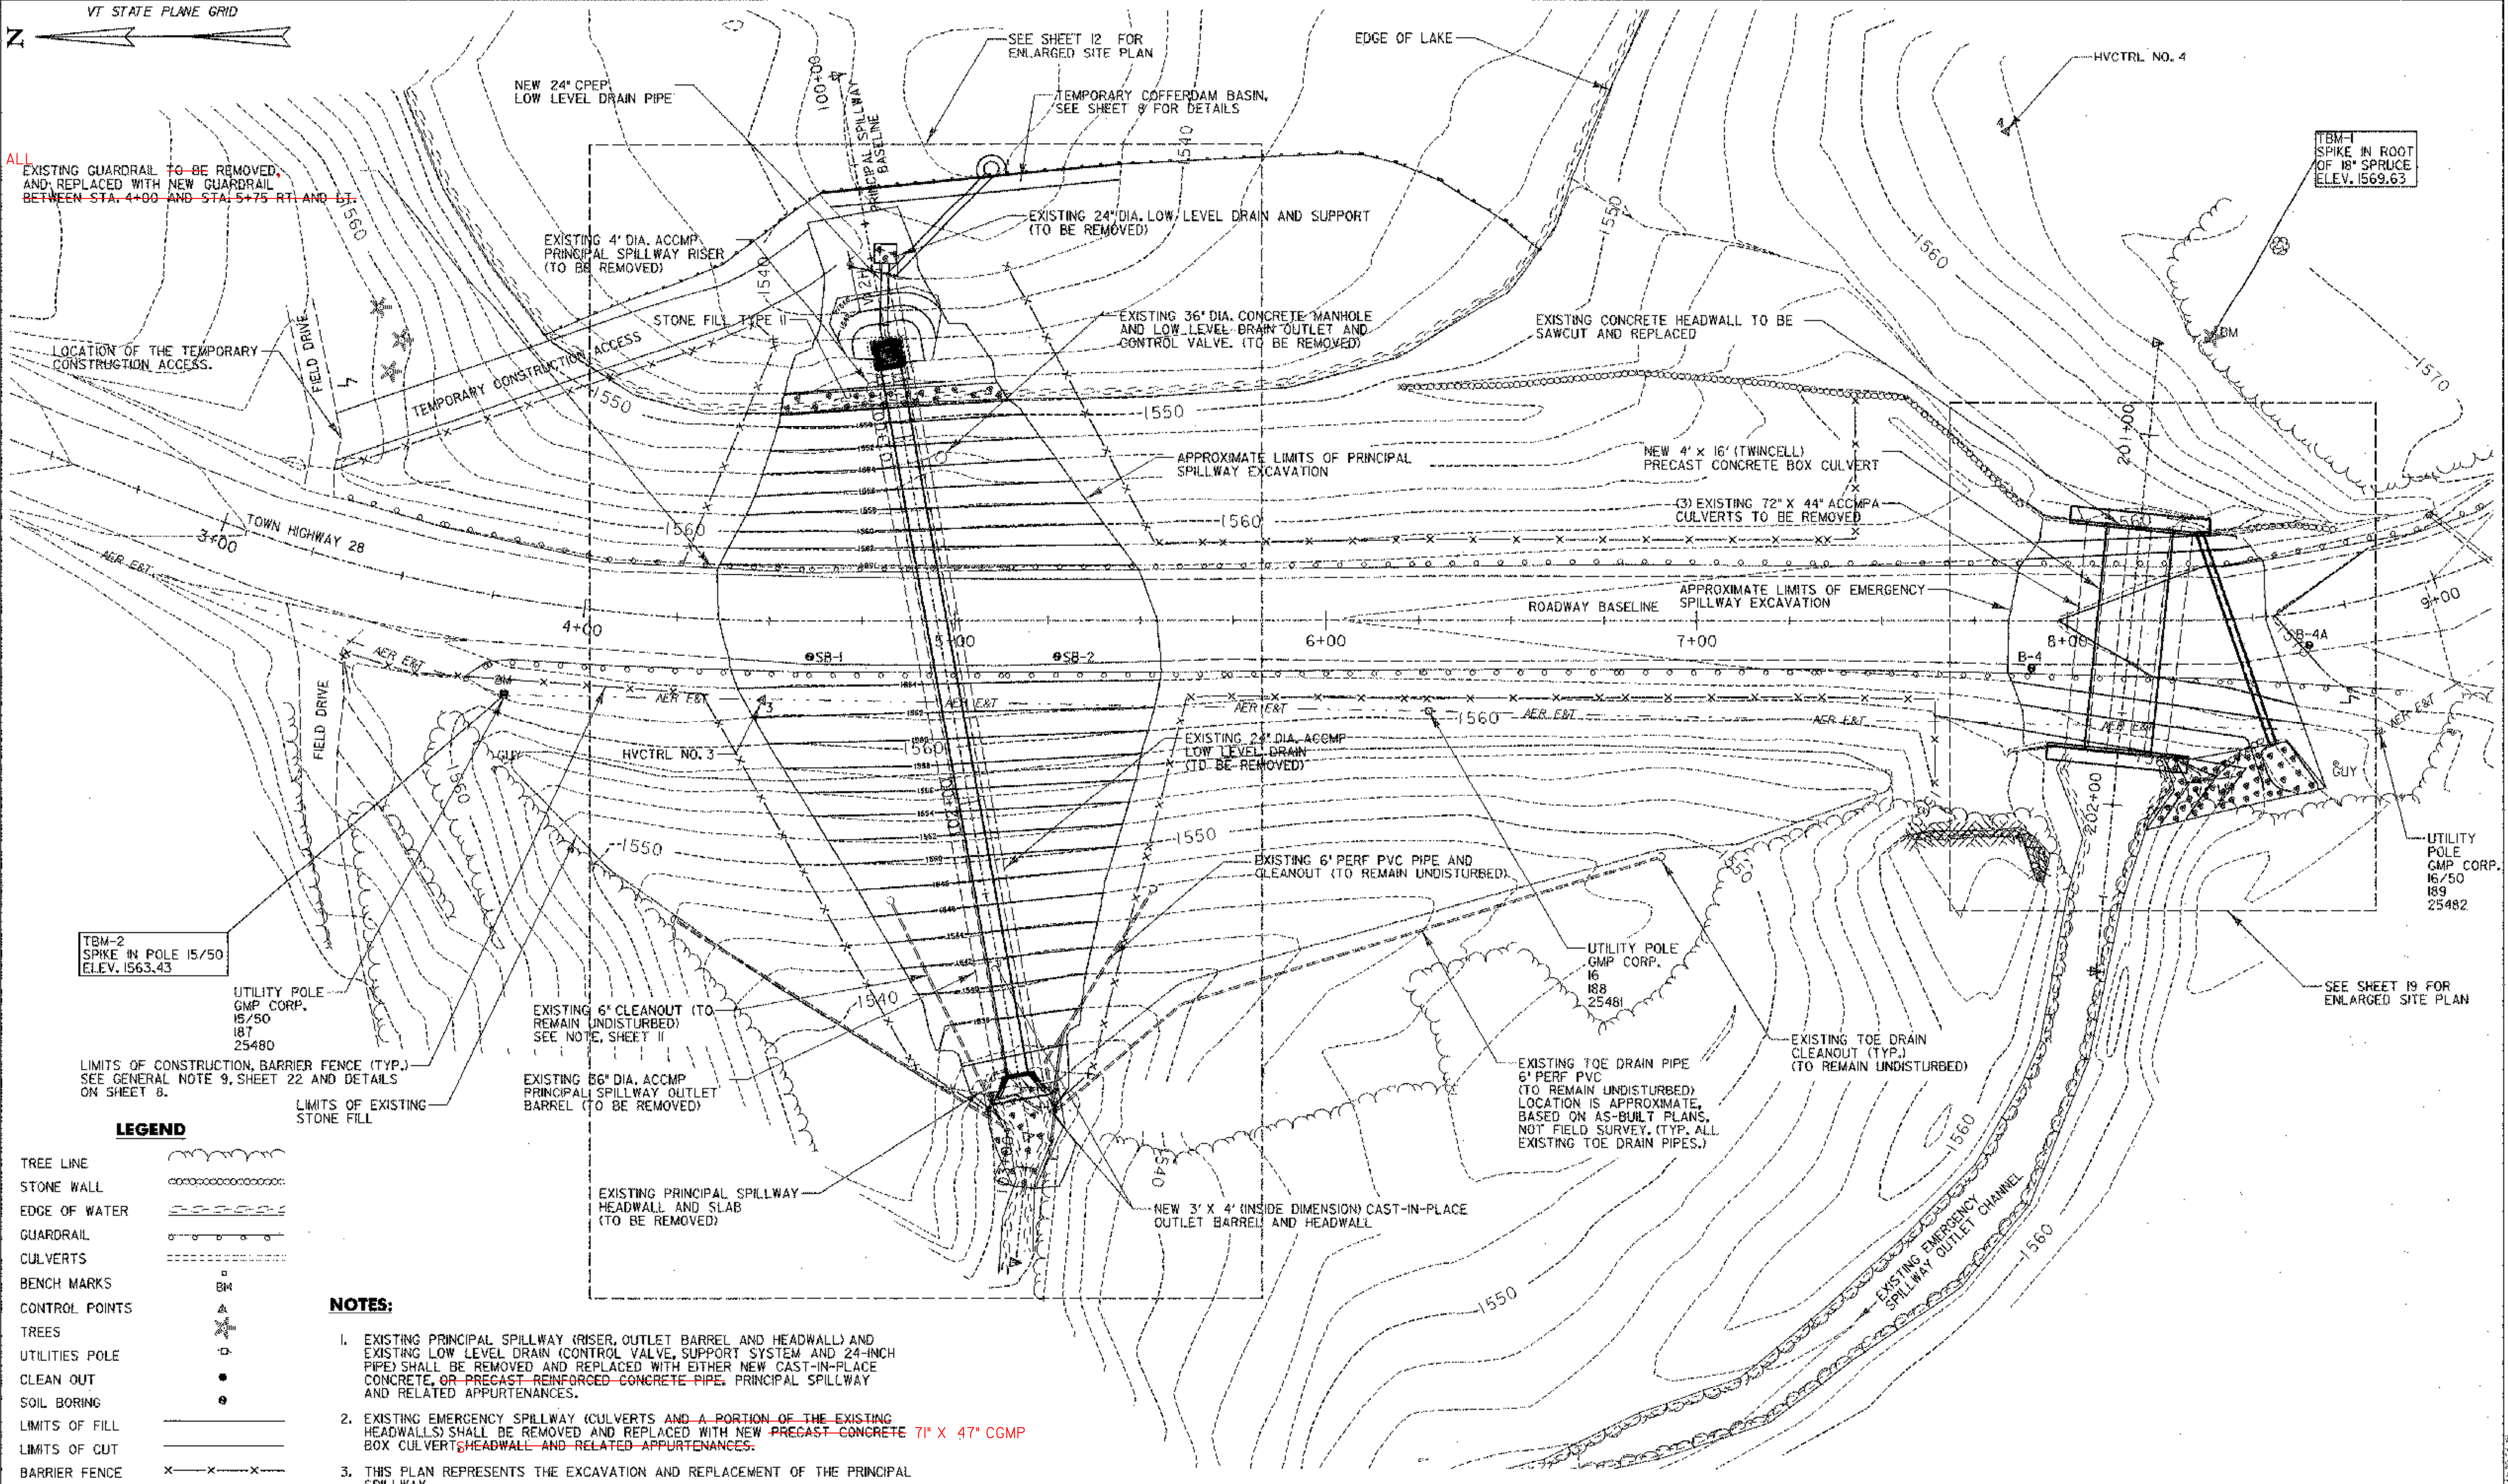


LEGEND

TREE LINE
STONE WALL
EDGE OF WATER
GUARDRAIL
CULVERTS
BENCH MARKS
CONTROL POINTS
TREES
UTILITIES POLE
CLEAN OUT
SOIL BORING
LIMITS OF FILL
LIMITS OF CUT
BARRIER FENCE
SILT FENCE
HAY BALES
ROCK OUTCROPPING

- NOTES:**
- EXISTING PRINCIPAL SPILLWAY (RISER, OUTLET BARREL AND HEADWALL) AND EXISTING LOW LEVEL DRAIN (CONTROL VALVE, SUPPORT SYSTEM AND 24-INCH PIPE) SHALL BE REMOVED AND REPLACED WITH EITHER NEW CAST-IN-PLACE CONCRETE, OR PRECAST REINFORCED CONCRETE PIPE, PRINCIPAL SPILLWAY AND RELATED APPURTENANCES.
 - EXISTING EMERGENCY SPILLWAY (CULVERTS AND A PORTION OF THE EXISTING HEADWALLS) SHALL BE REMOVED AND REPLACED WITH NEW PRECAST CONCRETE 71" X 47" CGMP BOX CULVERTS, HEADWALL AND RELATED APPURTENANCES.
 - THIS PLAN REPRESENTS THE EXCAVATION AND REPLACEMENT OF THE PRINCIPAL SPILLWAY.

DATUM

VERTICAL	ASSUMED
HORIZONTAL	NAD 83

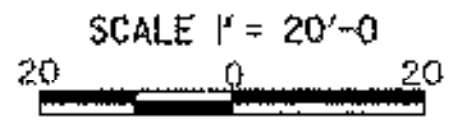

PLOTTED 05/21/2003

NO.	DATE	REVISIONS	BY	CHK'D



DuBois & King Inc.

engineering planning management development

TOWN OF WARREN
WARREN, VERMONT

BLUEBERRY LAKE DAM
REHABILITATION PROJECT

SITE PLAN

DRAWN BY EBS	DATE MAY 2003
CHECKED BY JW	PROJ. NO. RI6663
PROJ. ENG. SRP	DRAW. NO. 11298
SHEET 9 OF 24	