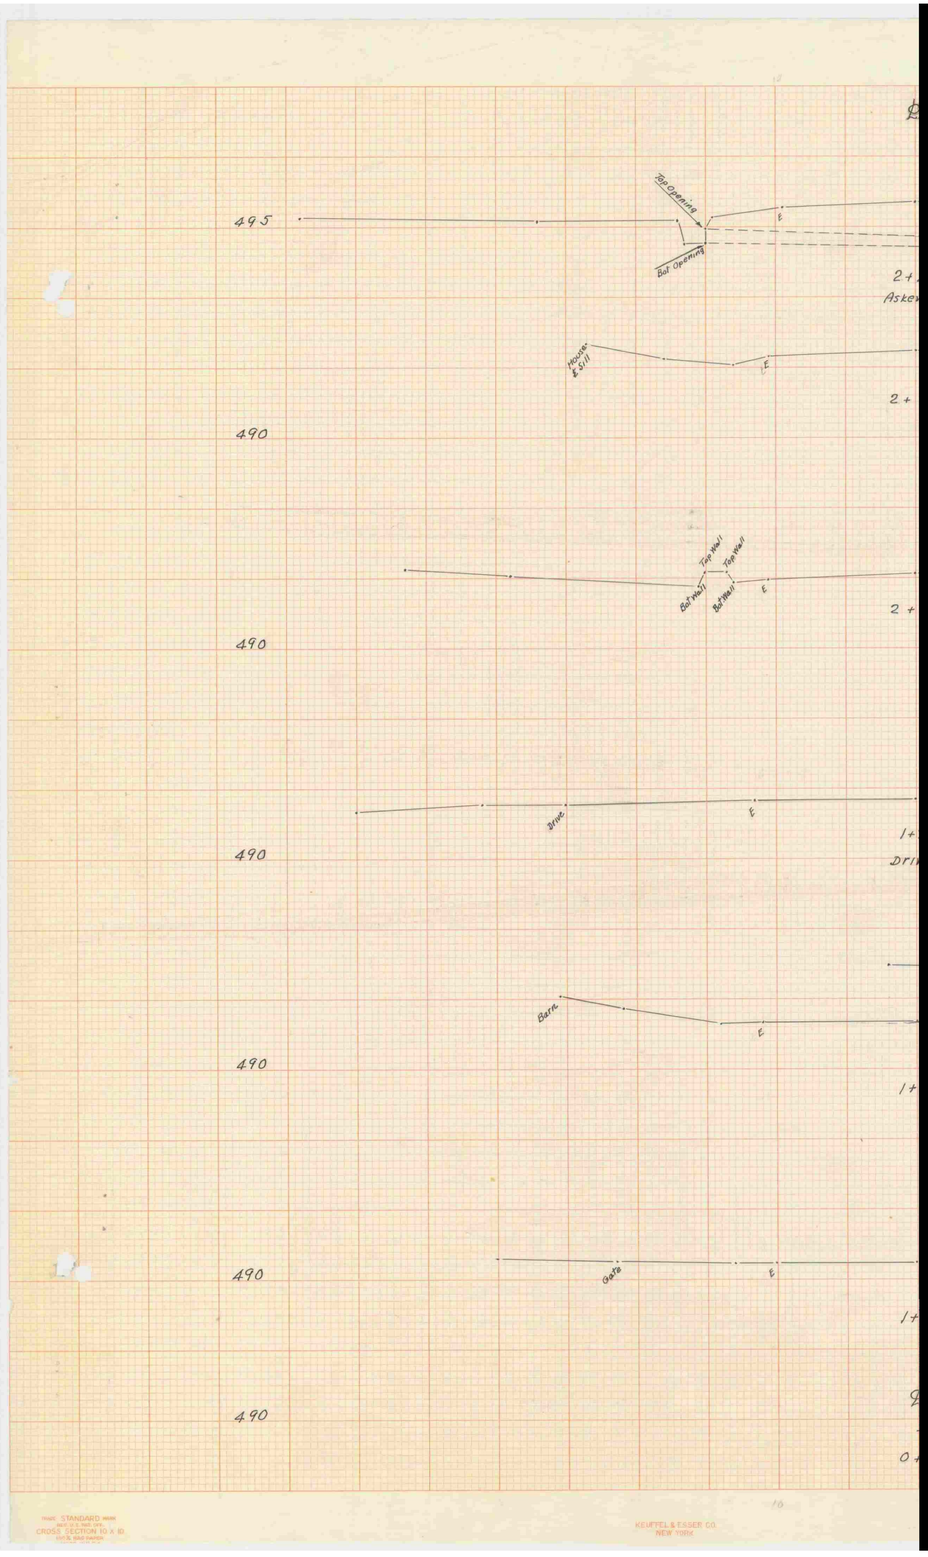

495
Top Opening
Bot. Opening
E
2+
Asker
House
& Sill
E
2+
490
Top Well
Top Well
Bot Well
Bot Well
E
2+
490
E
1+
Drin
490
Barn
E
1+
490
Gate
E
1+
490
2+