℄

START STRUCTURE EXCAVATION STA 0+81.
END UNCLASSIFIED CHANNEL EXCAV. STA 0+81

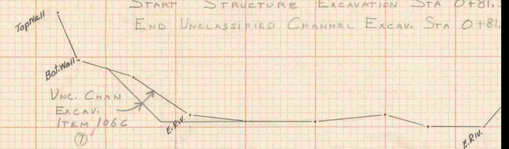

0+80

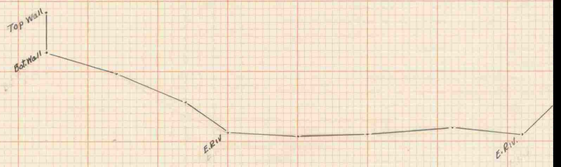

0+70

START UNCLASSIFIED CHANNEL EXCAVATIO

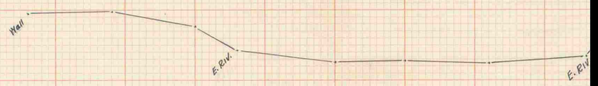

0+60

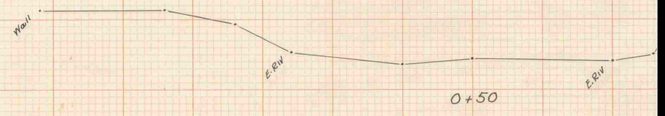

0+50

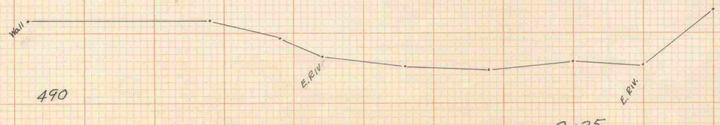

0+25

℄

STANDARD
CROSS SECTION 10 X 10
KEUFFEL & E
NEW Y