


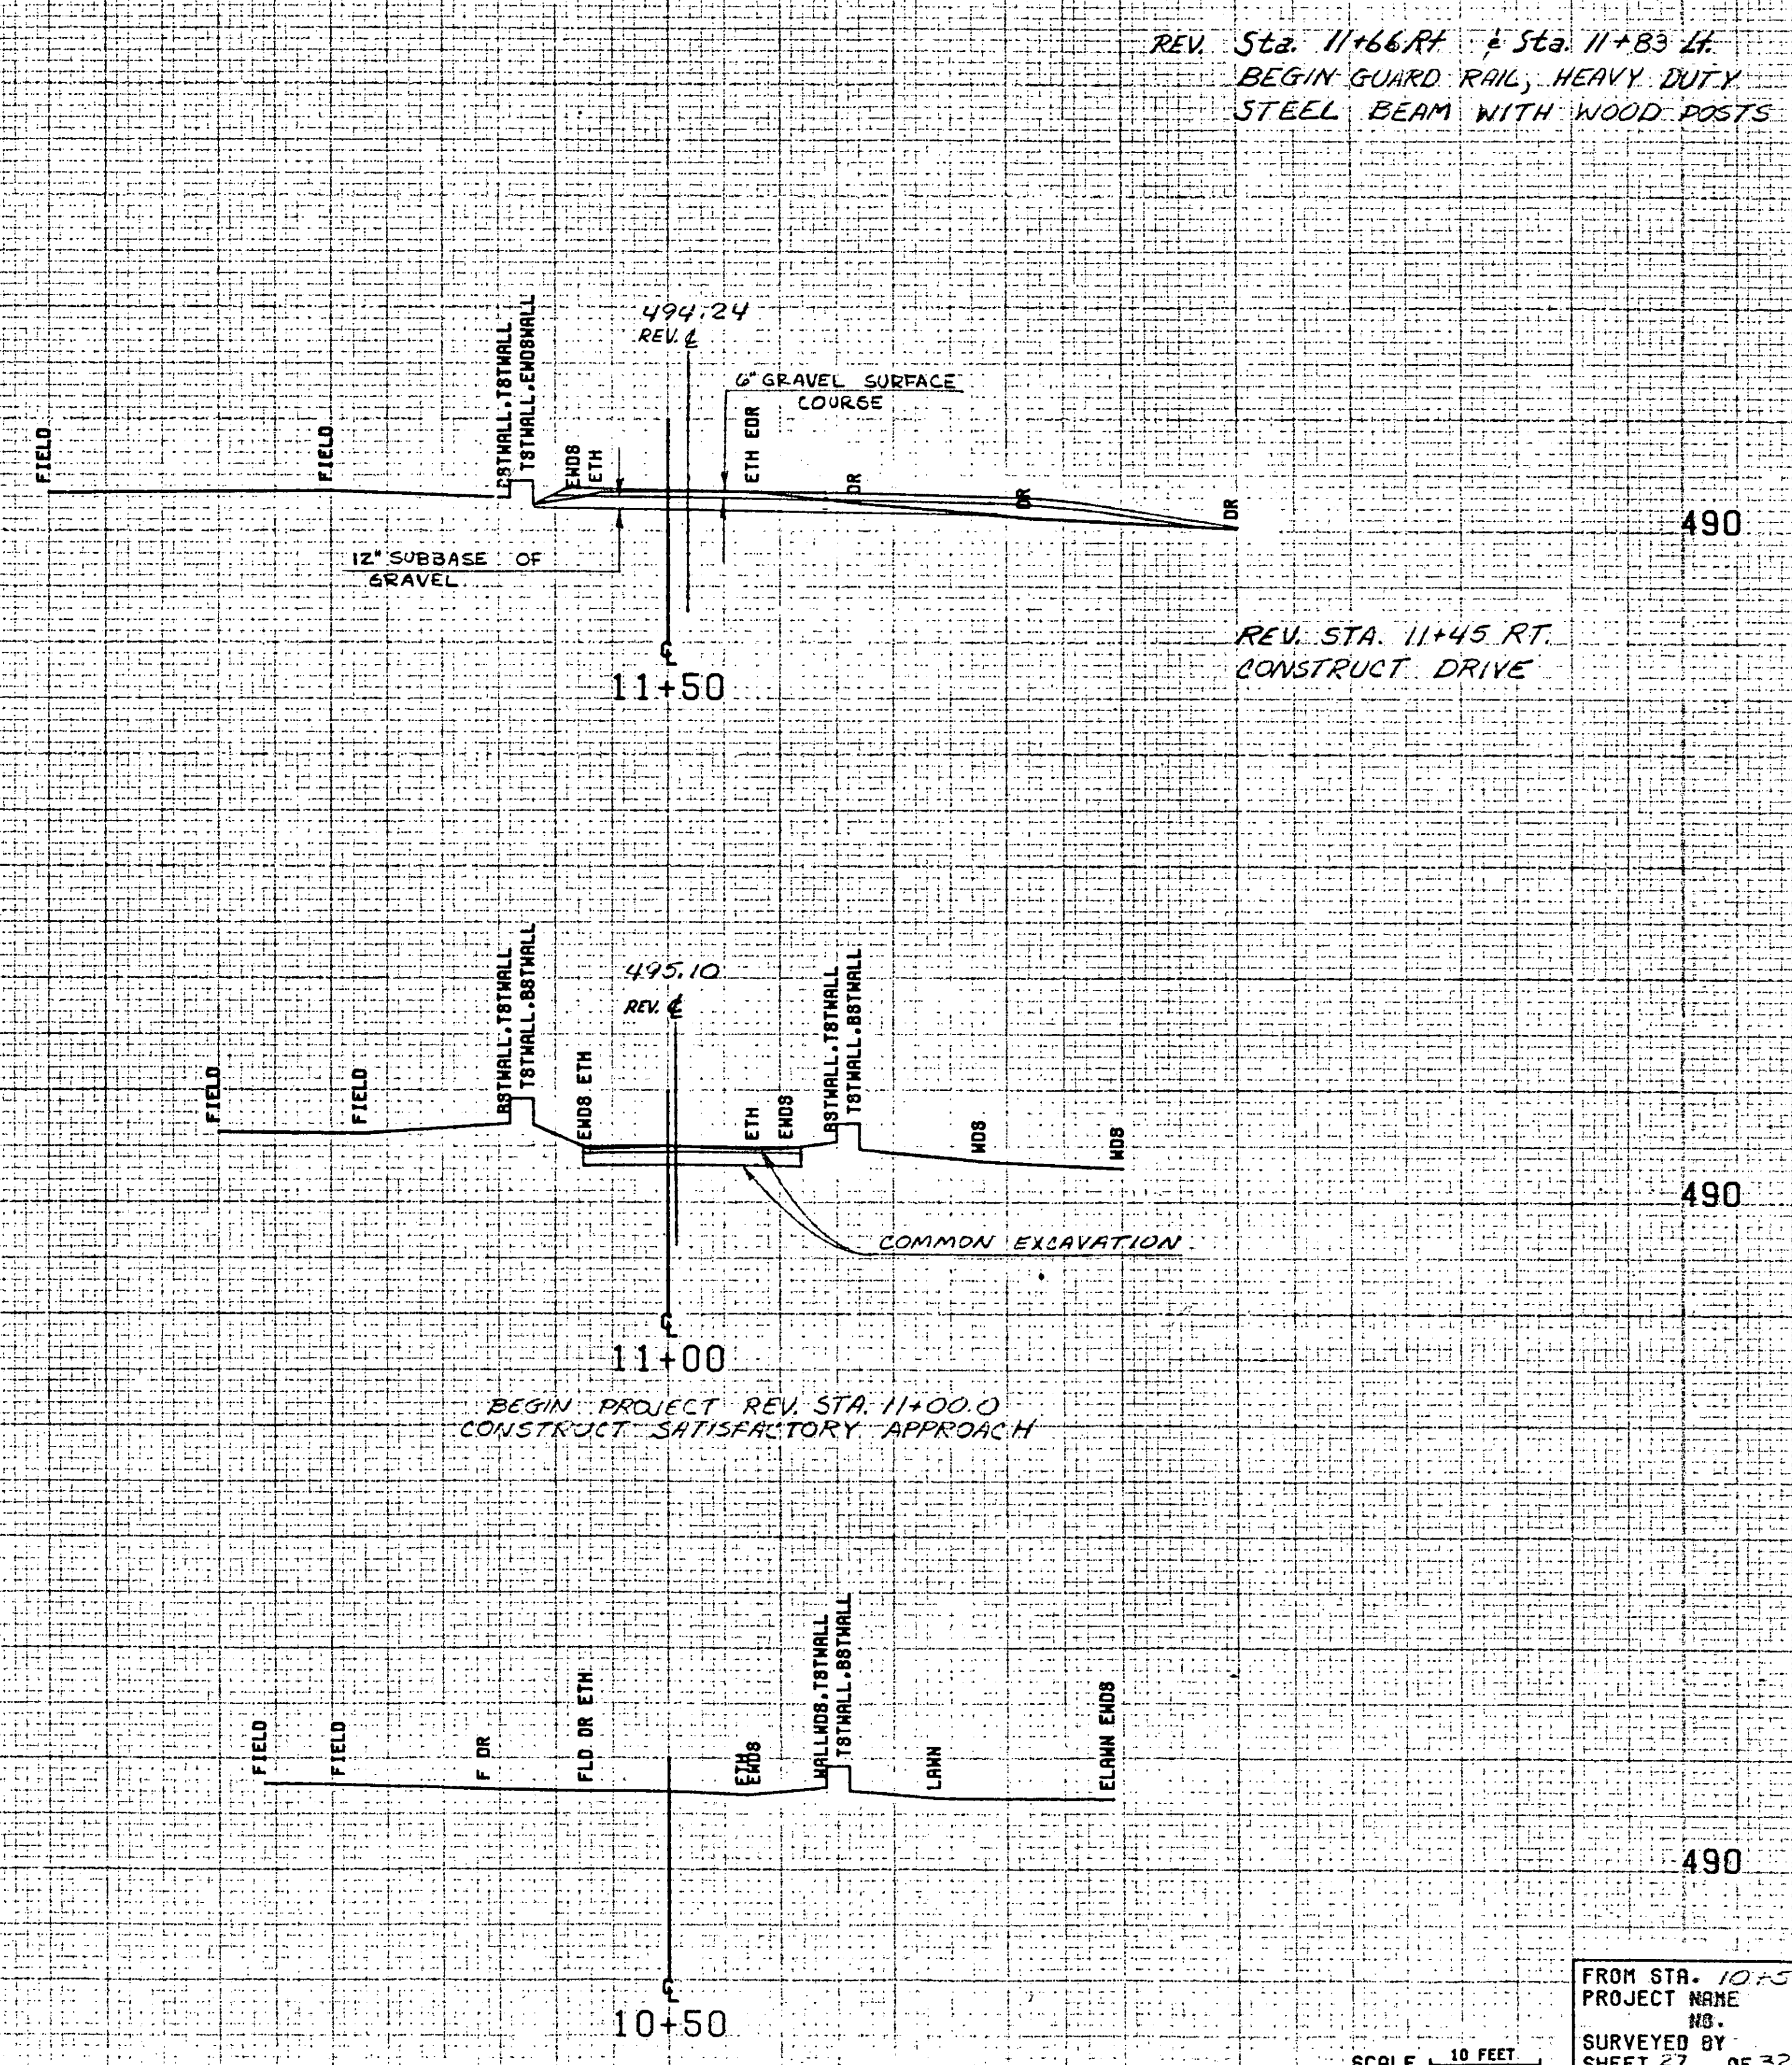

FROM STA. 10+50 TO STA. 11+50
PROJECT NAME: CHESTER MAIN
NO. BRZ1442(8) PLOTTED 01/29/82
SURVEYED BY: O COLBY
SHEET 27 OF 32 SHEETS 12/04/81

SCALE 10 FEET