


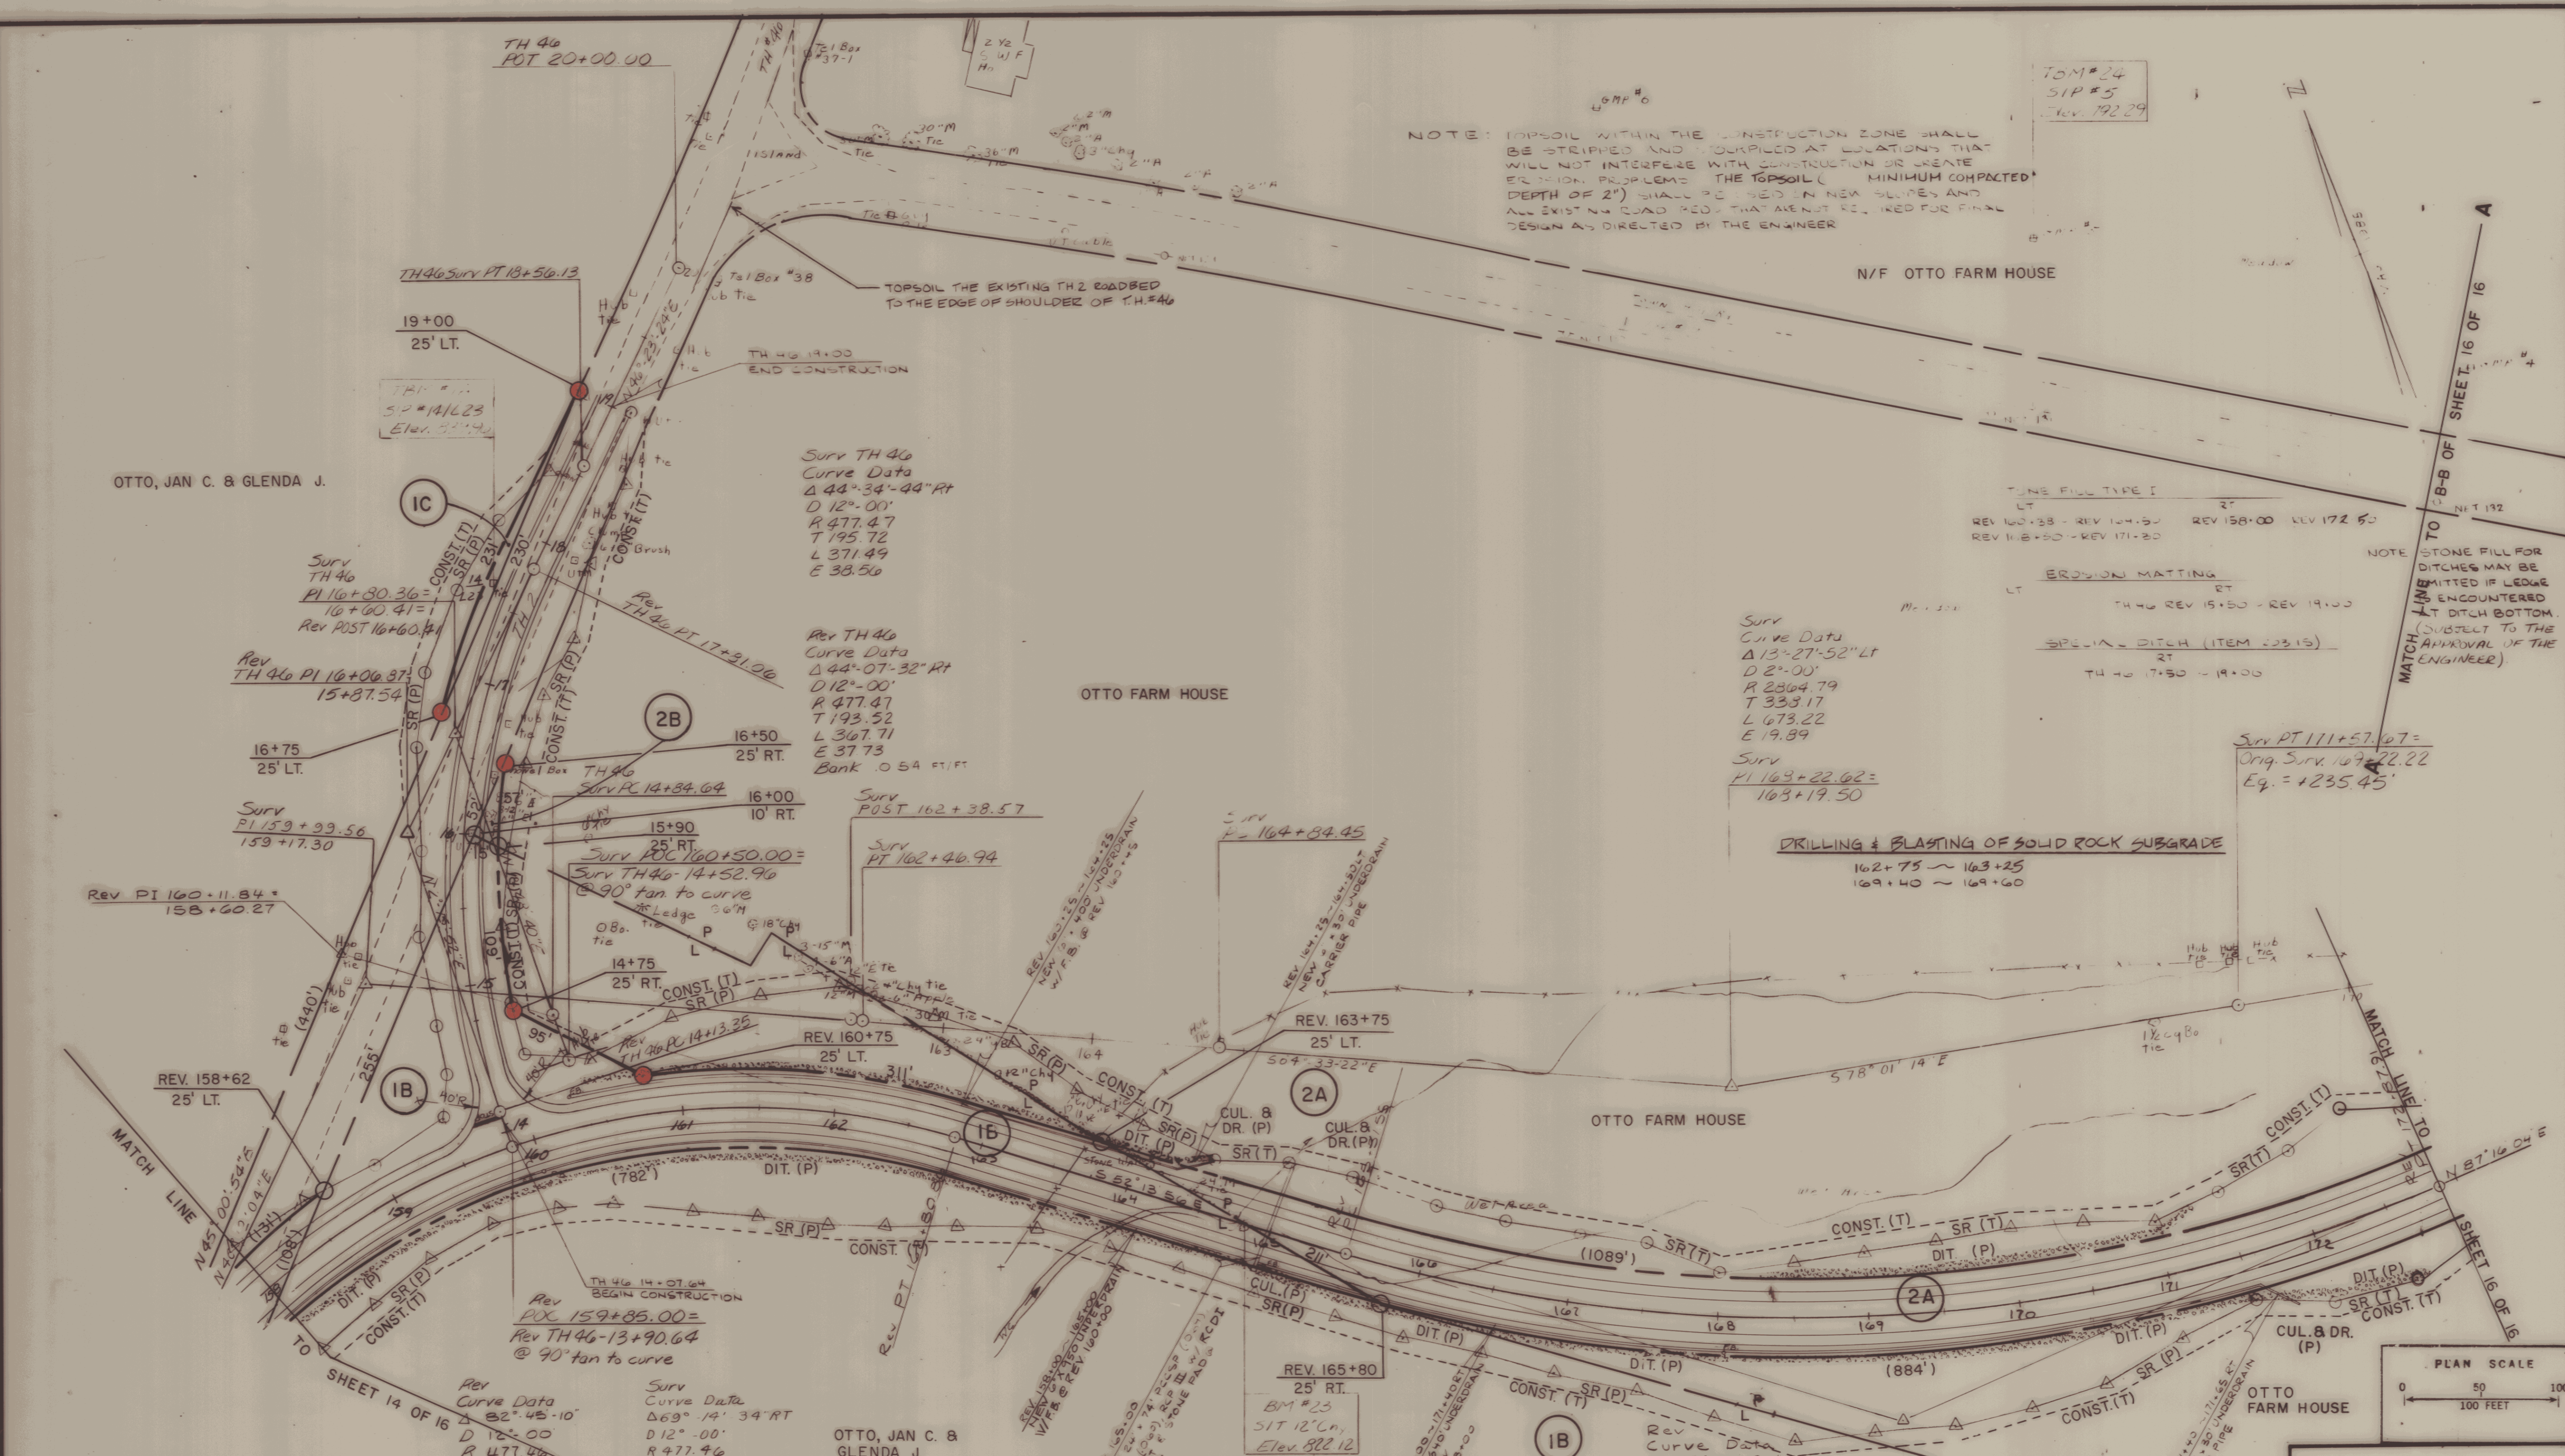

DATUM
VERTICAL NGVD 1929
HORIZONTAL N/A

EAST MONTPELIER
RSEGC-RS 0246(1) SA
R.O.W. SHEET 15 OF 16
20 of 128

This sheet for R.O.W. information only